

(905) IP

Nomberger survey
Bellevue Ave
Corner Court and Opera St

INDEXED ON MAP

Plot 526.5
Meas. 527.23

Col. to P.H. II

Main To Mad River

Plot 526.5
Meas. 525.57

Bellevue Ave

Main

Main To Mad River

Plot 526.5
Meas. 525.15


Bellevue Ave

Mad River

Plot 526.5
Meas. 526.95

Plot 526.5
Meas. 525.15

Plot 526.5
Meas. 525.15

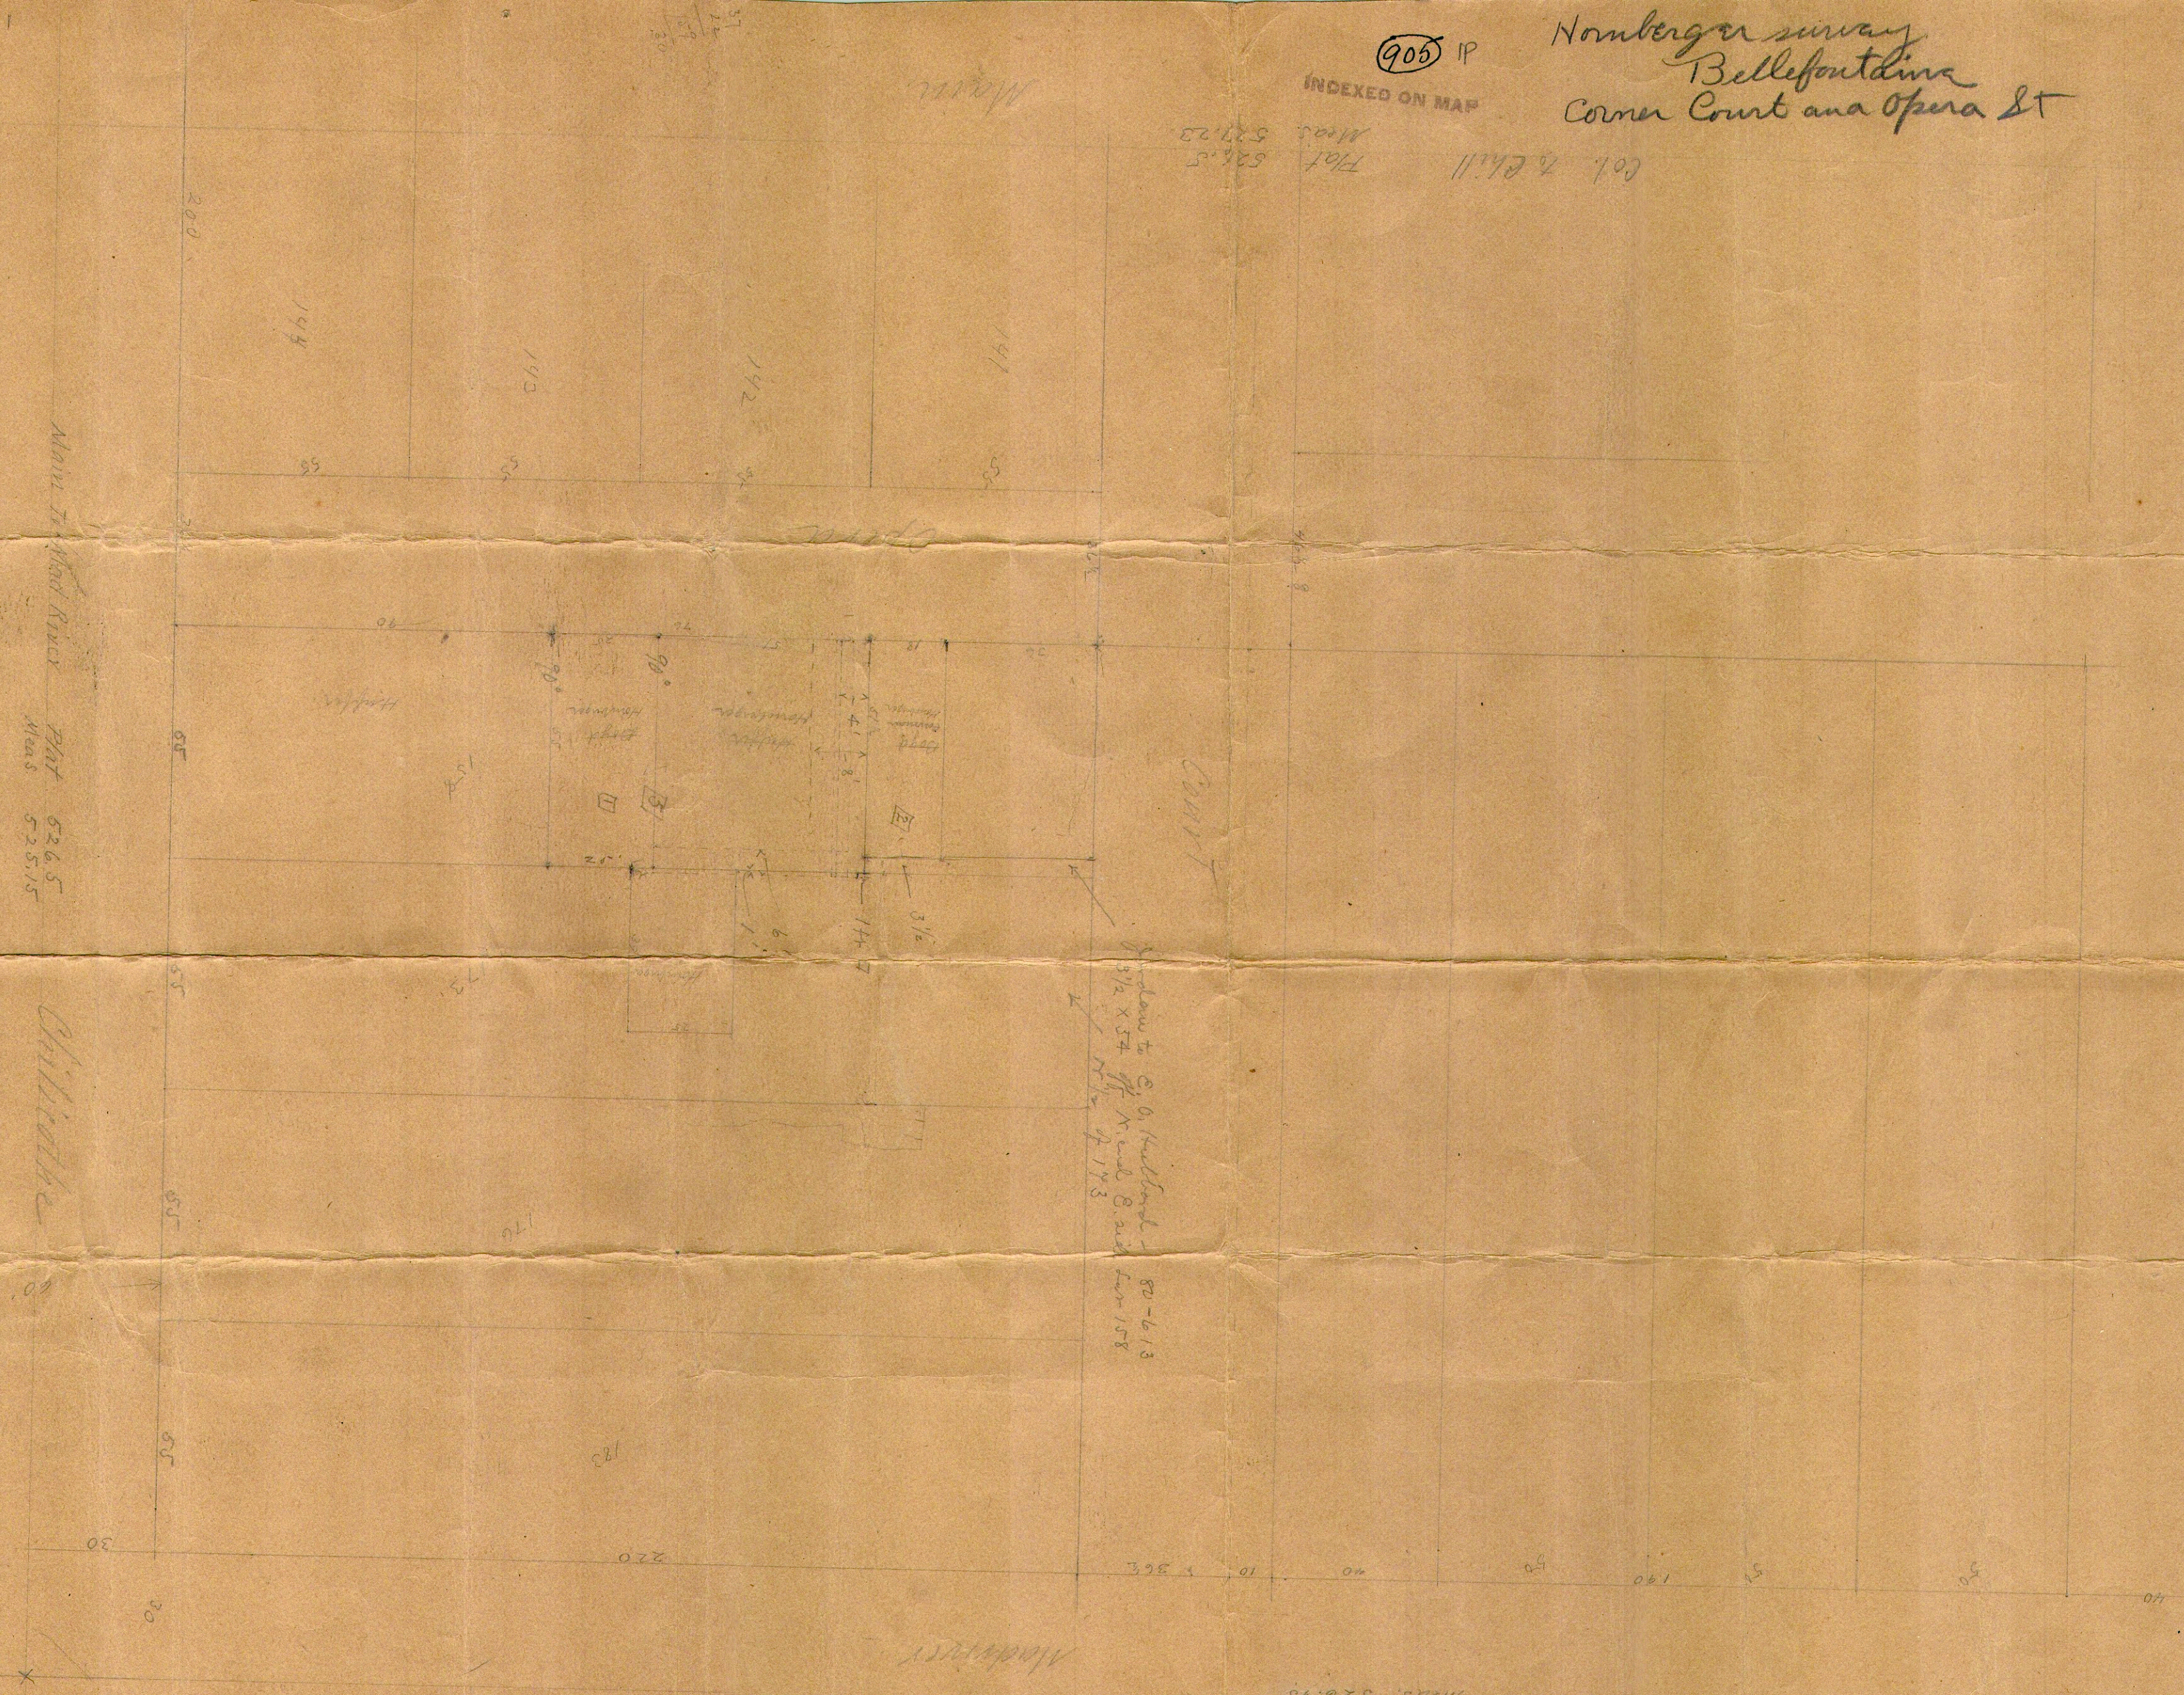

Section 5, T. 9 N., R. 10 E., S. 158
3 1/2 x 57
M. 1/2
4 1/2 x 173