

R

R

**LAKE
TOWNSHIP
1942**

INDEX


SECTION	TOWN	RANGE	PAGE	VIRGINIA MILITARY SURVEY	PAGE
27	4	14	1	4498	6
33	4	14	1	5045	6
				9572	6
				4478	7
28	4	14	2	10086	7
				10198	7
34	4	14	2	5345	8
				3683	9
34	4	14	3	4398	9
				2873	10
36	4	14	4	3317	11
				3442	11
31	3	15	5	3324	12
				9883	12
				12485	12
				3322	13
				9988	13

ALLOTMENT	PAGE
IRON CITY ADDITION	14
BELLEVILLE ADDITION	14
IRON CITY HEIGHTS	14
CLARK'S PARK ADDITION N-PART	15
CLARK'S PARK ADDITION VACATED PART	16
CLARK'S PARK ADDITION S-PART	17

LAKE TOWNSHIP
INDEX

MAP

CORRECTED TO April 12-1942
~~Cancelled Jan 1-1945~~
~~April 2-1945~~
~~November 10, 1945~~
~~January 1-1949~~
~~January 6, 1948~~
~~January 1-1949~~
Jan-1-1950

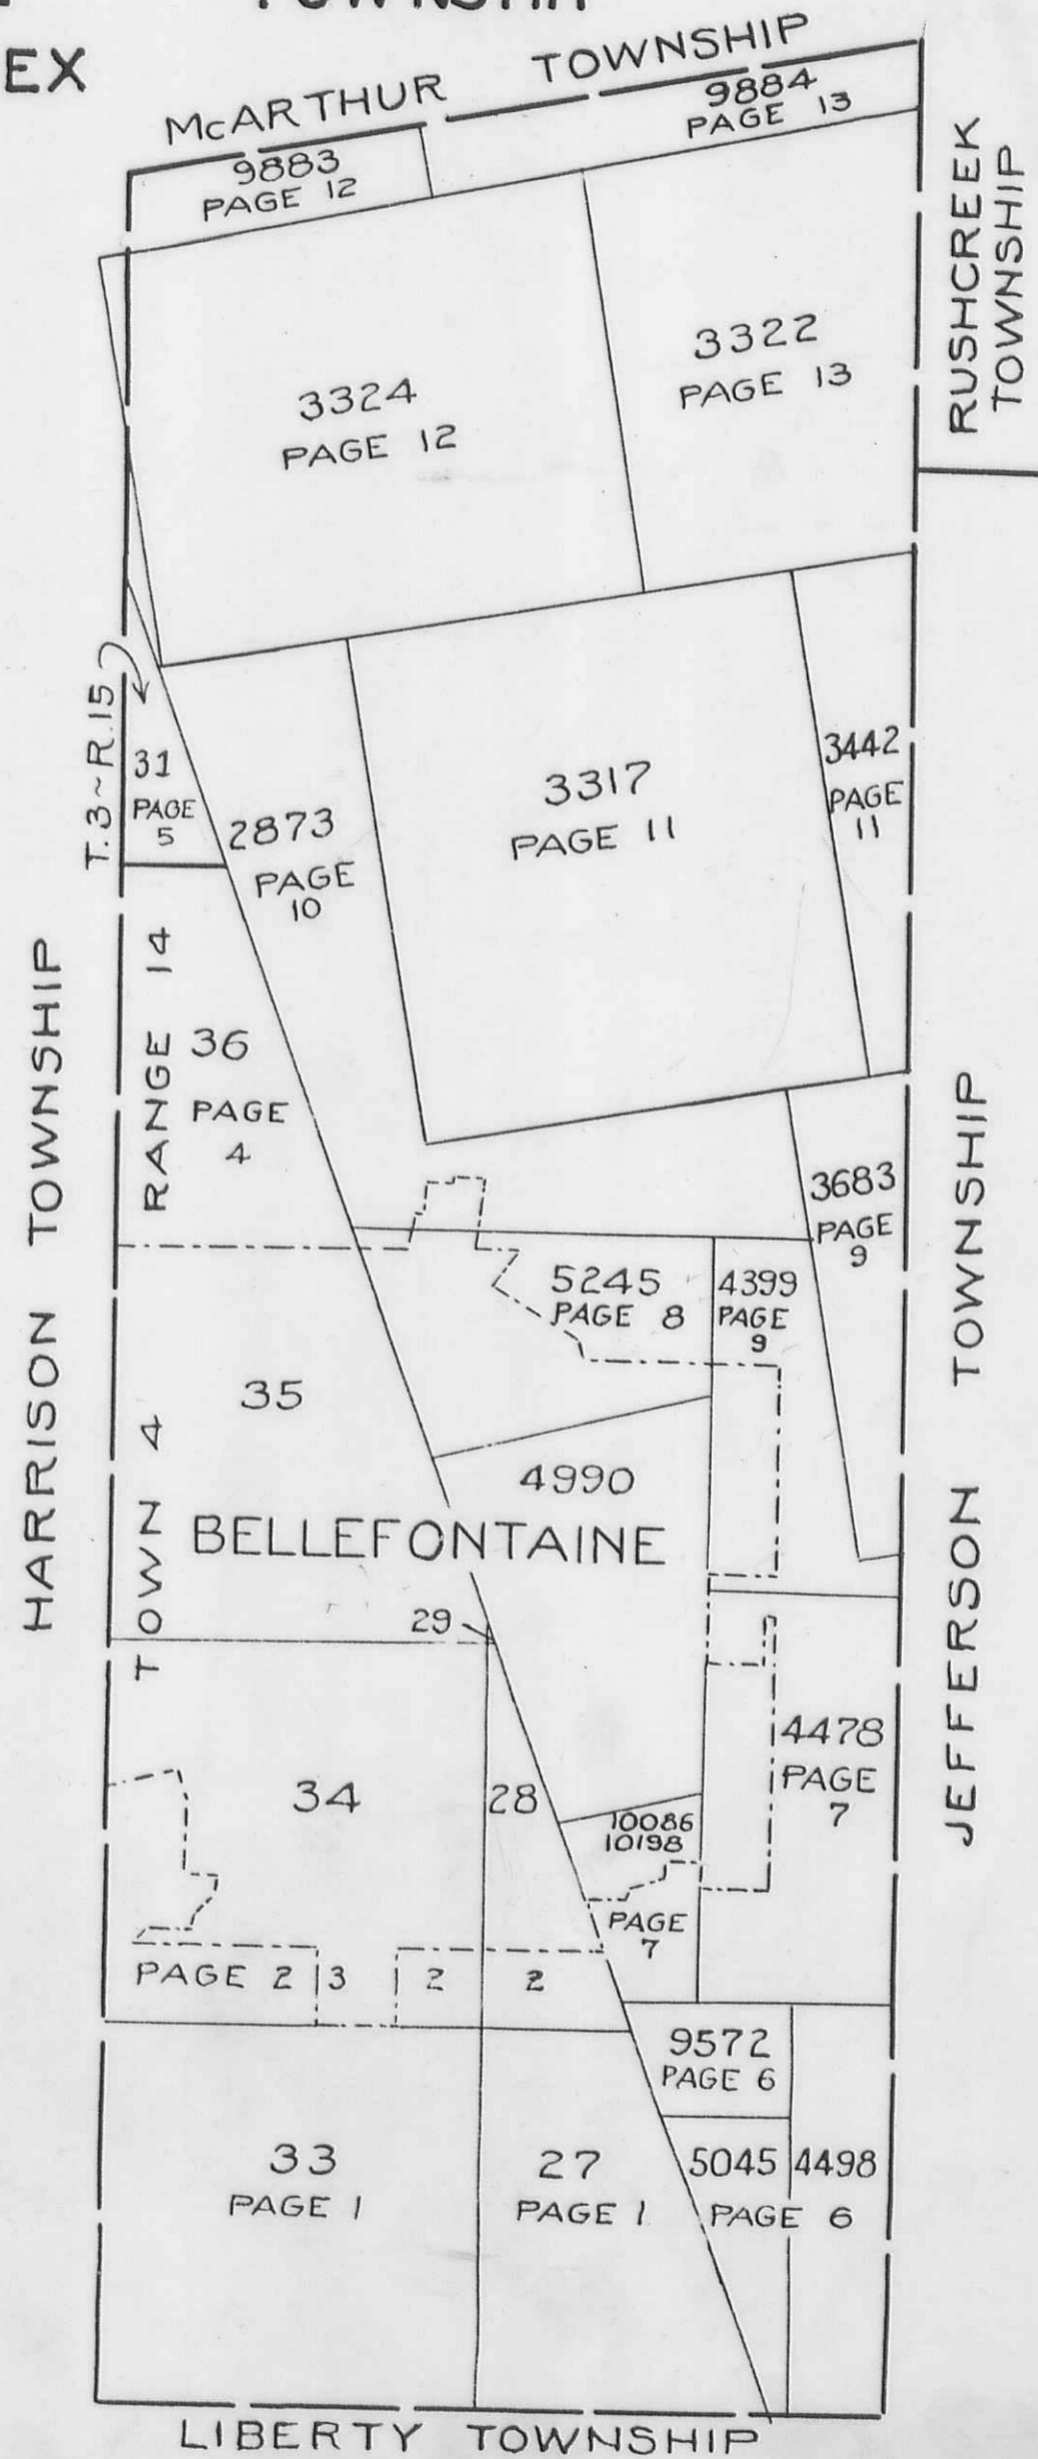

HARRISON TOWNSHIP

JEFFERSON TOWNSHIP

RUSHCREEK TOWNSHIP

McARTHUR TOWNSHIP

LIBERTY TOWNSHIP

9883 PAGE 12
9884 PAGE 13

3324 PAGE 12

3322 PAGE 13

T. 3 ~ R. 15

31 PAGE 5

2873 PAGE 10

3317 PAGE 11

3442 PAGE 11

RANGE 14

36 PAGE 4

3683 PAGE 9

5245 PAGE 8

4399 PAGE 9

35

4990

BELLEFONTAINE

29

T

34

28

4478 PAGE 7

10086
10198

PAGE 7

PAGE 2 | 3 | 2 | 2

9572 PAGE 6

33 PAGE 1

27 PAGE 1


5045 4498 PAGE 6

LAKE TOWNSHIP

SECTION 27 TOWN 4 RANGE 14
SECTION 33 TOWN 4 RANGE 14

SCALE 10 CHAINS TO THE INCH

See Page 2

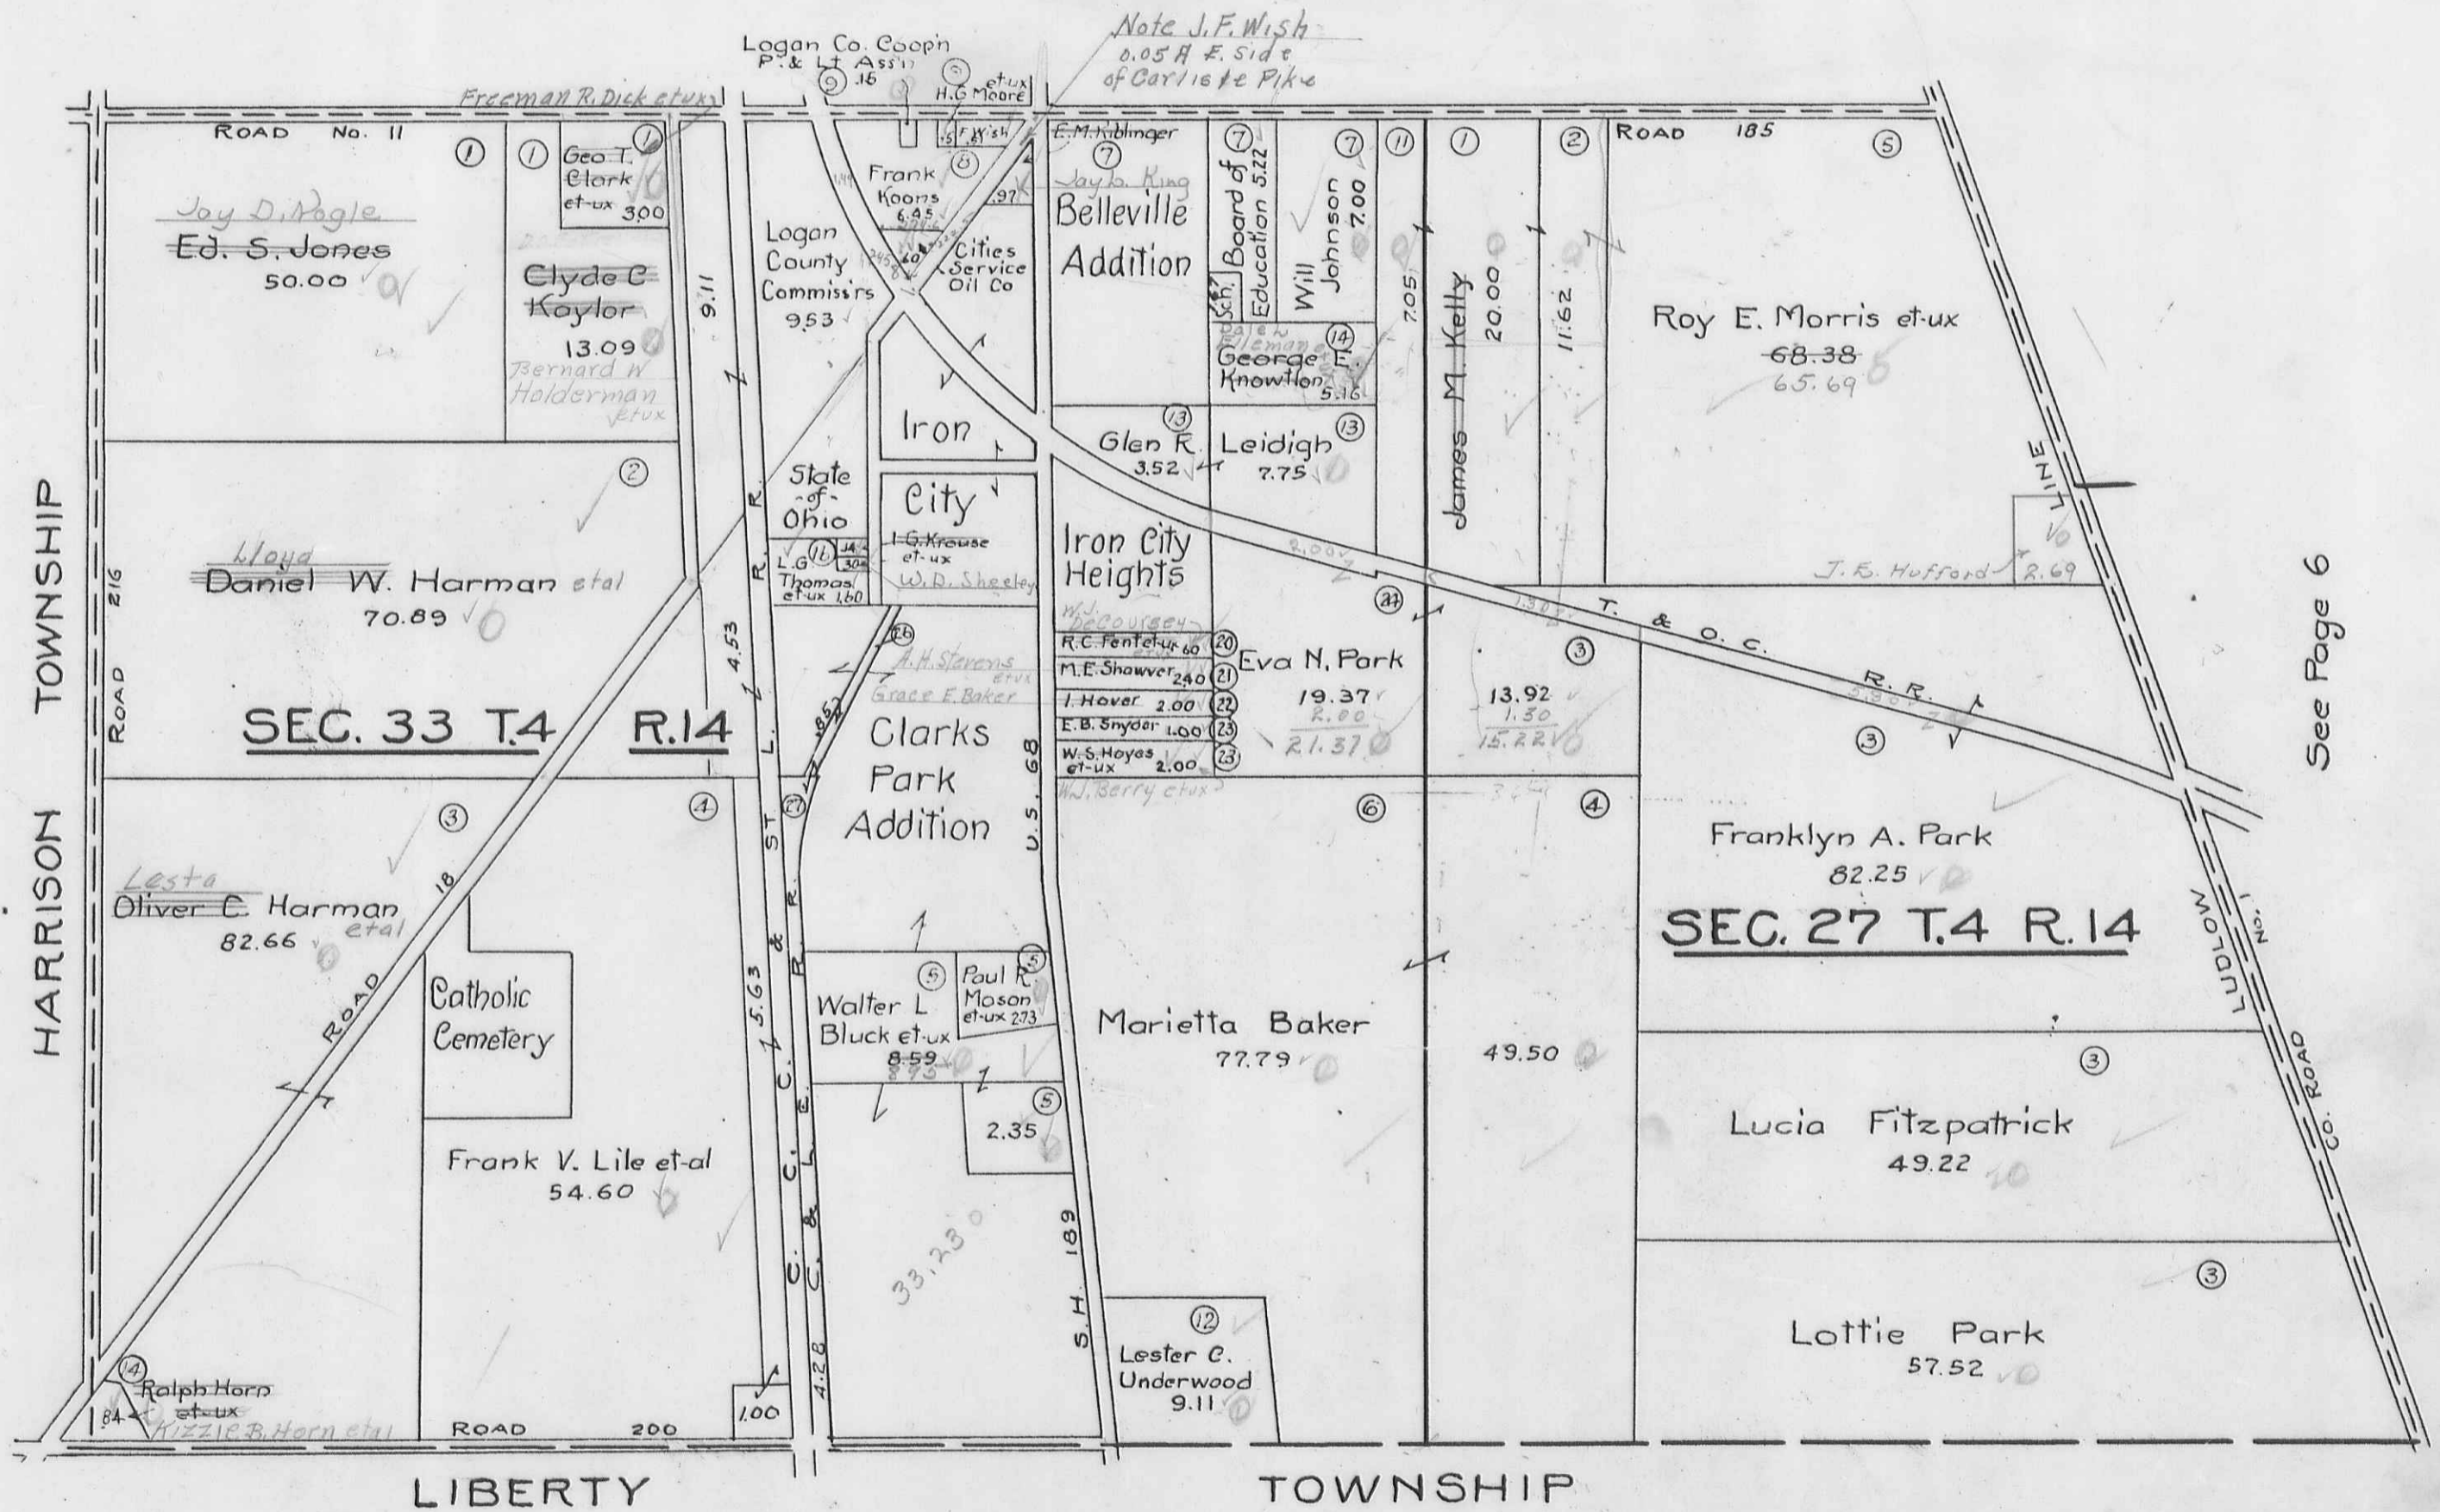


See Page 6

LAKE TOWNSHIP
SECTION 34 TOWN 4 RANGE 14

SCALE 200 FEET TO THE INCH

BELLEFONTAINE CORPORATION

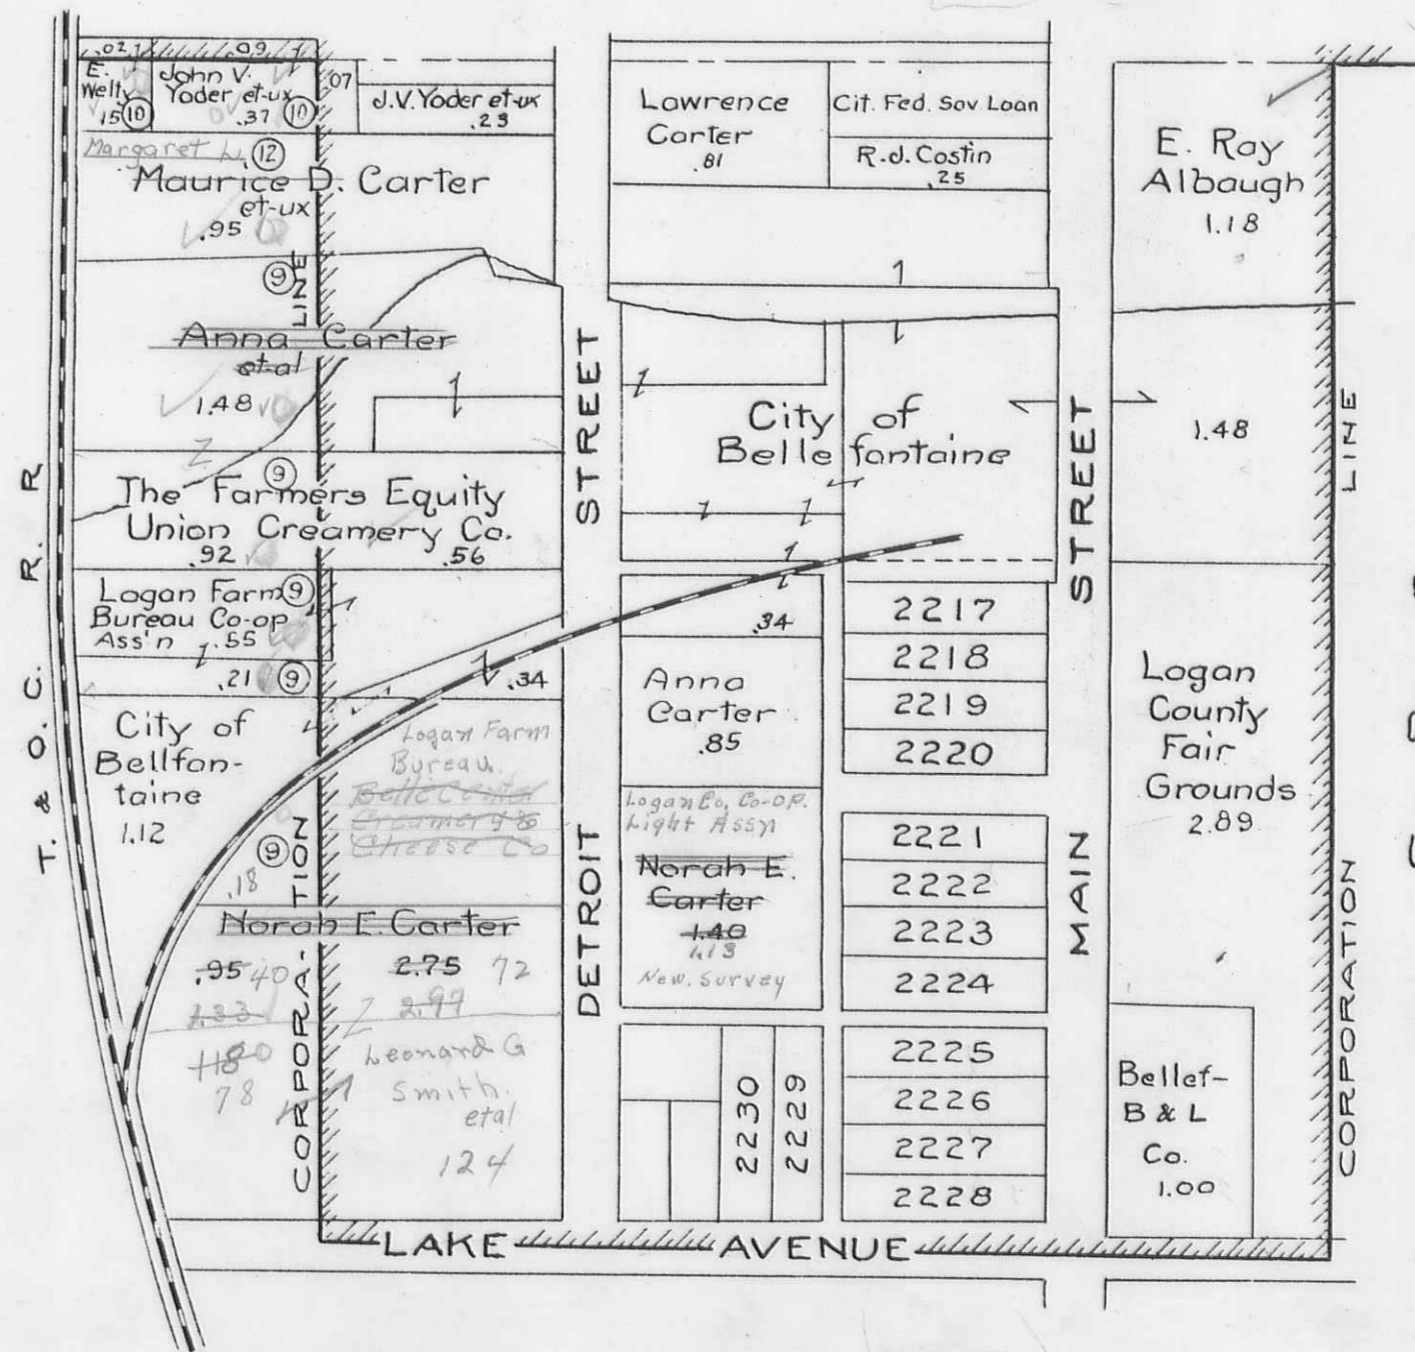


See Page 2

See Page 1

SECTION 36 TOWN 4 RANGE 14


SCALE 10 CHAINS TO THE INCH

See Page 5

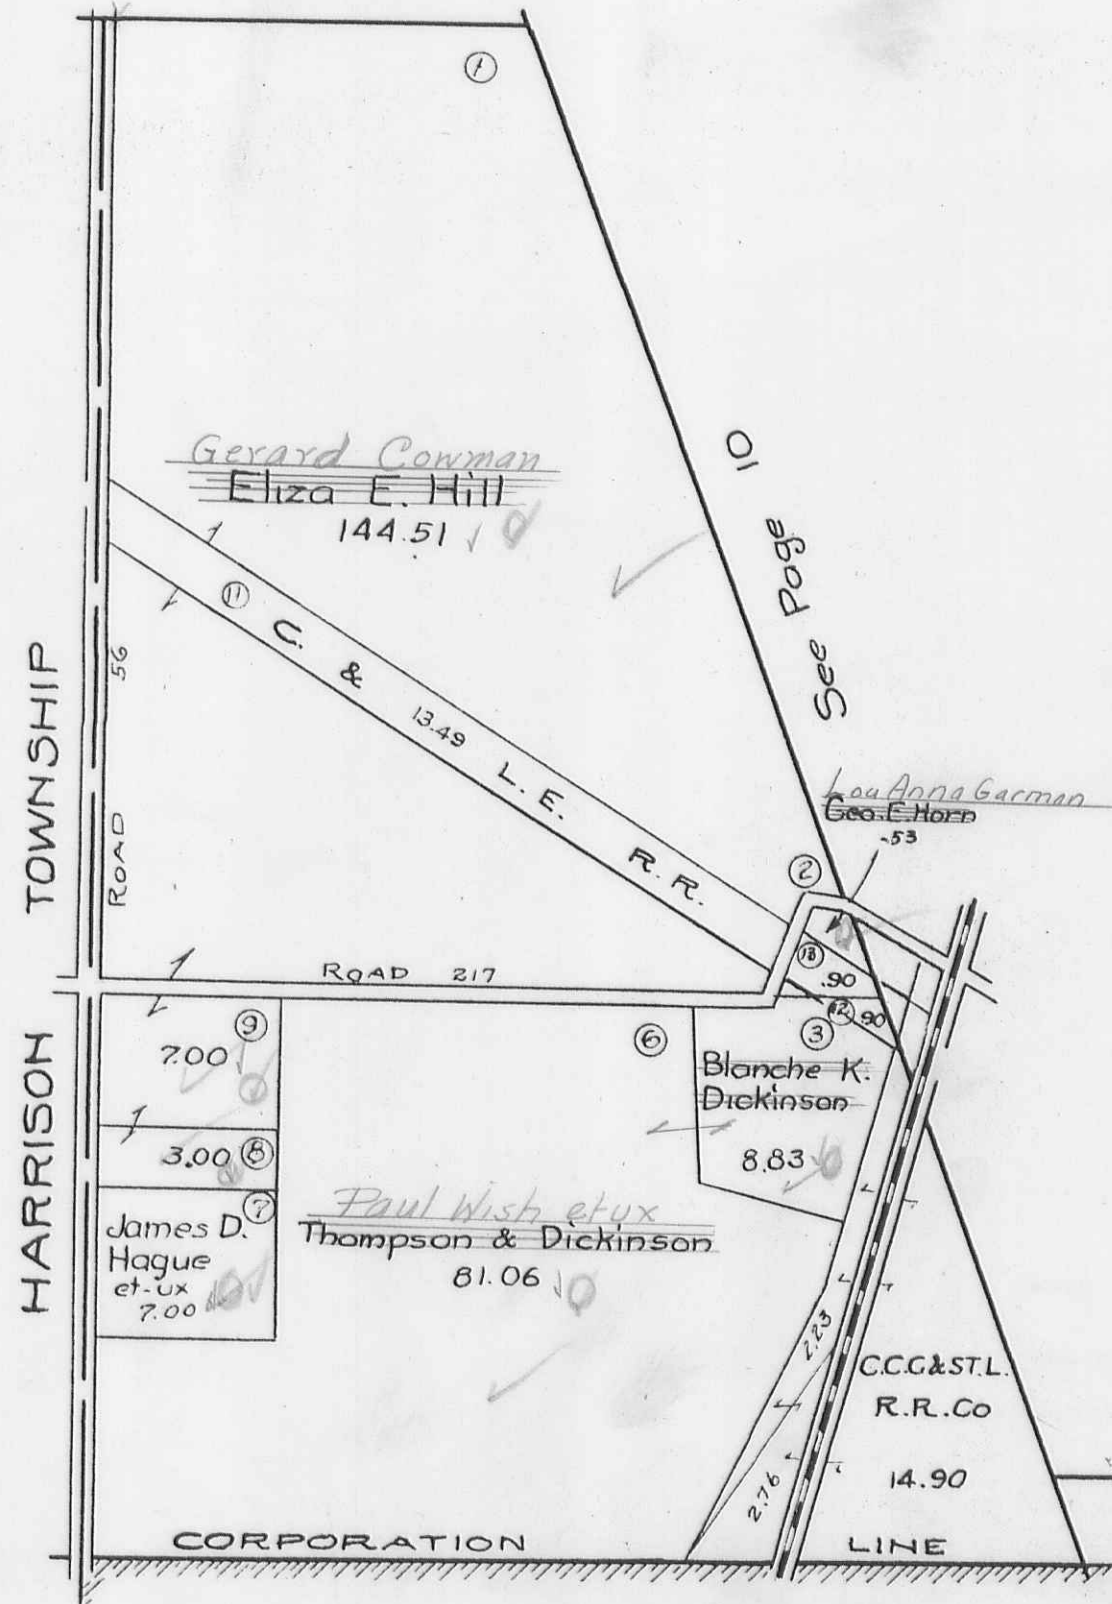

SECTION 31 TOWN 3 RANGE 15

SCALE 10 CHAINS TO THE INCH

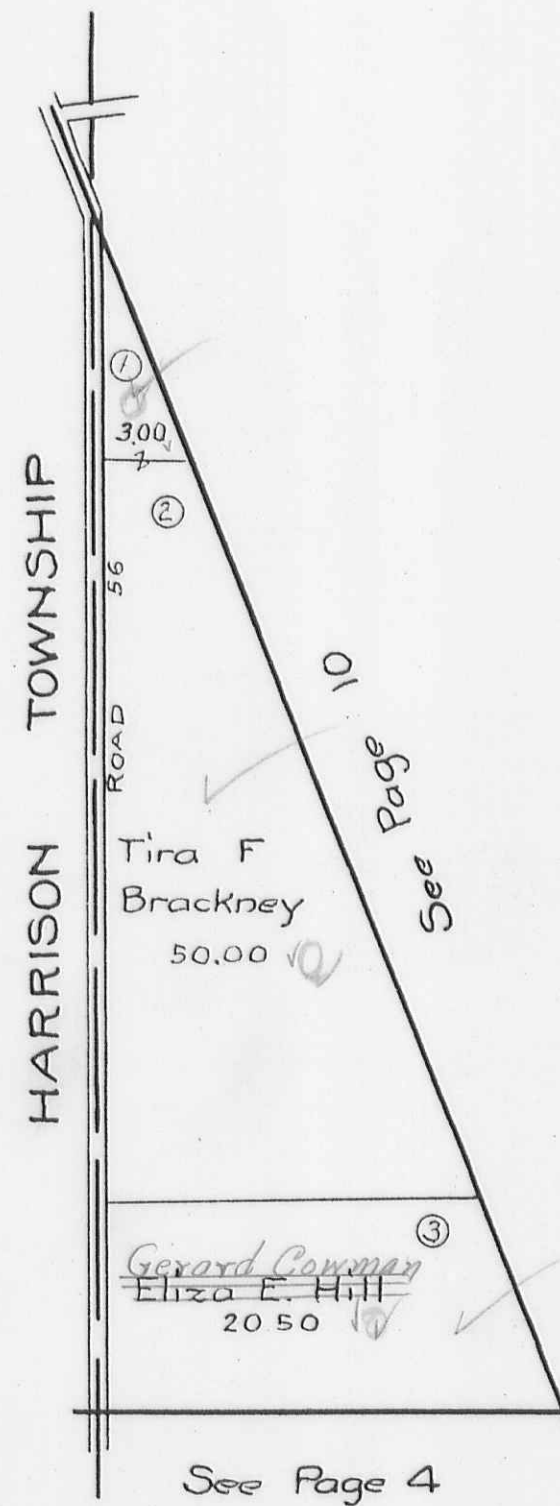


4478
10086
10198

SCALE 10 CHAINS TO THE INCH

See Page 9

Handwritten: New
Sheet

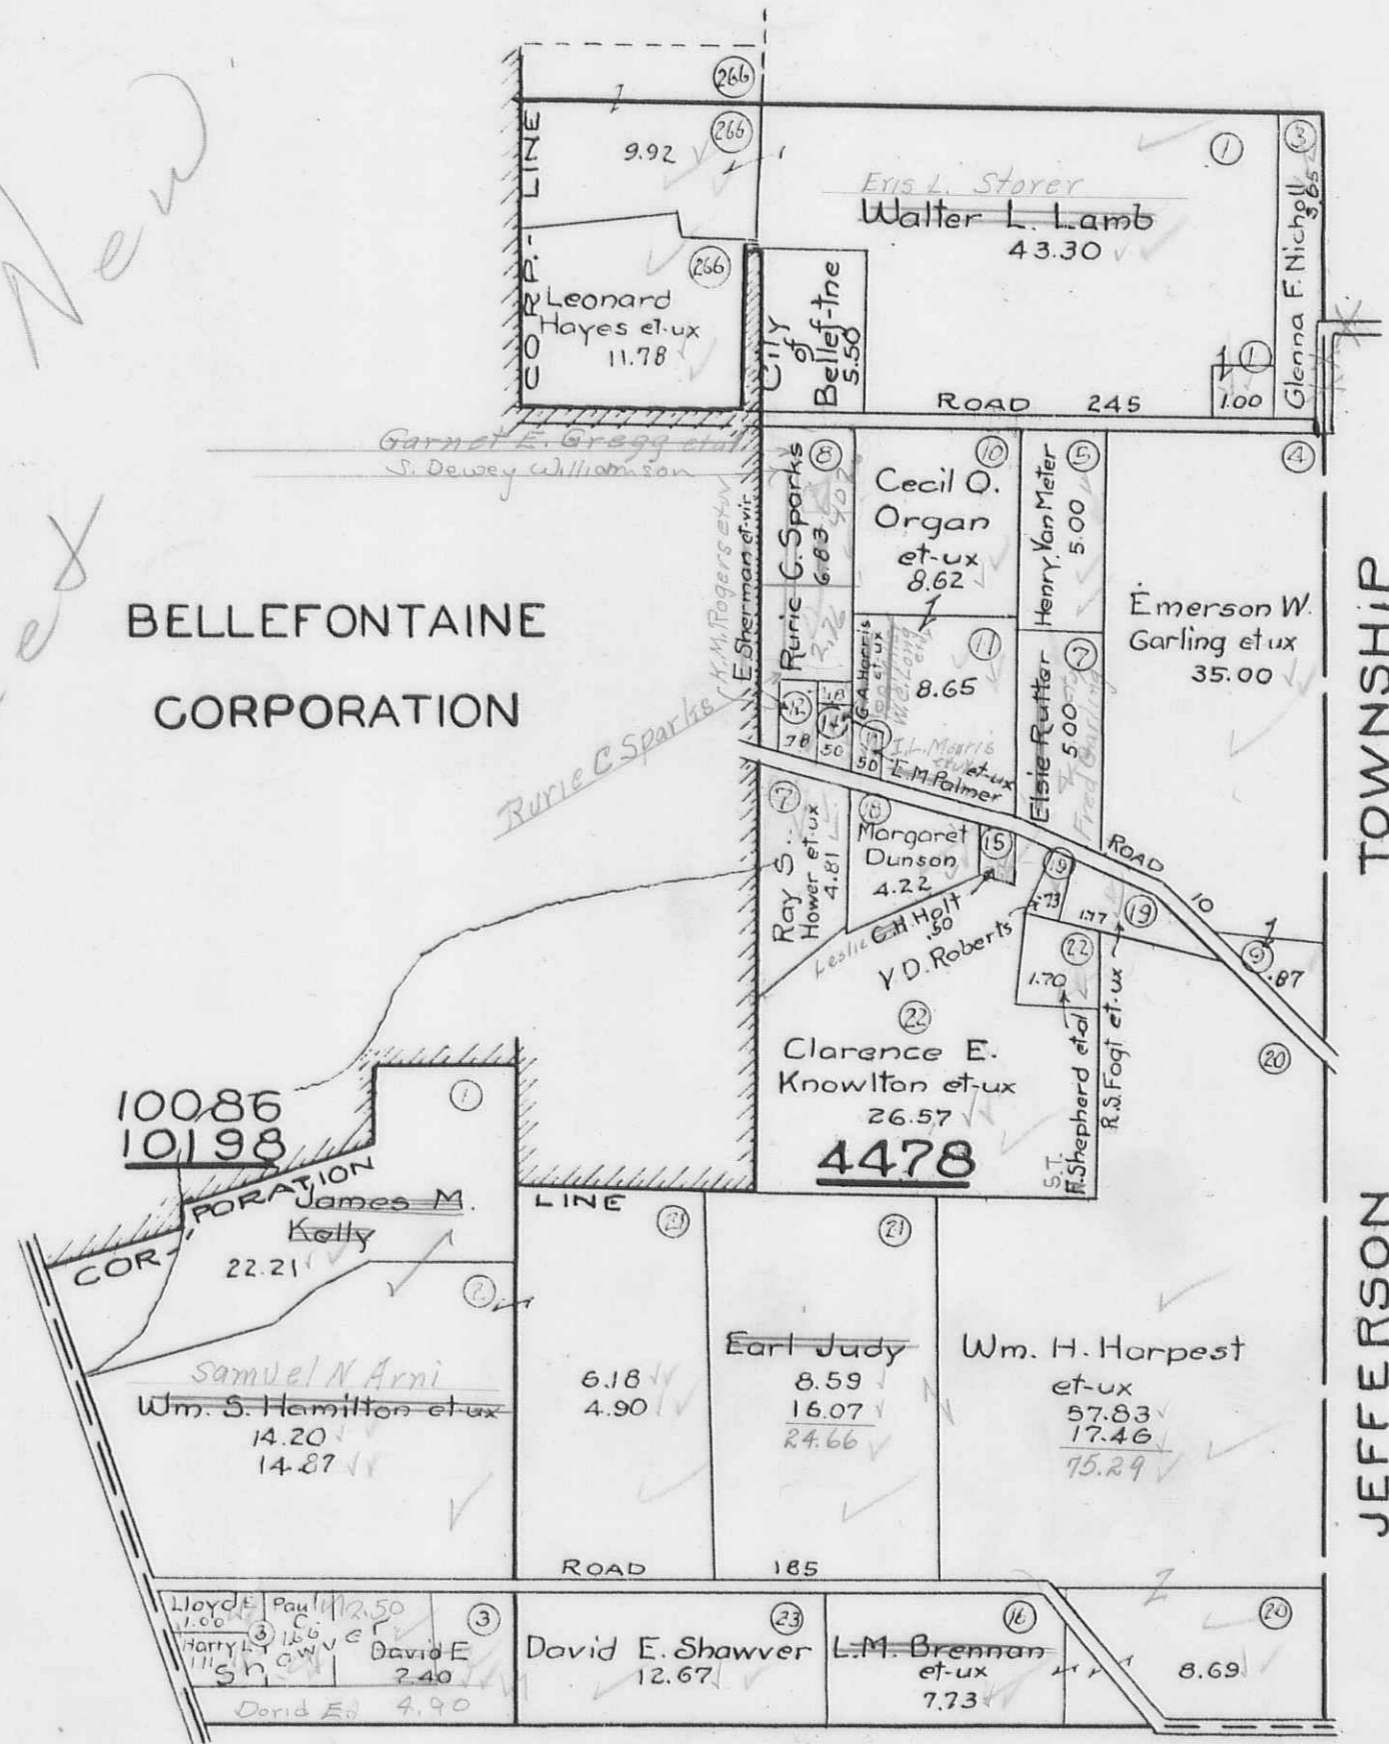


See Page 6

LAKE TOWNSHIP
 VIRGINIA MILITARY SURVEY 5245
 SCALE 10 CHAINS TO THE INCH

677
 471
 156
 1704

See Page 10

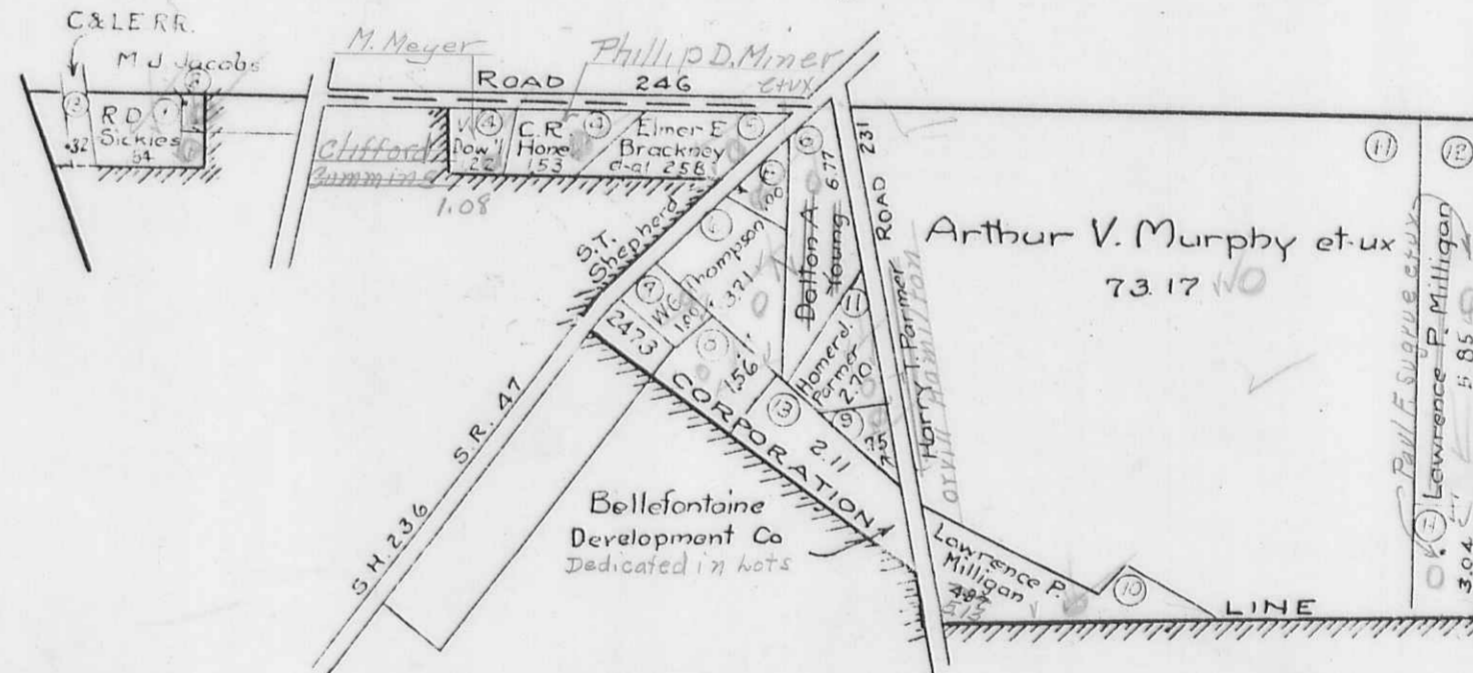

See Page 9

BELLEFONTAINE CORPORATION


LAKE TOWNSHIP
VIRGINIA MILITARY SURVEYS

3683
4399

SCALE 10 CHAINS TO THE INCH

See Page 11

See Page 8

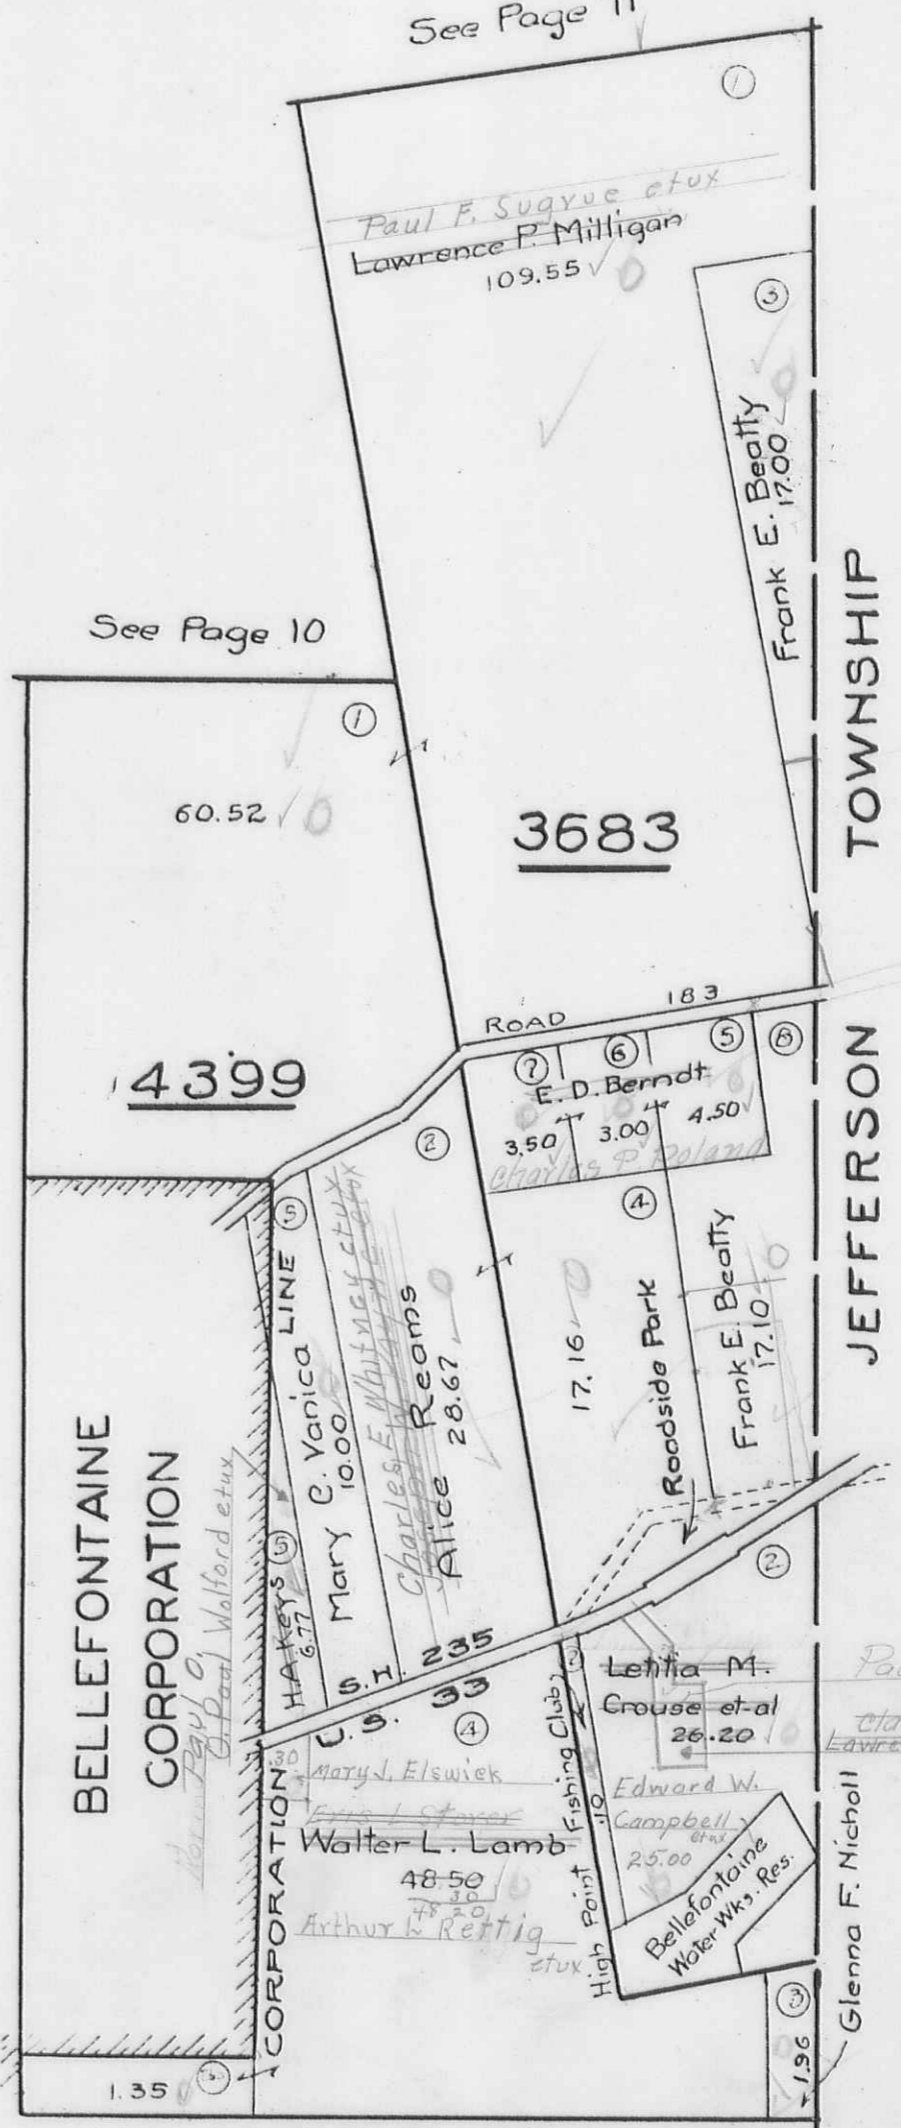

See Page 7

Paul T. Chiles
Clara A. Wendling
Lawrence C. Stevenson et ux 1.20 A.

VIRGINIA MILITARY SURVEY 2873

SCALE 10 CHAINS TO THE INCH


See Page 12

See Page 5

See Page 4

See Page 11

See Page 9

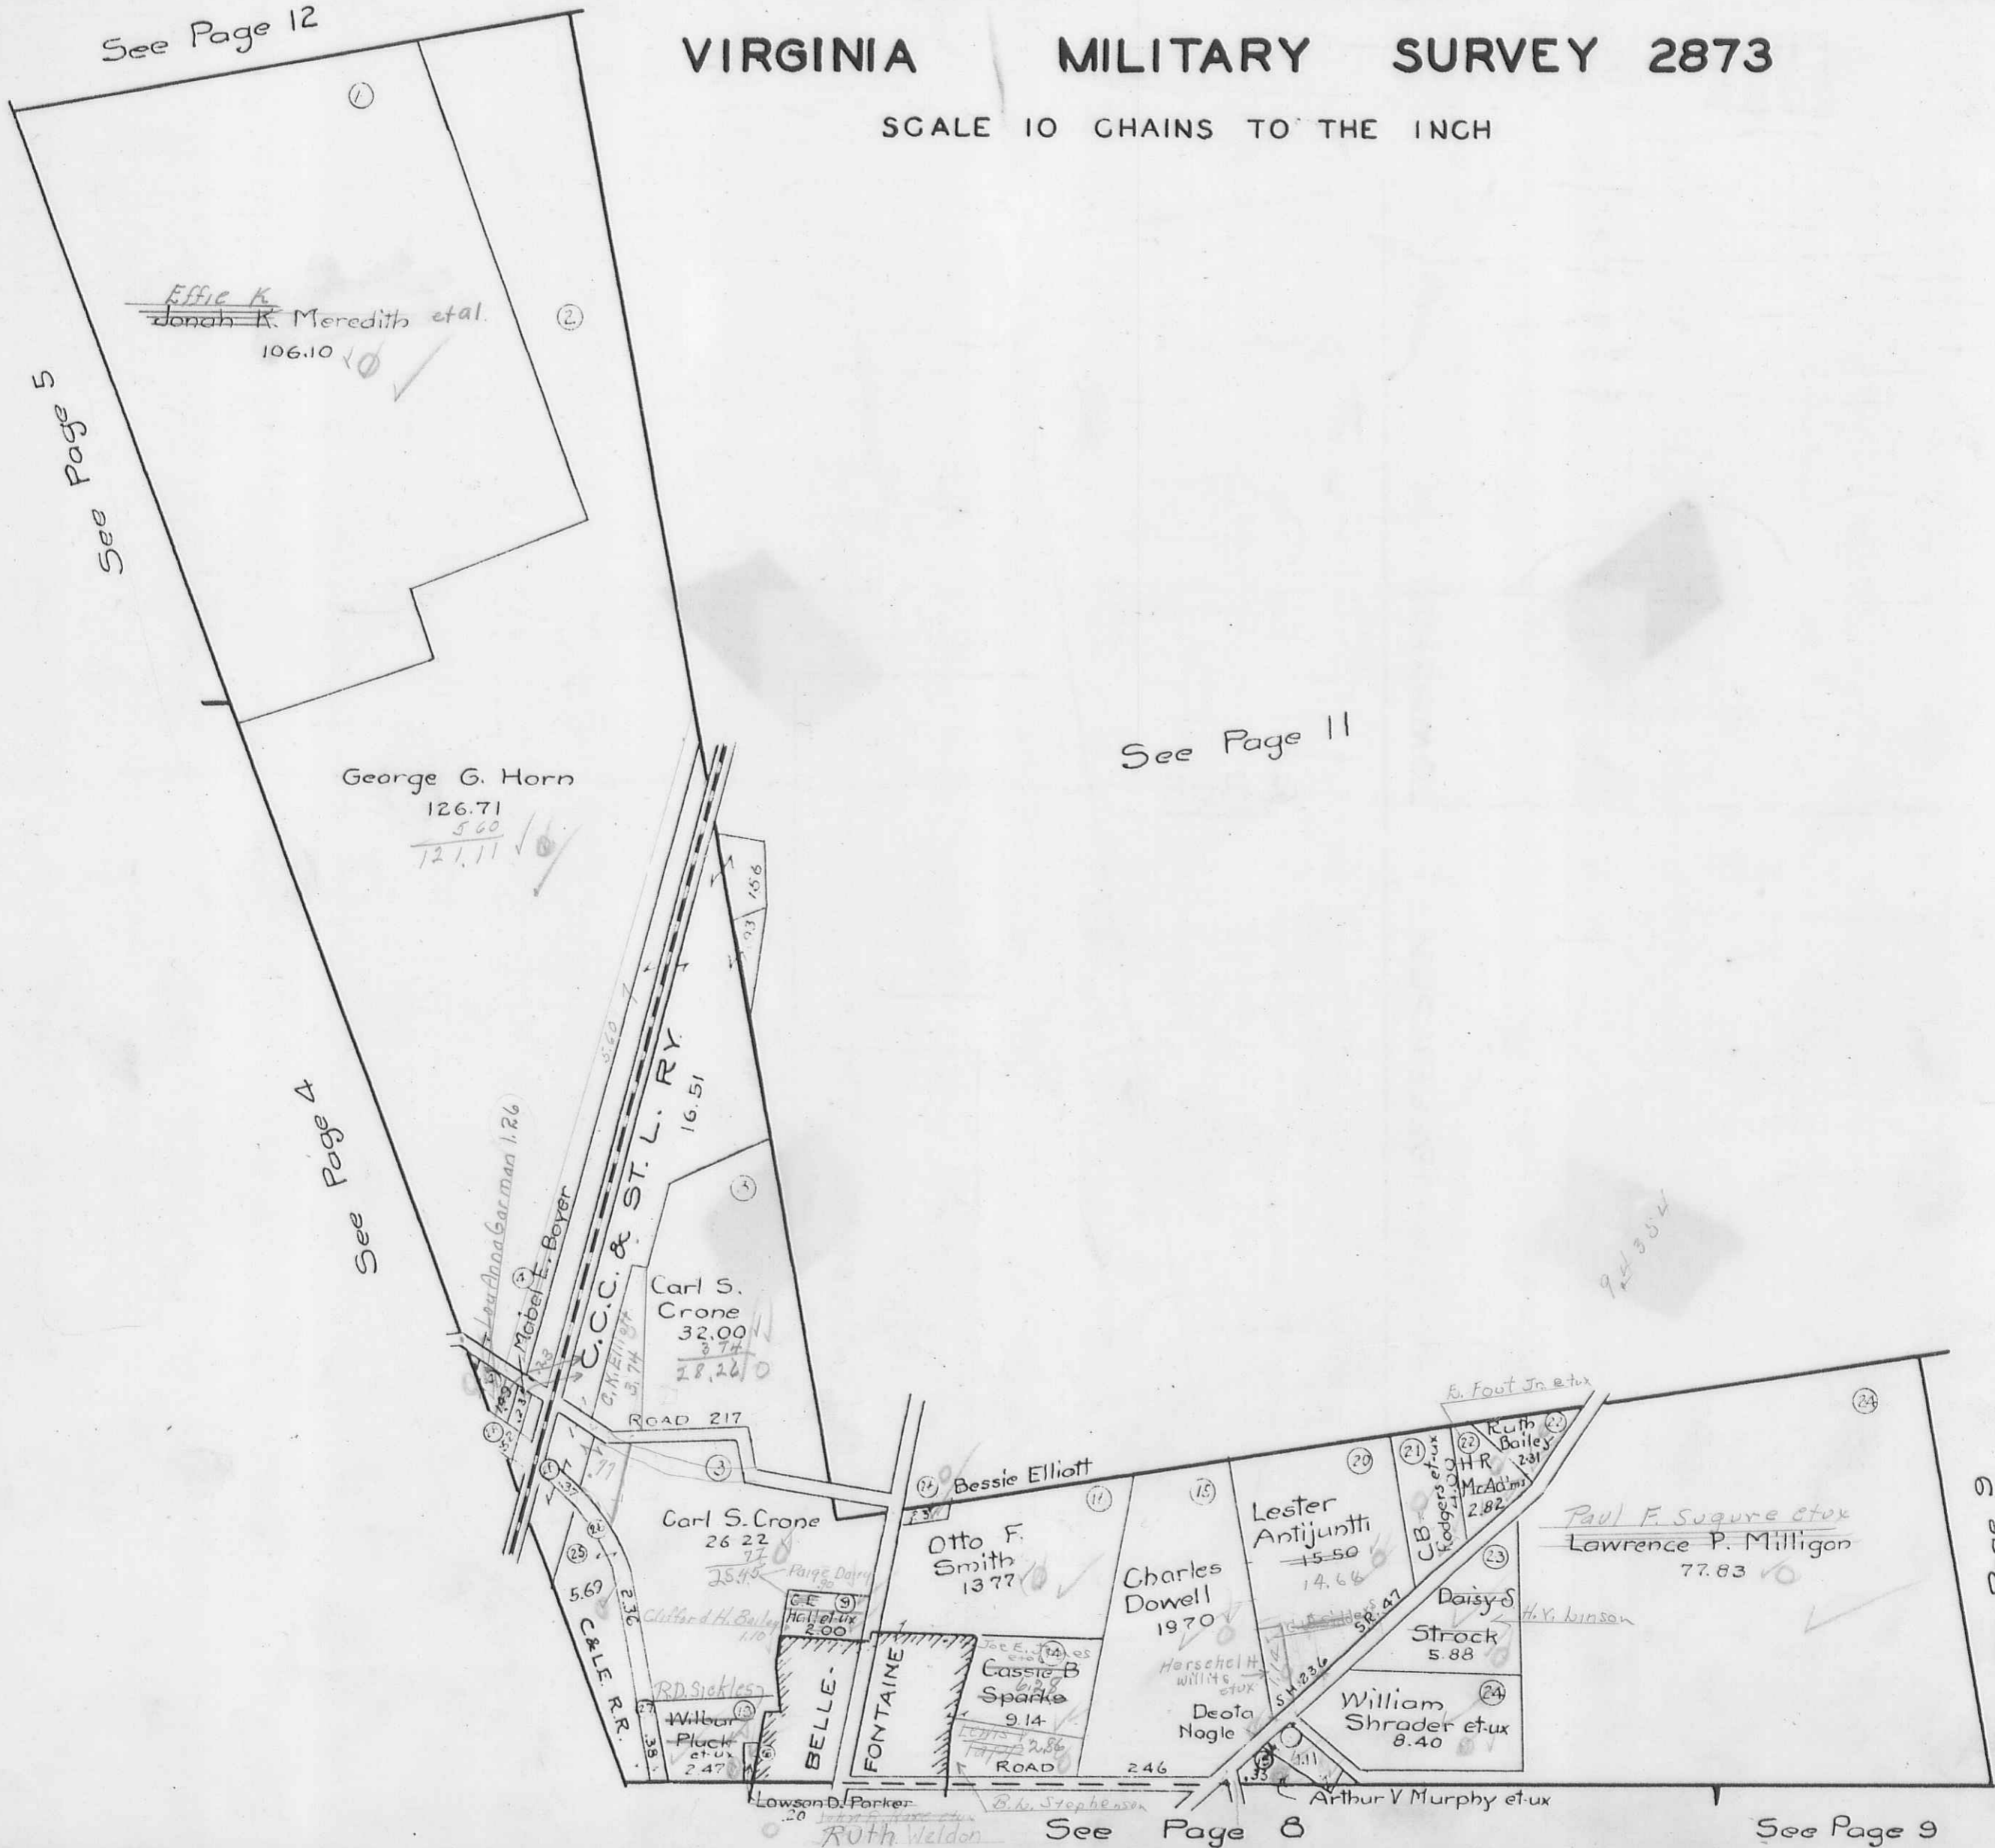


VIRGINIA MILITARY SURVEYS

3317
3442

SCALE 10 CHAINS TO THE INCH

See Page 12

See Page 13

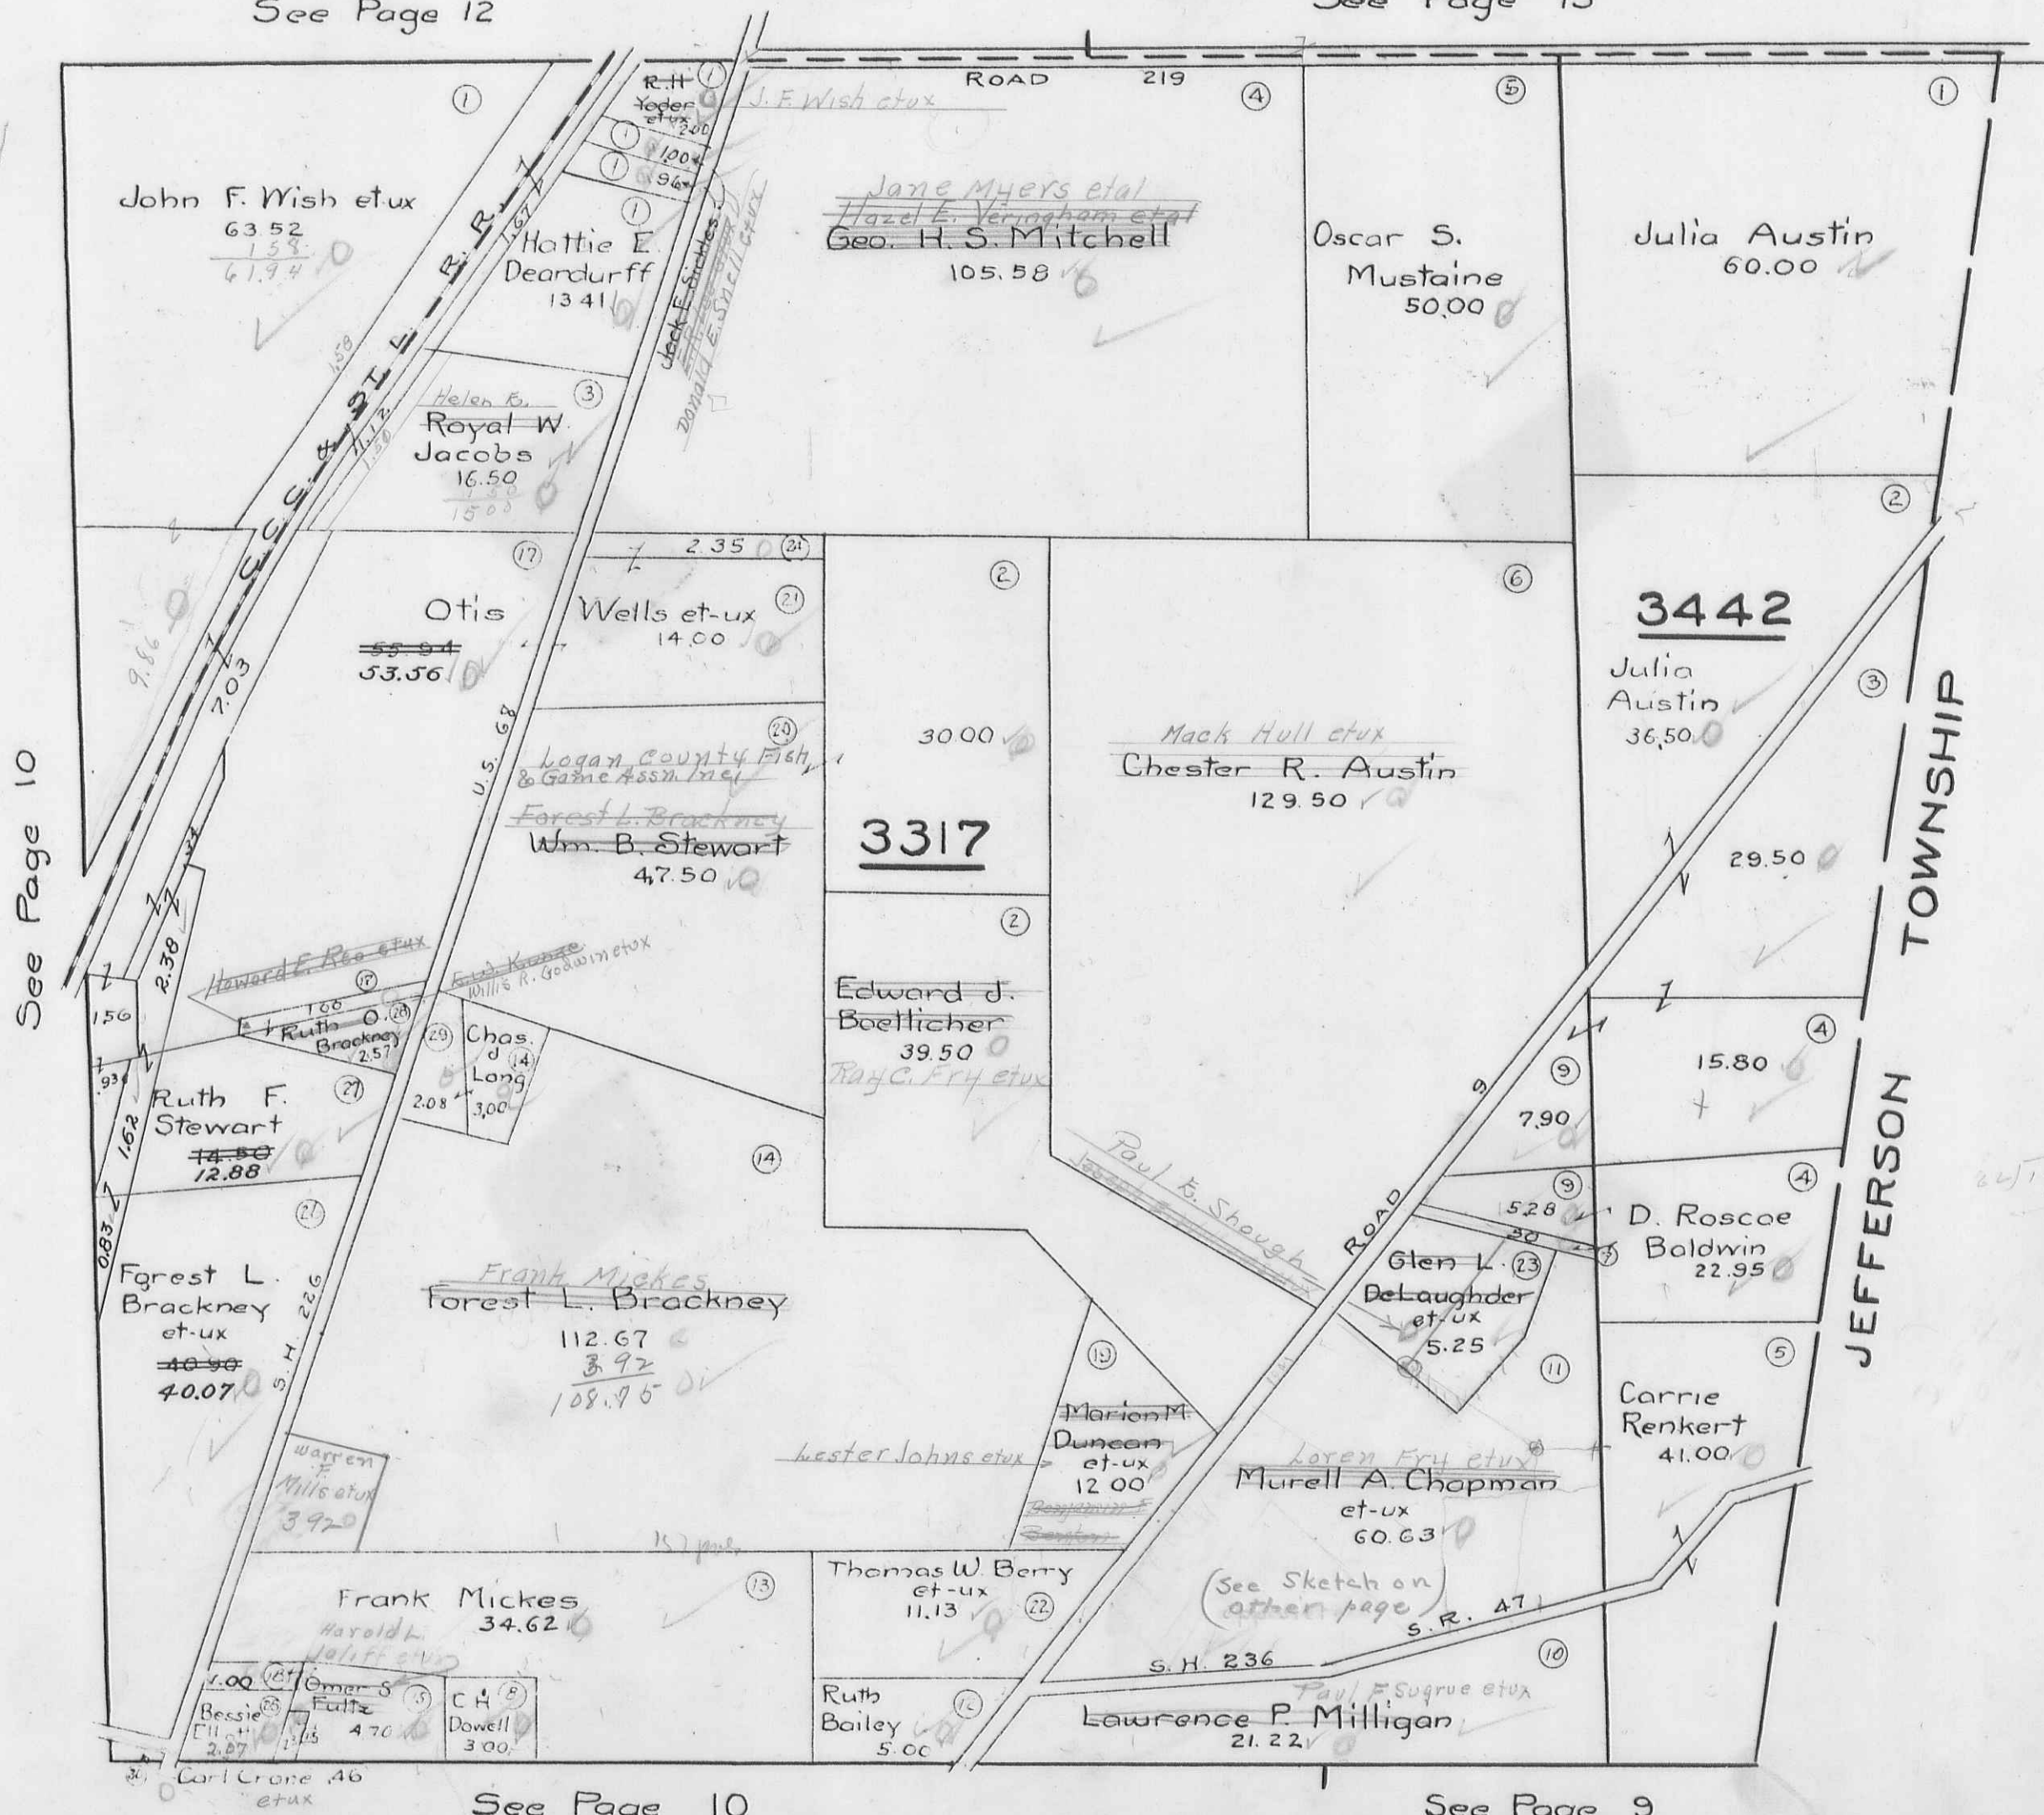


See Page 10

JEFFERSON TOWNSHIP

See Page 10

See Page 9

McARTHUR TOWNSHIP

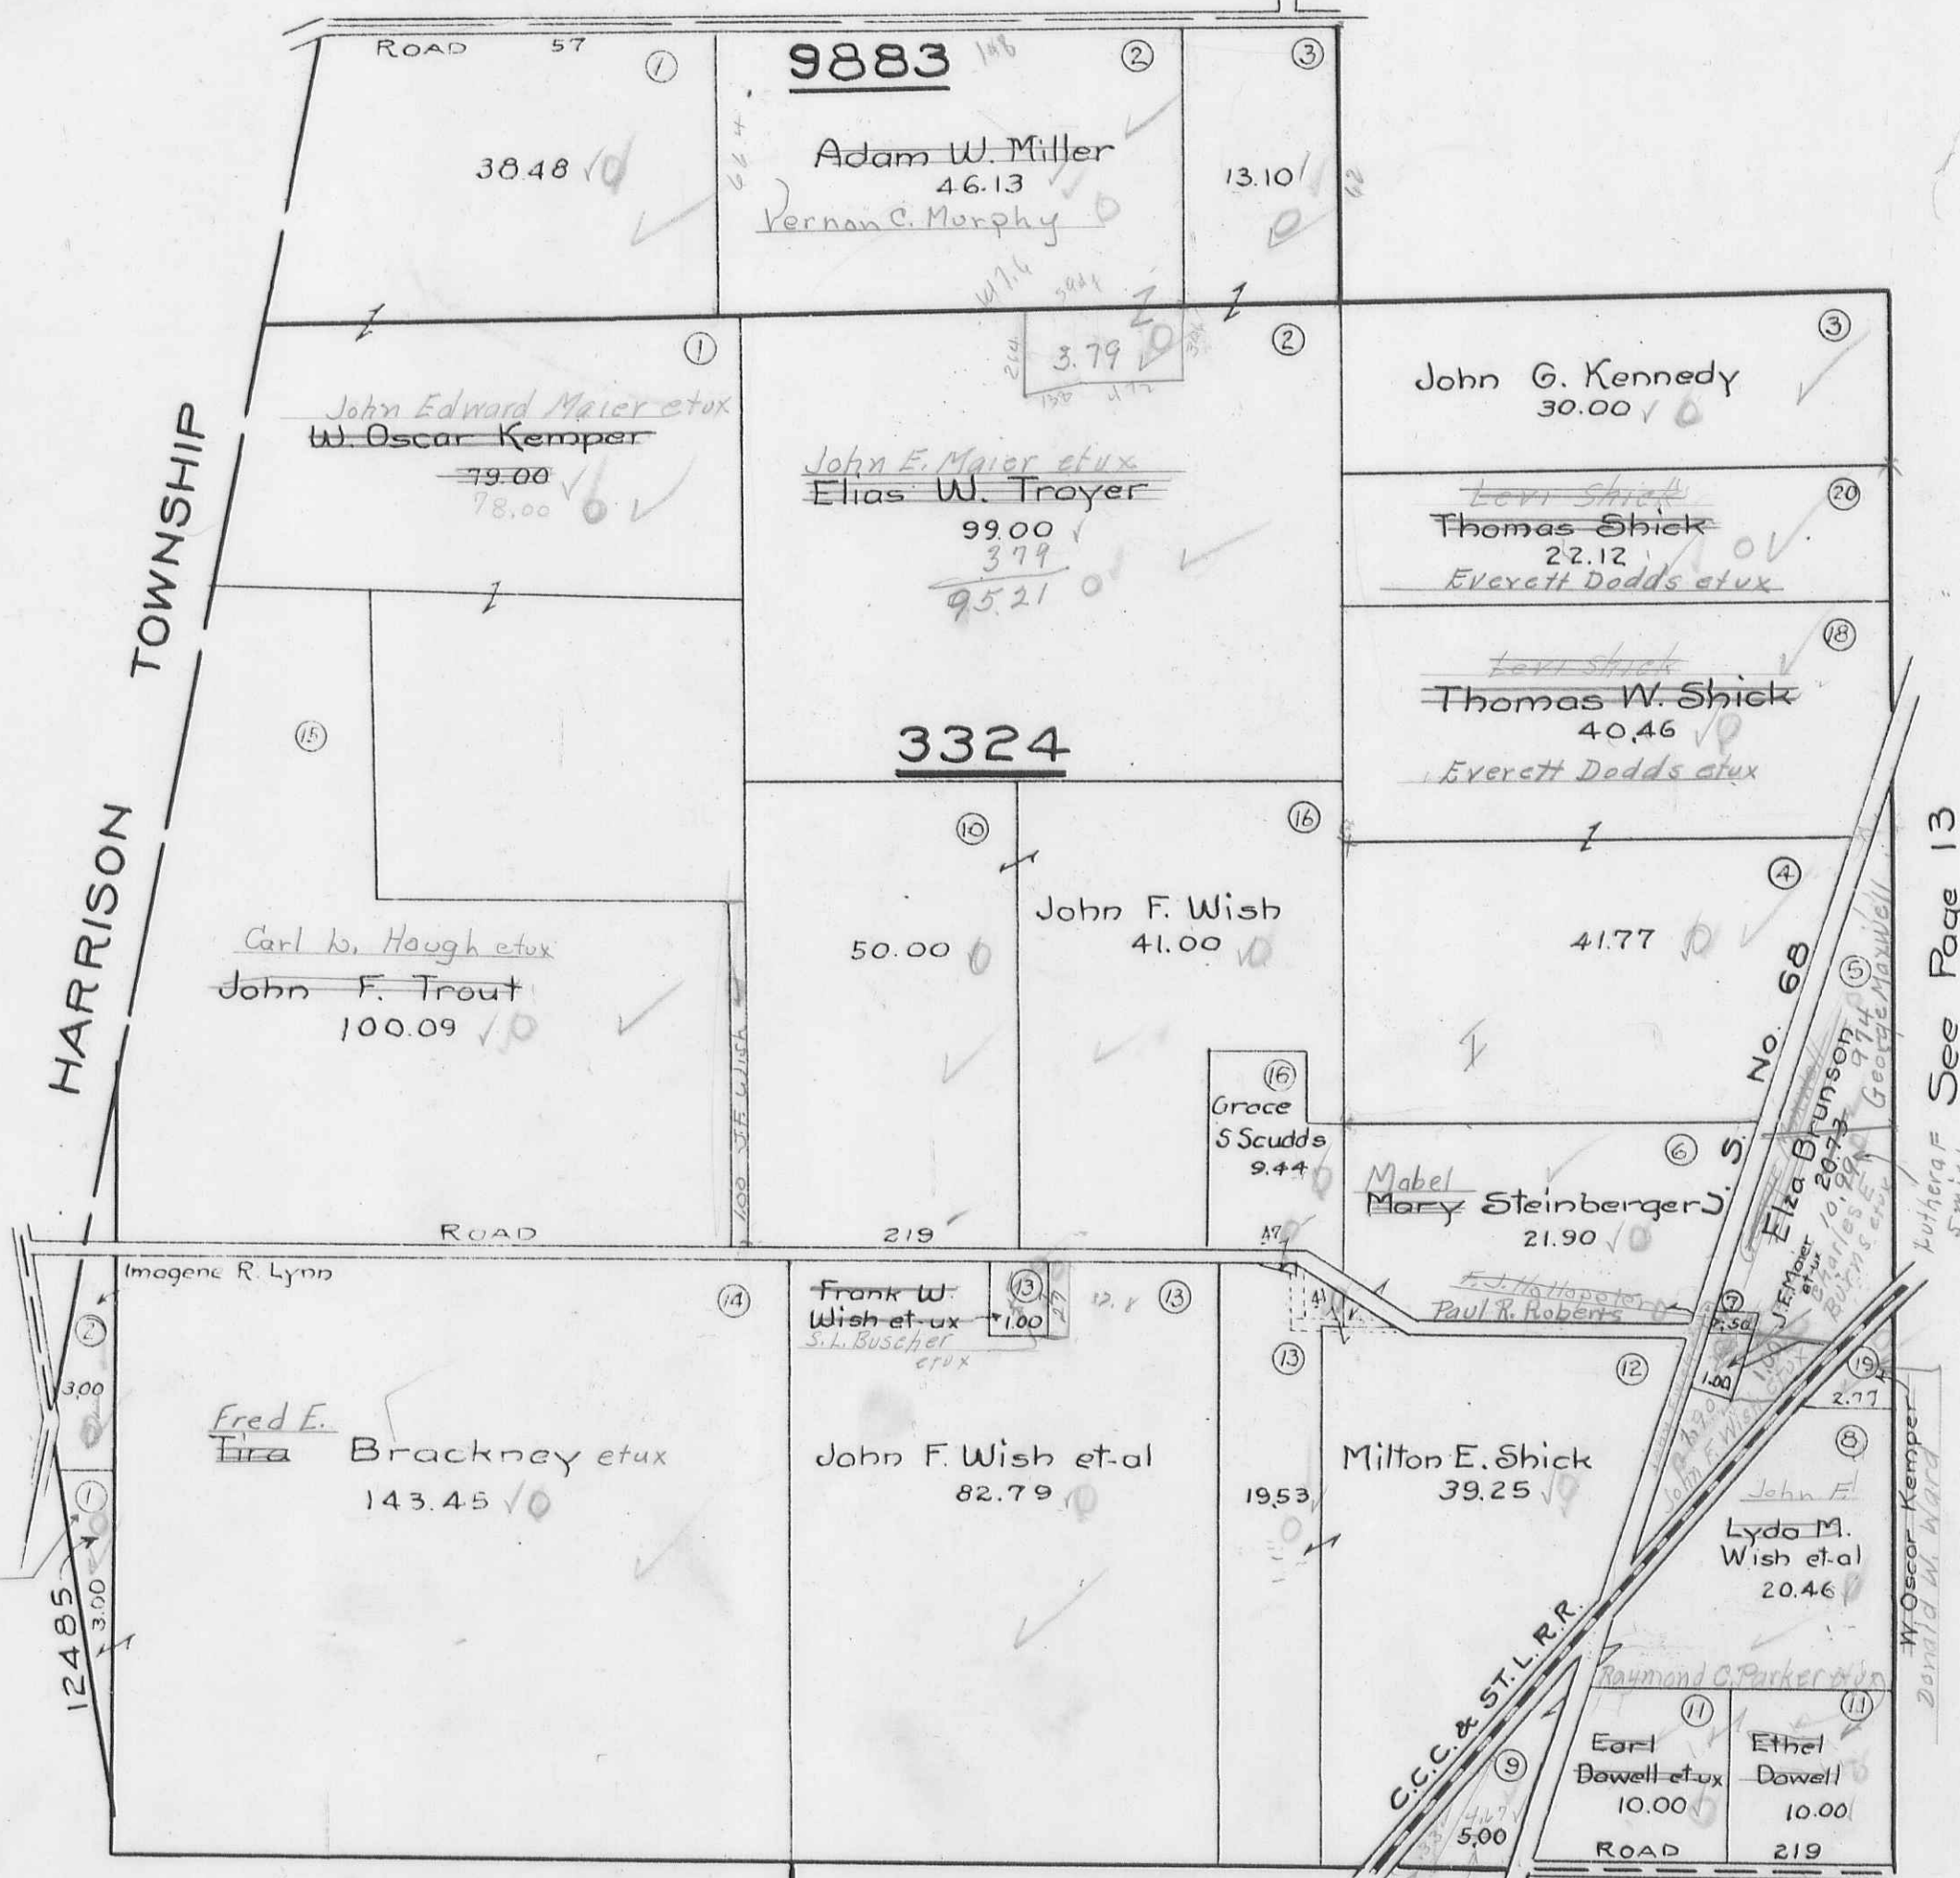

HARRISON TOWNSHIP

See Page 13

See Page 10

See Page 11

Tira F. Brackney

C.C.C. & ST. L. R.R.


W. Oscar Kemper
Donald W. Ward

VIRGINIA MILITARY SURVEYS

3322
9884

SCALE 10 CHAINS TO THE INCH

McARTHUR TOWNSHIP

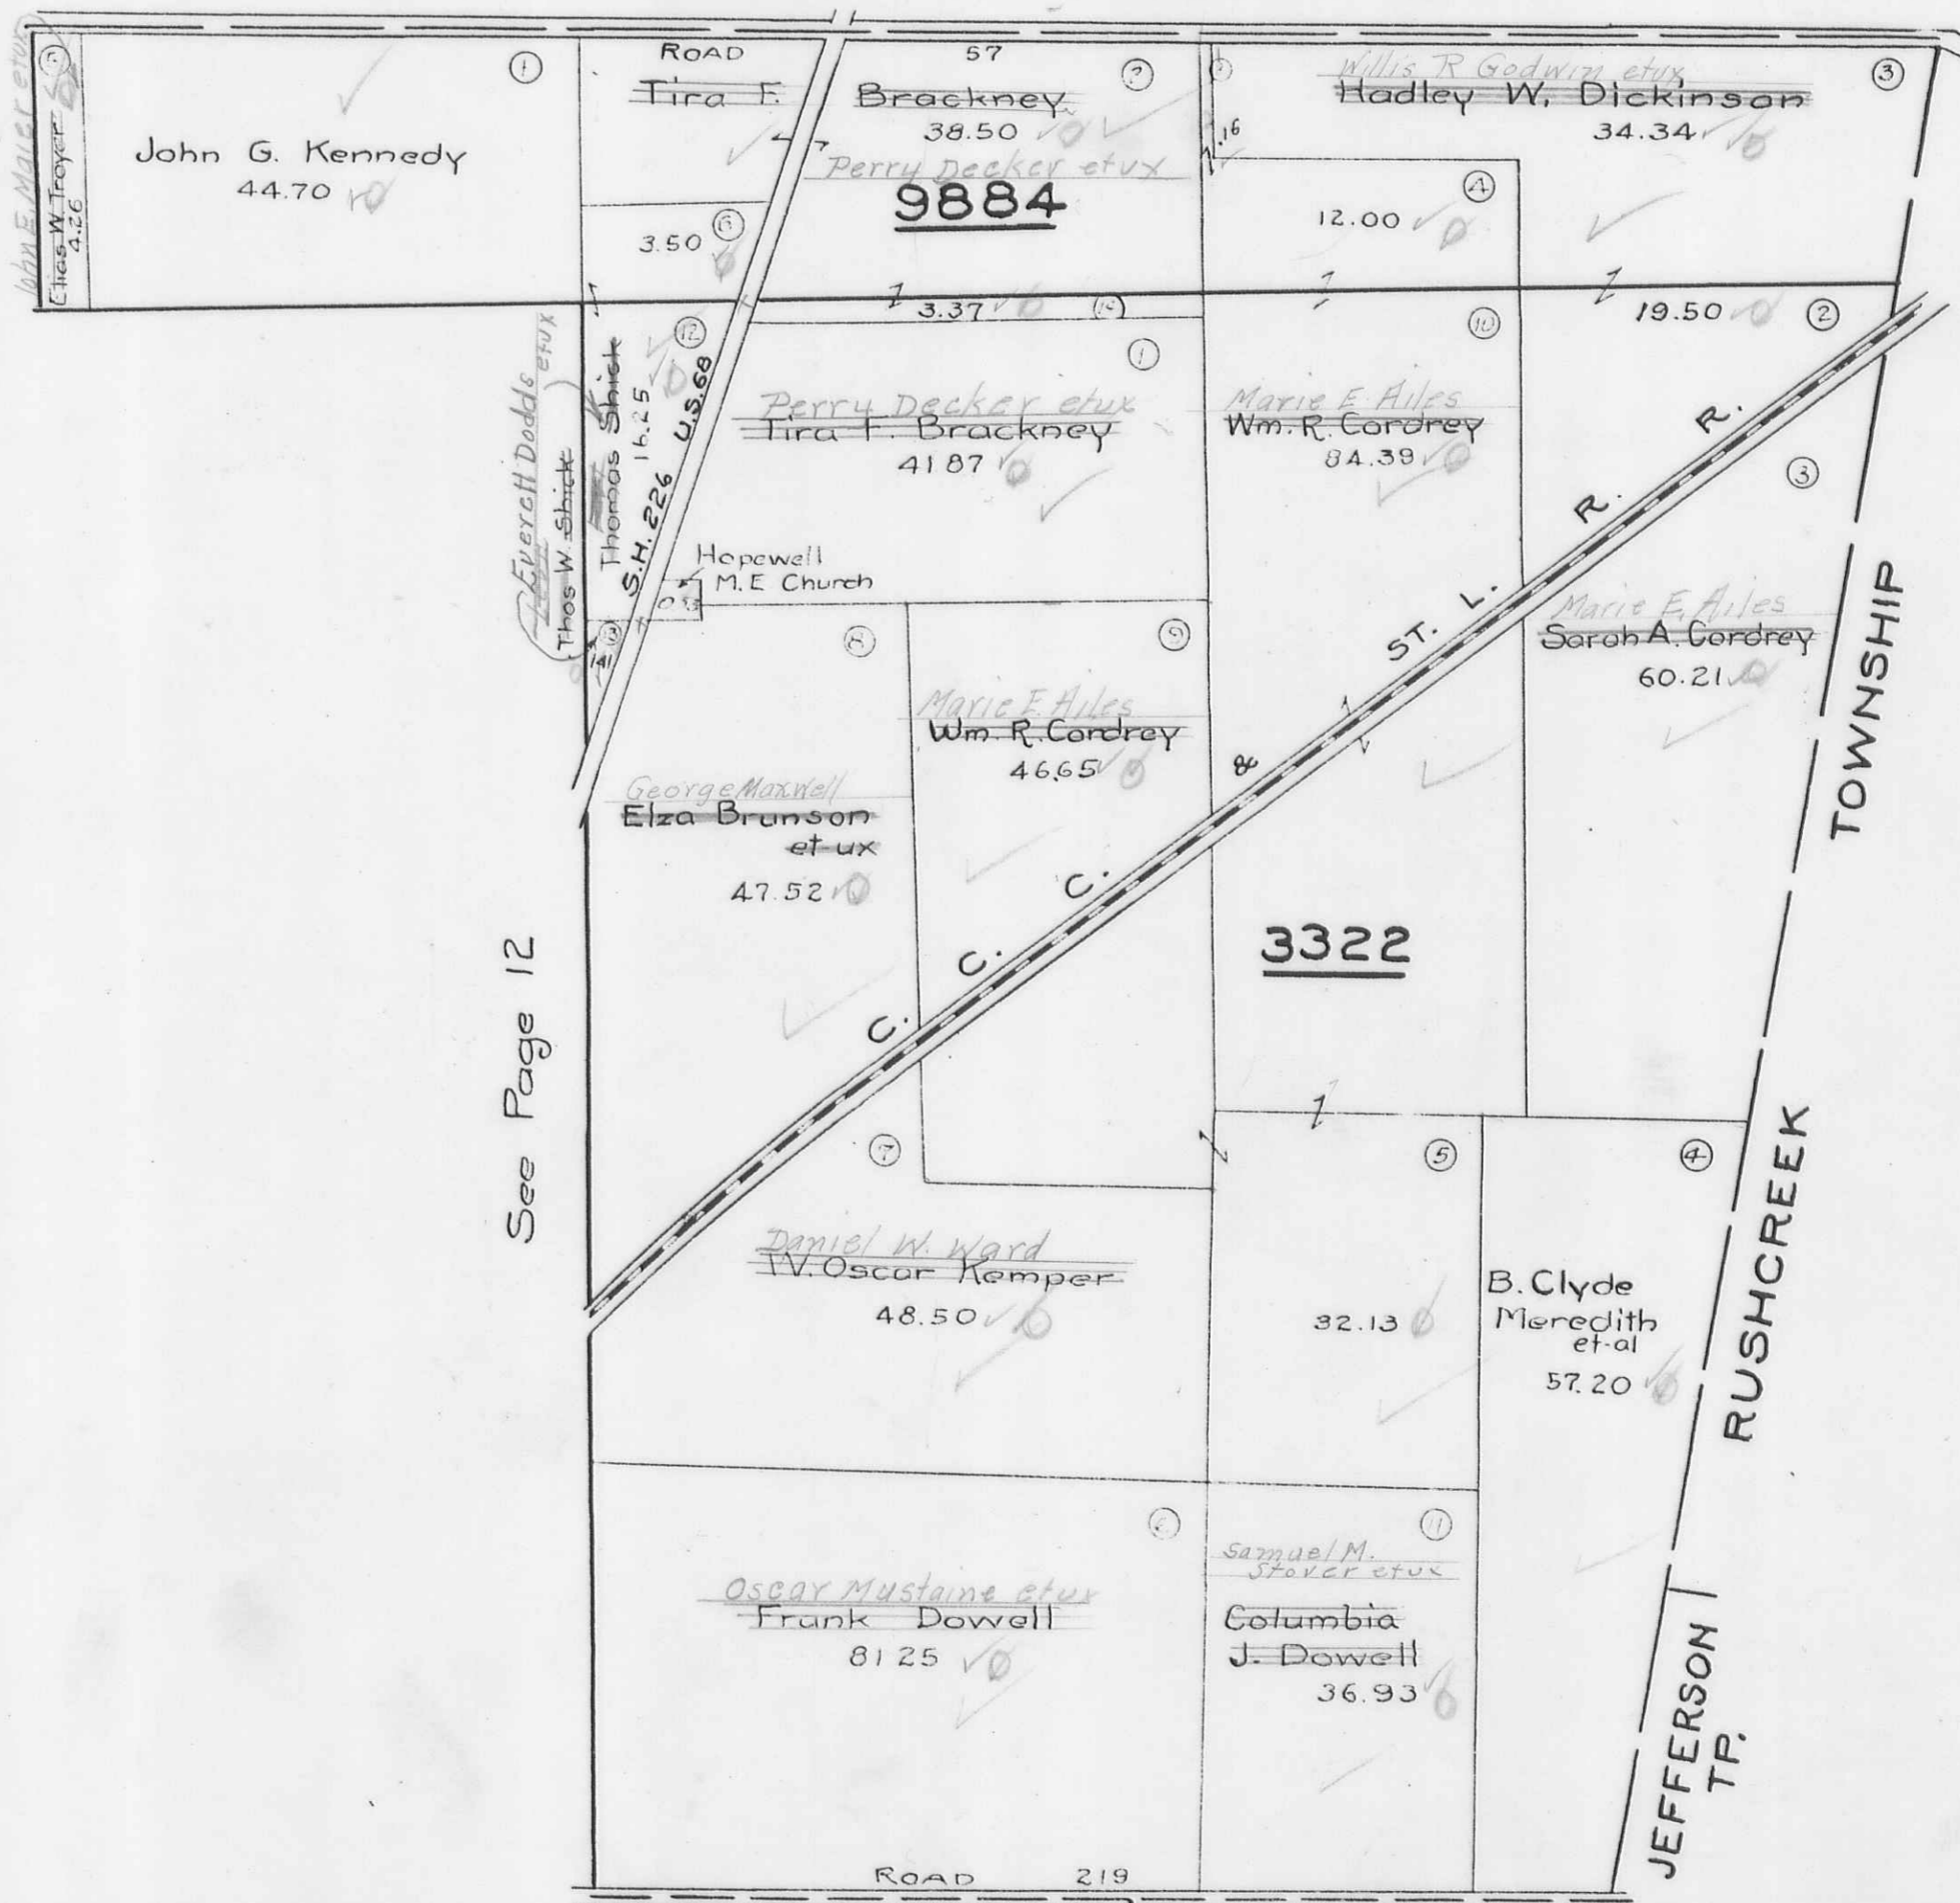


See Page 12

See Page 11

LAKE TOWNSHIP — SECTION 33 TOWN 4 RANGE 14 — PAGE 14
 IRON CITY — BELLEVILLE — IRON CITY HEIGHTS



SCALE 200 FEET TO THE INCH

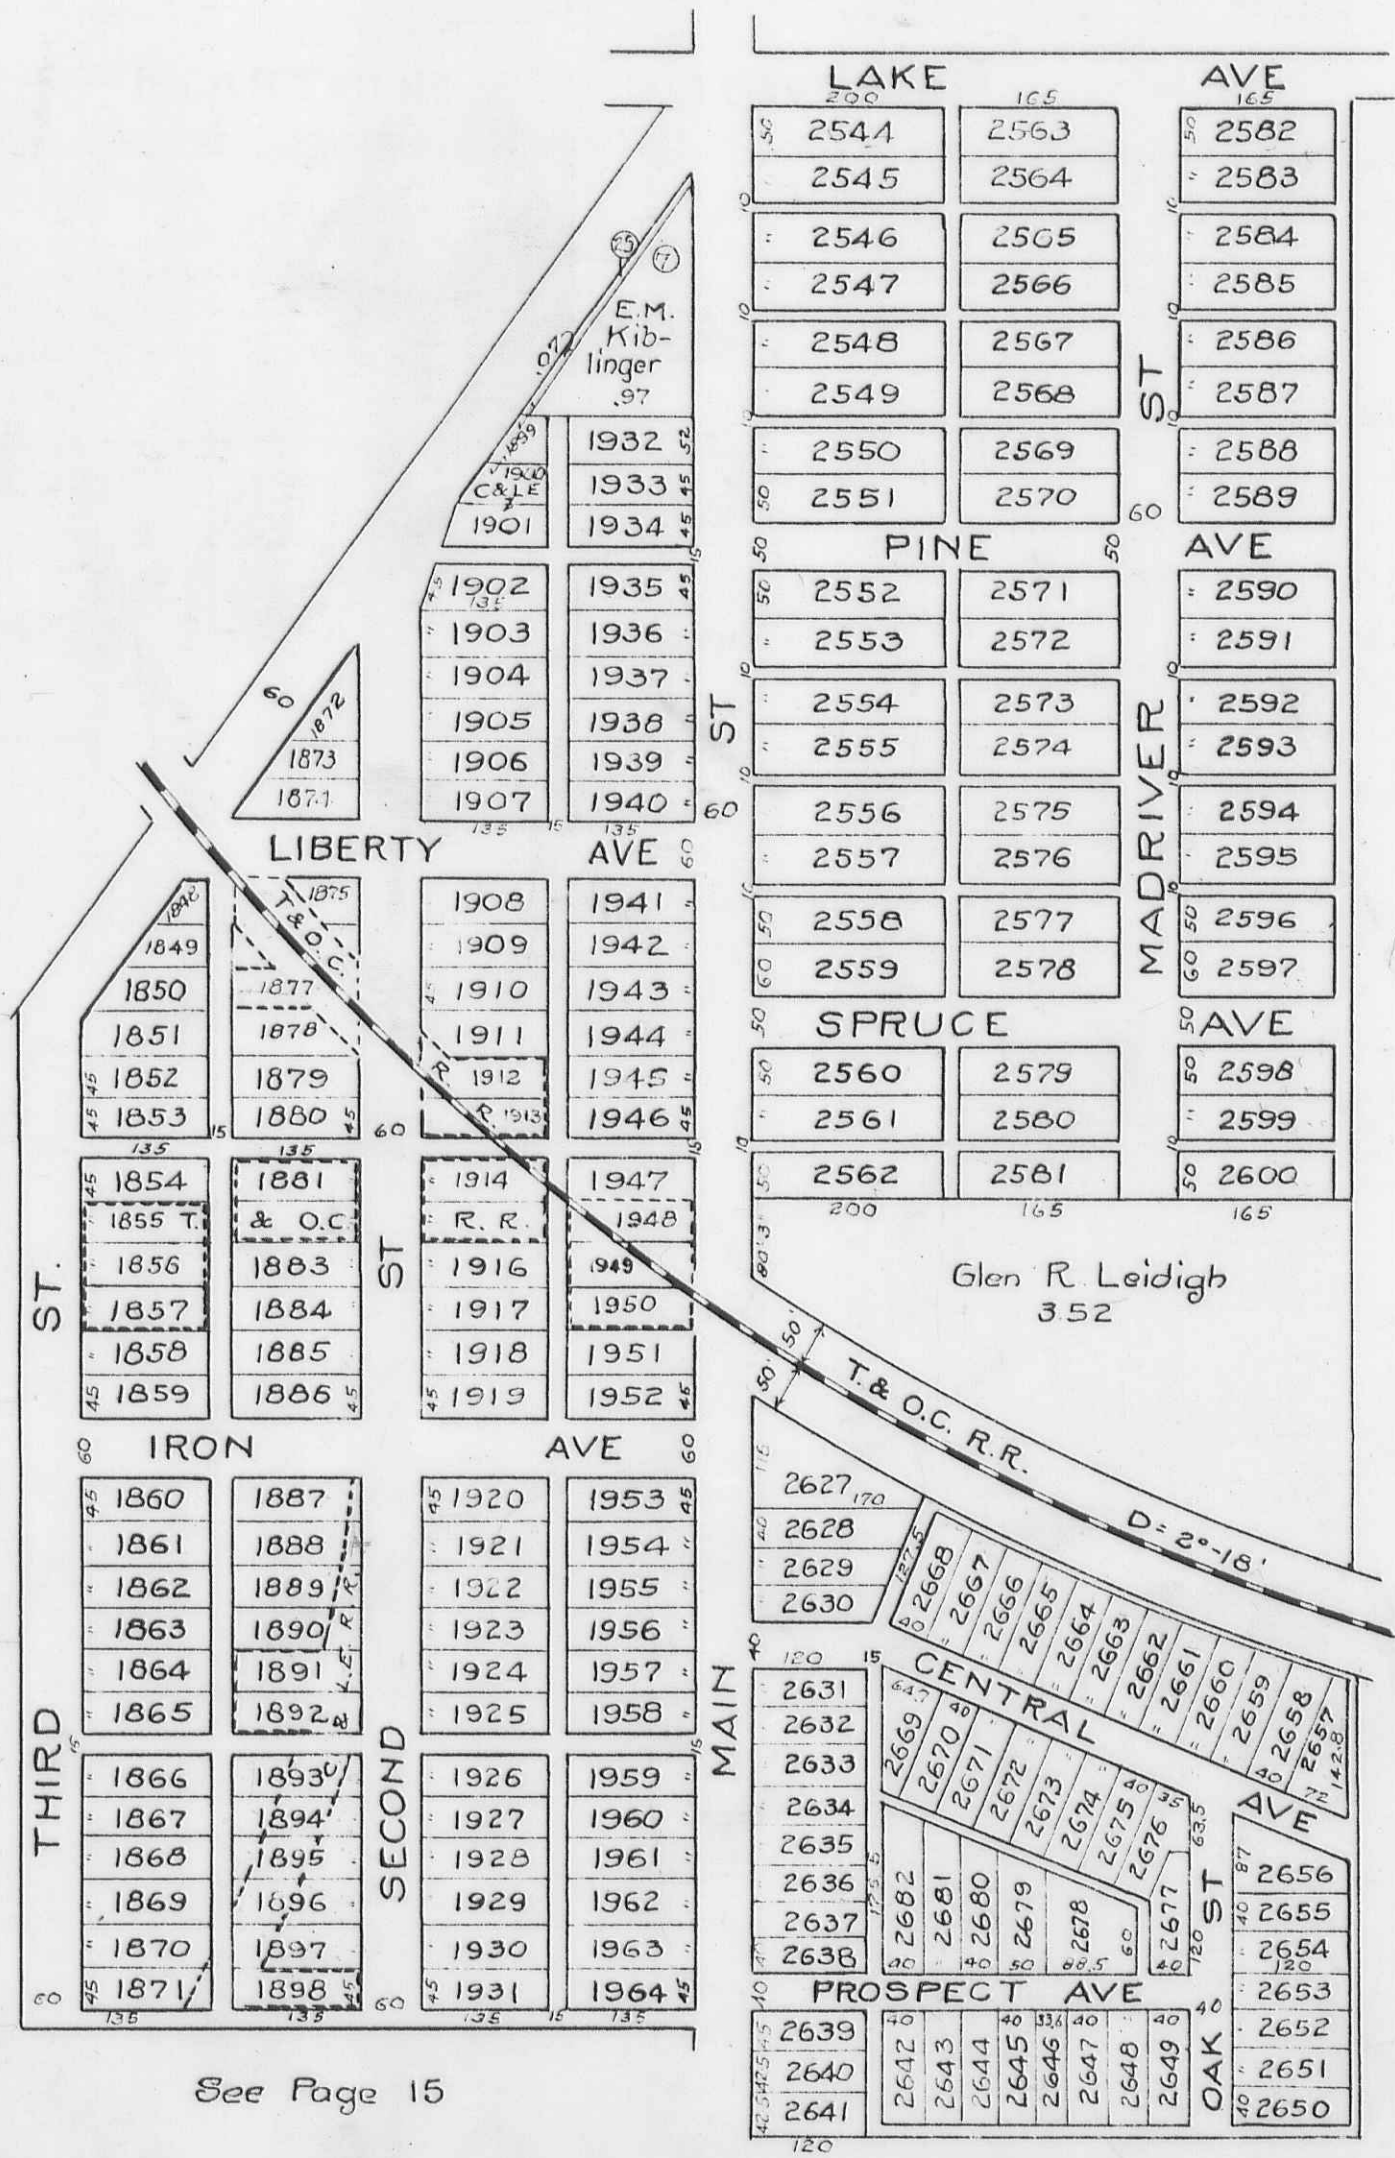

— LOTS —
 IRON CITY ---- 1848 — 1964
 BELLEVILLE --- 2544 — 2600
 IRON CITY HTS. - 2627 — 2862

See Page 15

SCALE 100 FEET TO THE INCH

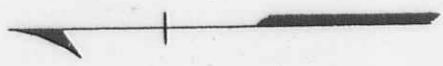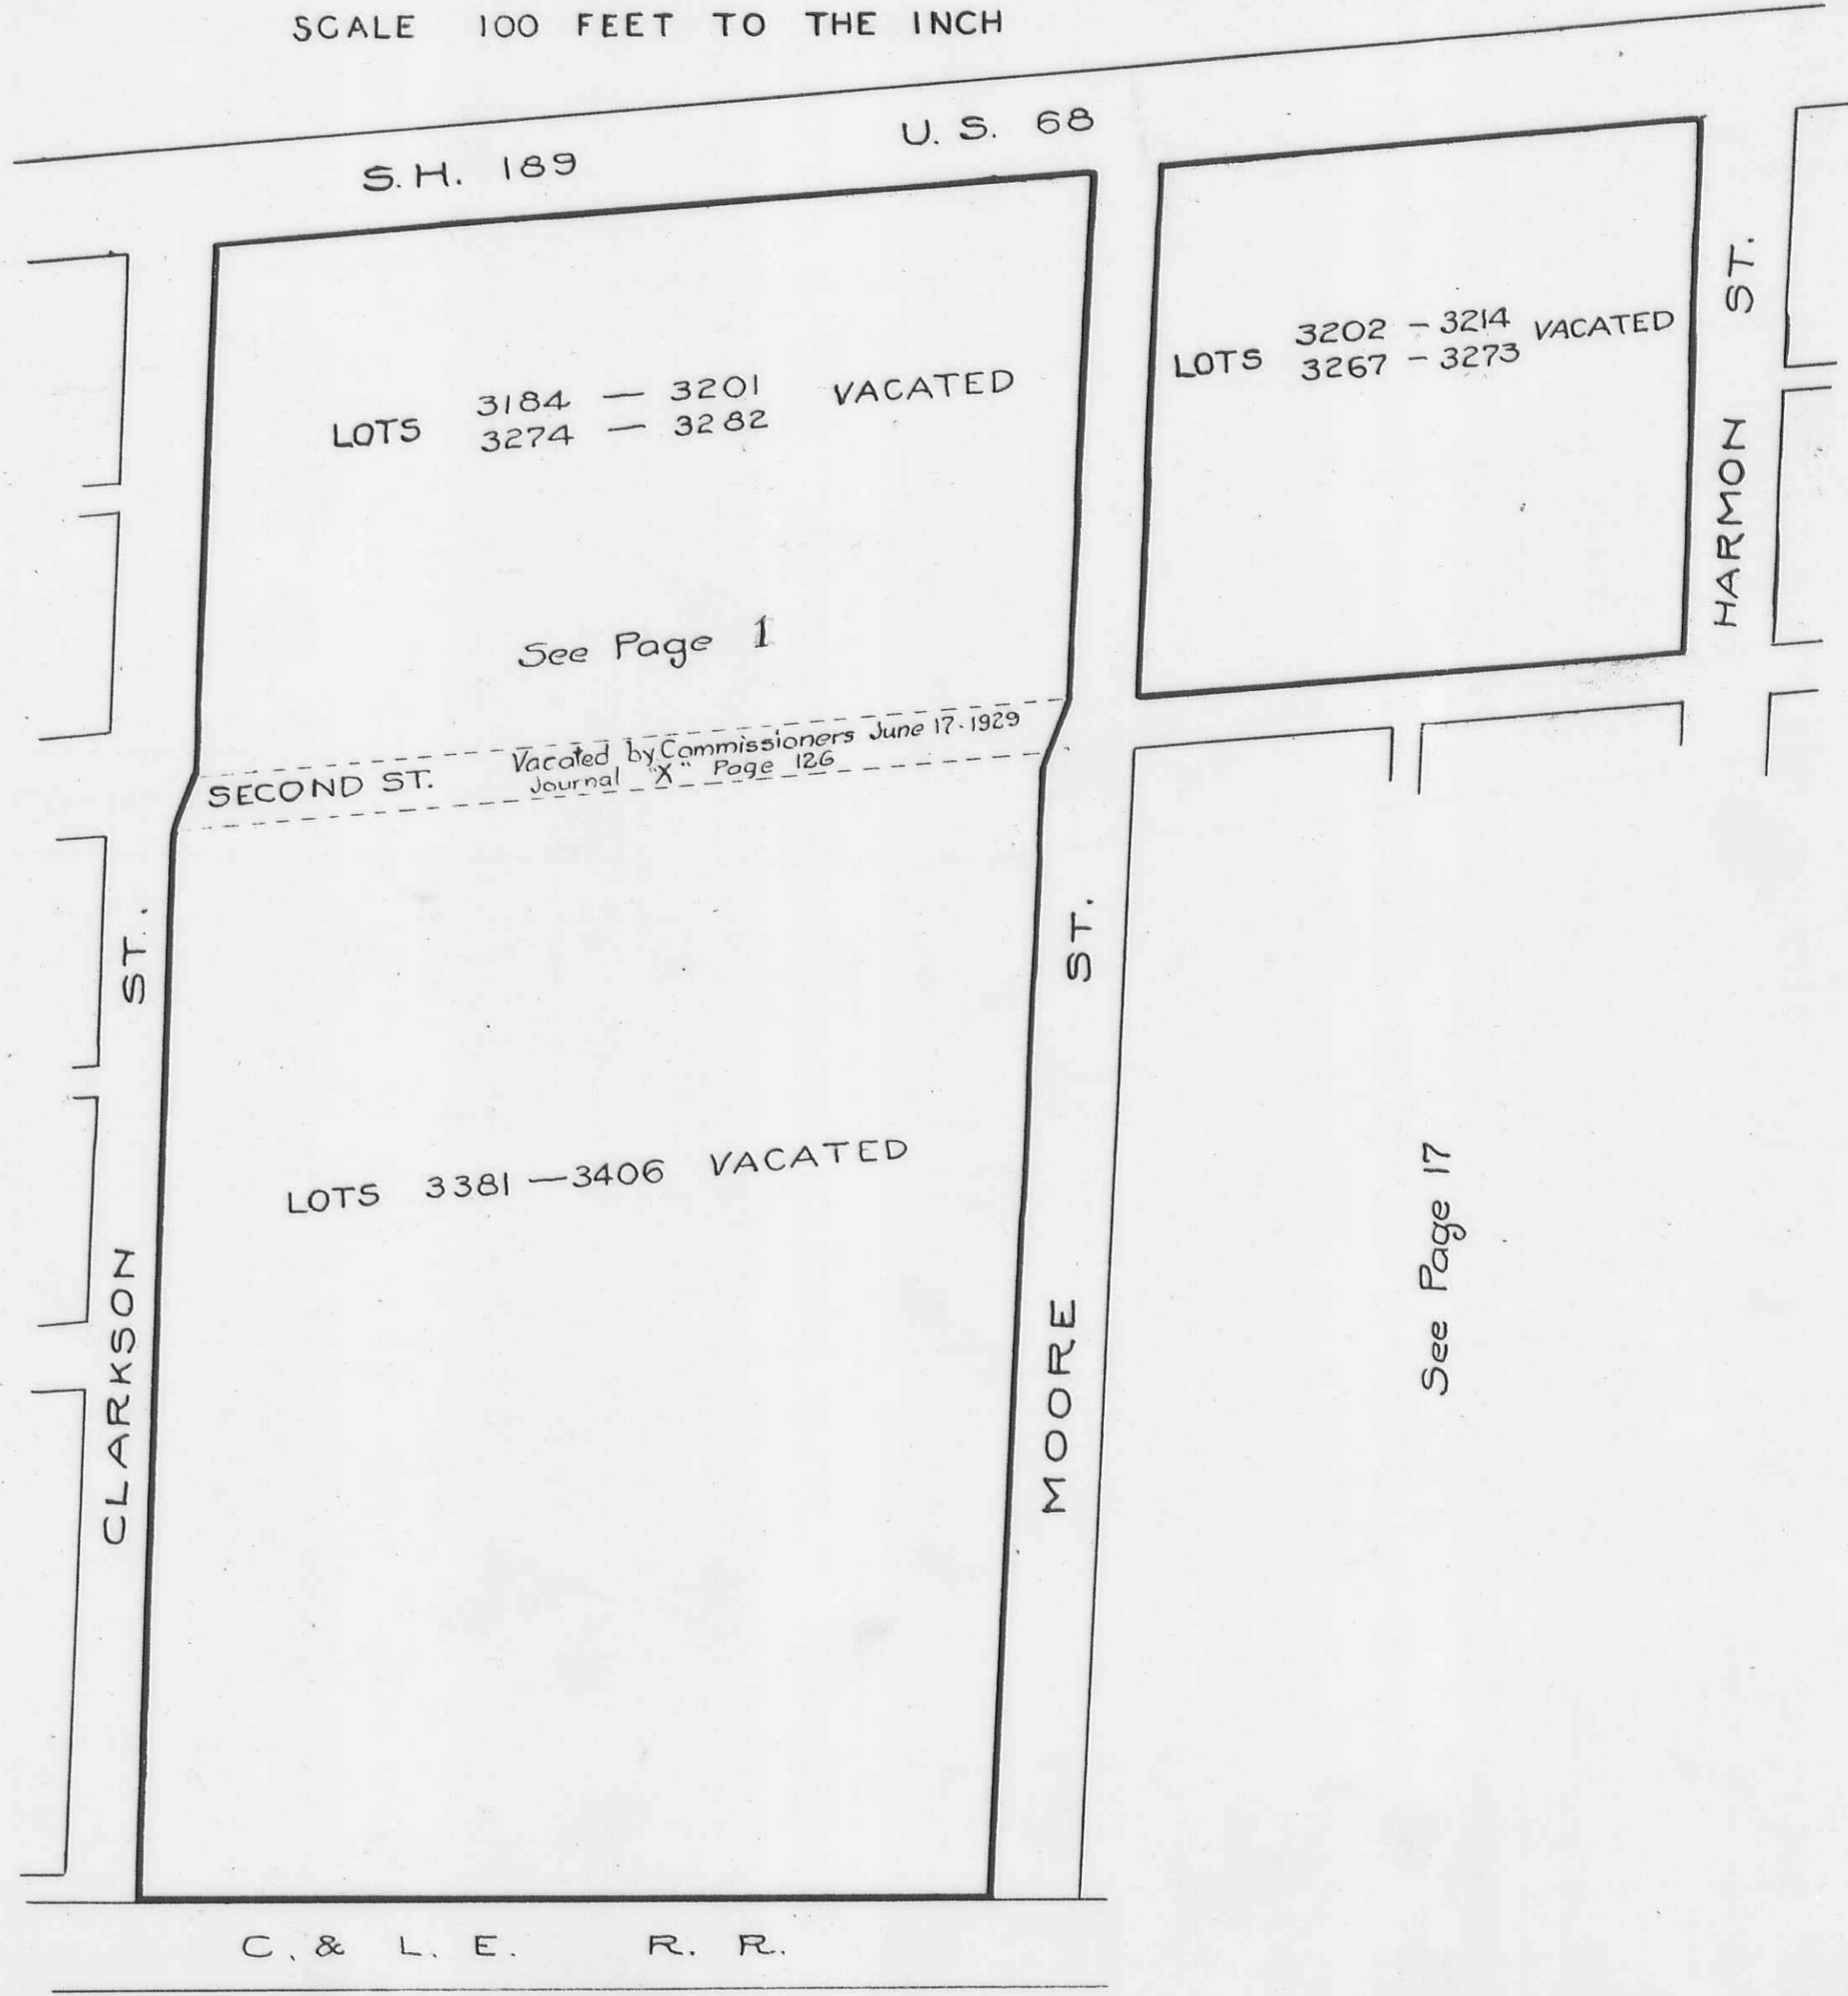

LAKE TOWNSHIP — SECTION 33 TOWN 4 RANGE 14 — PAGE 17
 CLARK'S PARK ADDITION S-PART

SCALE 100 FEET TO THE INCH

Vacated Lots See Page 16

