

Recorder

**LIBERTY
TOWNSHIP
1942**

Recorder's Office

H.E.Dyser

Microfilmed 1958

LIBERTY TOWNSHIP INDEX MAP

PAGE 0

HARRISON TWP.	LAKE	TOWNSHIP	VMS 5864 PAGE 2
2-3-14 PAGE 1	32-4-14 PAGE 1	26-4-14 PAGE 2	JEFFERSON TOWNSHIP
1-3-14 PAGE 4	31-4-14 PAGE 4	25-4-14 PAGE 3	TOWNSHIP
6-4-13 PAGE 5	36-5-13 PAGE 5	30-5-13 PAGE 6	TOWNSHIP
5-4-13 PAGE 8	35-5-13 PAGE 8	29-5-13 PAGE 7	MONROE
4-4-13 PAGE 9	34-5-13 PAGE 9	28-5-13 PAGE 10	MONROE
CHAMPAIGN COUNTY	33-5-13 PAGE 12	WEST LIBERTY CORPORATION PAGES-13-14-15-16 27-5-13 PAGE 11	CHAMPAIGN COUNTY

CORRECTED TO

~~January 1-1945~~
~~April 1-1945~~
~~November 10, 1945~~
~~January 1-1946~~
~~January 1-1948~~
~~January 1-1949~~
~~January 1-1950~~


LIBERTY TOWNSHIP

PAGE 1

SECTION 2 TOWN 3 RANGE 14

SECTION 32 TOWN 4 RANGE 14

SCALE 10 CHAINS TO THE INCH

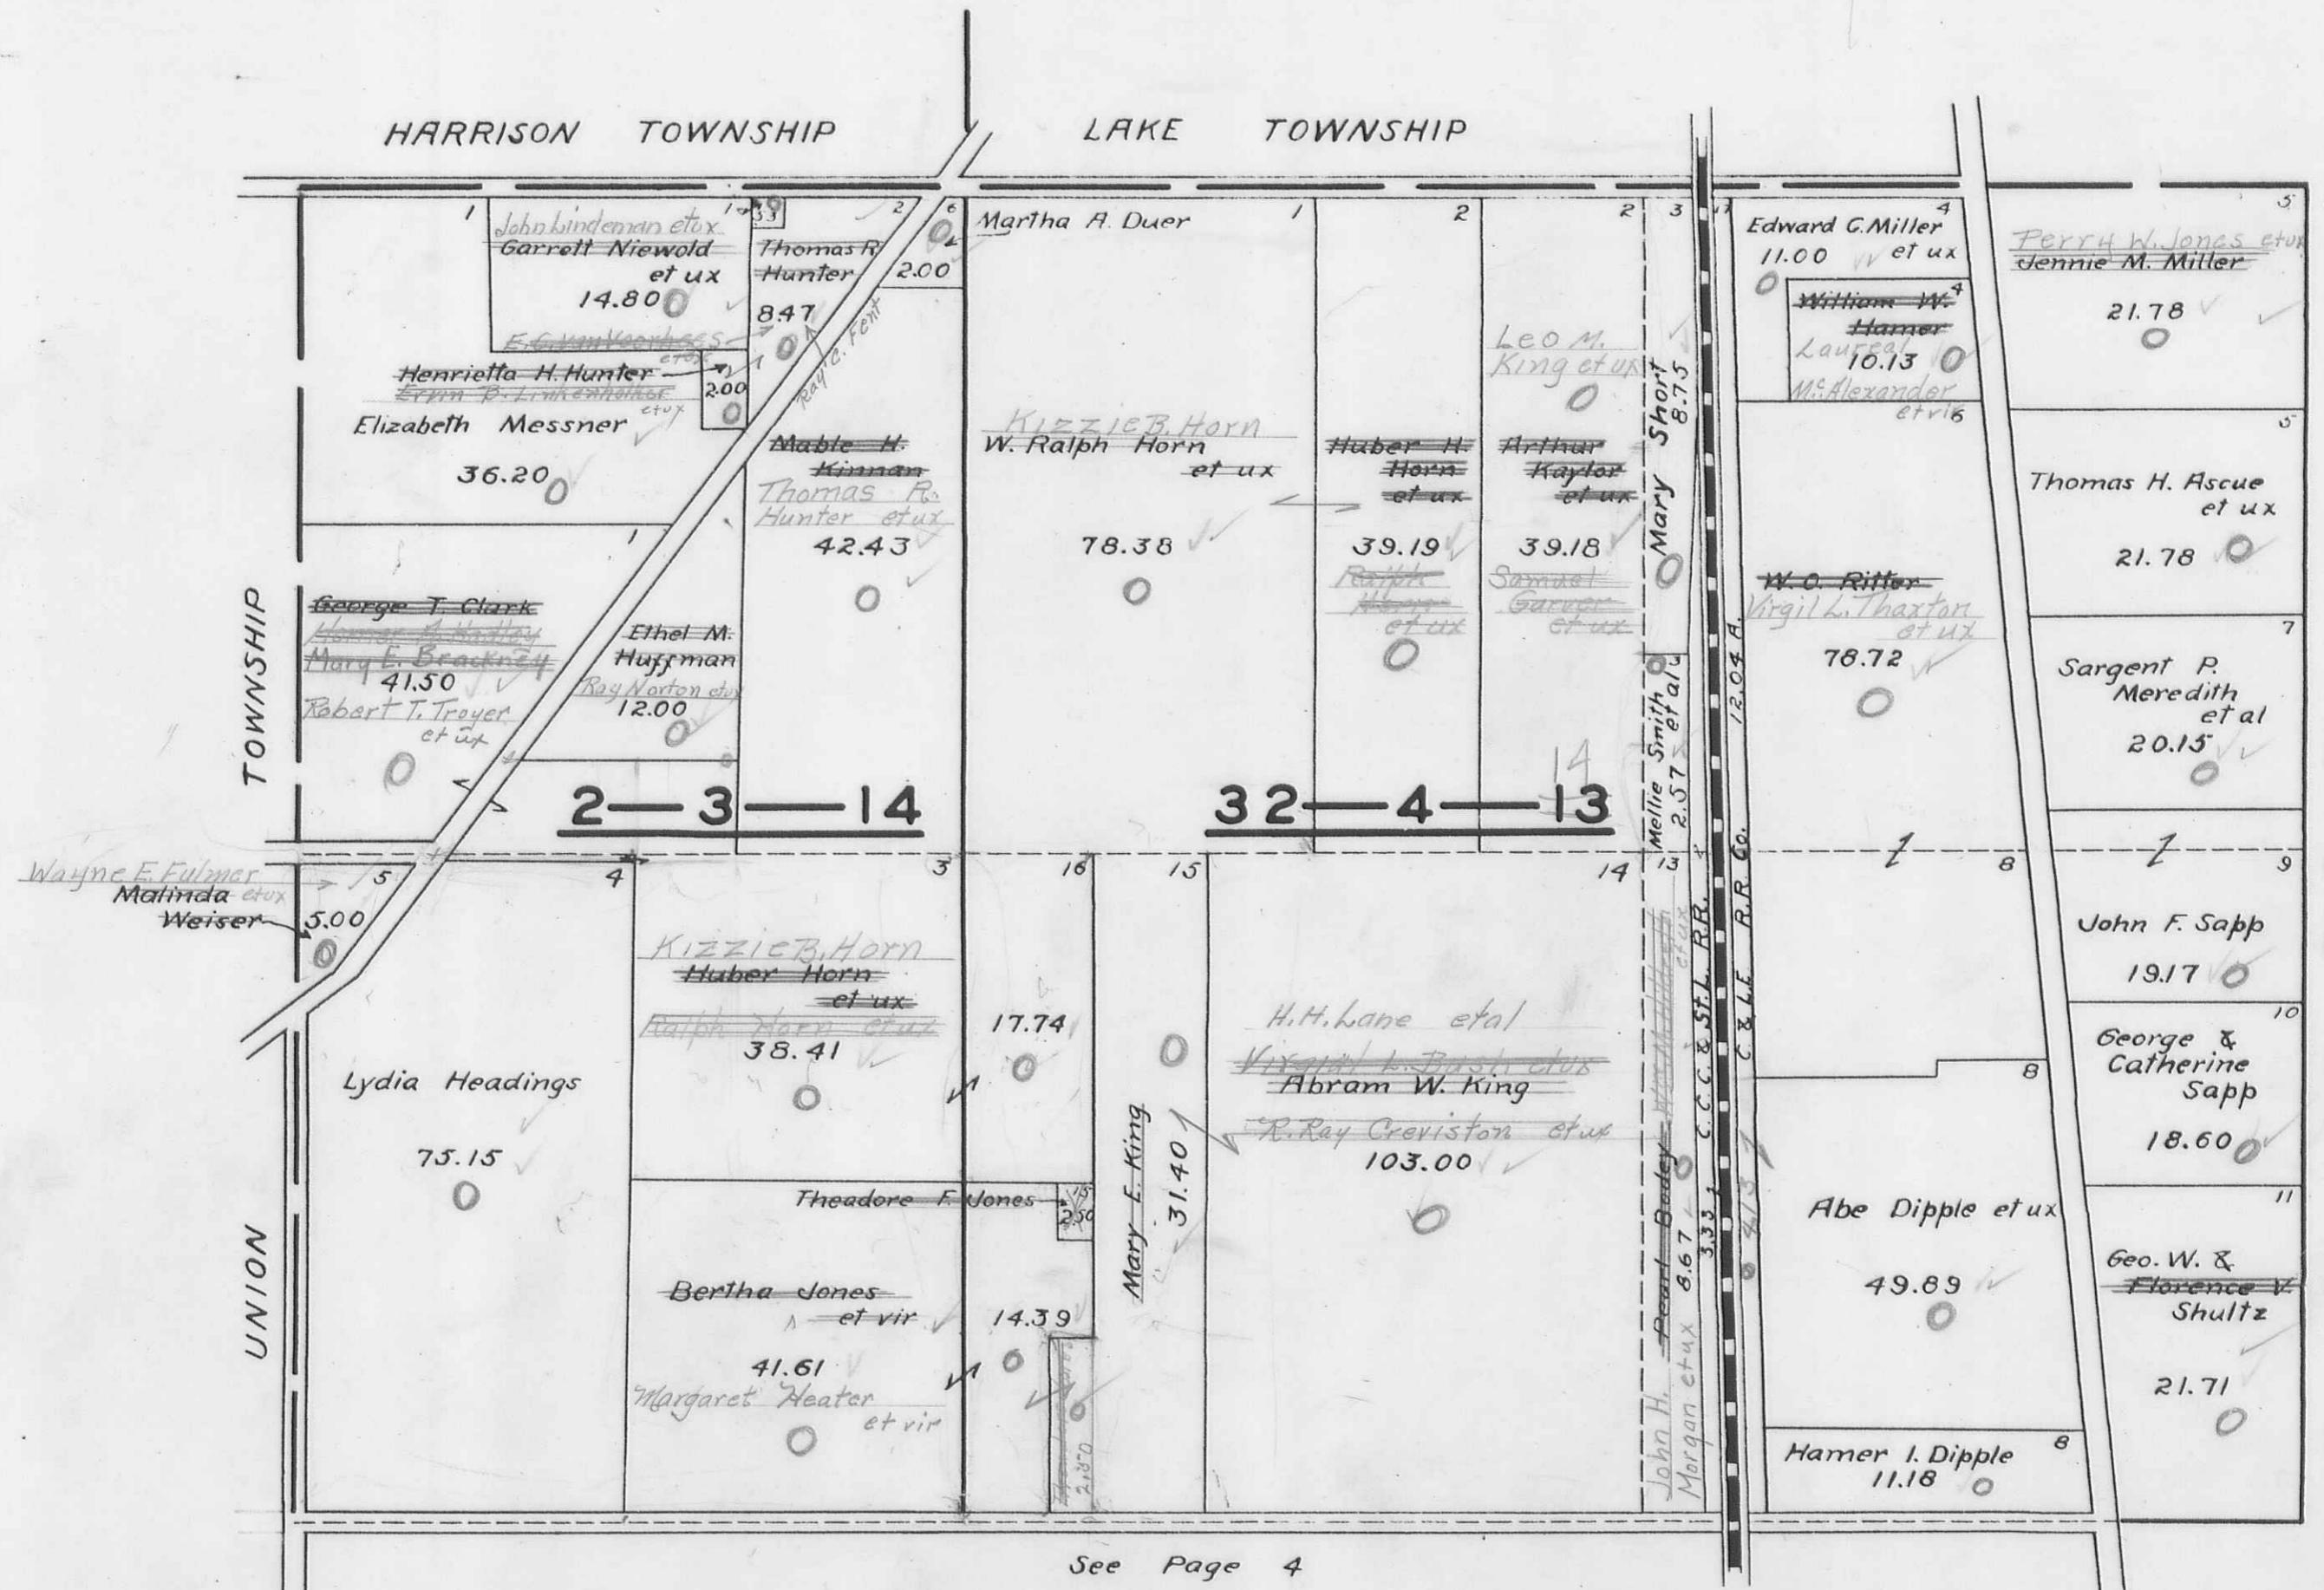


LIBERTY TOWNSHIP

PAGE 2

SECTION 26 TOWN 4 RANGE 14
VIRGINIA MILITARY SURVEY 5864

SCALE 10 CHAINS TO THE INCH

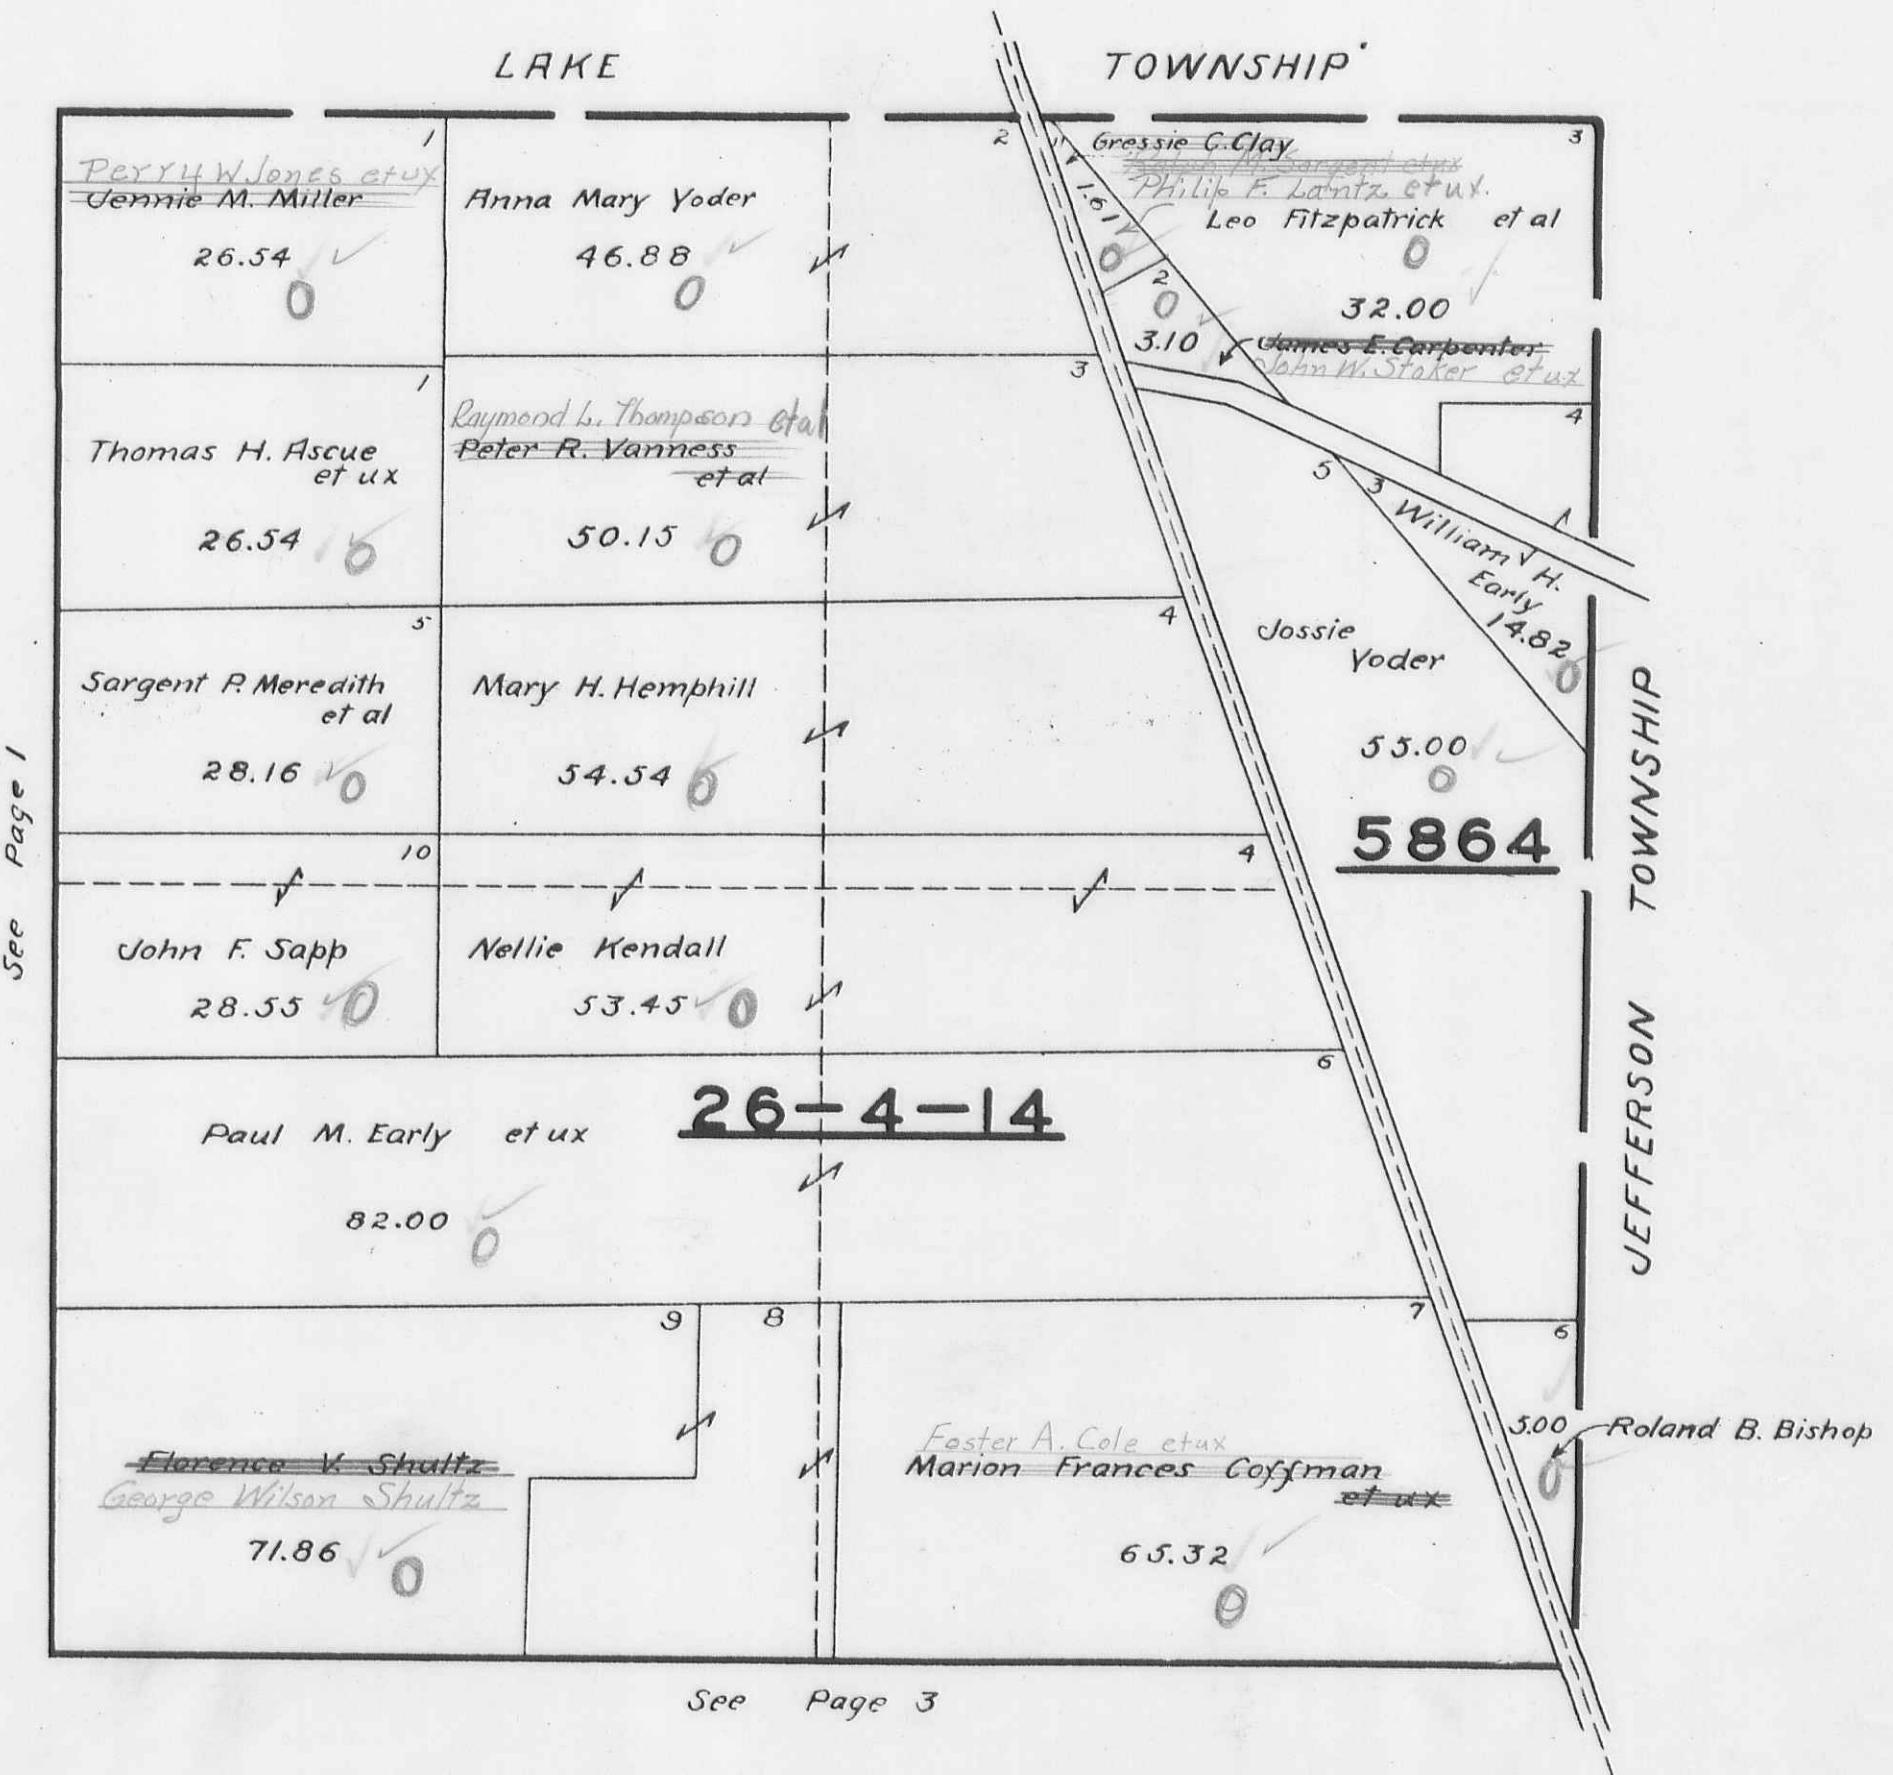

LIBERTY TOWNSHIP
SECTION 25 TOWN 4 RANGE 14

SCALE 10 CHAINS TO THE INCH

PAGE 3

See Page 2

George Wilson Shultz Florence V Shultz	1	2	3	4
20.50 ✓ 0	✓ 0			
Naomi Lyman O. McLain et ux	2		Charles A. McCallach et ux	Henry B. Green et ux Anna Harris
61.29 ✓ 0		31.92 ✓ 0		50.00 ✓ 0

Forrest Vettice Berry et ux	11	10	8	6
Florence V Shultz George Wilson Shultz			Charles A. McCallach et ux	Alf J. Yoder Adaline Yoder 23.19 ✓ 0
76.00 ✓ 0		Foster A. Cole Foster A. Cole et ux 11.98 ✓ 0 Daniel E. Jones 1.08 ✓ 0	39.62 et ux 1.08 ✓ 0 38.54 ✓ 0	

Bertha E. Barrett	11	12	13
Forrest V. Berry et ux		James W. Robinson et ux	Alfred & Alberta Young 11.37 ✓ 0
Bertha E. Barrett 15.87 ✓ 0		145.53 ✓ 0	
Samuel S. Johnson et ux Bertha E. Barrett Forrest V. Berry et ux		15.00 ✓ 0	

Jacob Shultz Cordelia Shultz	14
66.00 ✓ 0	

John W. Libbincott et ux	15
1.50 ✓ 0	

See Page 6

MONROE TOWNSHIP

LIBERTY TOWNSHIP
INDEX

PAGE A

SECTION	TOWN	RANGE	PAGE
---------	------	-------	------

2	3	14	1
32	4	14	1
26	4	14	2
25	4	14	3
31	4	14	4
1	3	14	4
6	4	13	5
36	5	13	5
30	5	13	6
29	5	13	7
35	5	13	8
5	4	13	8
4	4	13	9
34	5	13	9
28	5	13	10
27	5	13	11
33	5	13	12

V M S 5864 ----- 2

WEST LIBERTY CORPORATION-13-14-15-16

LIBERTY TOWNSHIP

PAGE


4

SECTION 1 TOWN 3 RANGE 14

SECTION 31 TOWN 4 RANGE 14

SCALE 10 CHAINS TO THE INCH


See Page 1

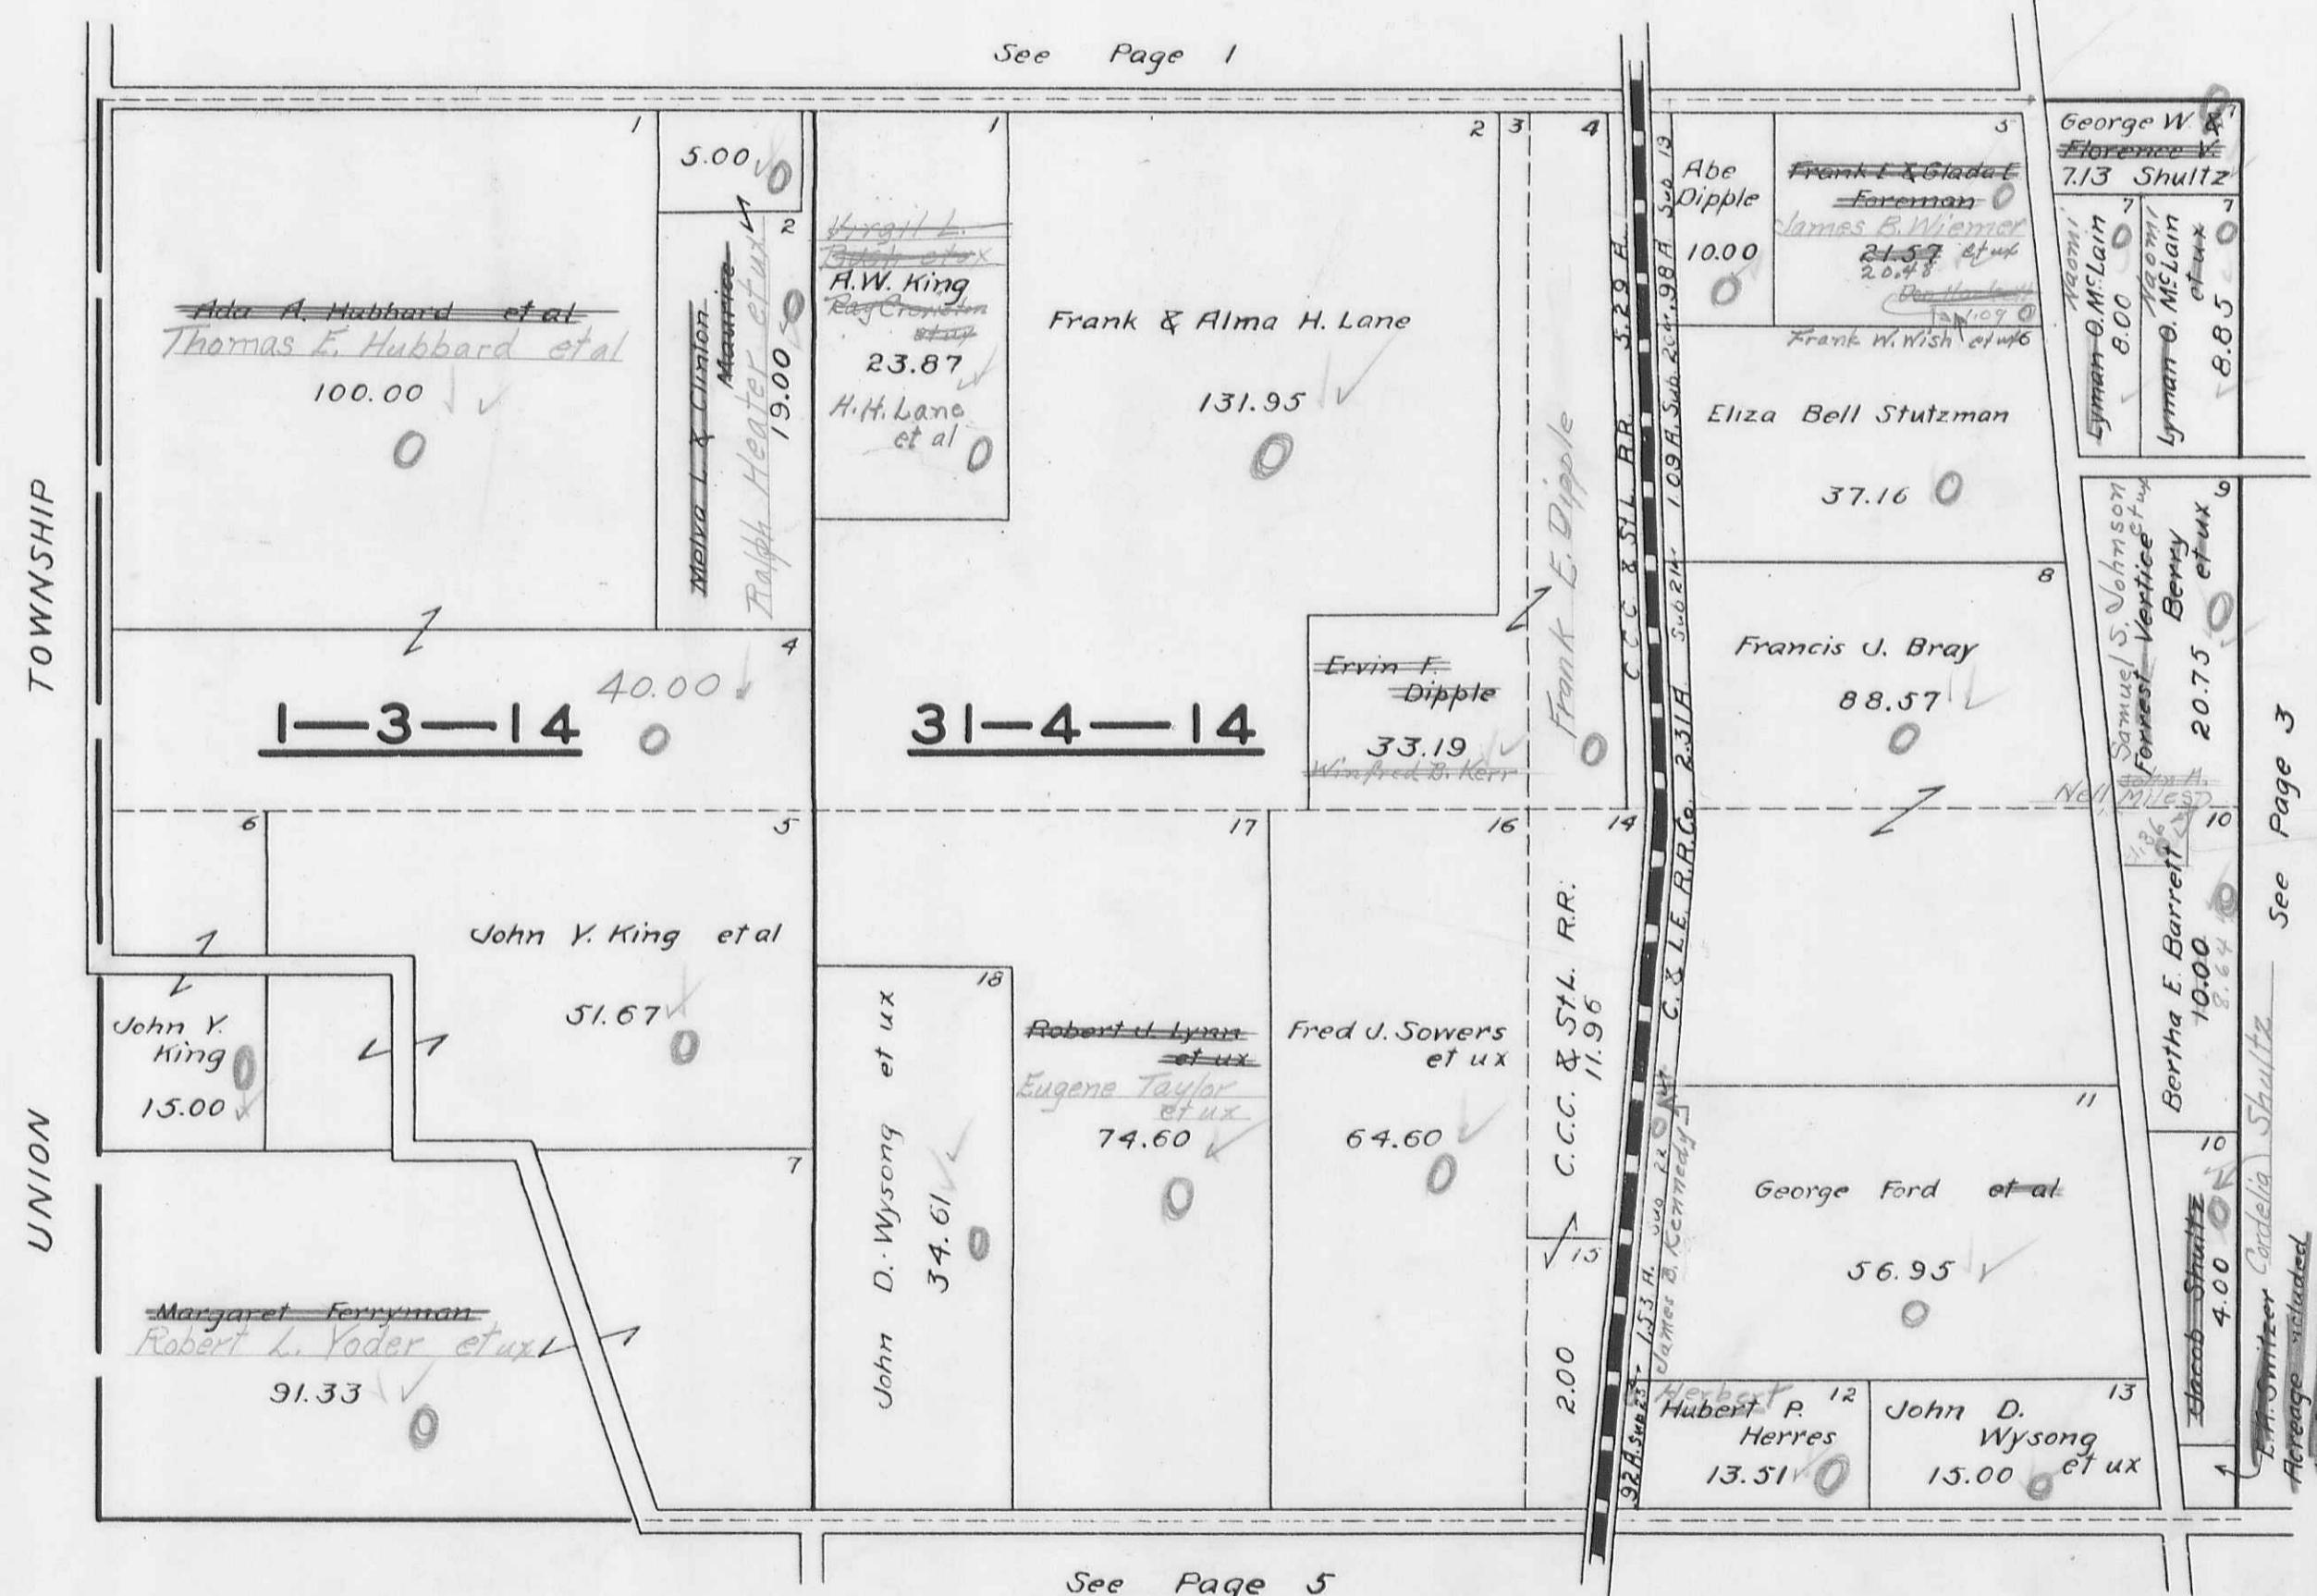

LIBERTY TOWNSHIP
SECTION 6 TOWN 4 RANGE 13
SECTION 36 TOWN 5 RANGE 13

PAGE 5


SCALE 10 CHAINS TO THE INCH

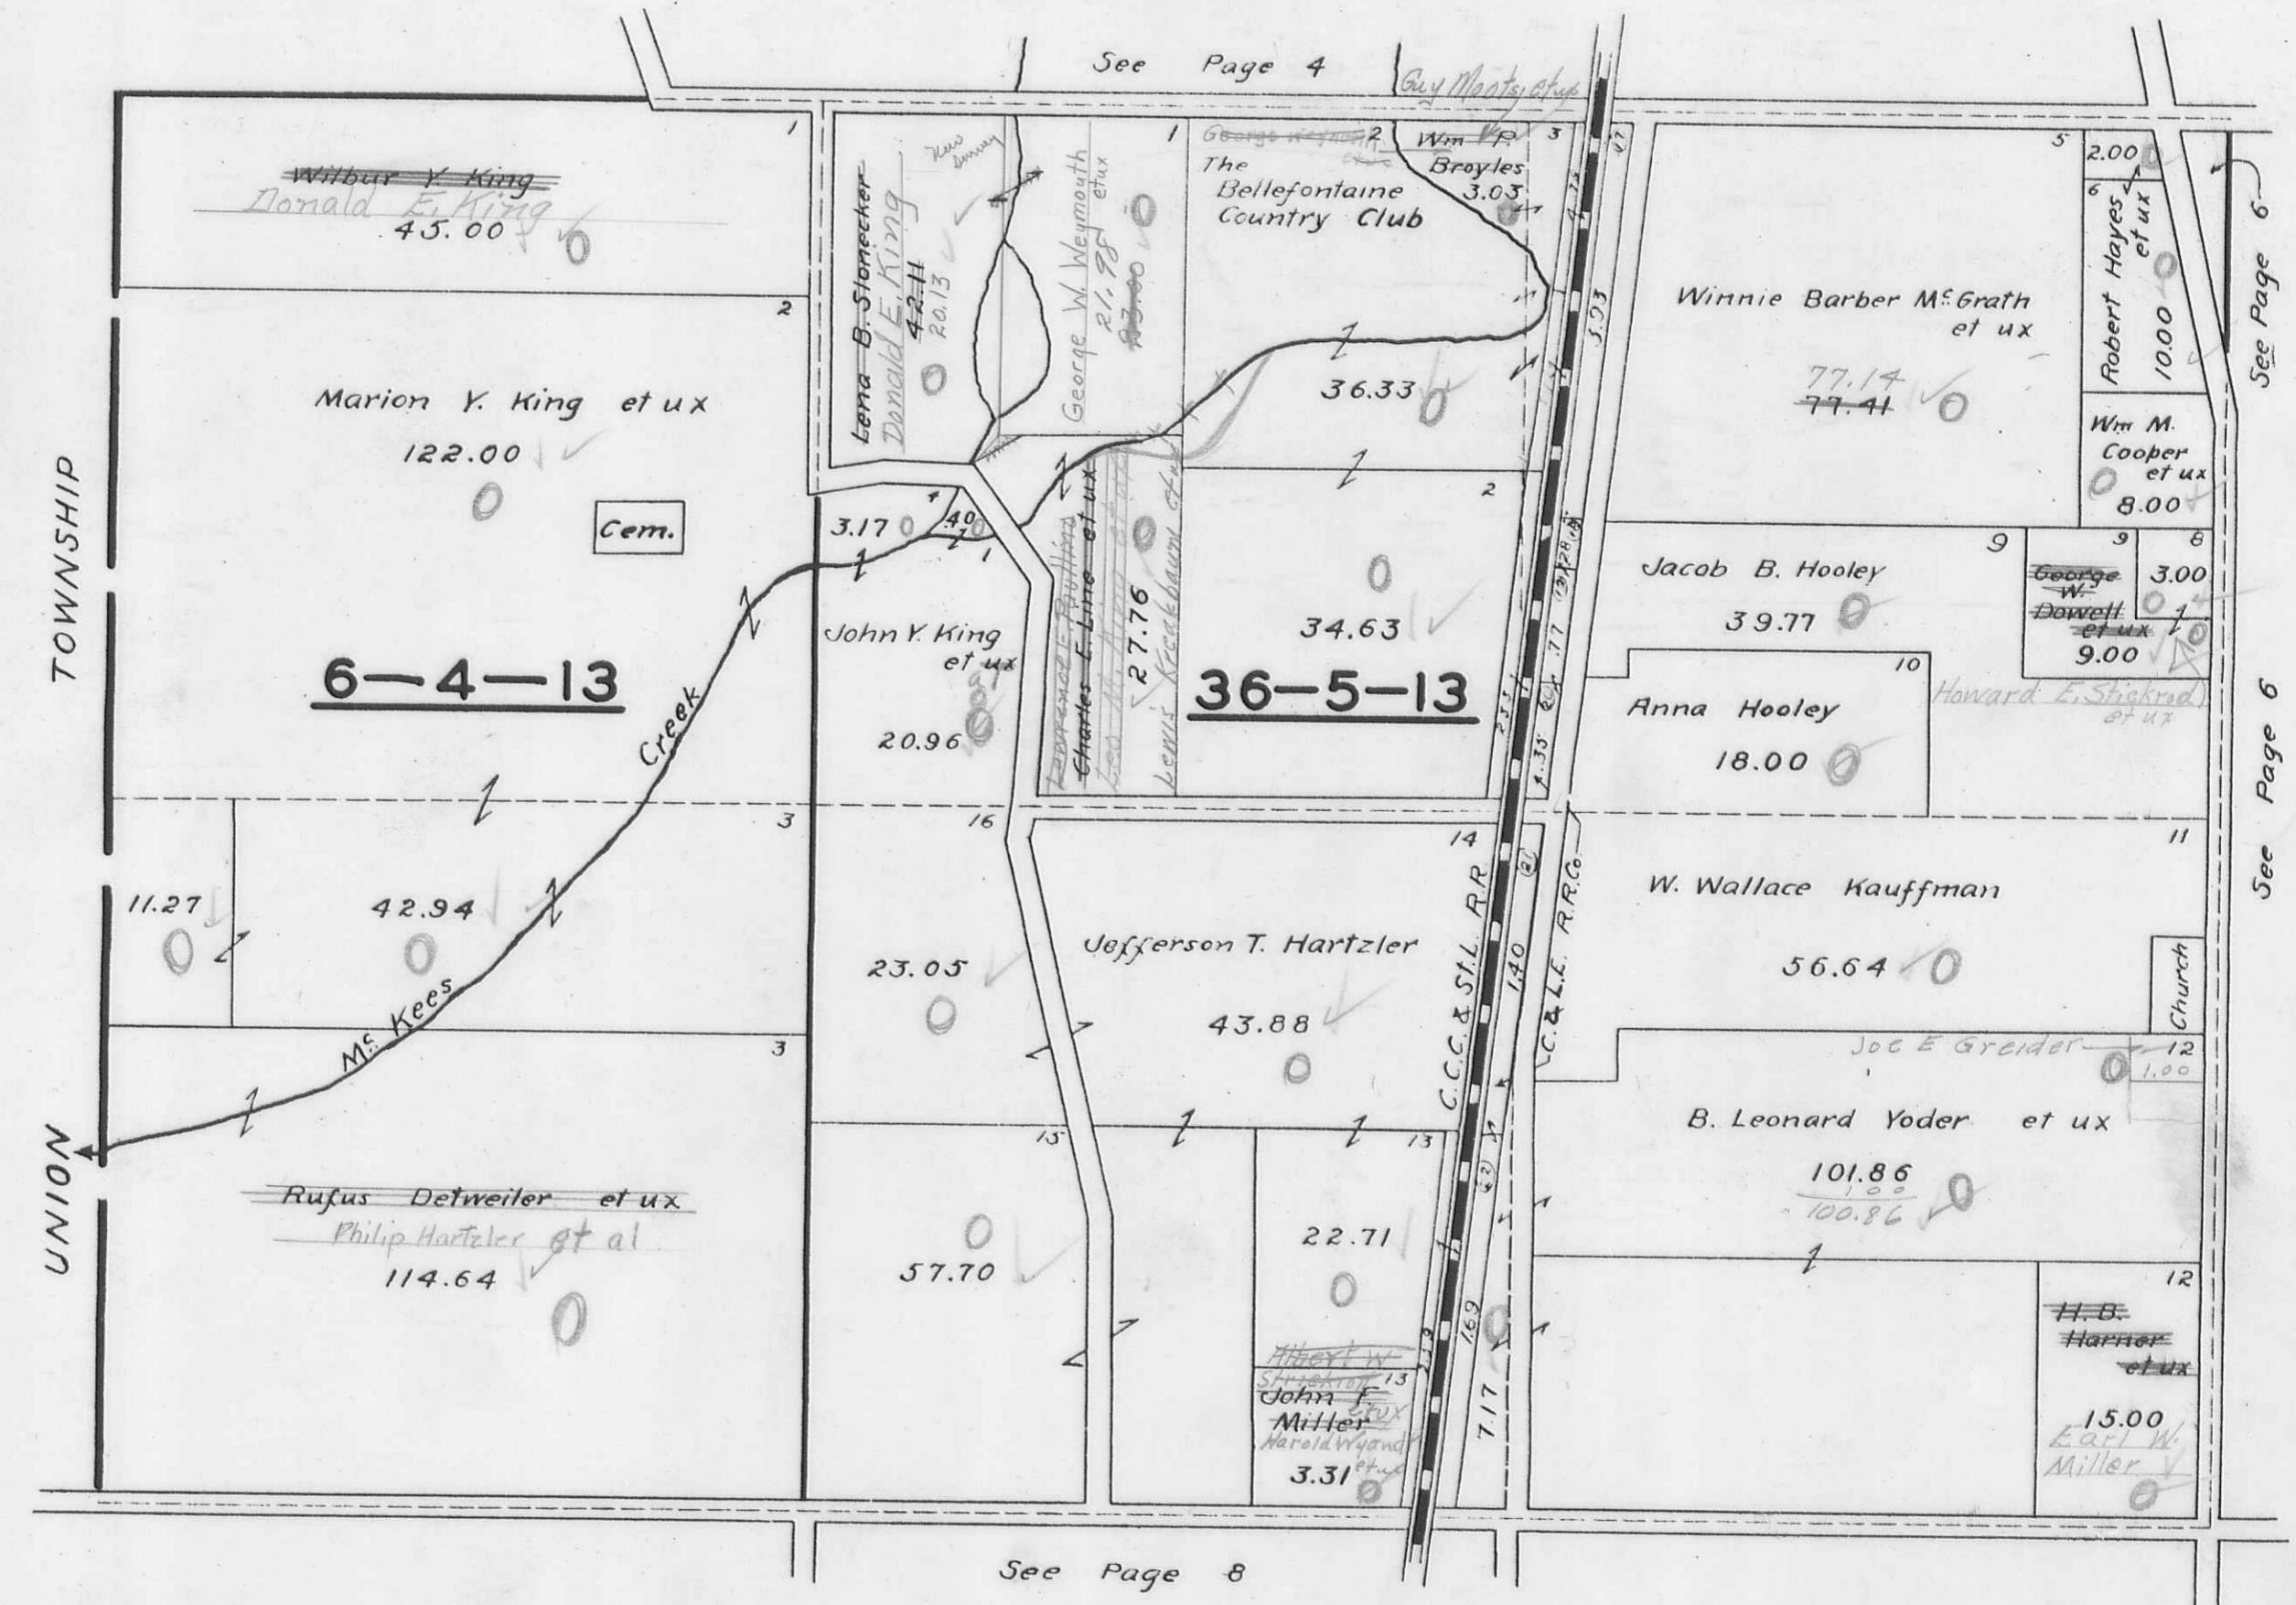

SECTION 30 TOWN 5 RANGE 13


SCALE 10 CHAINS TO THE INCH

See Page 3

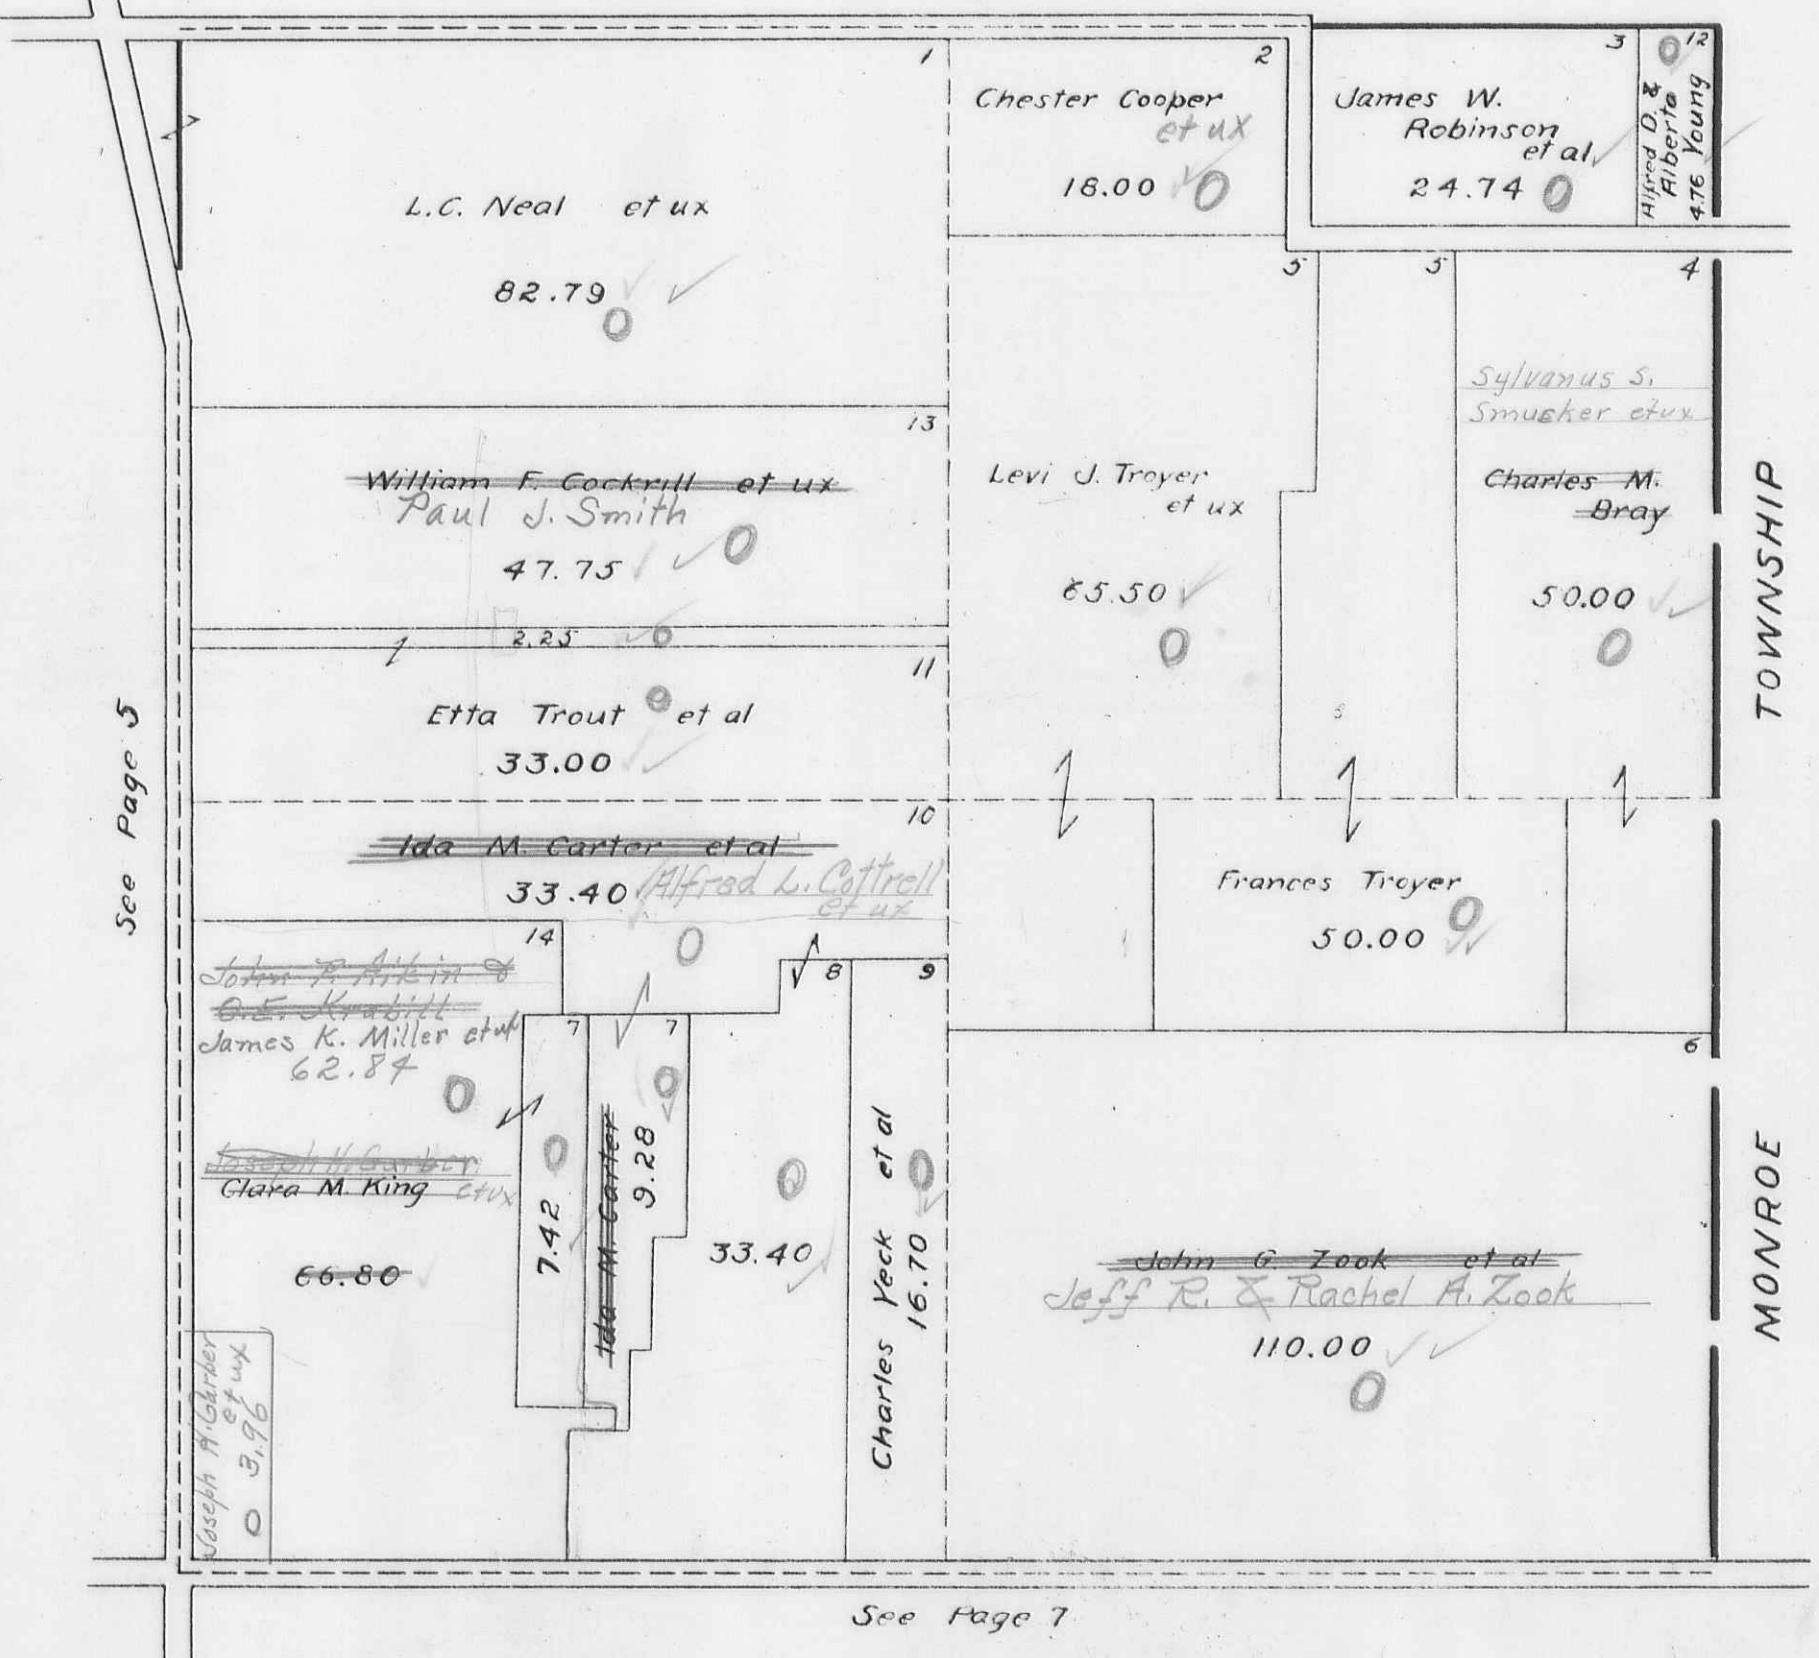

SECTION 29 TOWN 5 RANGE 13

SCALE 10 CHAINS TO THE INCH

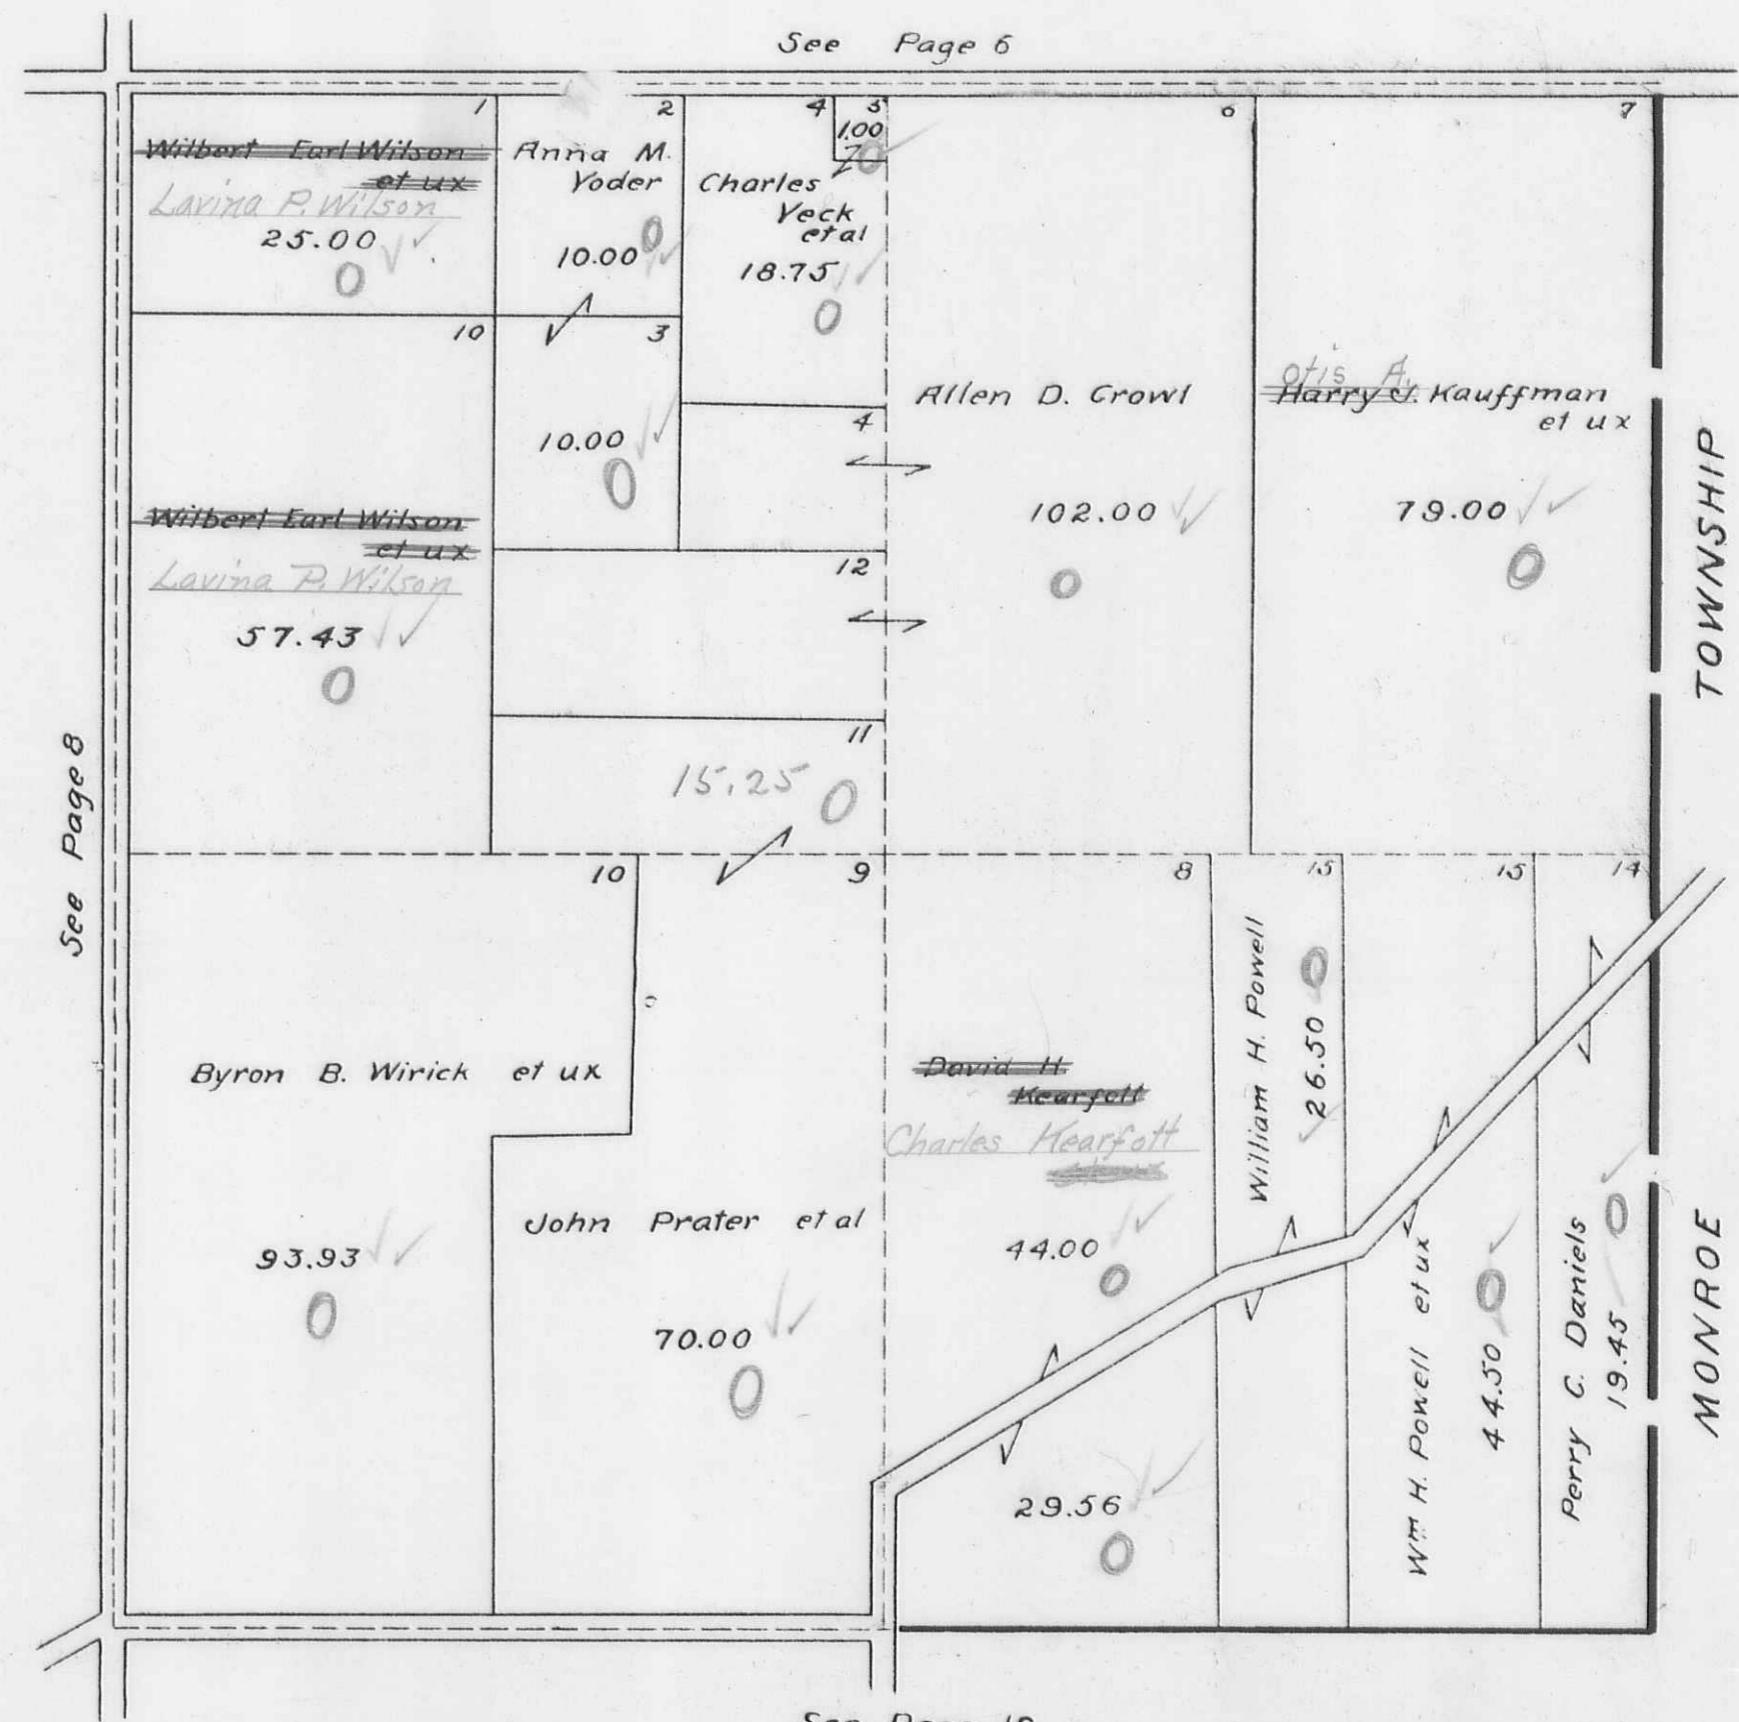

LIBERTY TOWNSHIP


PAGE 8

SECTION 5 TOWN 4 RANGE 13

SECTION 35 TOWN 5 RANGE 13

SCALE 10 CHAINS TO THE INCH

See Page 5

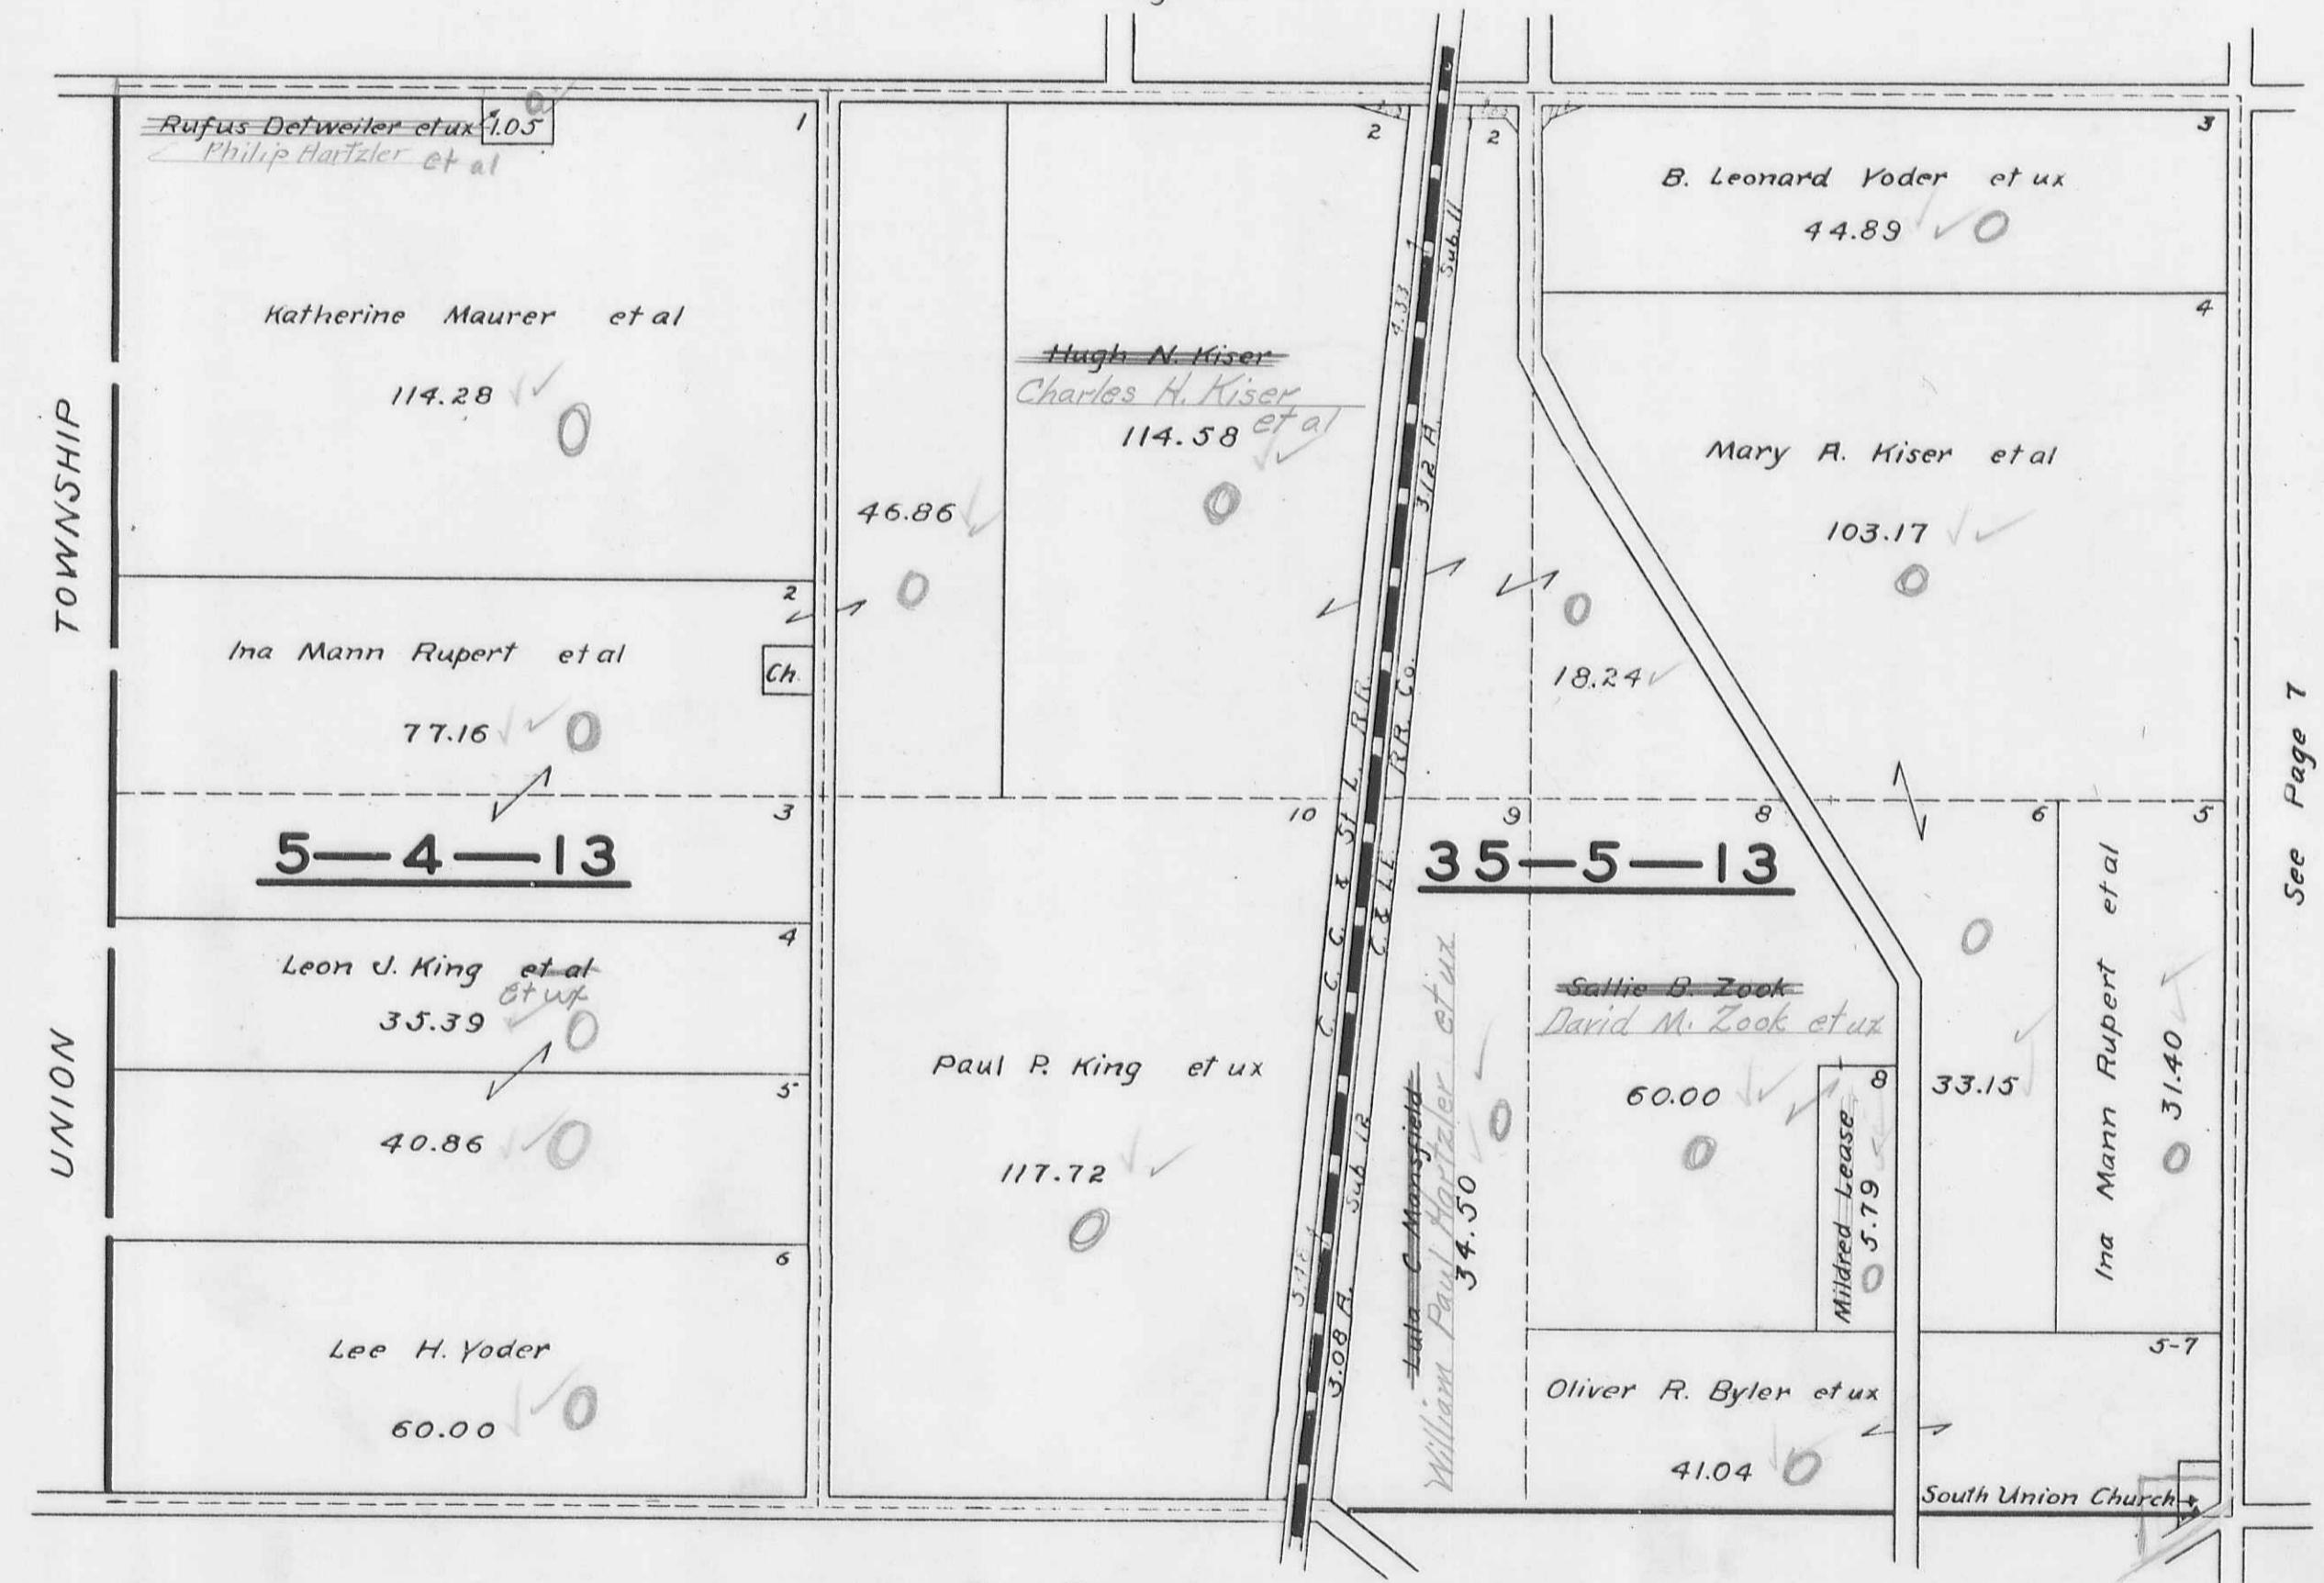


LIBERTY TOWNSHIP

PAGE 9

SECTION 4 TOWN 4 RANGE 13

SECTION 34 TOWN 5 RANGE 13

SCALE 10 CHAINS TO THE INCH

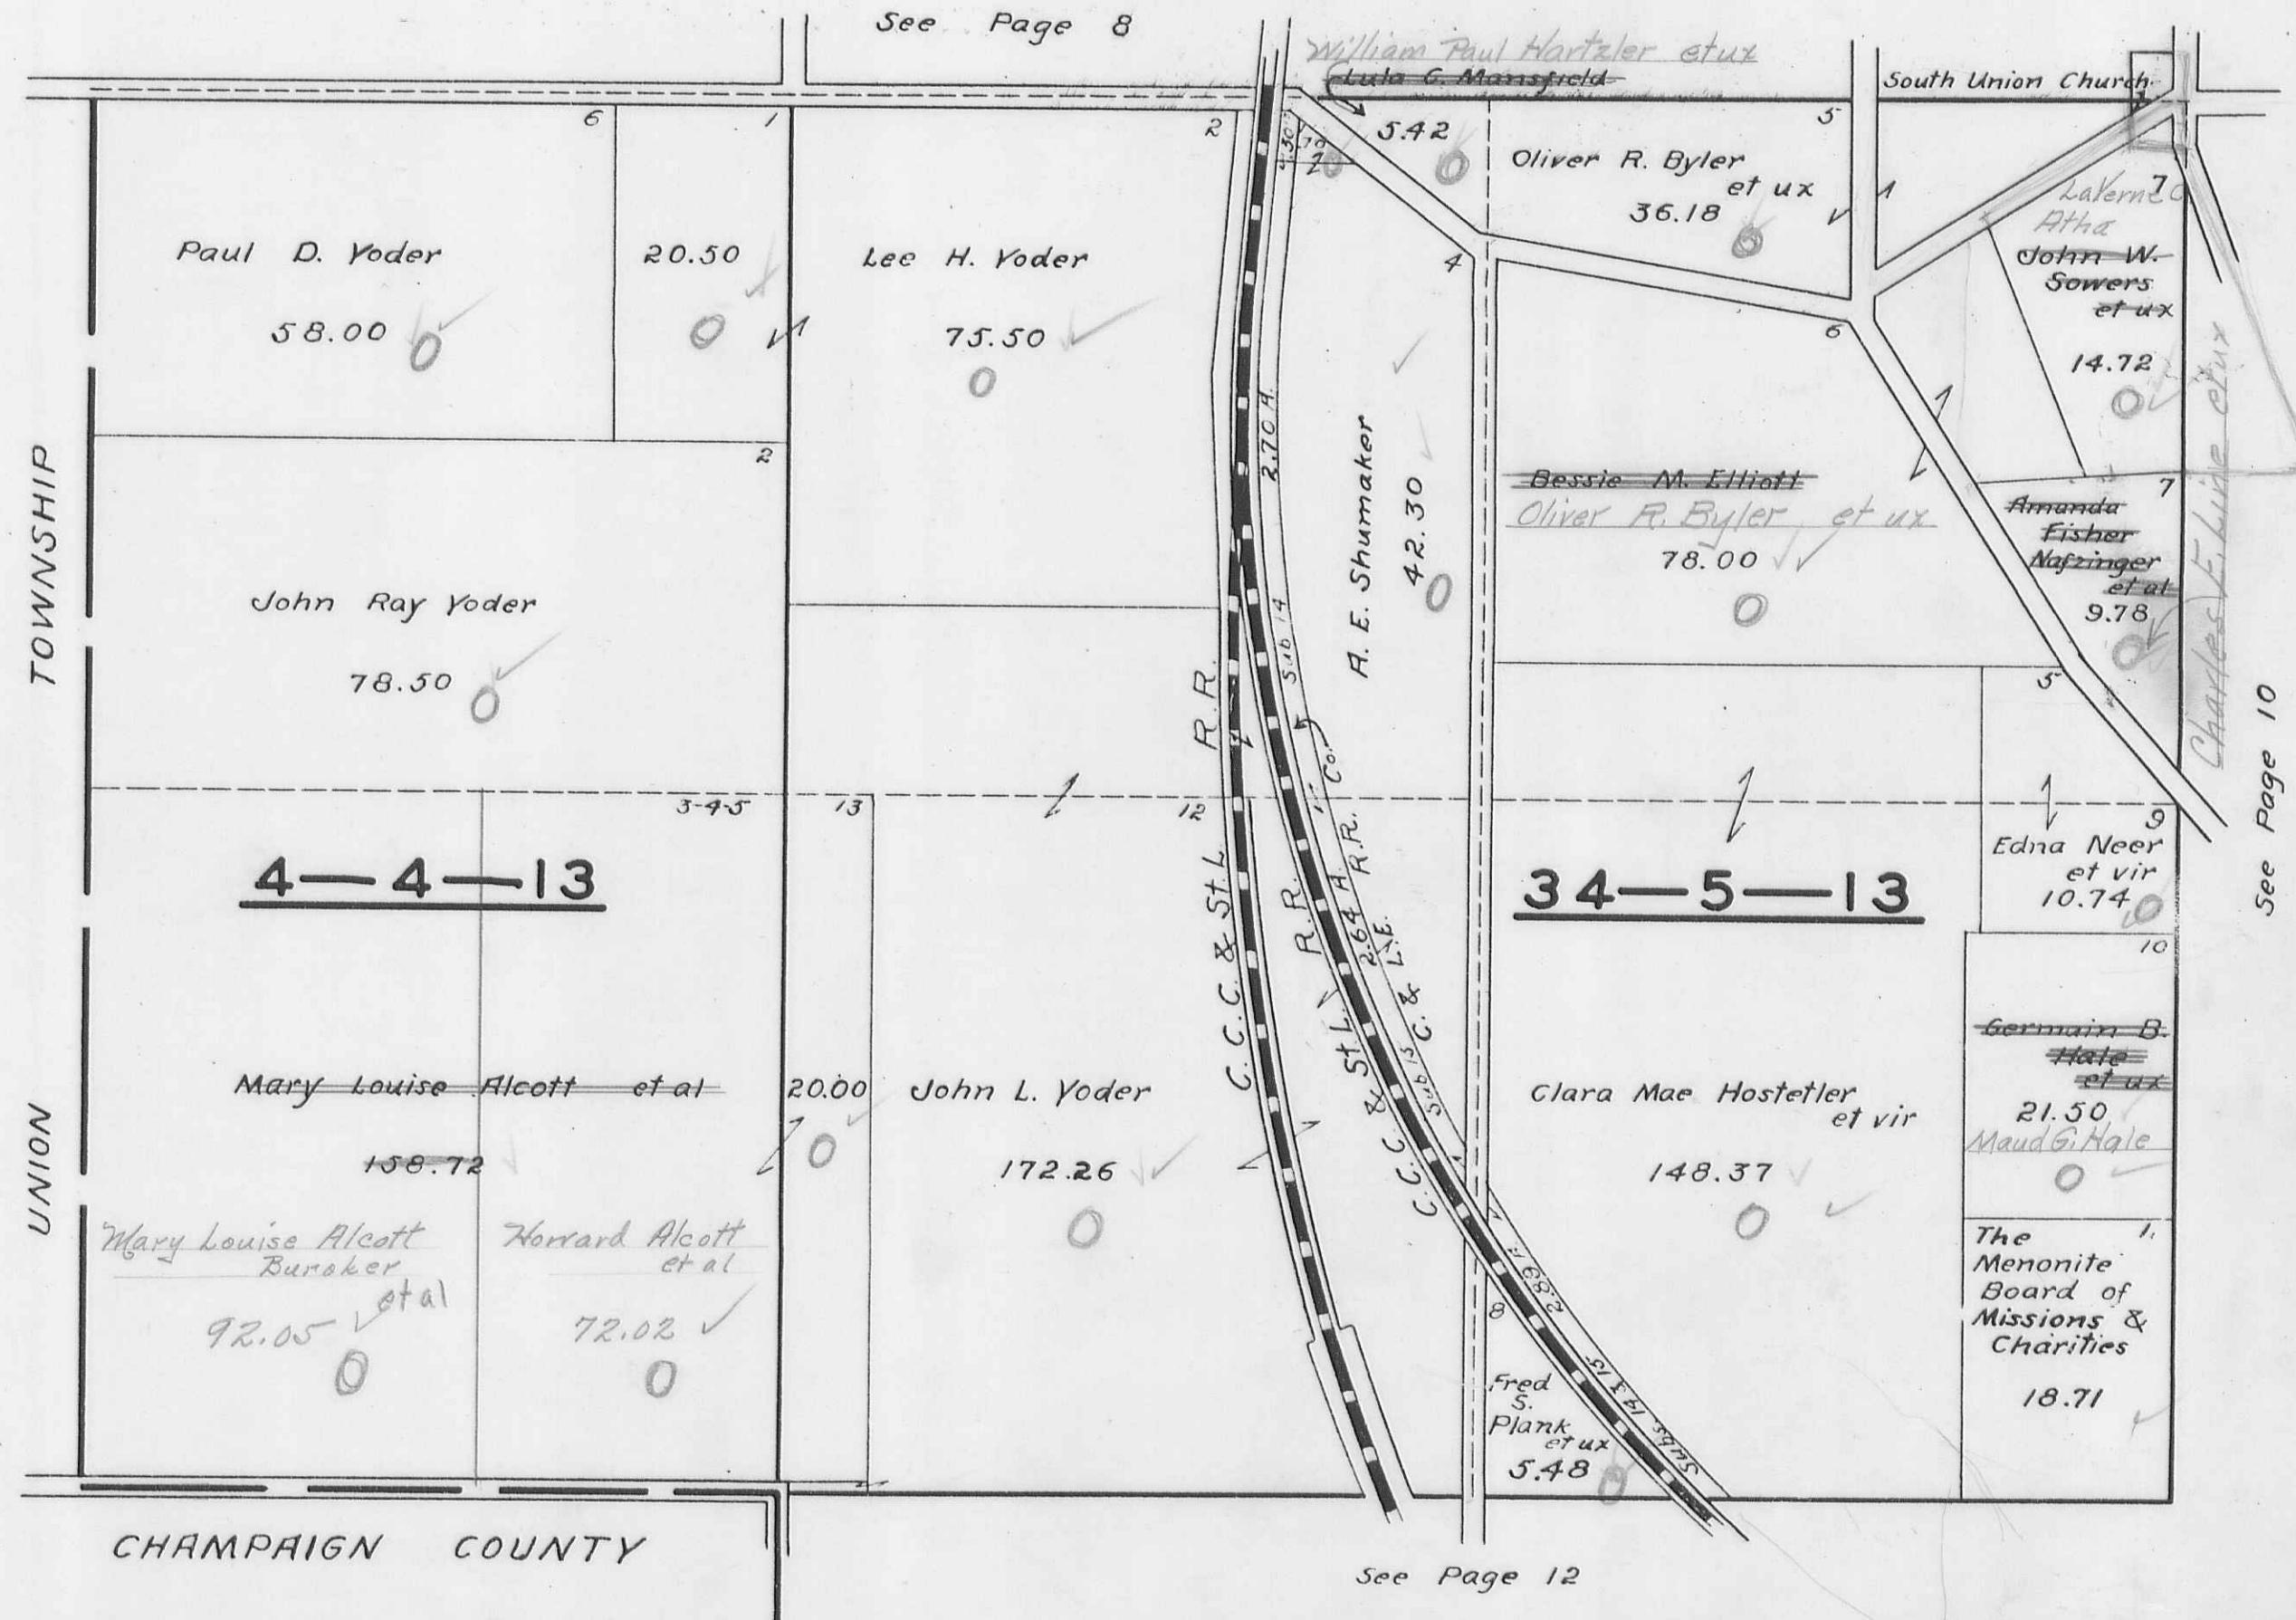


LIBERTY TOWNSHIP
SECTION 28 TOWN 5 RANGE 13

SCALE 10 CHAINS TO THE INCH

PAGE 10

See Page 7

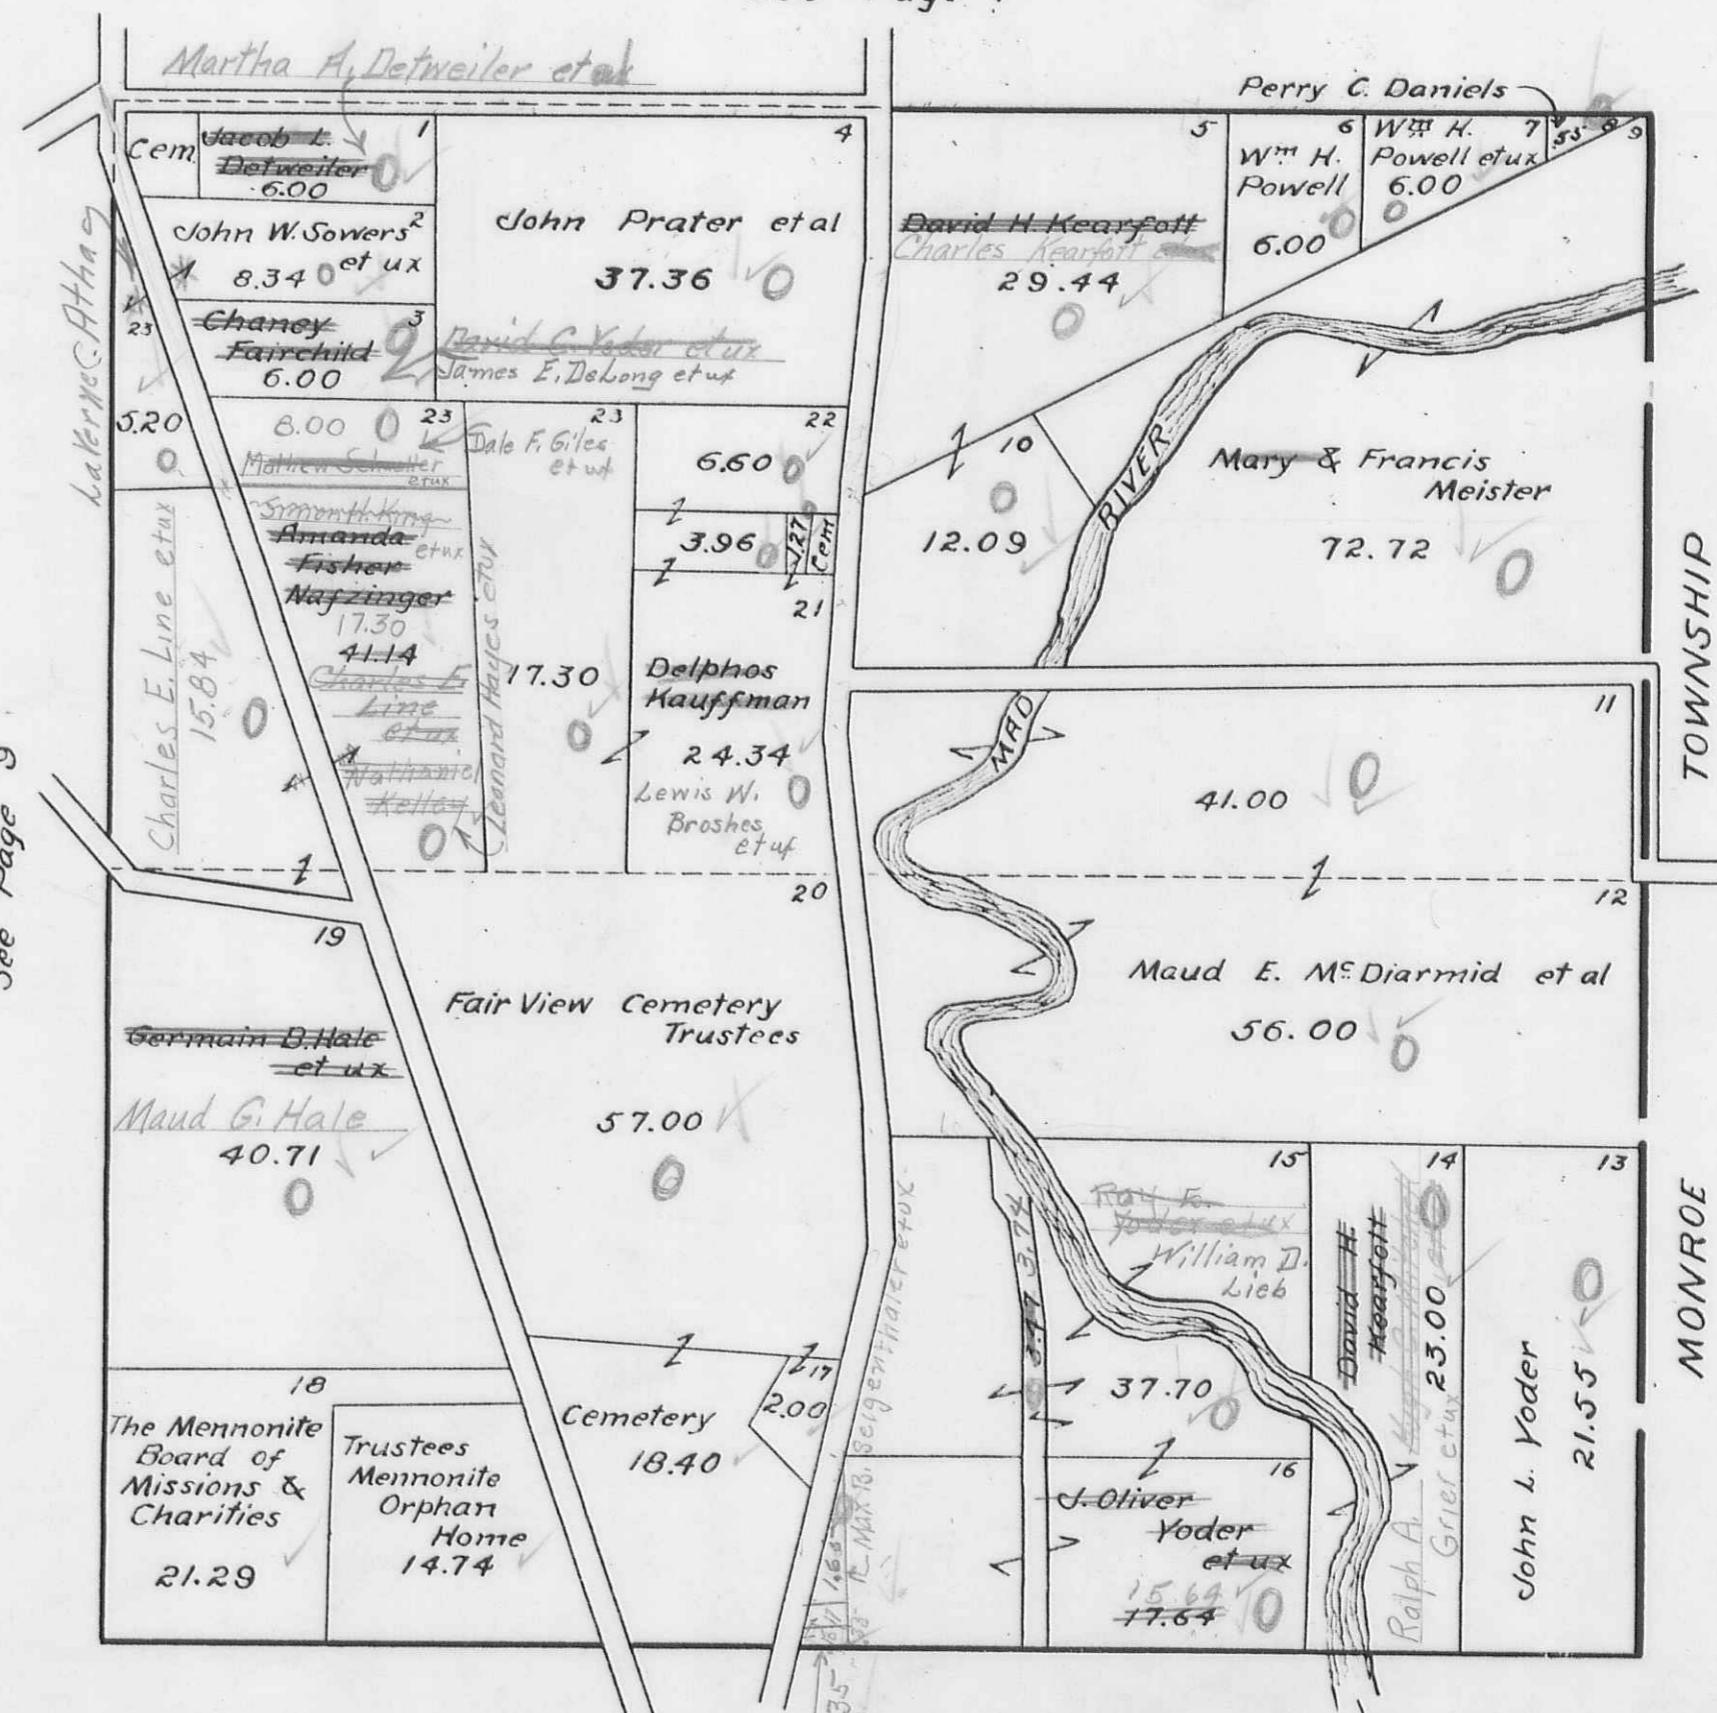

4 1.18
 8.00
3 3.14
17.30
15.84
4.85
20.03 9

TOWNSHIP



MONROE

LIBERTY TOWNSHIP

PAGE 11

SECTION 27 TOWN 5 RANGE 13


SCALE 10 CHAINS TO THE INCH

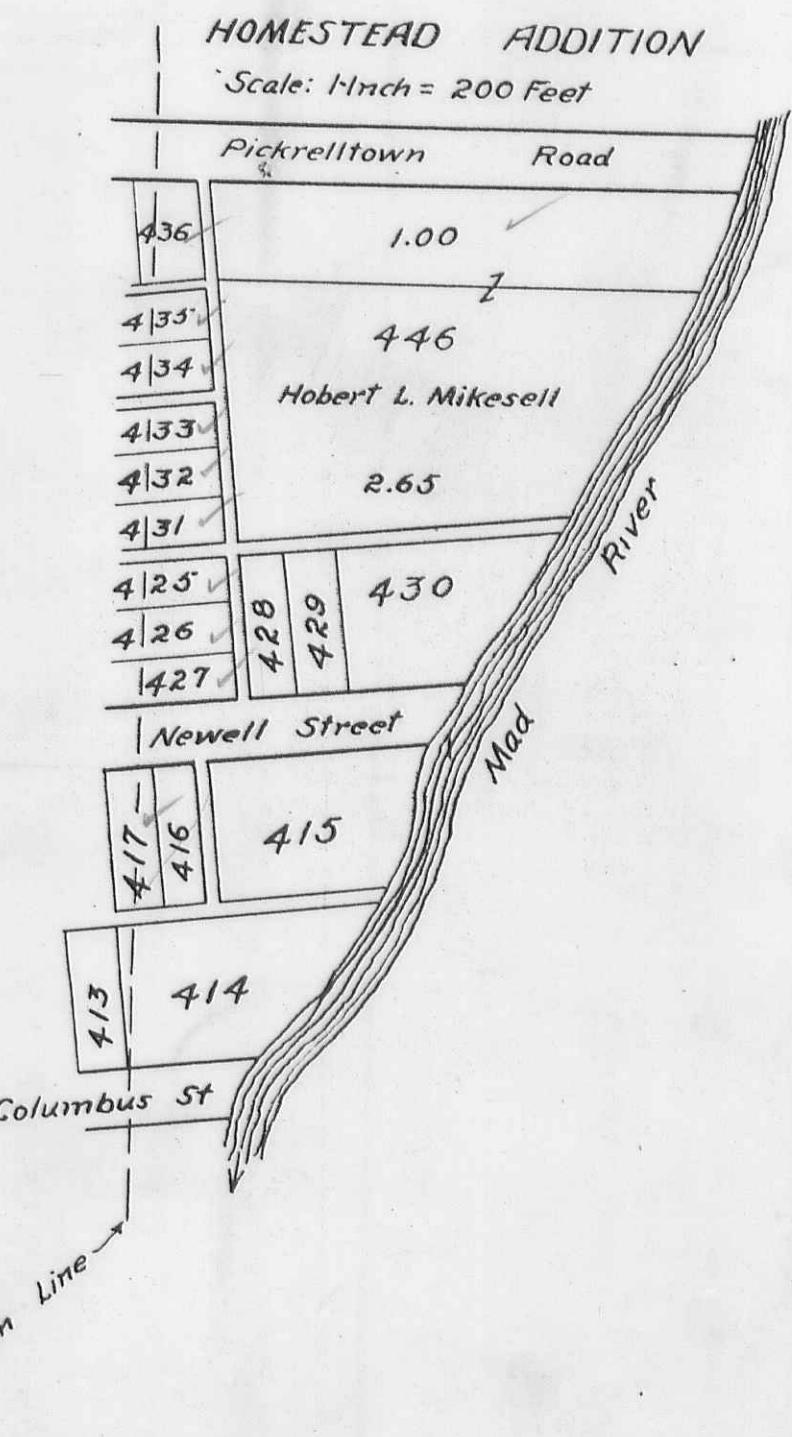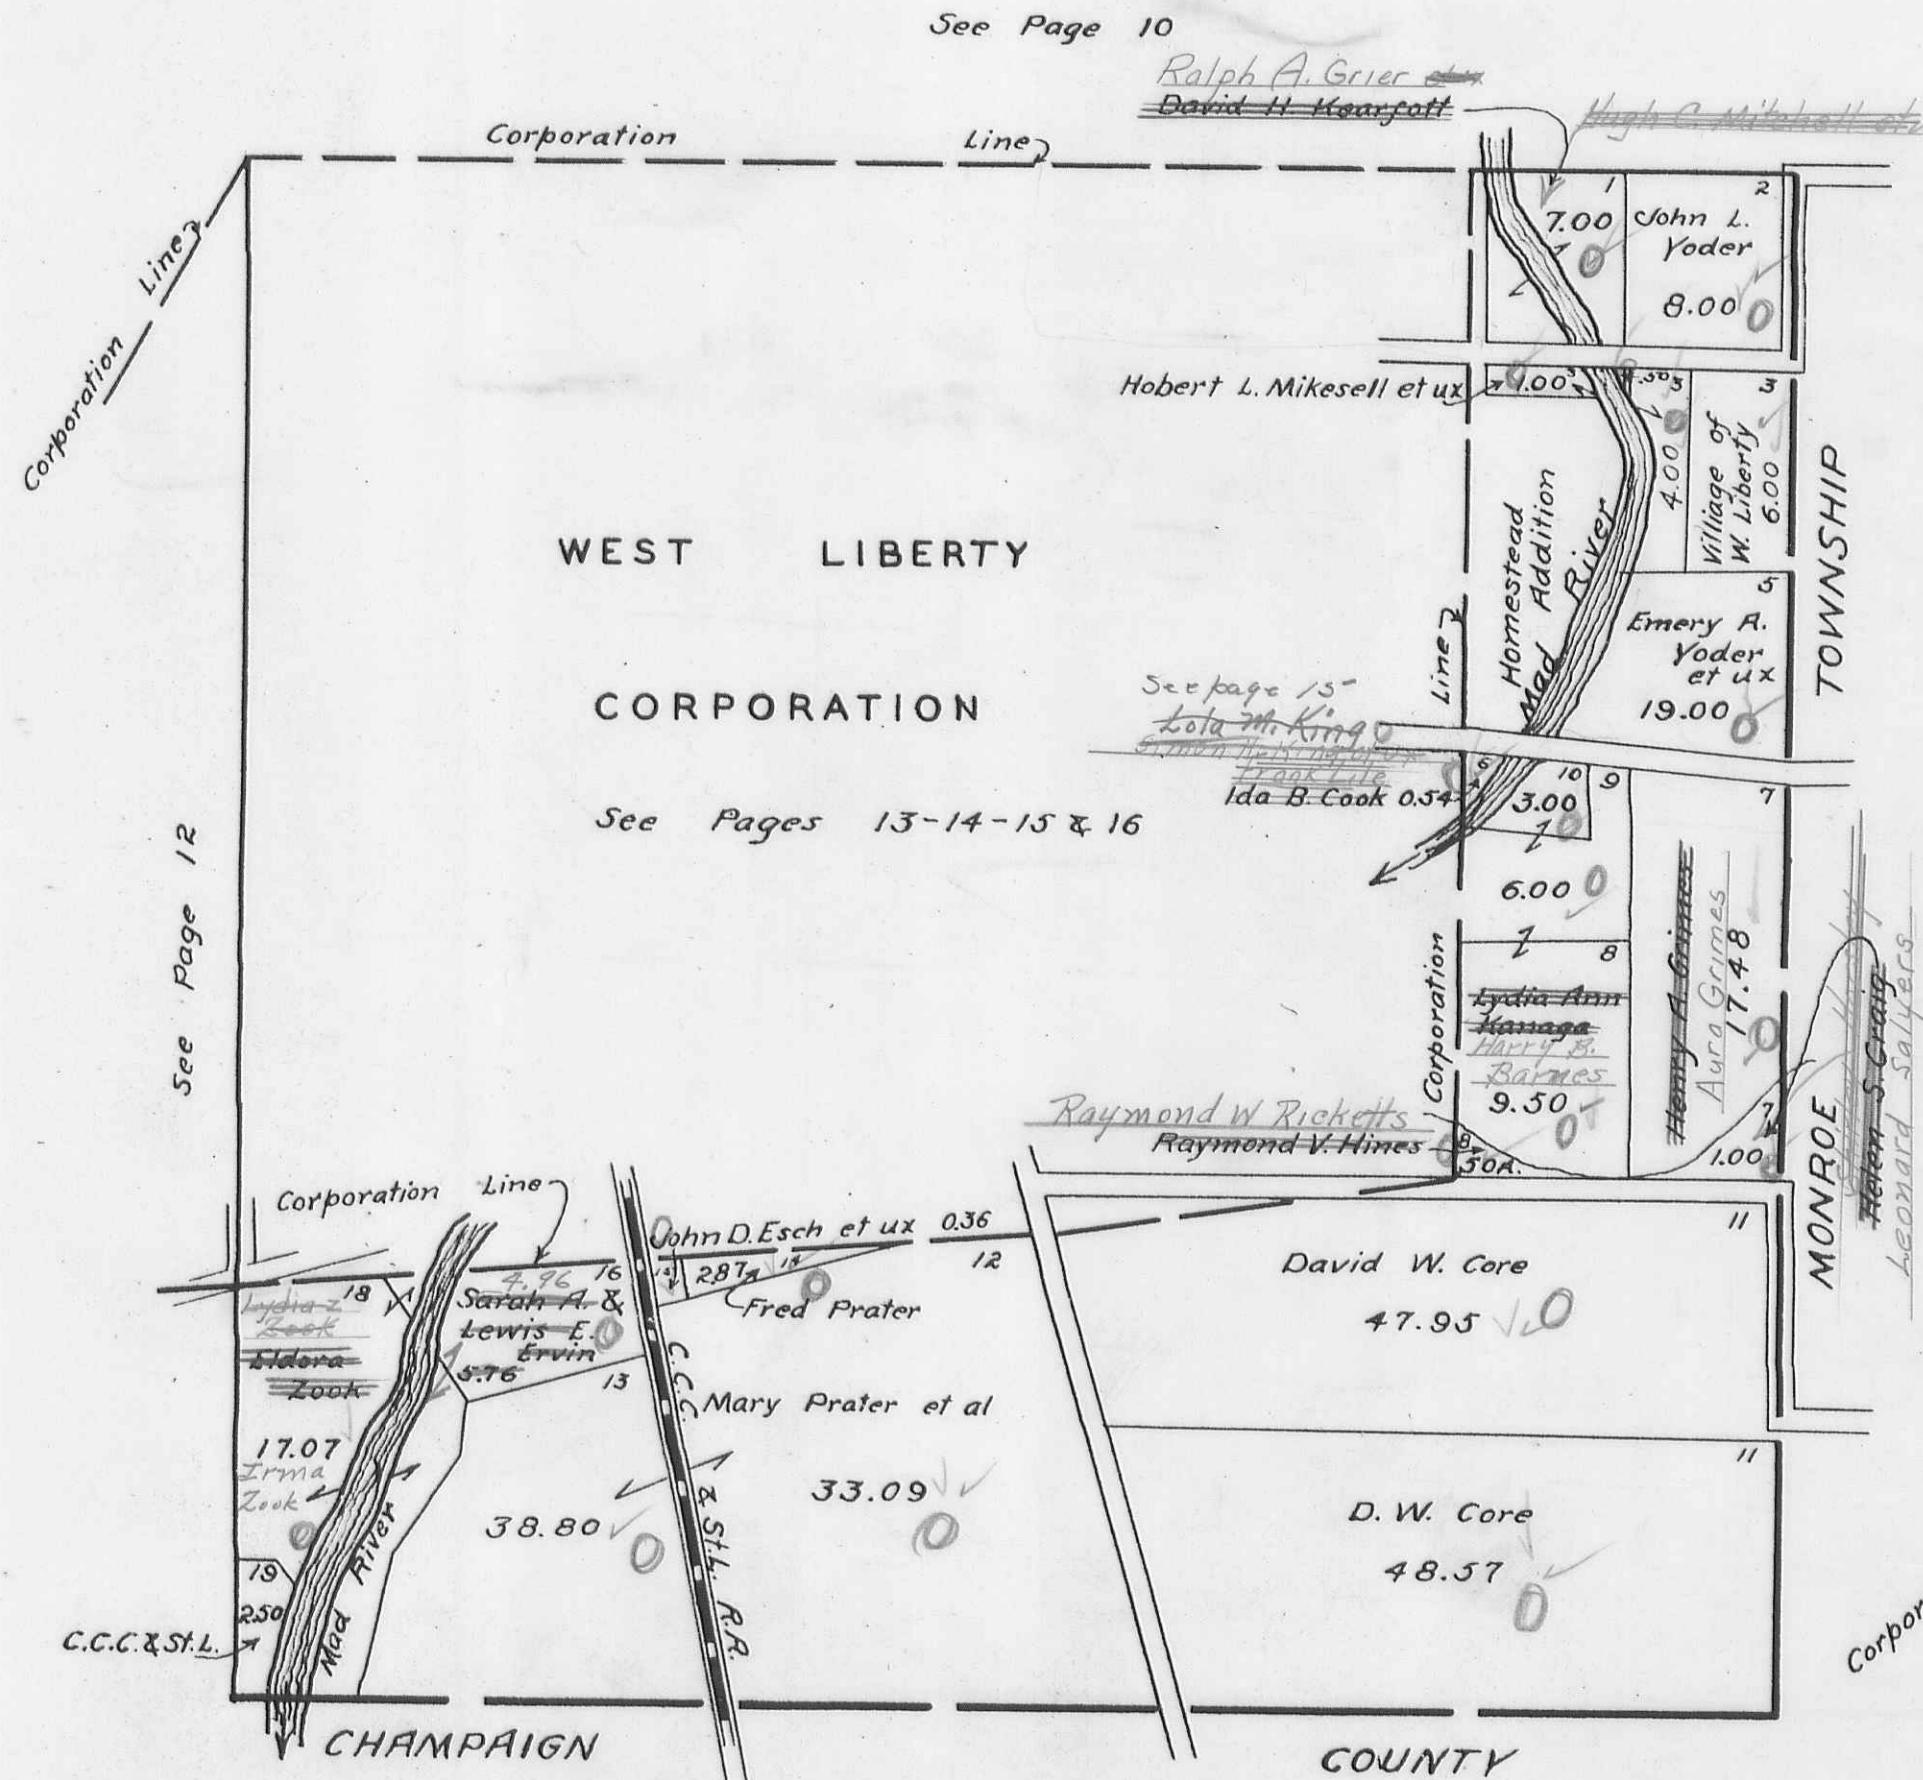

LIBERTY TOWNSHIP
SECTION 33 TOWN 5 RANGE 13

SCALE 10 CHAINS TO THE INCH

PAGE 12

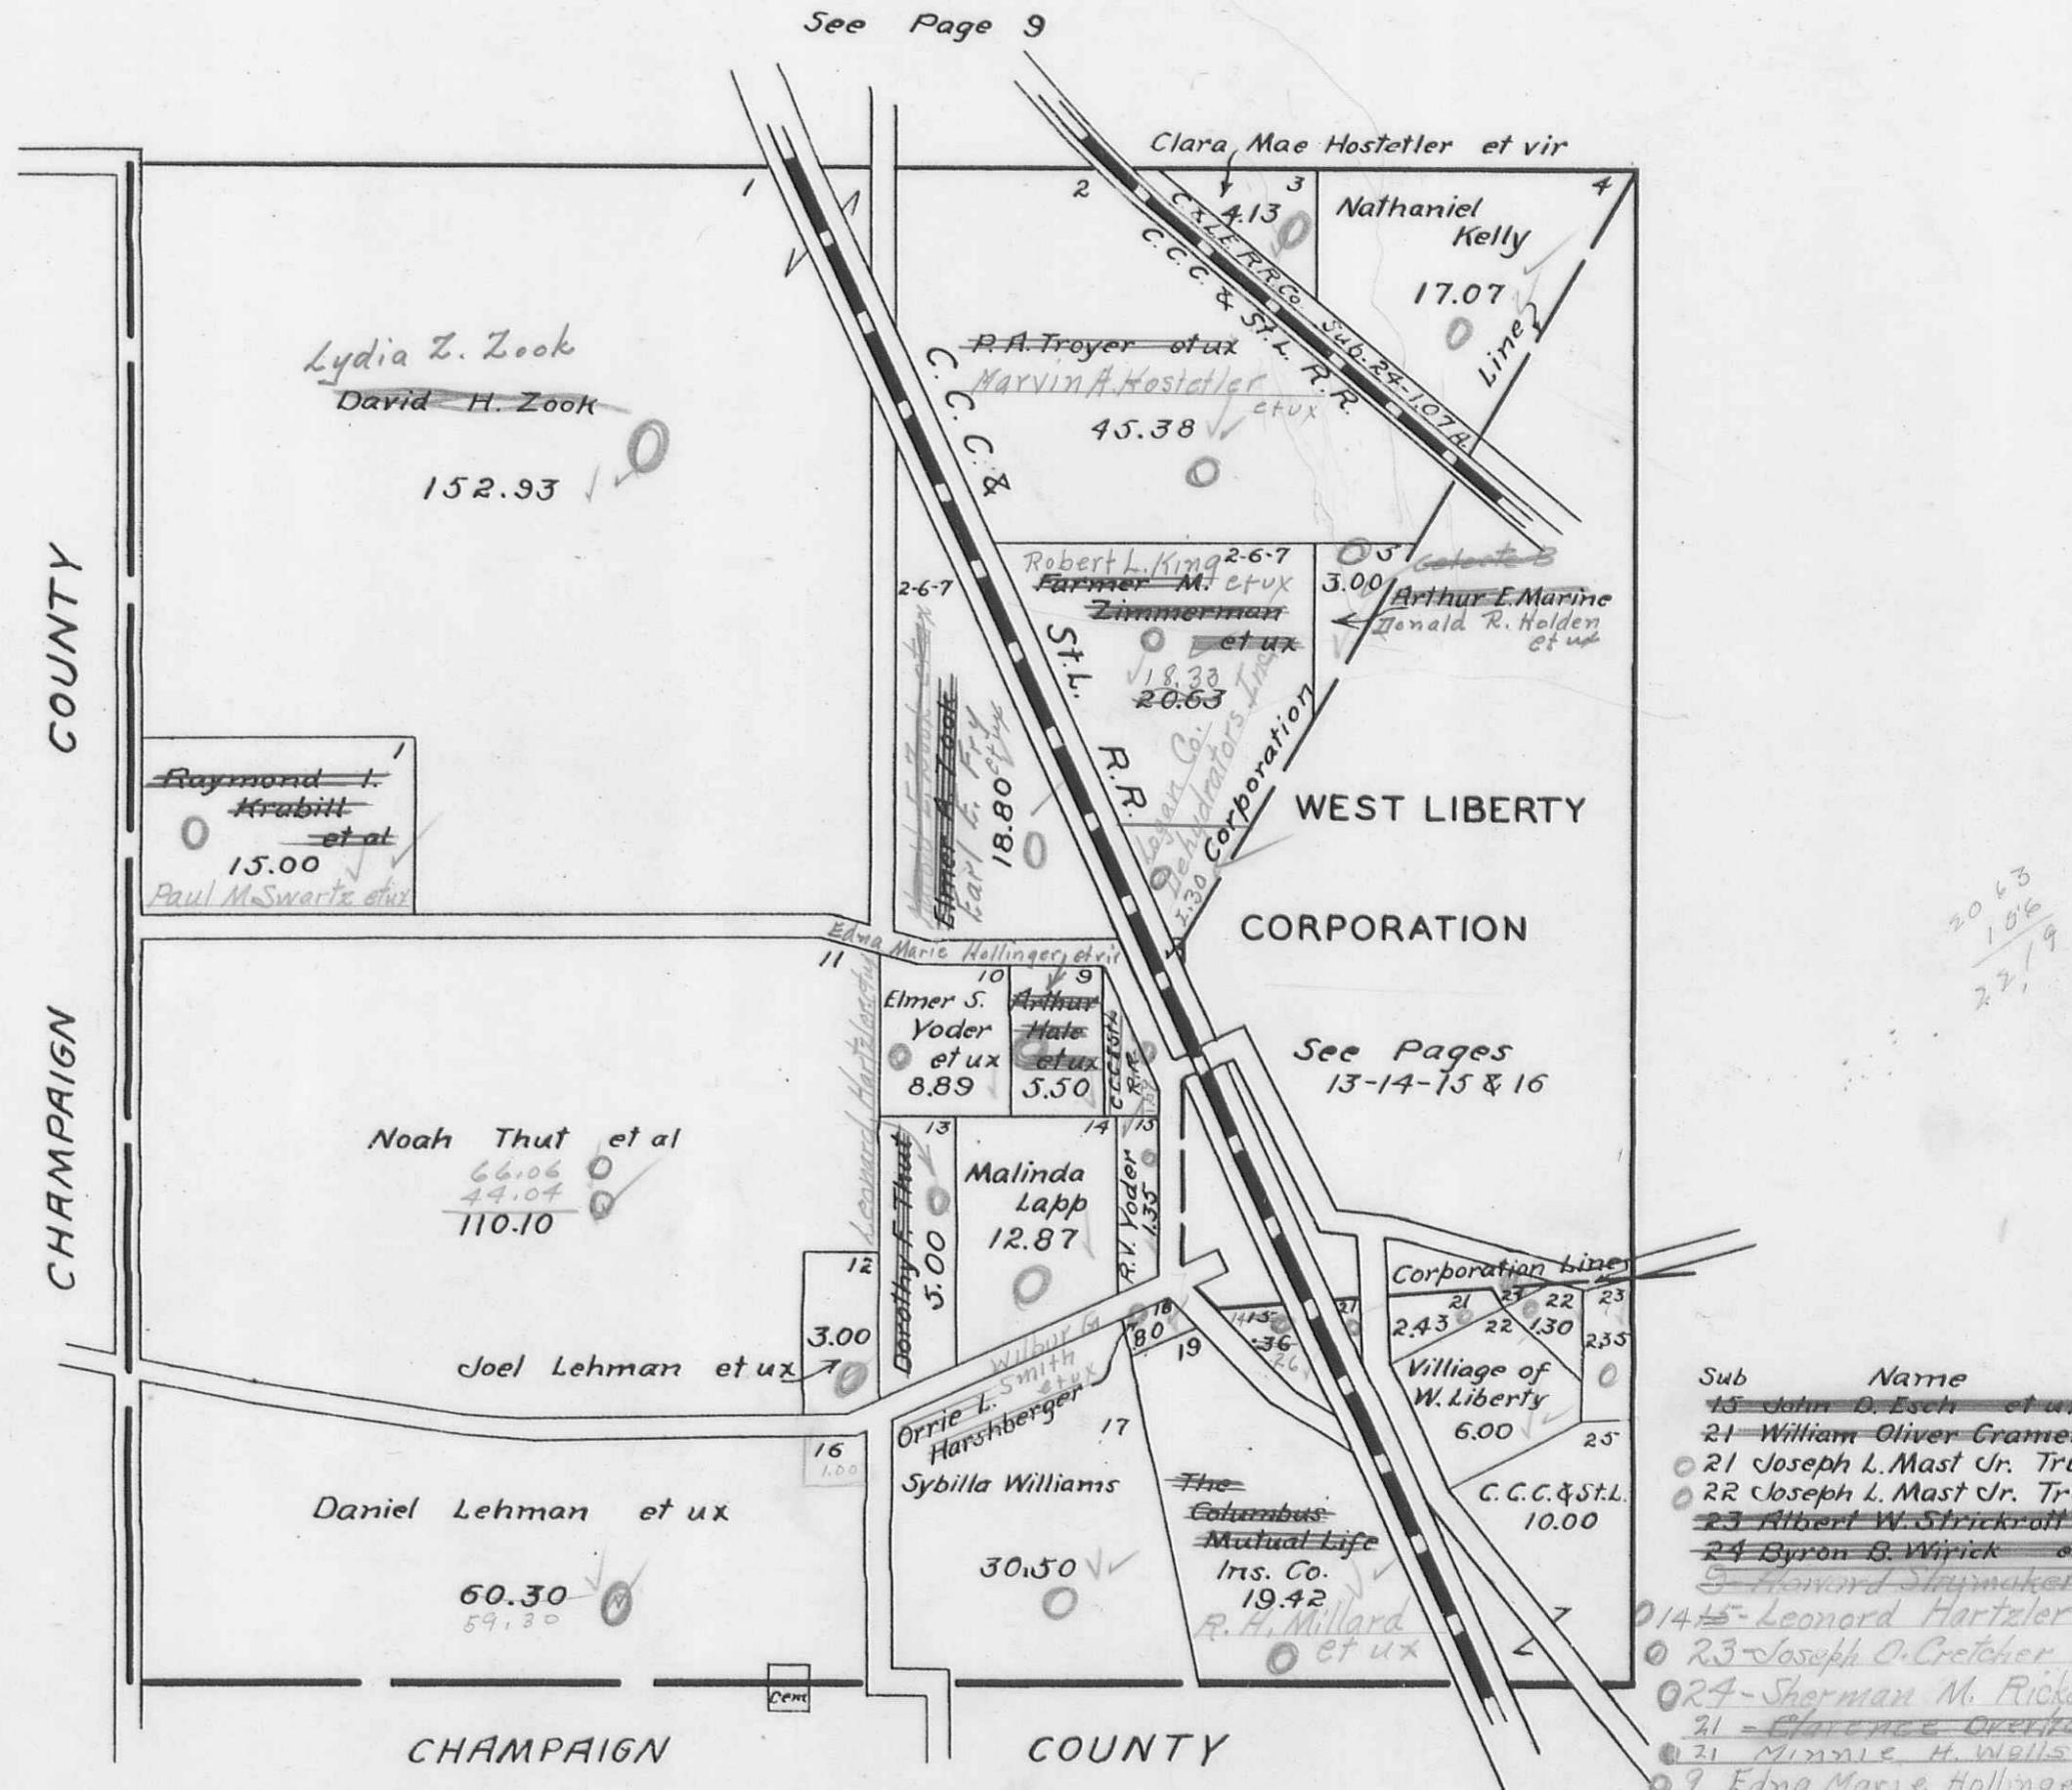


LIBERTY TOWNSHIP
WEST LIBERTY CORPORATION

SCALE 200 FEET TO THE INCH

PAGE 13


"Void"
See New page 13

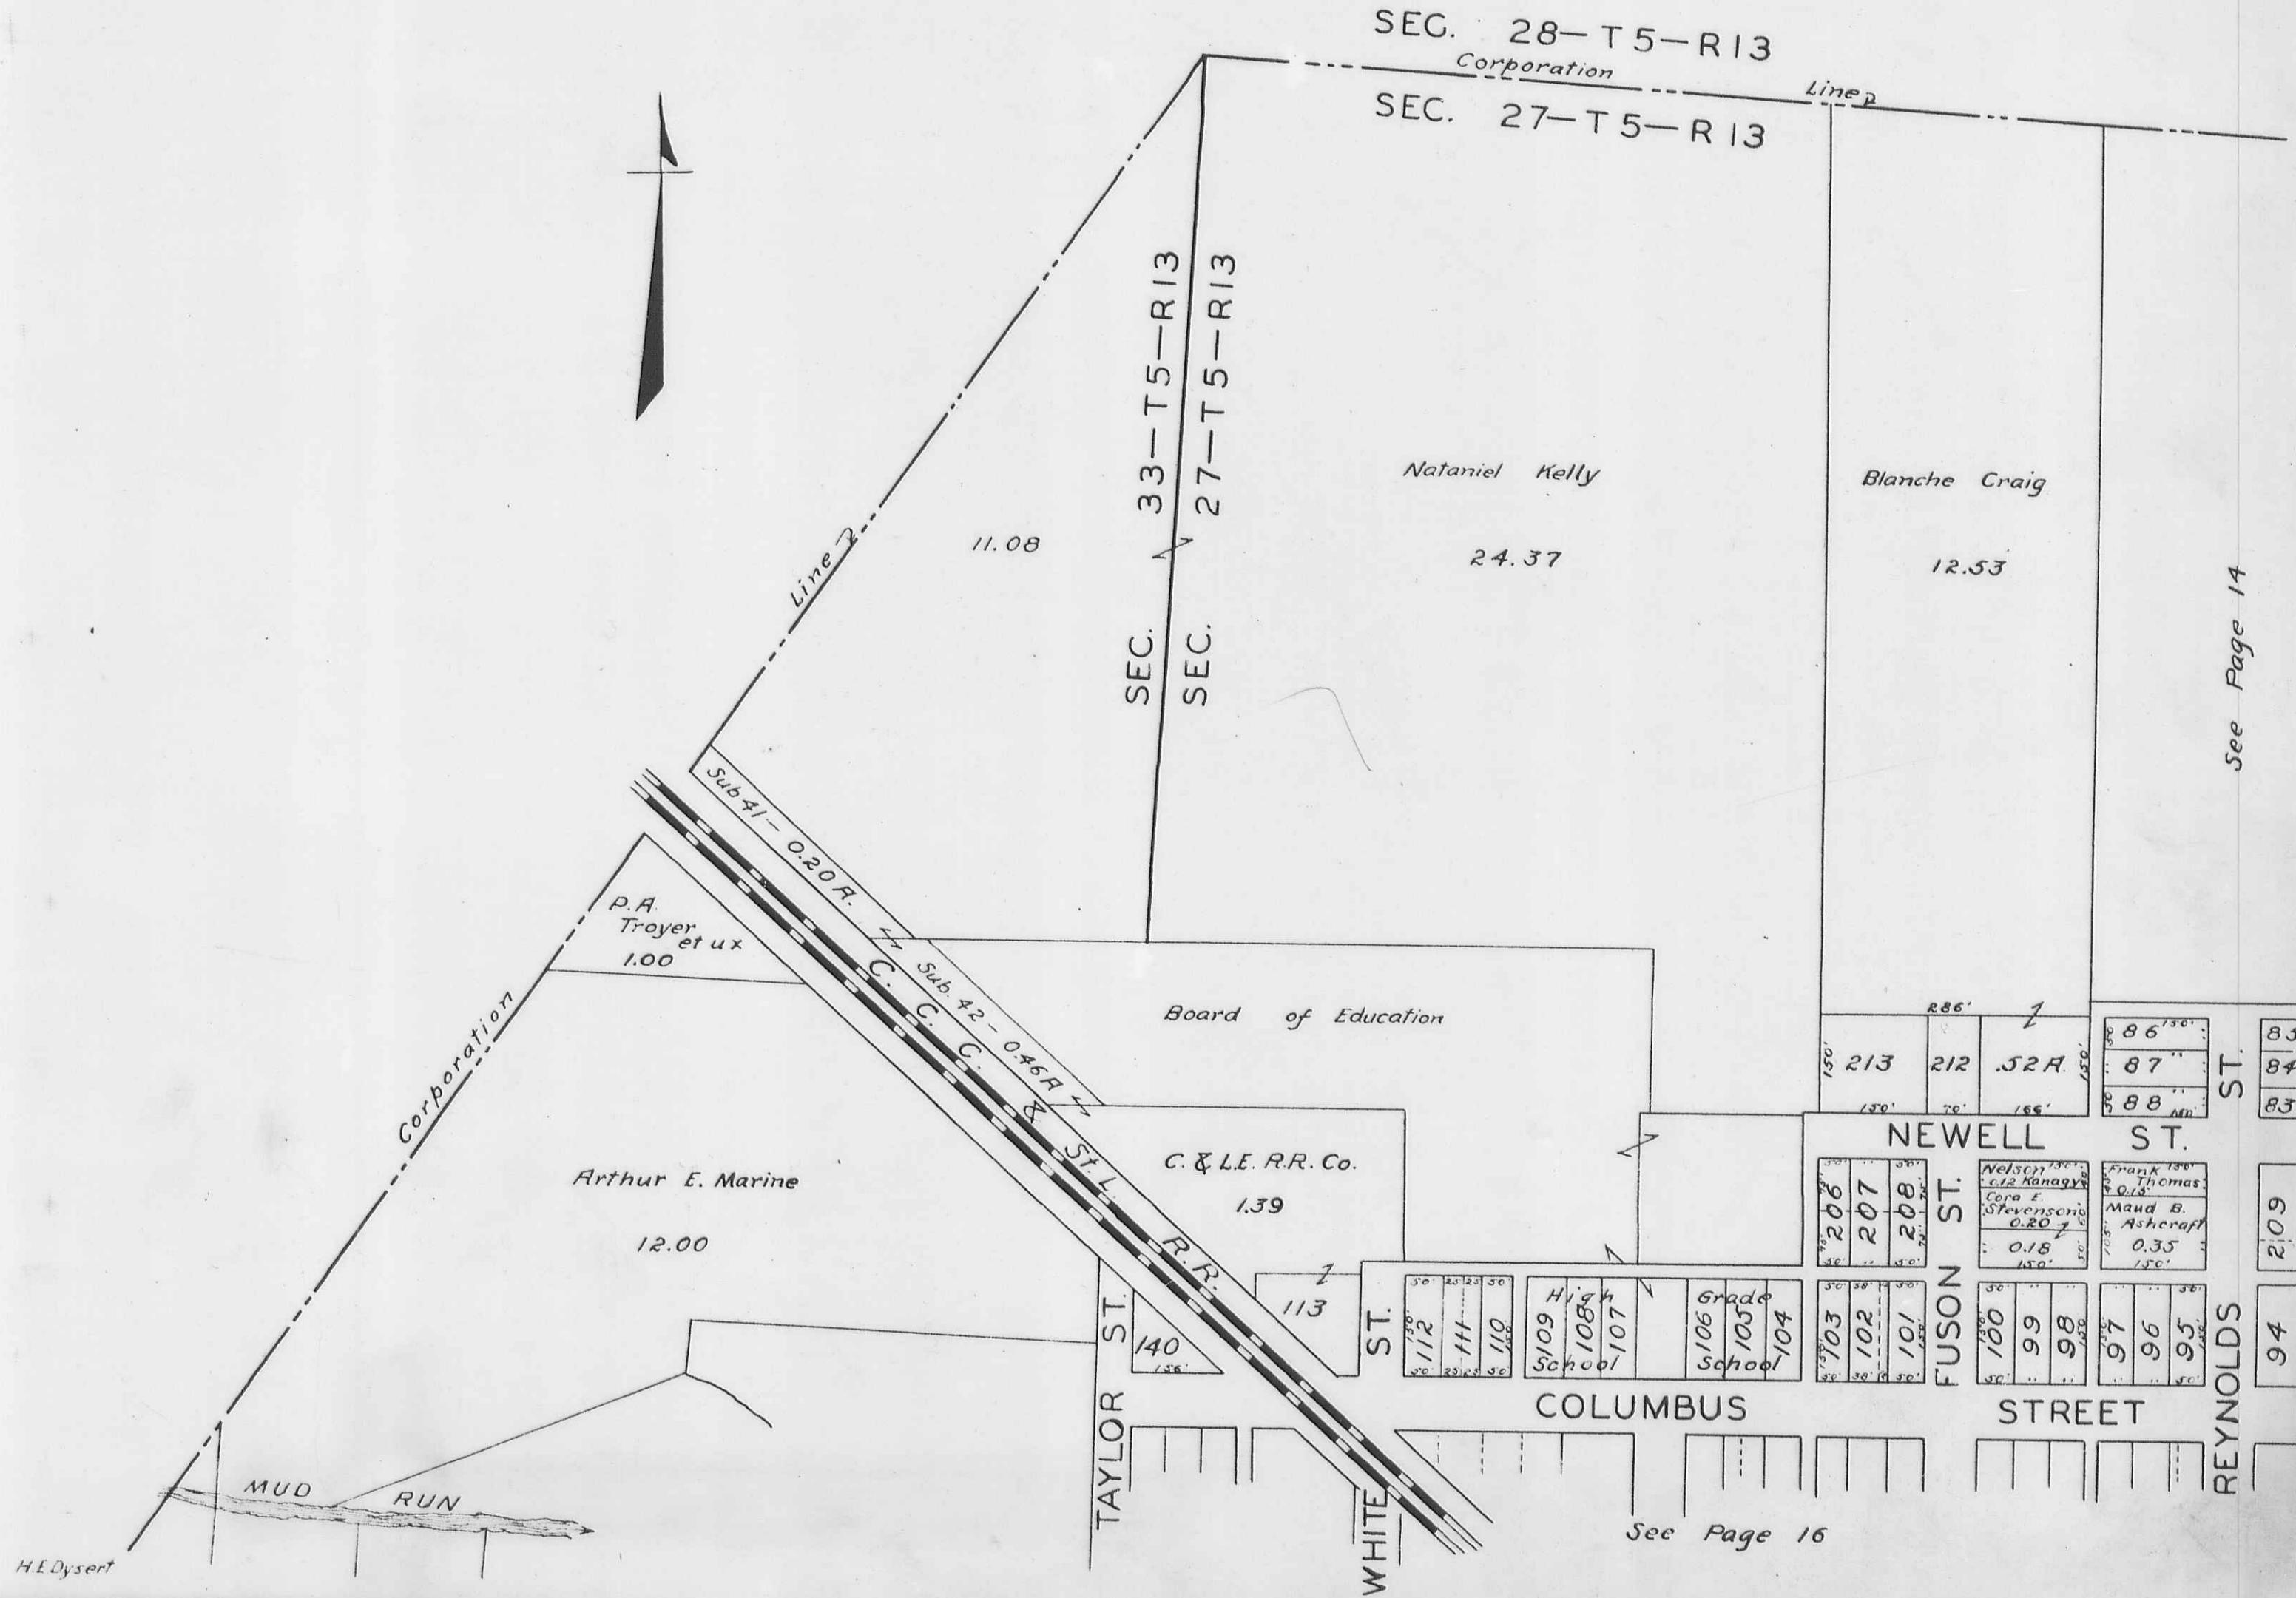

**LIBERTY TOWNSHIP
WEST LIBERTY CORPORATION**

PAGE 13

SCALE 200 FEET TO THE INCH

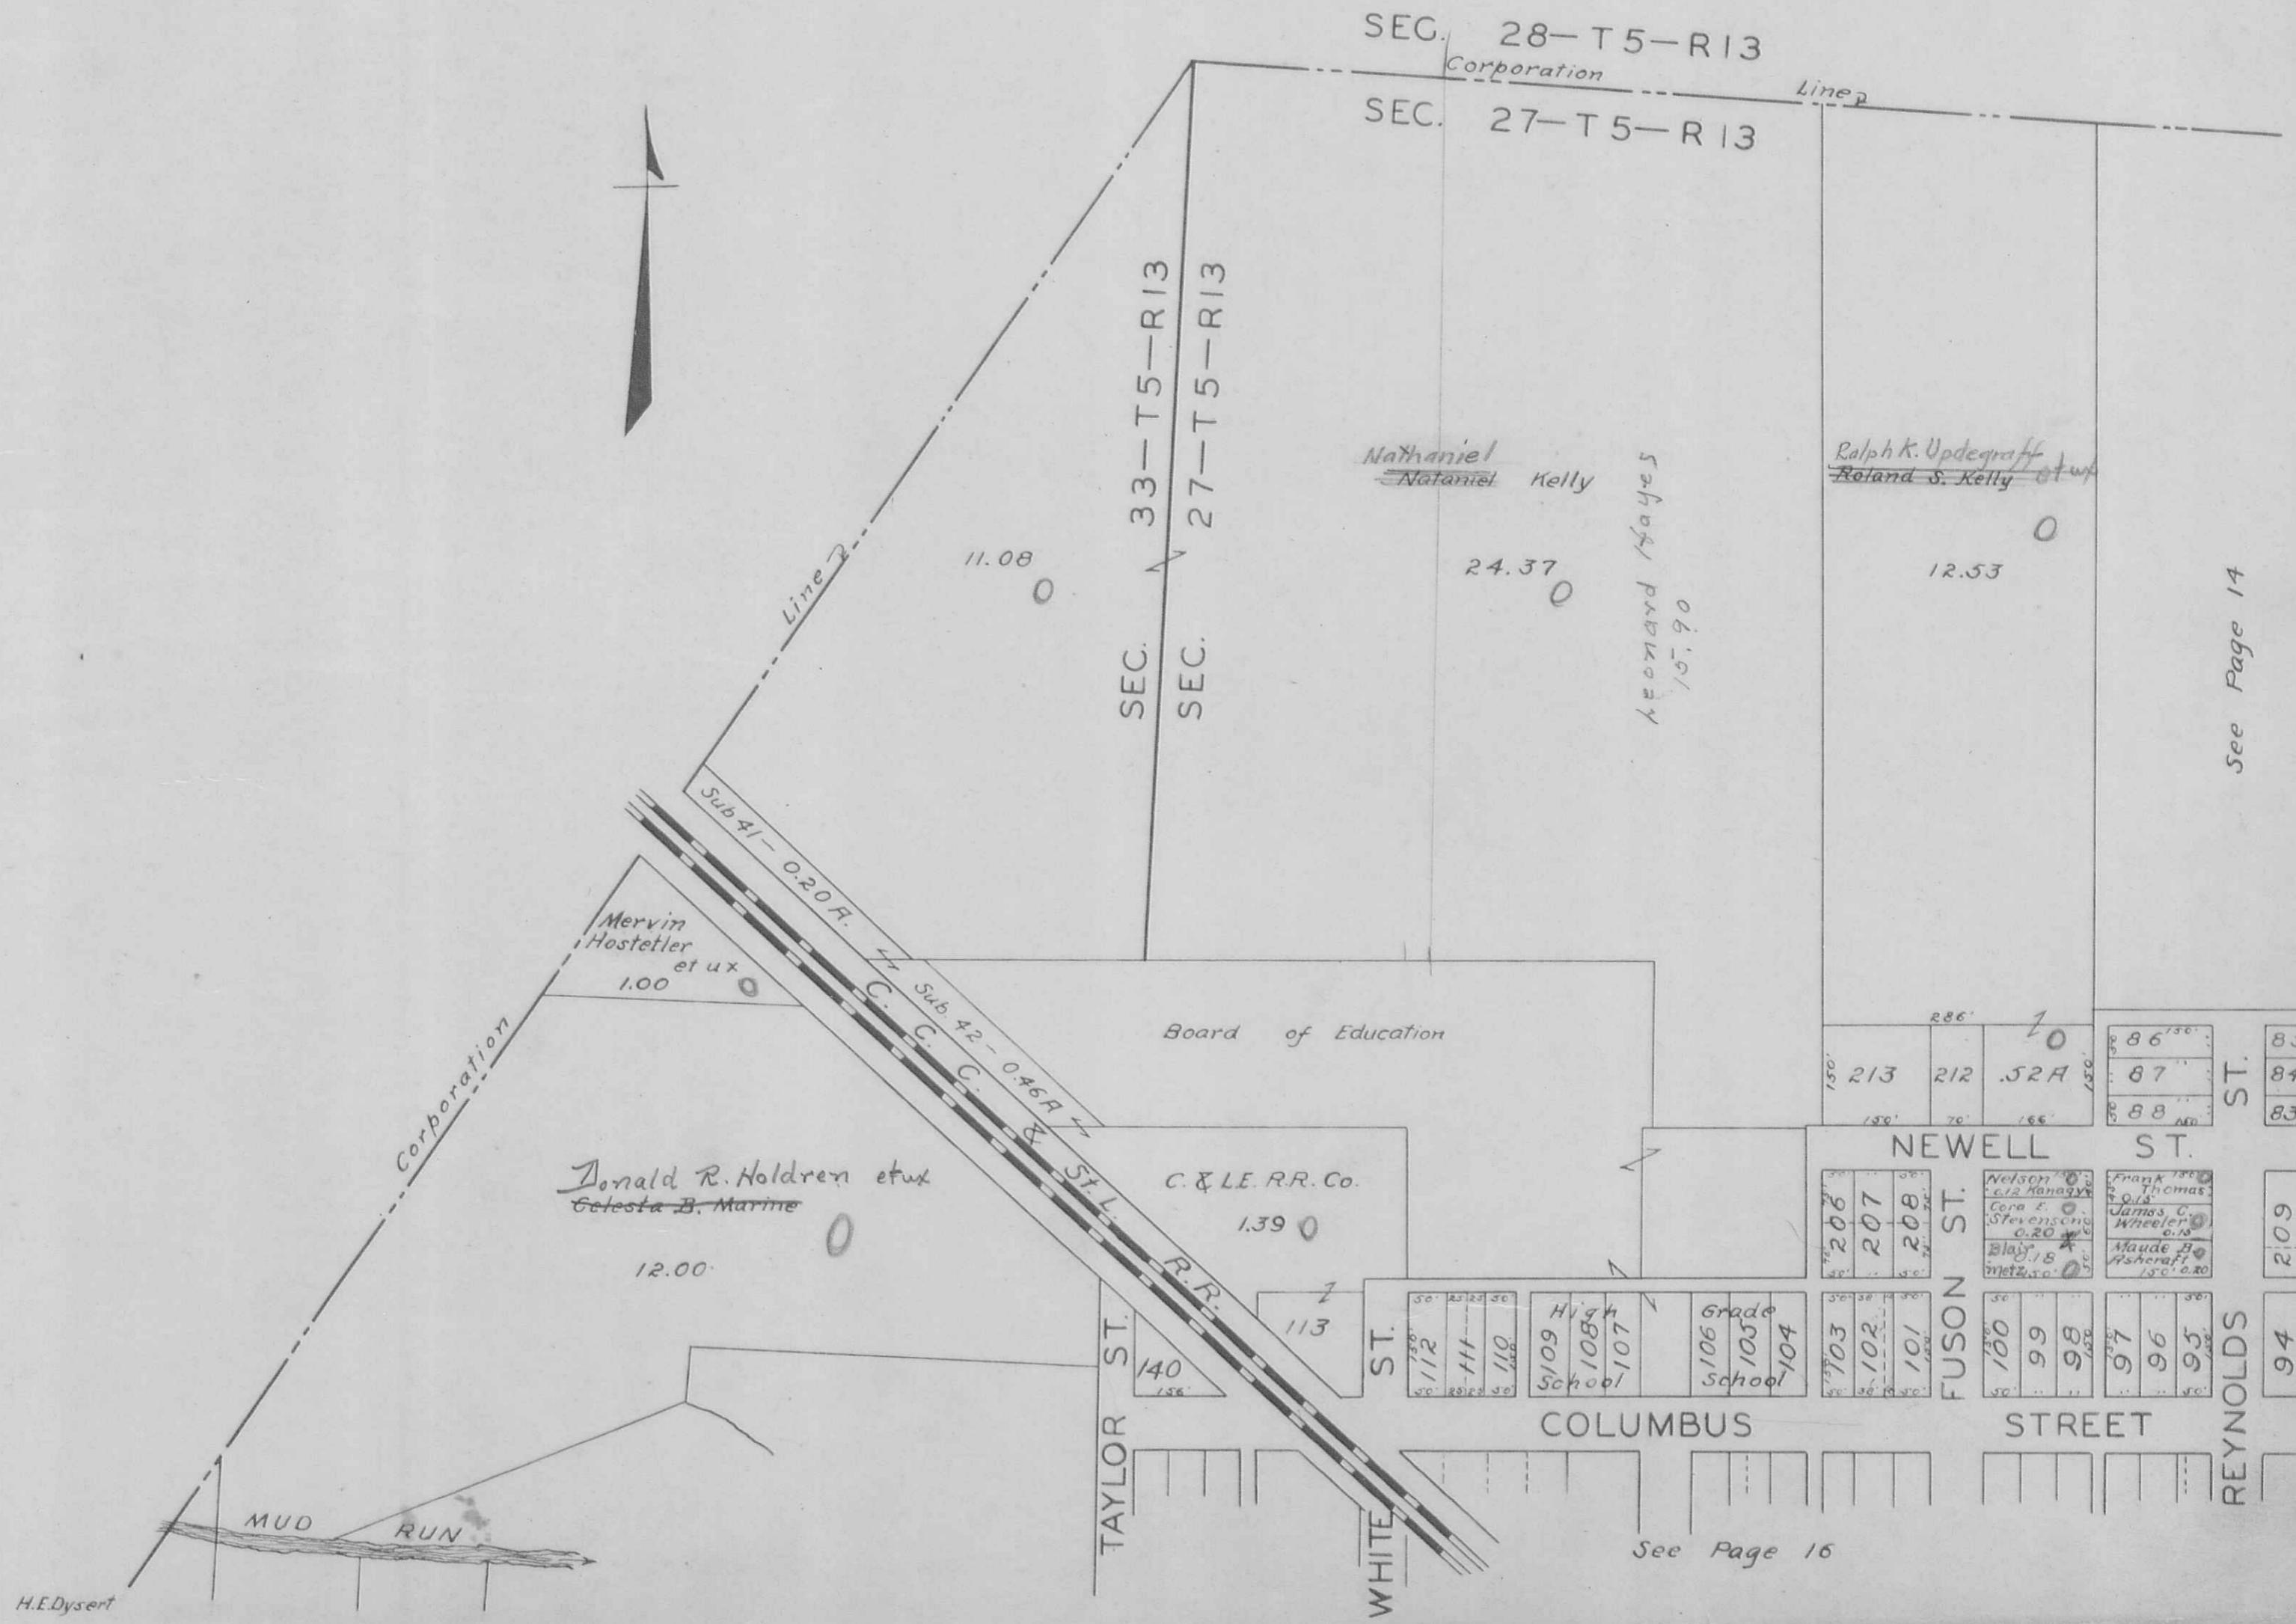


LIBERTY

TOWNSHIP

PAGE 14

WEST LIBERTY CORPORATION

SCALE 200 FEET TO THE INCH

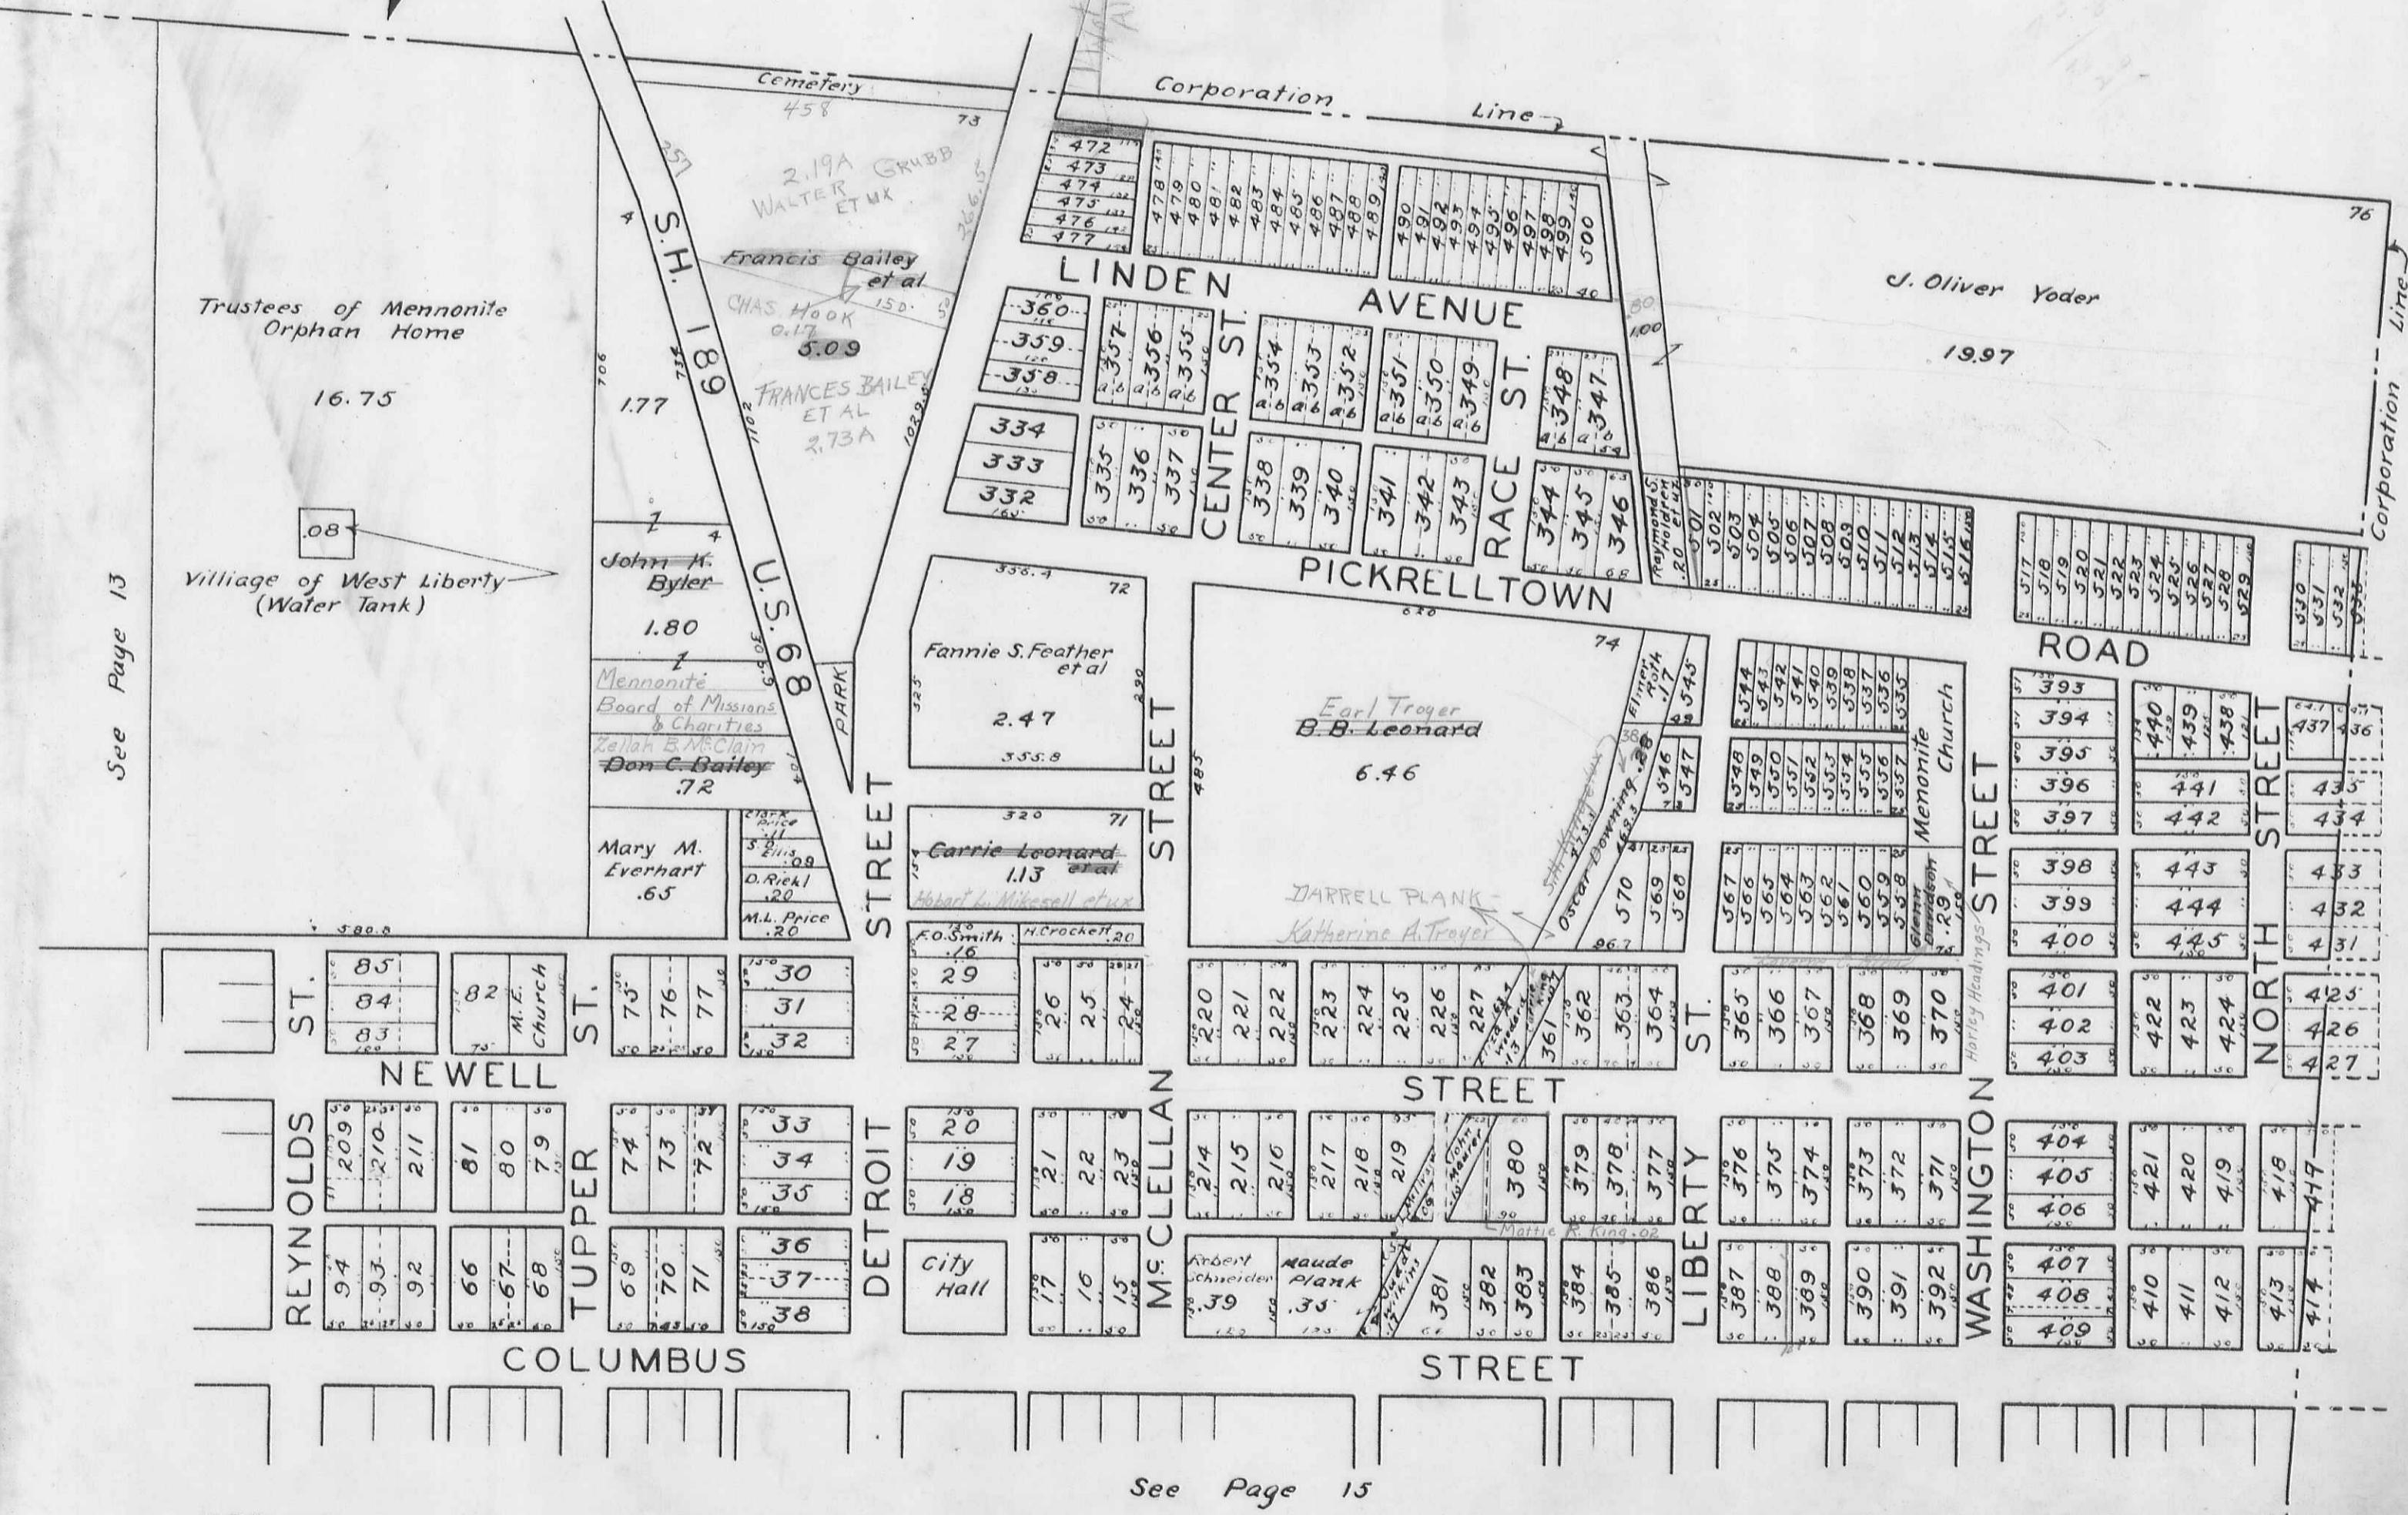*"Void"**See New page 14*

**LIBERTY TOWNSHIP
WEST LIBERTY CORPORATION**

PAGE 14

SCALE 200 FEET TO THE INCH

See Page 13

Trustees of Mennonit
Orphan Home

16.7

Village of West Liberty
(Water Tank)

DETROIT

COLUMBUS

H.E. Dysert

See Page 15

LIBERTY TOWNSHIP

PAGE 15

WEST LIBERTY CORPORATION

SCALE 200 FEET TO THE INCH

"Void"
See New page 15

See Page 16

STREET

178	183
177	184
176	185
175	186
174	187
173	188
170	180
170	180

STREET

123	195
124	197
125	196
126	194
127	193
128	192
129	191
129	190

STREET

89	65
90	64
91	63
92	54
93	55
94	56
95	55
96	56

STREET

42	11
43	10
44	12
45	13
46	14
47	15
48	16
49	17
50	18

STREET

57	57
58	58
59	59
60	60
61	61
62	62
63	63
64	64
65	65

STREET

11	11
12	12
13	13
14	14
15	15
16	16
17	17
18	18
19	19

STREET

40	40
41	41
42	42
43	43
44	44
45	45
46	46
47	47
48	48
49	49
50	50

STREET

10	10
11	11
12	12
13	13
14	14
15	15
16	16
17	17
18	18
19	19

STREET

11	11
12	12
13	13
14	14
15	15
16	16
17	17
18	18
19	19

STREET

11	11
12	12
13	13
14	14
15	15
16	16
17	17
18	18
19	19

STREET

11	11
12	12
13	13
14	14
15	15
16	16
17	17
18	18
19	19

STREET


11	11

<

LIBERTY TOWNSHIP
WEST LIBERTY CORPORATION

PAGE 16

SCALE 200 FEET TO THE INCH

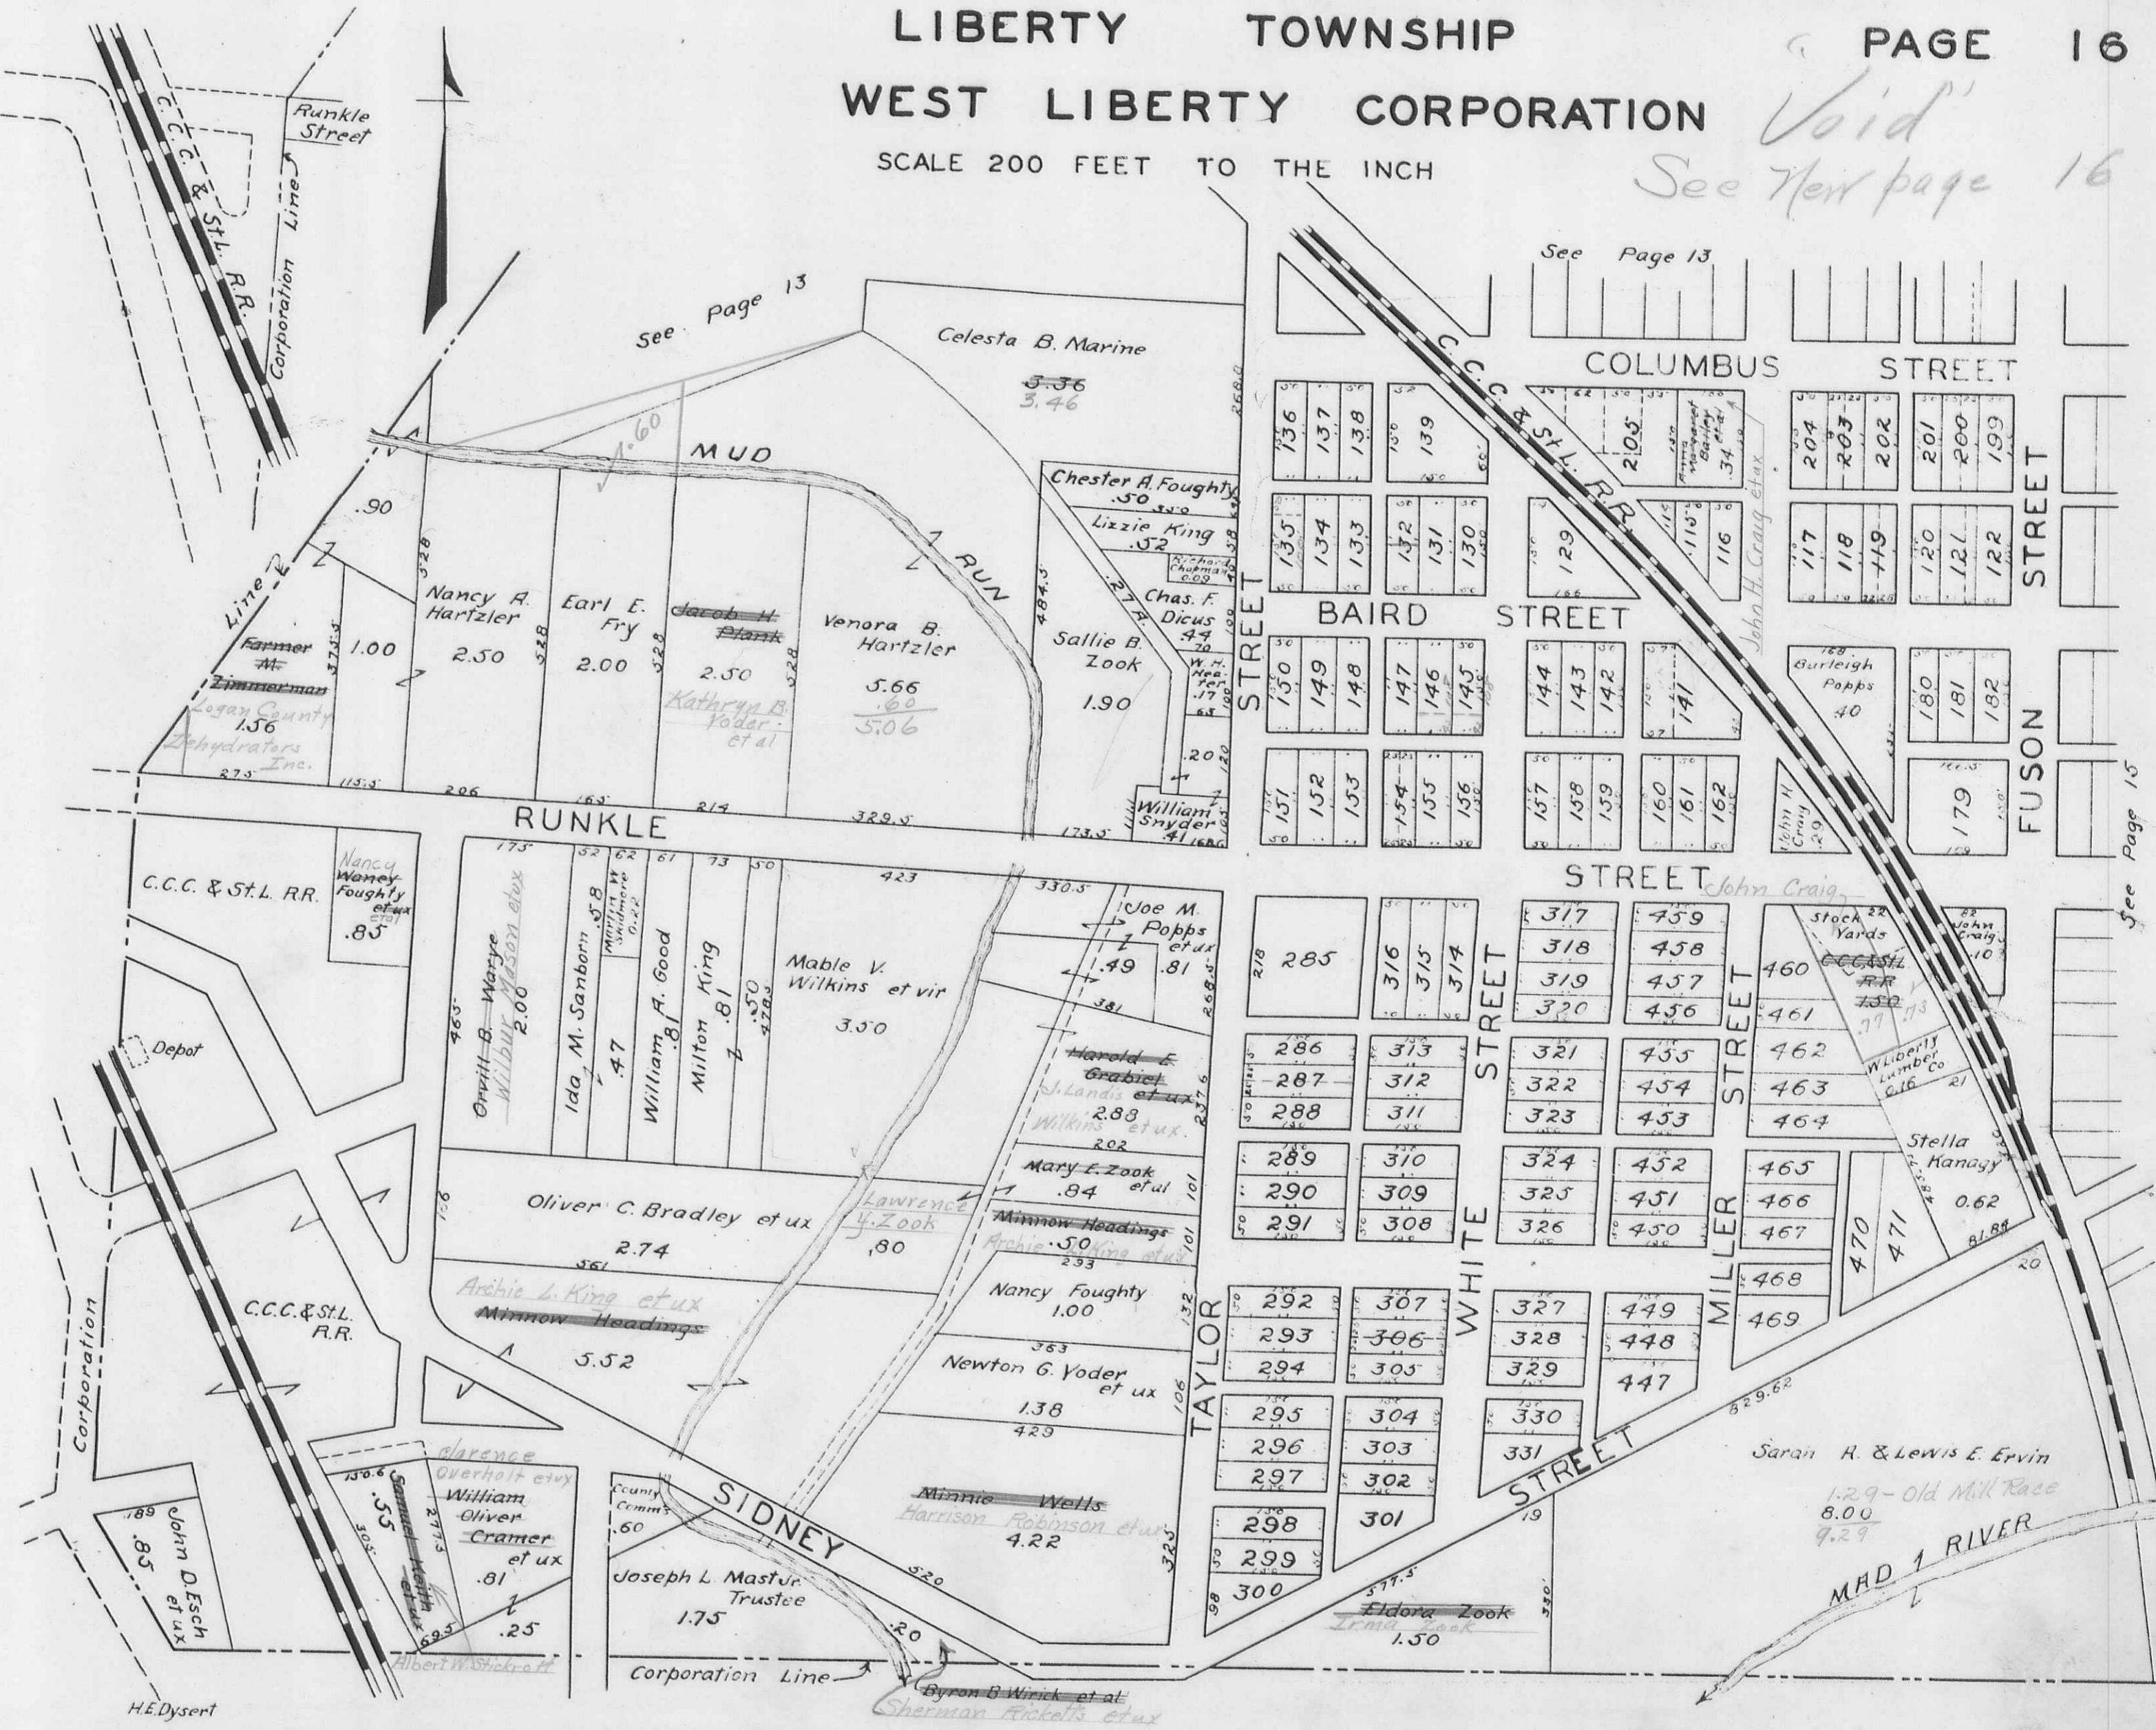

**LIBERTY TOWNSHIP
WEST LIBERTY CORPORATION**

PAGE 16

SCALE 200 FEET TO THE INCH

see page 13

Donald R. Holdren
Gretesta B. Marine

See Page 1

COLUMBUS STREET

STREET

1

15

LIBERTY

WEST LIBER

SCALE 200 FEET

RUNKLE

Amos V. Hartzler	James B. Bennett	Kathryn Yoder et al.	Venora B. Hartzler
1.00	2.50	2.50	5.06
0	0	0	0

SIDNEY

Marion Hostettler et ux	Wilbur Mason et ux	Ida M. Sanborn	William A. Good	Milton King	Mable V. Wilkins et vir
.85	2.00	.58	0	0	0
0	0	0	0	0	0

CORPORATION LINE

Harrison Robinson et ux	Joseph L. Mast Jr. Trustee
4.22	1.75
0	0

Logan Co. Dehydrator Inc.

Robert L. King et ux
1.56
0

RUNKLE STREET

John D. Esch et ux
.85
0

Corporation Line

Donald R. Holdren et Cestesta B. Martine
3.56
0

CHESTER A. FOUE

Lizzie Kin
0 .52
0

WILLIE A. BOYD

Joe M. Papp
1.90
0

WILLIAM SNYDER

Wm. H. Snyder et al
1.73.5
0

WILLIAM SNYDER

William Snyder
41
0

See page 13

Scale 200 feet

See Page 13

TAYLOR

292	293	294	295	296	297	298	299	300
237.6	101	101	285	286	287	288	289	290
268.0	50	50	285	313	312	311	310	309
4	50	50	314	315	316	317	318	319

BAIRD STREET

151	152	153	149	148	147	146	145	154
50	50	50	50	50	50	50	50	50
150	150	150	150	150	150	150	150	150
50	50	50	50	50	50	50	50	50

COLUMBUS STREET

136	137	138	139	130	132	131	130	139
50	50	50	50	50	50	50	50	50
135	135	135	135	135	135	135	135	135
50	50	50	50	50	50	50	50	50

WHITE STREET

321	322	323	324	325	326	327	328	329	330	331
50	50	50	50	50	50	50	50	50	50	50
150	150	150	150	150	150	150	150	150	150	150
50	50	50	50	50	50	50	50	50	50	50

MILLER STREET

460	461	462	463	464	465	466	467	468	469	470	471
50	50	50	50	50	50	50	50	50	50	50	50
150	150	150	150	150	150	150	150	150	150	150	150
50	50	50	50	50	50	50	50	50	50	50	50

FUSION STREET

117	118	119	179	181	182
50	50	50	50	50	50
150	150	150	150	150	150
50	50	50	50	50	50

RIVER

204	205	202	201	200	199
50	50	50	50	50	50
150	150	150	150	150	150
50	50	50	50	50	50

Irma Zook
1.50 O

George W. Kanagy
Sarah A. & Lewis E. Ervin
7.63

W. Liberty Lumber Co.
John H. Craig
29

Craig's Coal & Elter, Inc.

Stella Kanagy
0.62
81.84

Mad River
Irma Zook
O 2.30 +

See Page 15