

McARTHUR
TOWNSHIP
1942

McARTHUR
INDEX

TOWNSHIP
MAP

VIRGINIA MILITARY SURVEYS	PAGE
9946 -----	1
9925 -----	1
10121 -----	1
10951 -----	1
12052 -----	1
9927 -----	2
10434 -----	2
12742 -----	2
13715 -----	2
9903 --- NORTH --- PART ---	3
9928 --- NORTH --- PART ---	3
12320 -----	3
12350 -----	3
9903 --- SOUTH --- PART ---	4
9928 --- SOUTH --- PART ---	4
9904 -----	5
9929 -----	6
9930 -----	7

VIRGINIA MILITARY SURVEYS	PAGE
9931 -----	8
9932 -----	9
9905 -----	10
9906 -----	11
14033 -----	11
9907 -----	12
9902 -----	13
12168 -----	14
McPHERSON -----	16
10122 -----	17
10248 -----	17
10249 -----	17
9881 -----	18
10306 -----	19
10307 -----	19
9883 -----	20
9884 -----	21
9885 -----	21


SECTION	TOWN	RANGE	PAGE
17 -----	7 -----	9 -----	15
18 -----	7 -----	9 -----	15
19 -----	7 -----	9 -----	15
20 -----	7 -----	9 -----	15

McARTHUR TOWNSHIP
VIRGINIA MILITARY SURVEYS
SECTIONS TOWN RANGE
INDEX MAP

CORRECTED TO
APRIL 12-1942

~~January 1, 1945~~
~~April 9-1945~~
~~November 10, 1945~~
January 1, 1947


~~Corrected Jan 1, 1948~~
Jan 1, 1949
June 4, 49
Jan. 1-50

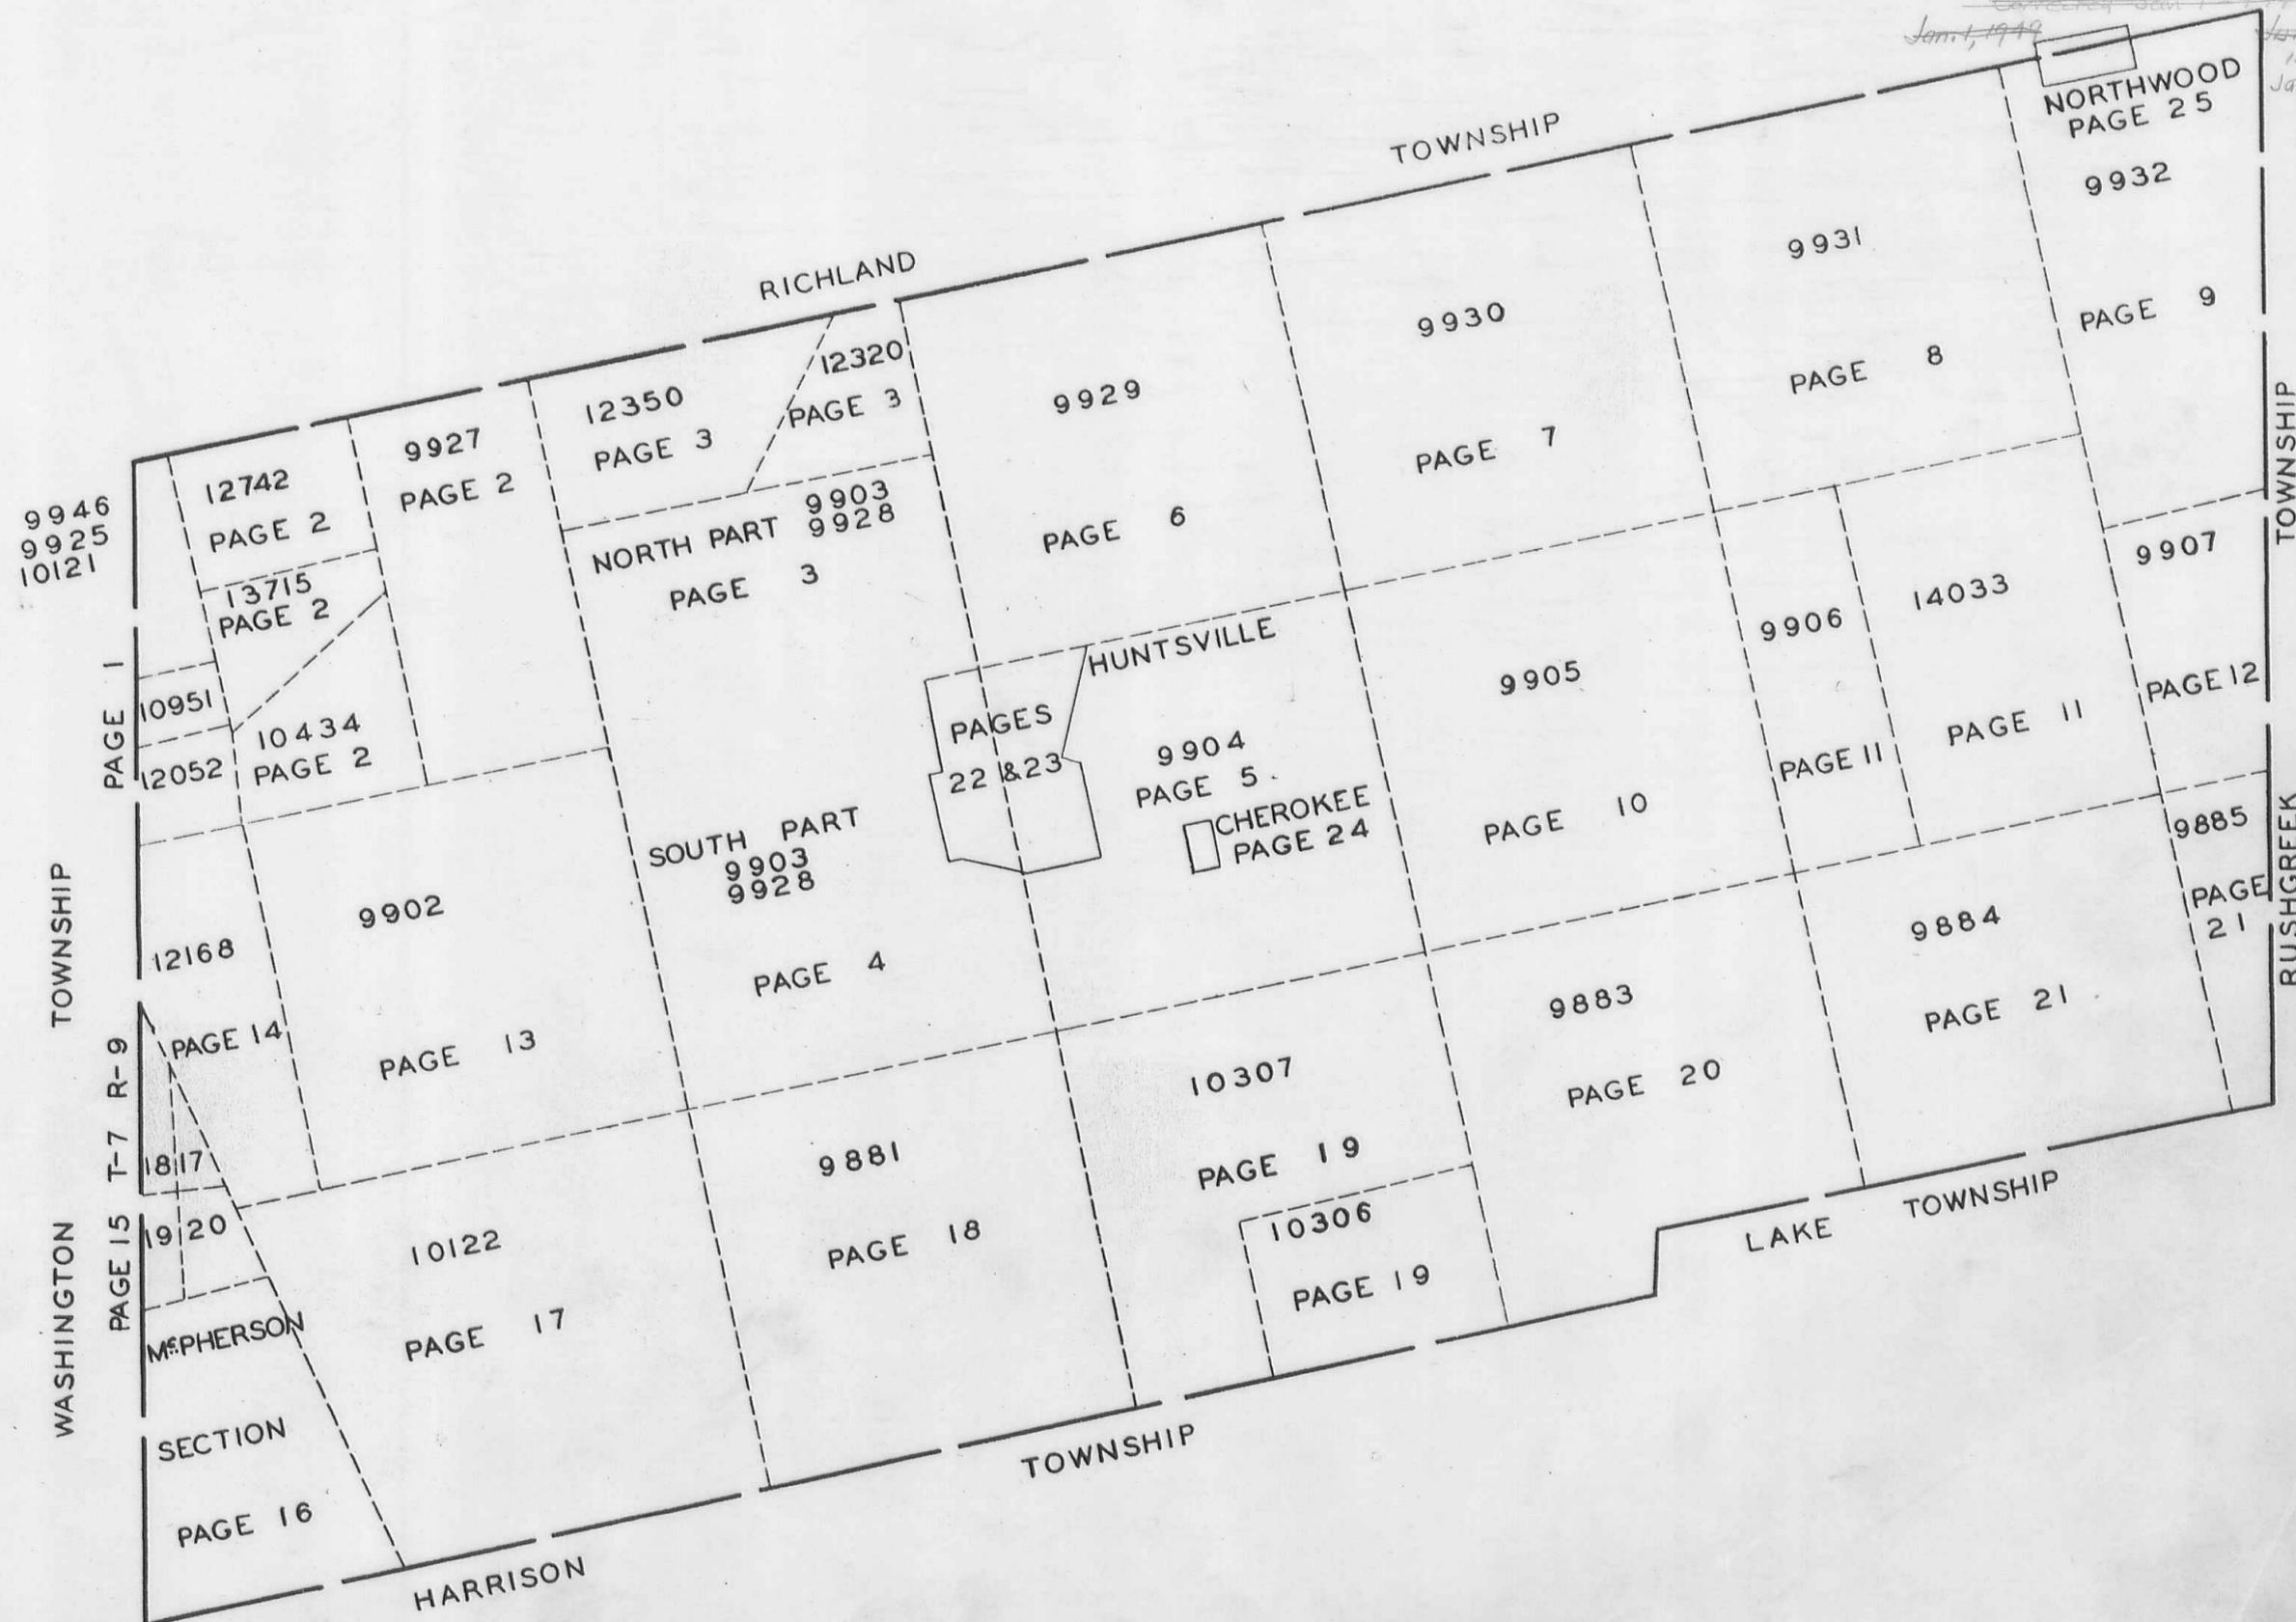

McARTHUR TOWNSHIP
VIRGINIA MILITARY SURVEYS

12742
13715
10434
9927

SCALE 10 CHAINS TO THE INCH

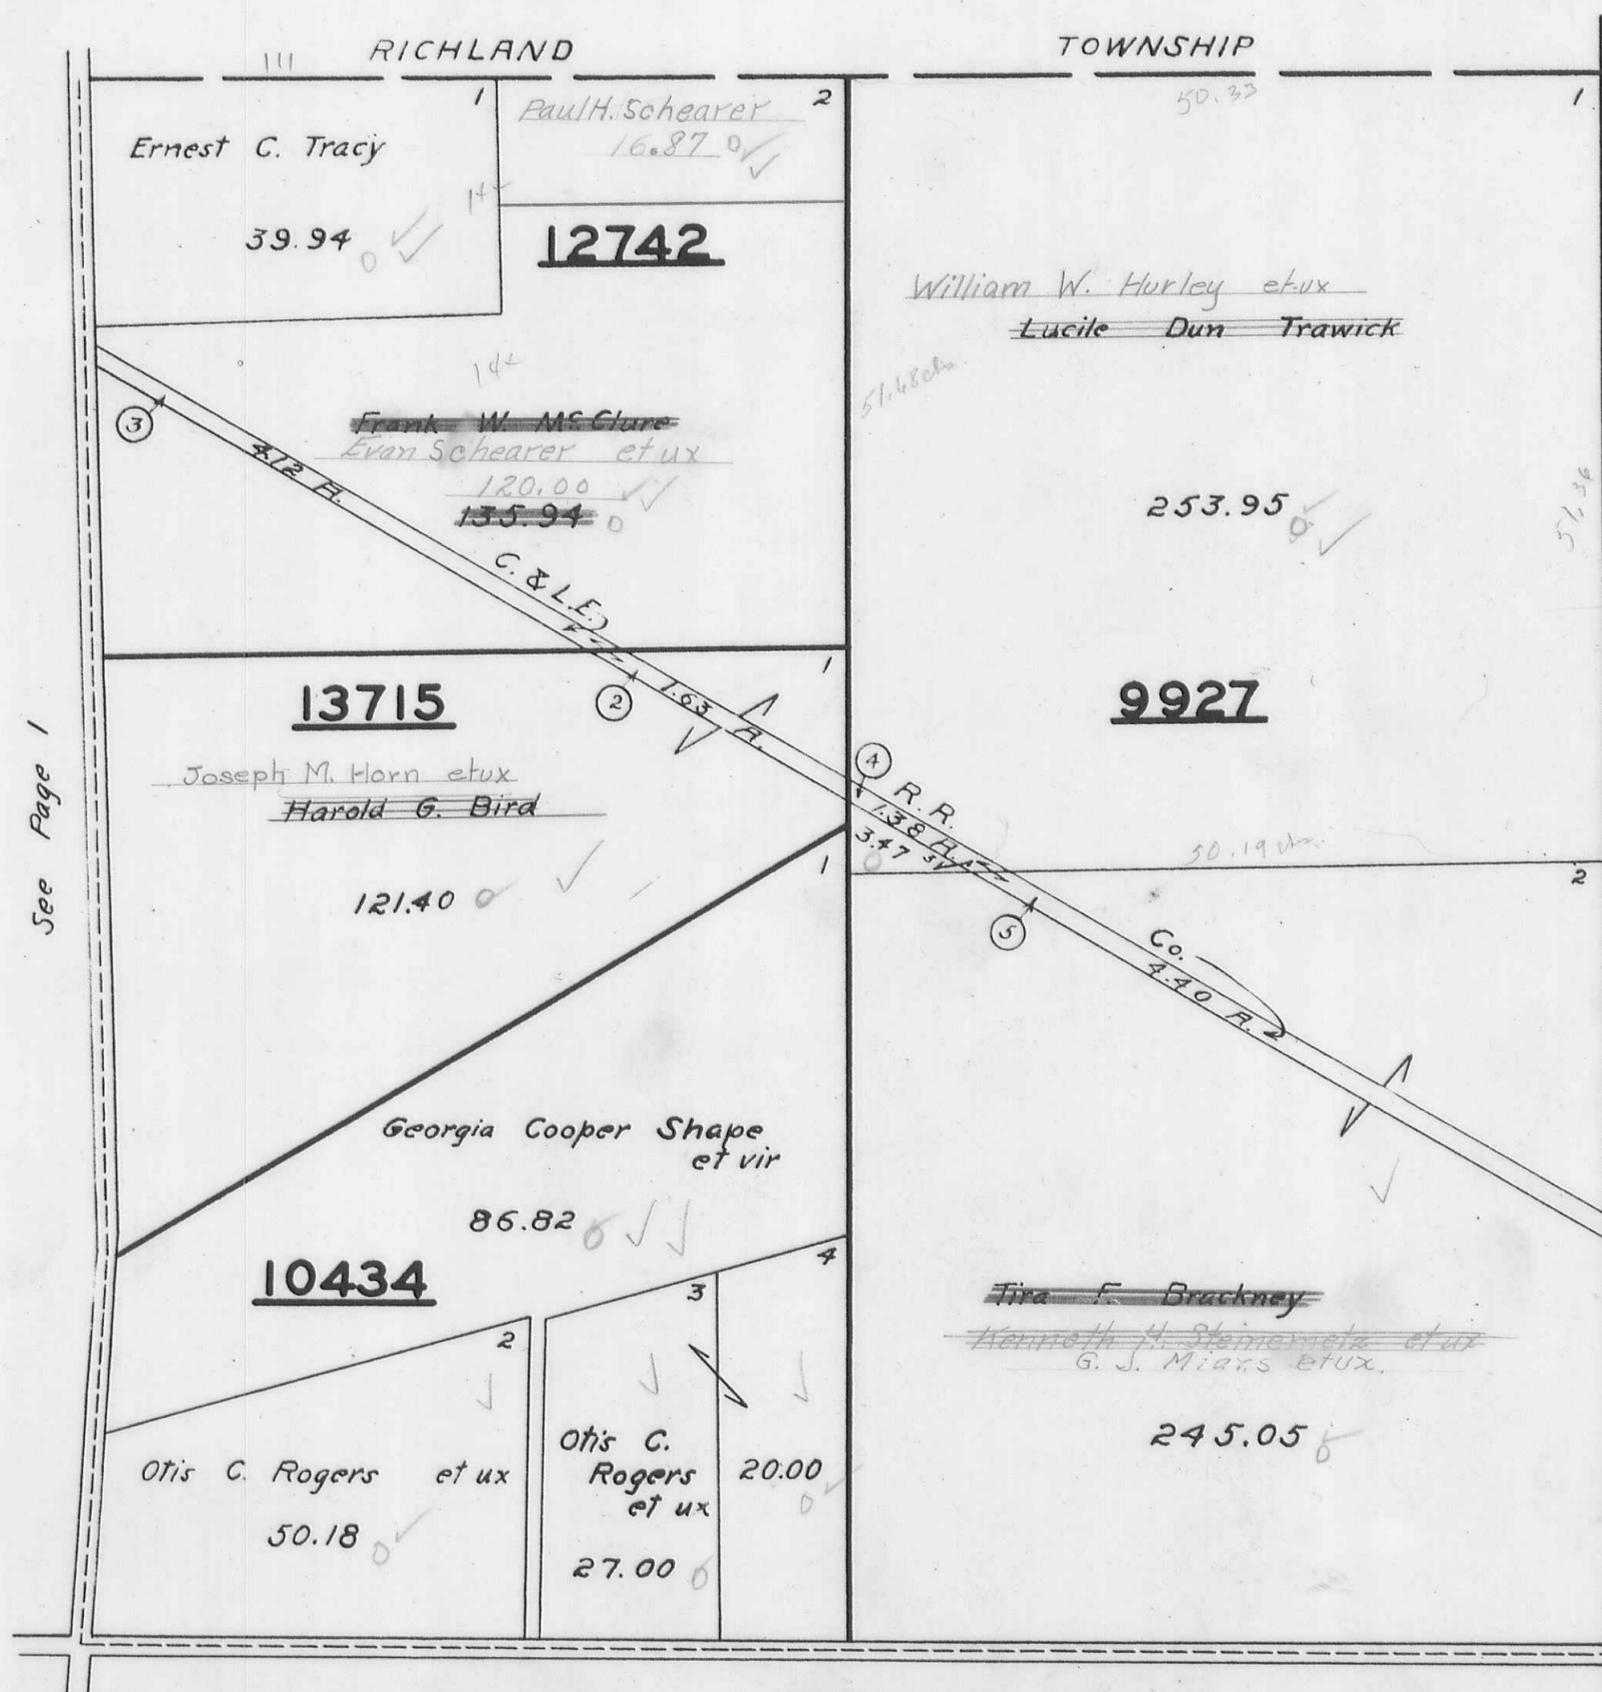

See Page 1

See Page 3


See Page 13

H.E.D.

McARTHUR TOWNSHIP
 VIRGINIA MILITARY SURVEYS

12350 PAGE 3
 13274
 12320
 9903
 9928

SCALE 10 CHAINS TO THE INCH

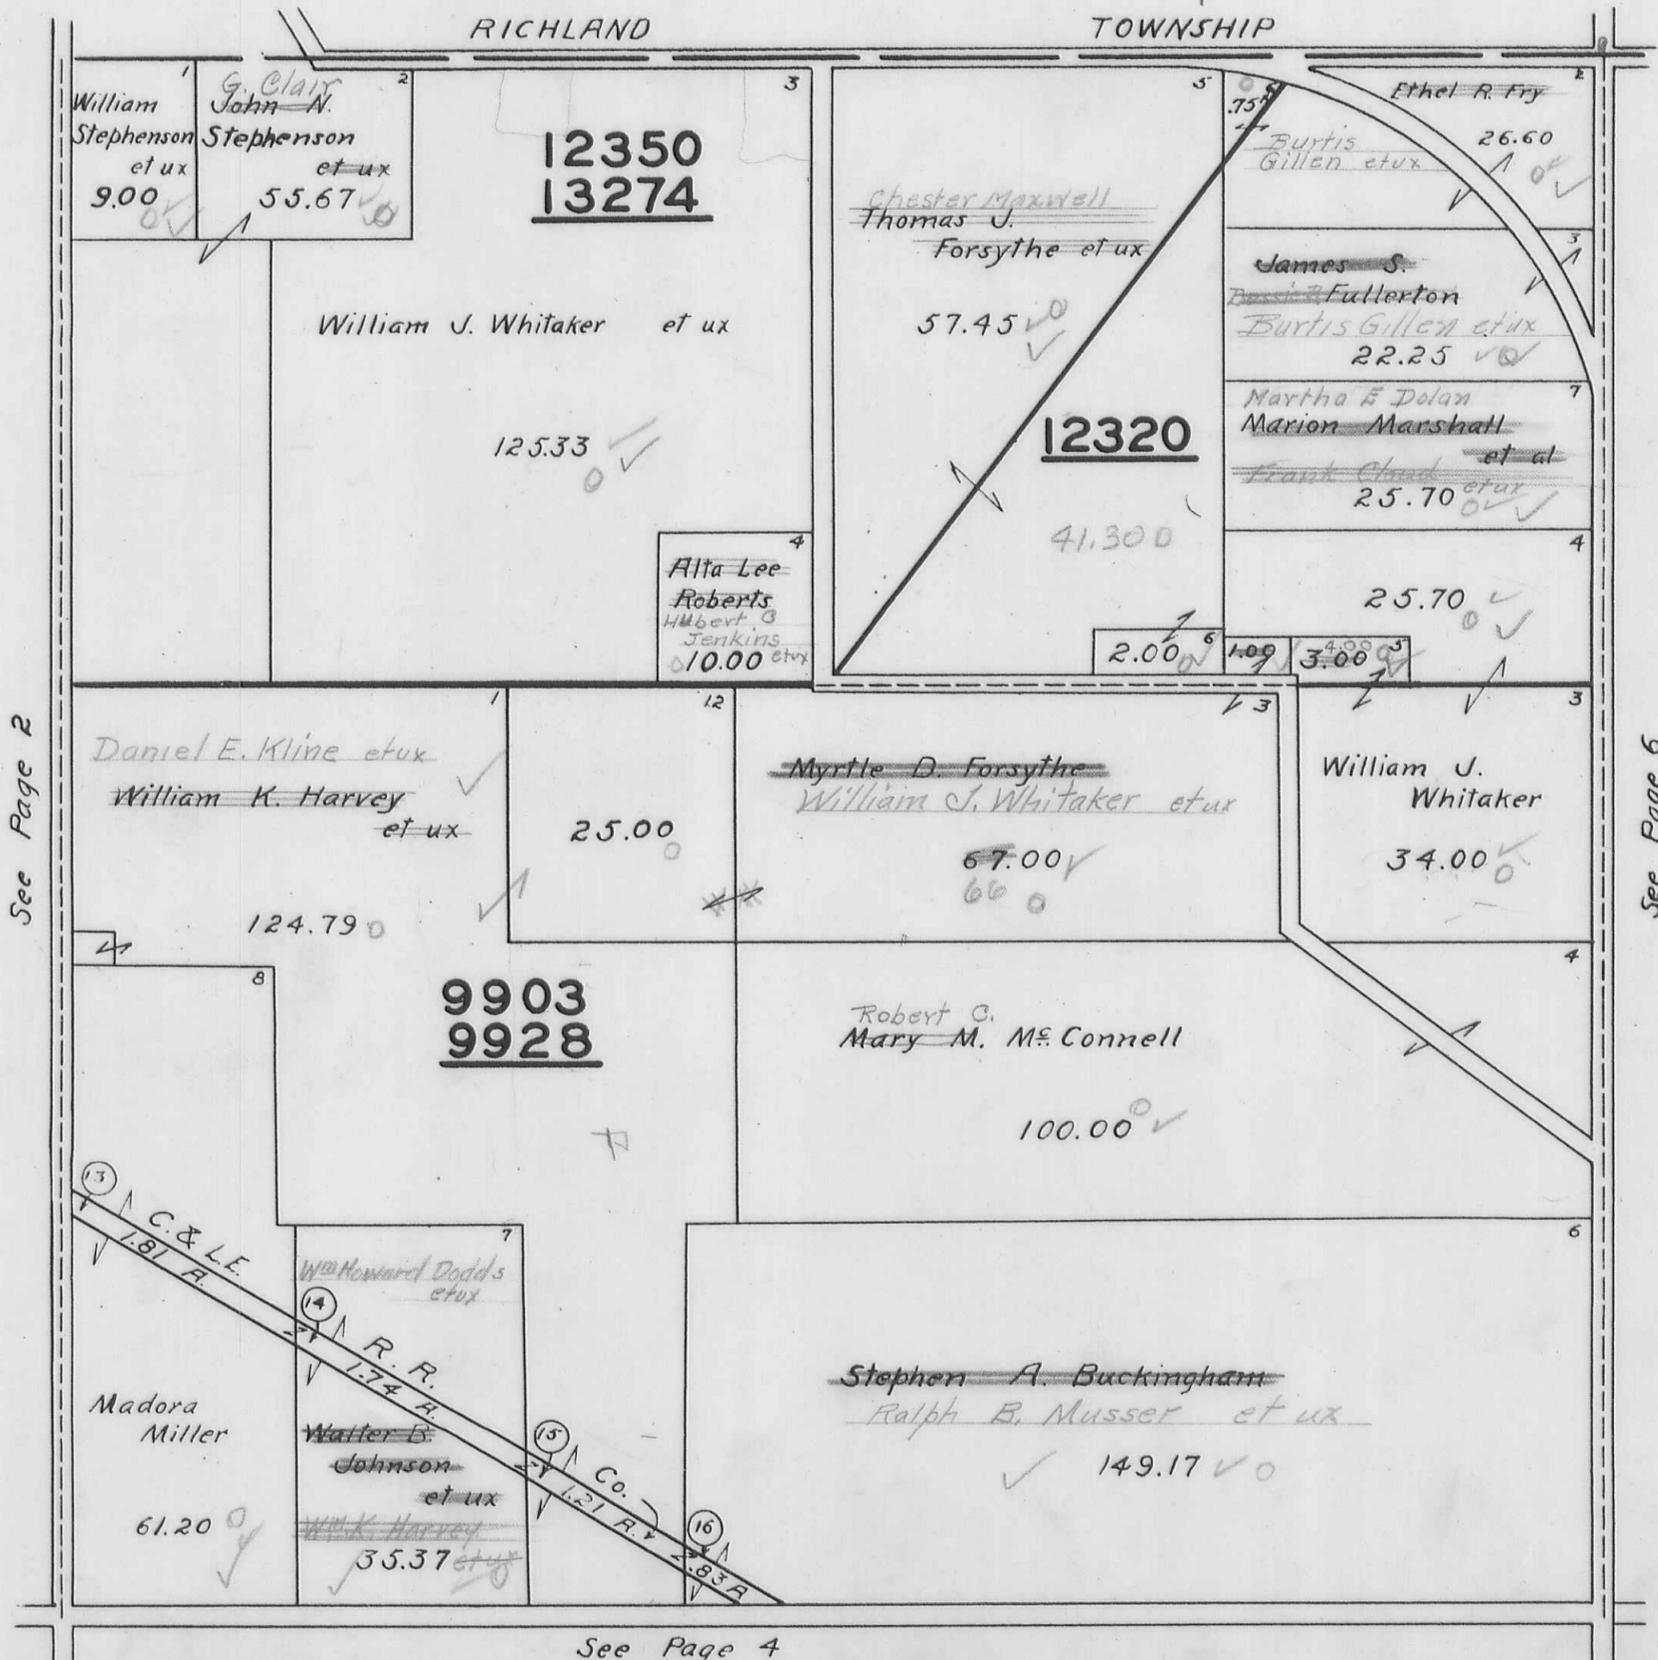

See Page 2

See Page 6

See Page 4

VIRGINIA MILITARY SURVEYS

9903
9928

SCALE 10 CHAINS TO THE INCH



See Page 3

See Page 24

Subs. 37-38-41
See Page 4-A
for Details

See Page 5


See Page 18

See Page 13

MARTIN TOWNSHIP

VIRGINIA MILITARY SURVEYS (PART) 9903
9928


SCALE 100 FEET THE INCH

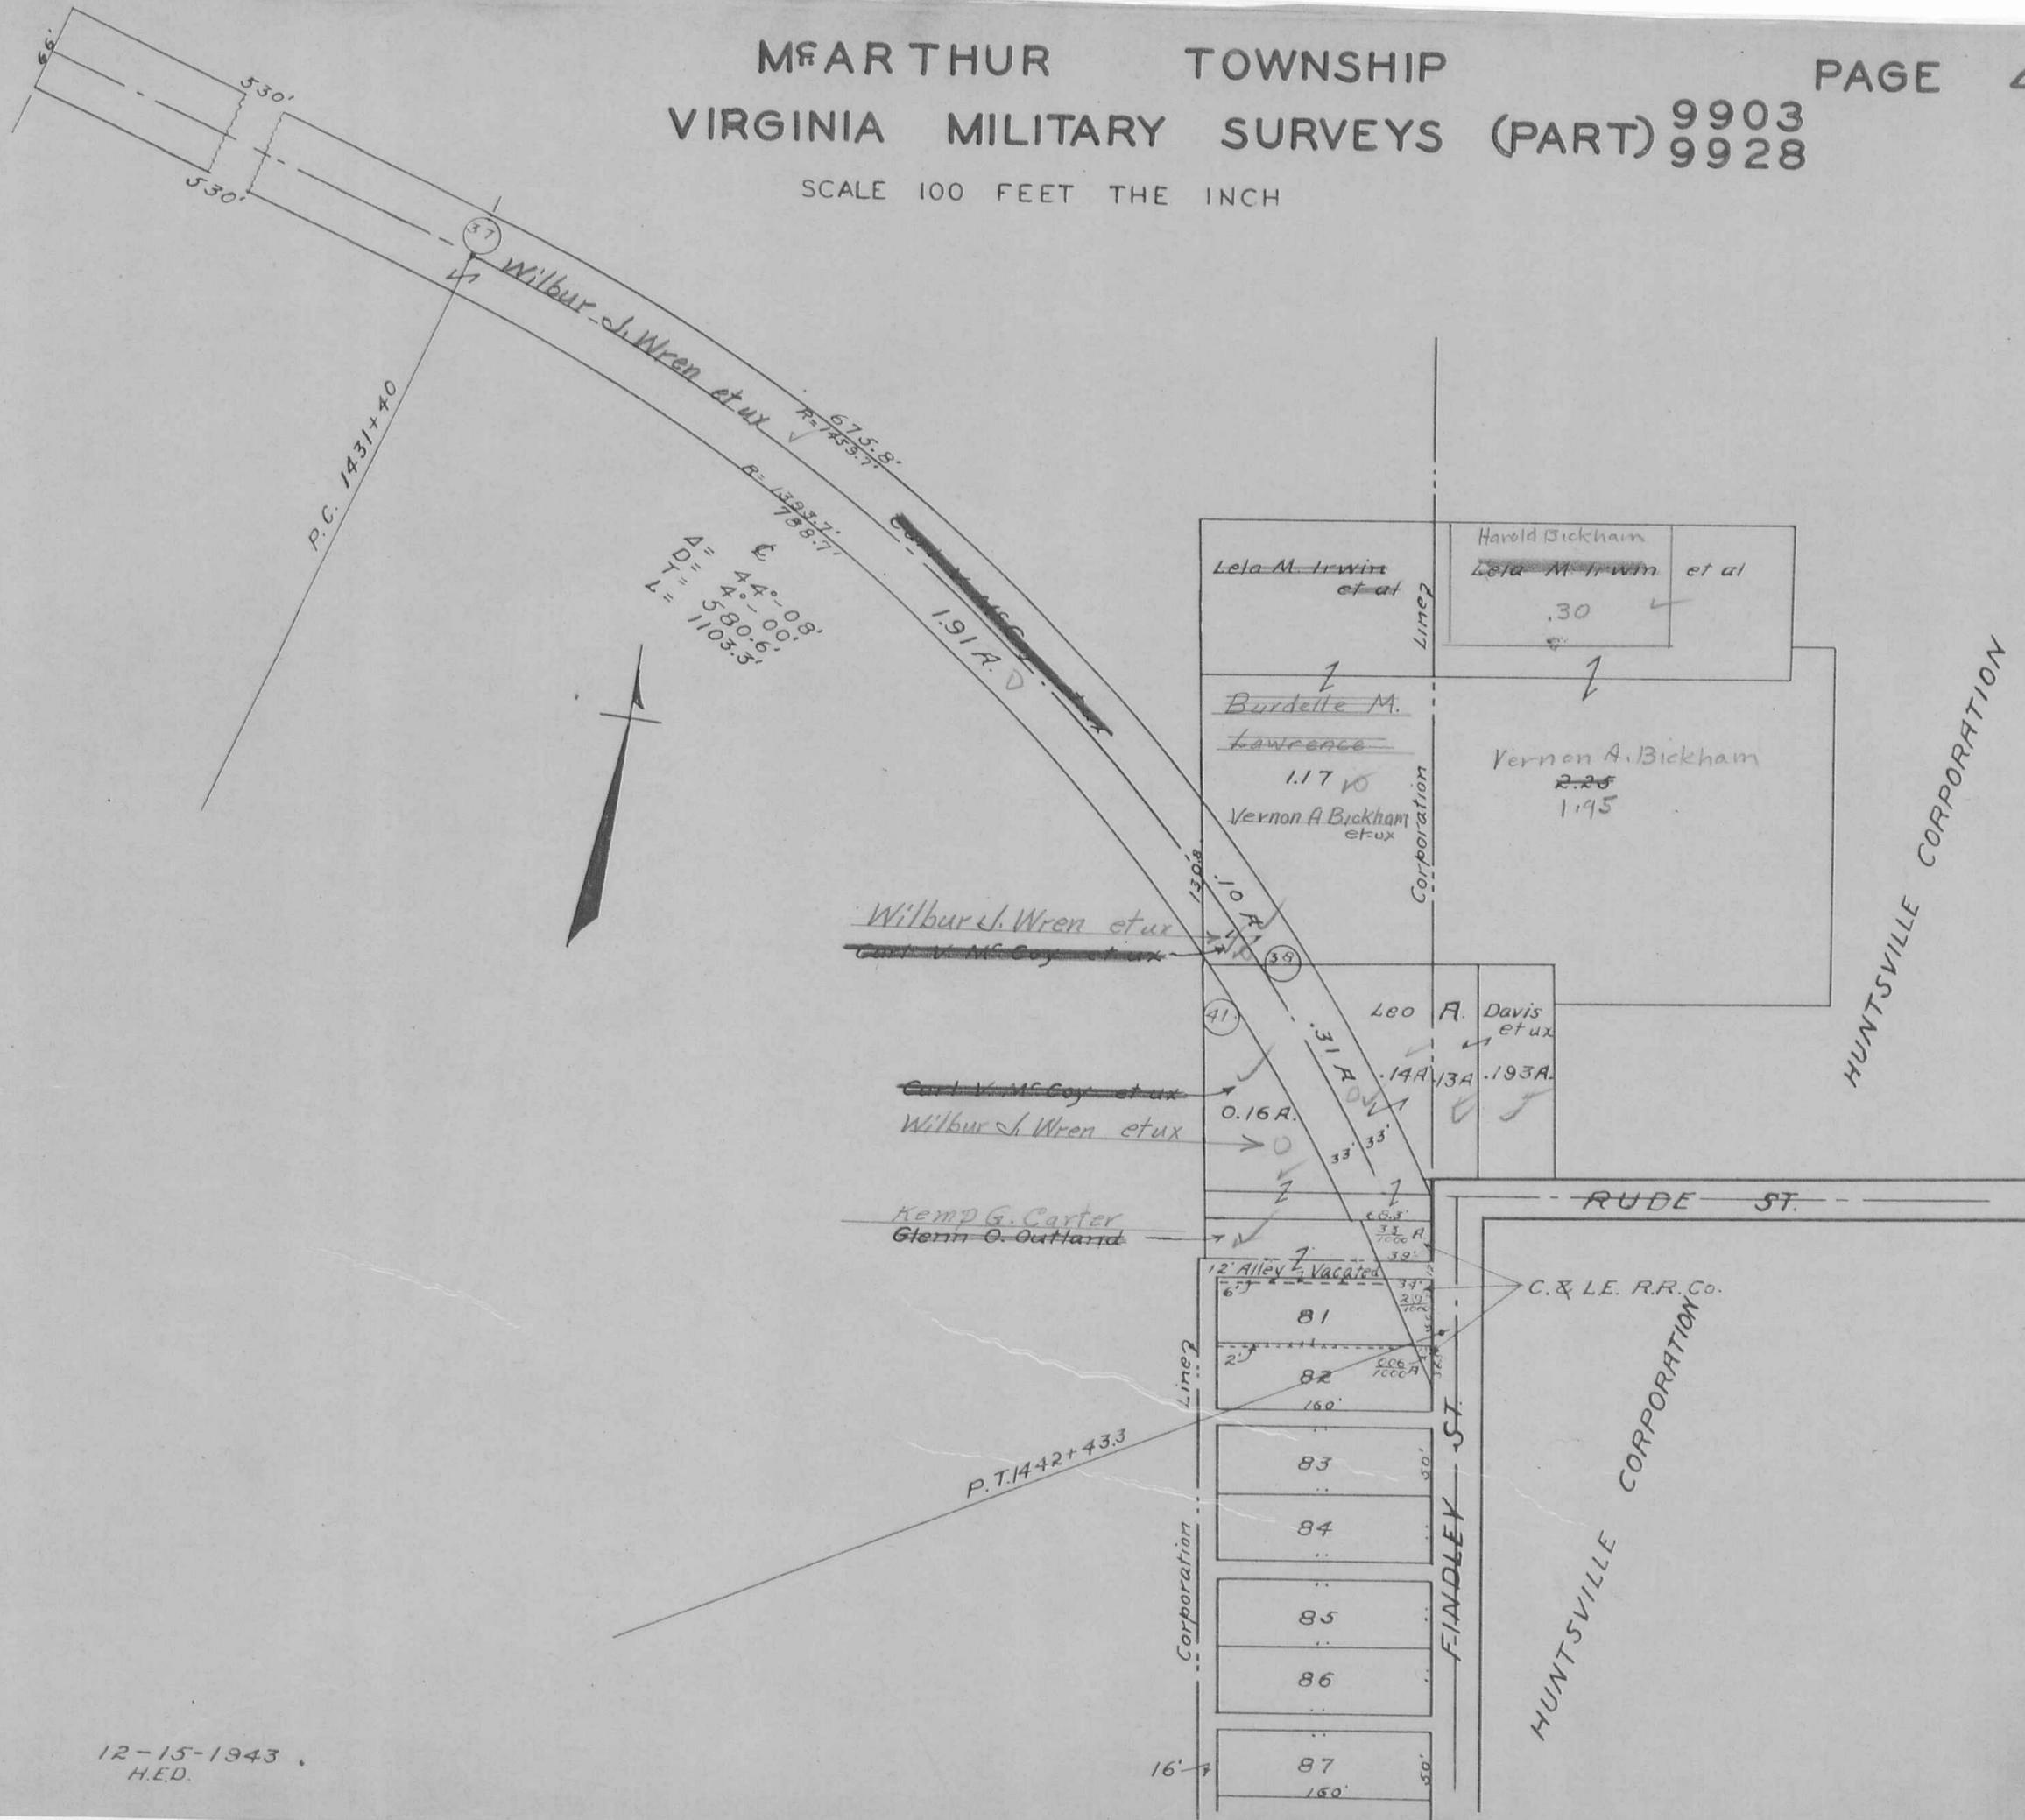

12-15-1943
H.E.D.

McARTHUR TOWNSHIP
 VIRGINIA MILITARY SURVEY 9930

SCALE 10 CHAINS TO THE INCH

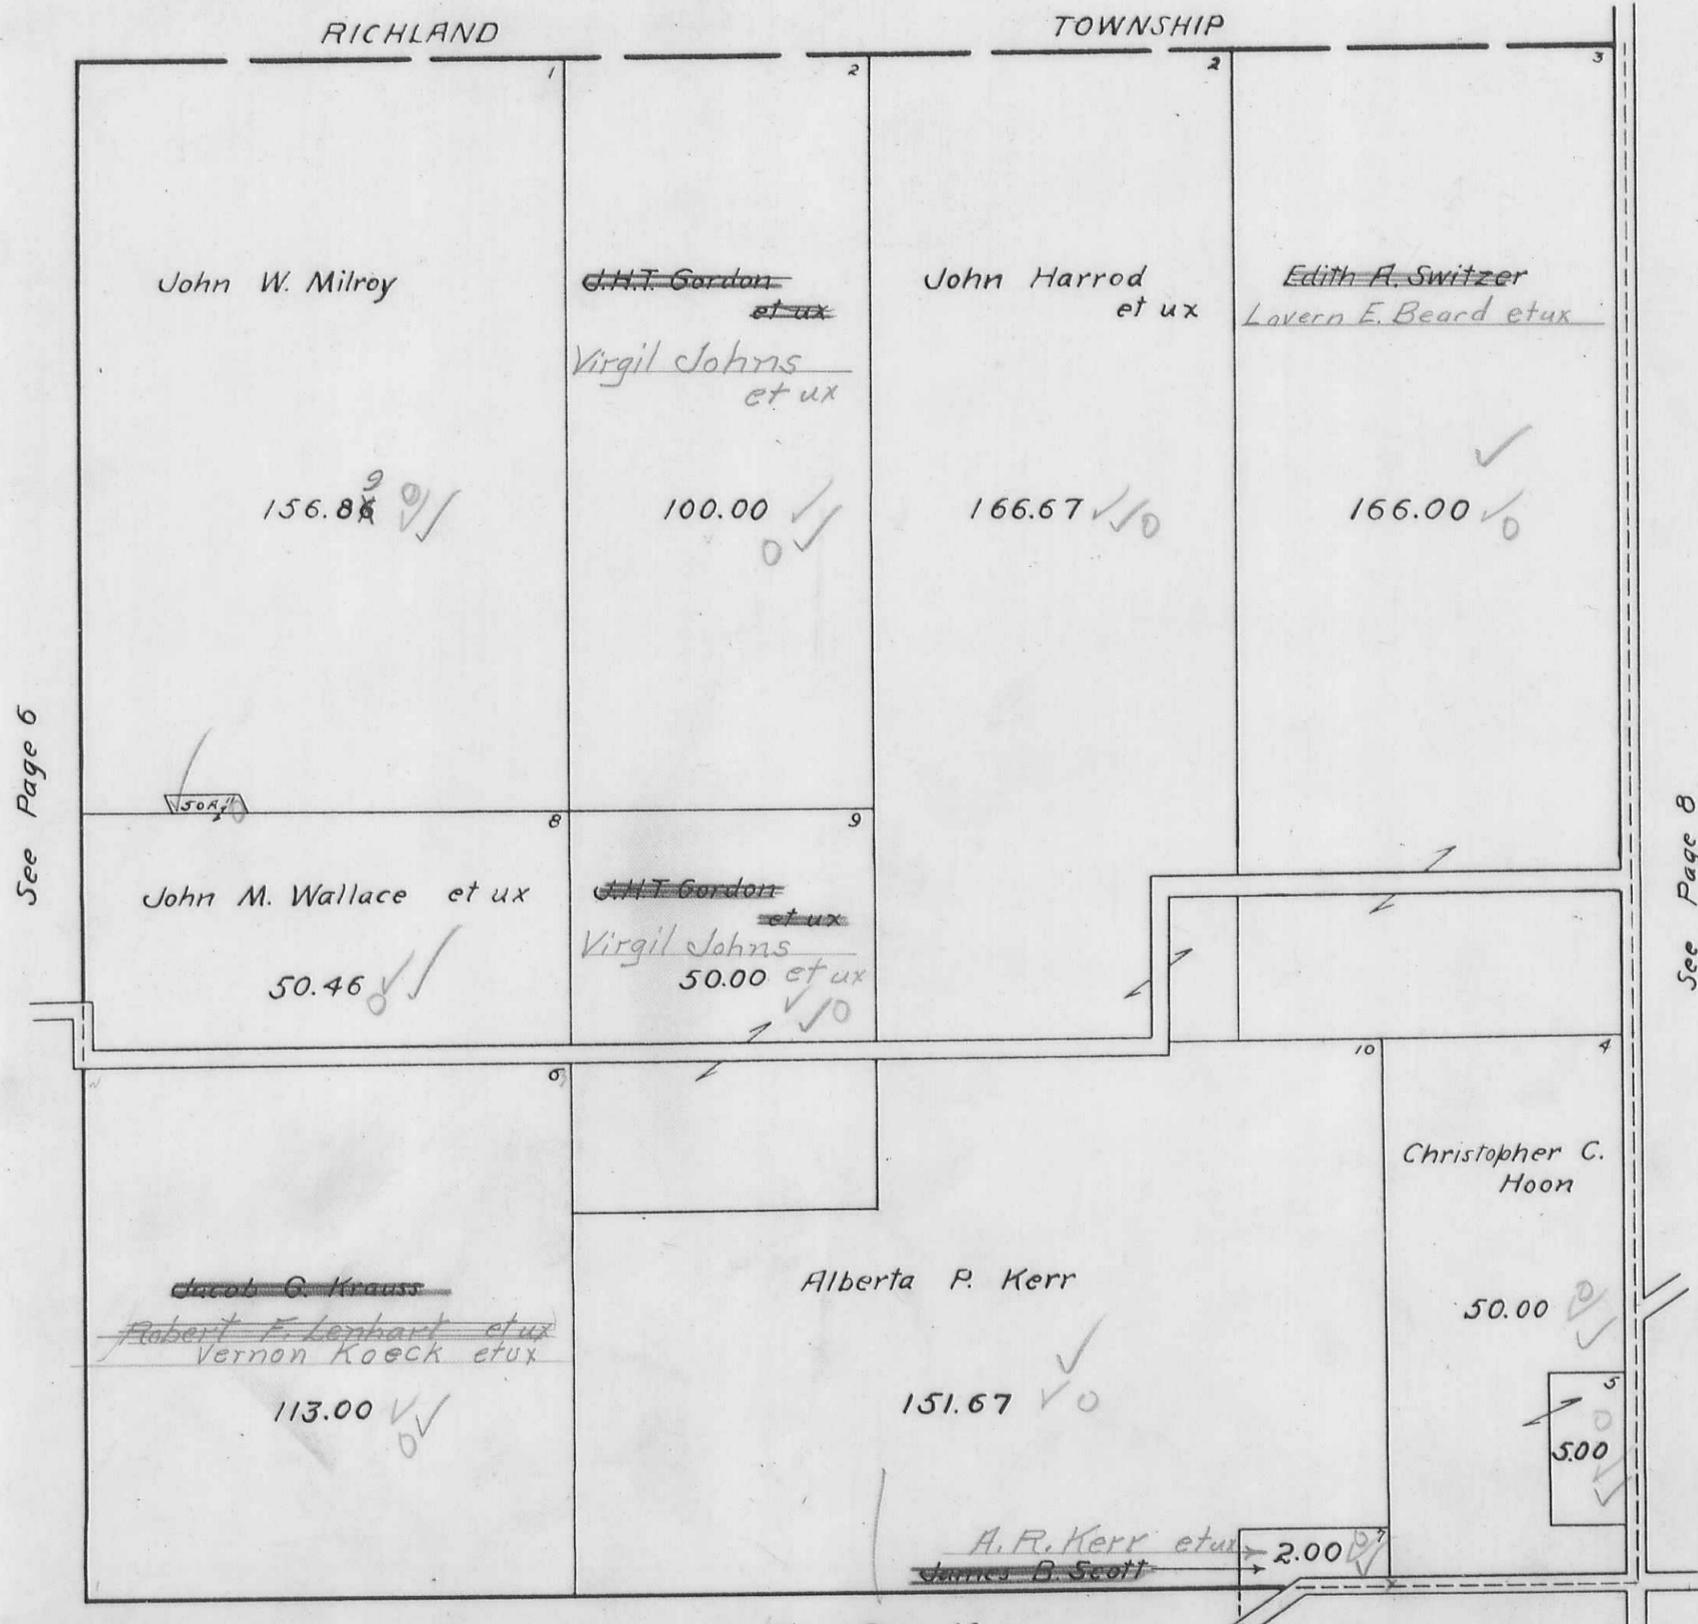

See Page 6

See Page 8

See Page 10


97
50
113
253

McARTHUR TOWNSHIP
 VIRGINIA MILITARY SURVEY 9931

SCALE 10 CHAINS TO THE INCH

RICHLAND

TOWNSHIP

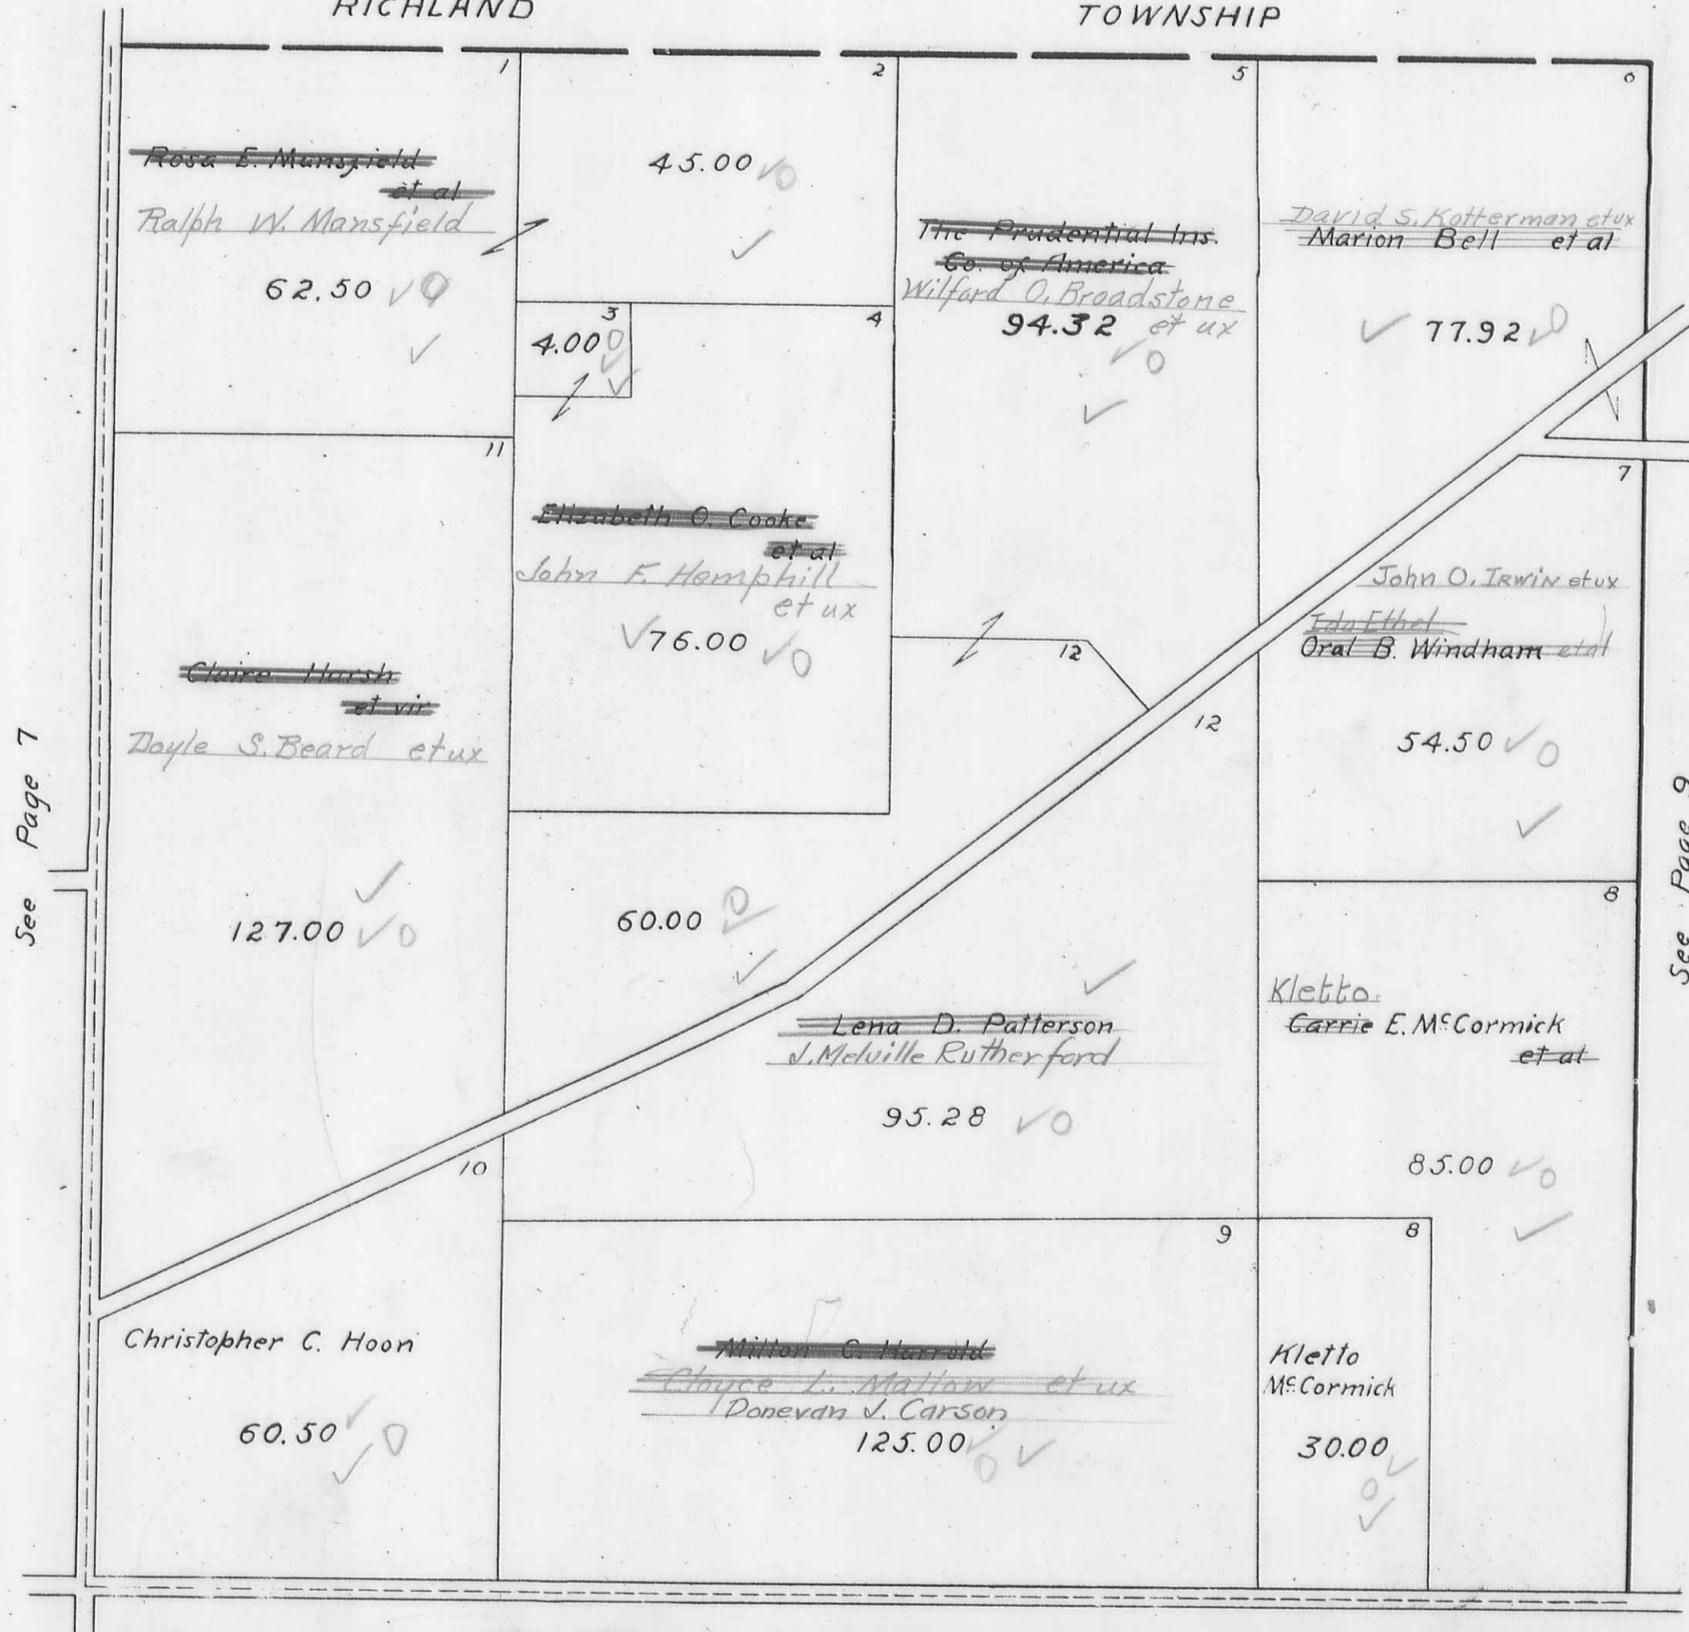


See Page 7

See Page 9

See Page 11

McARTHUR TOWNSHIP
 VIRGINIA MILITARY SURVEY 9932


SCALE 10 CHAINS TO THE INCH

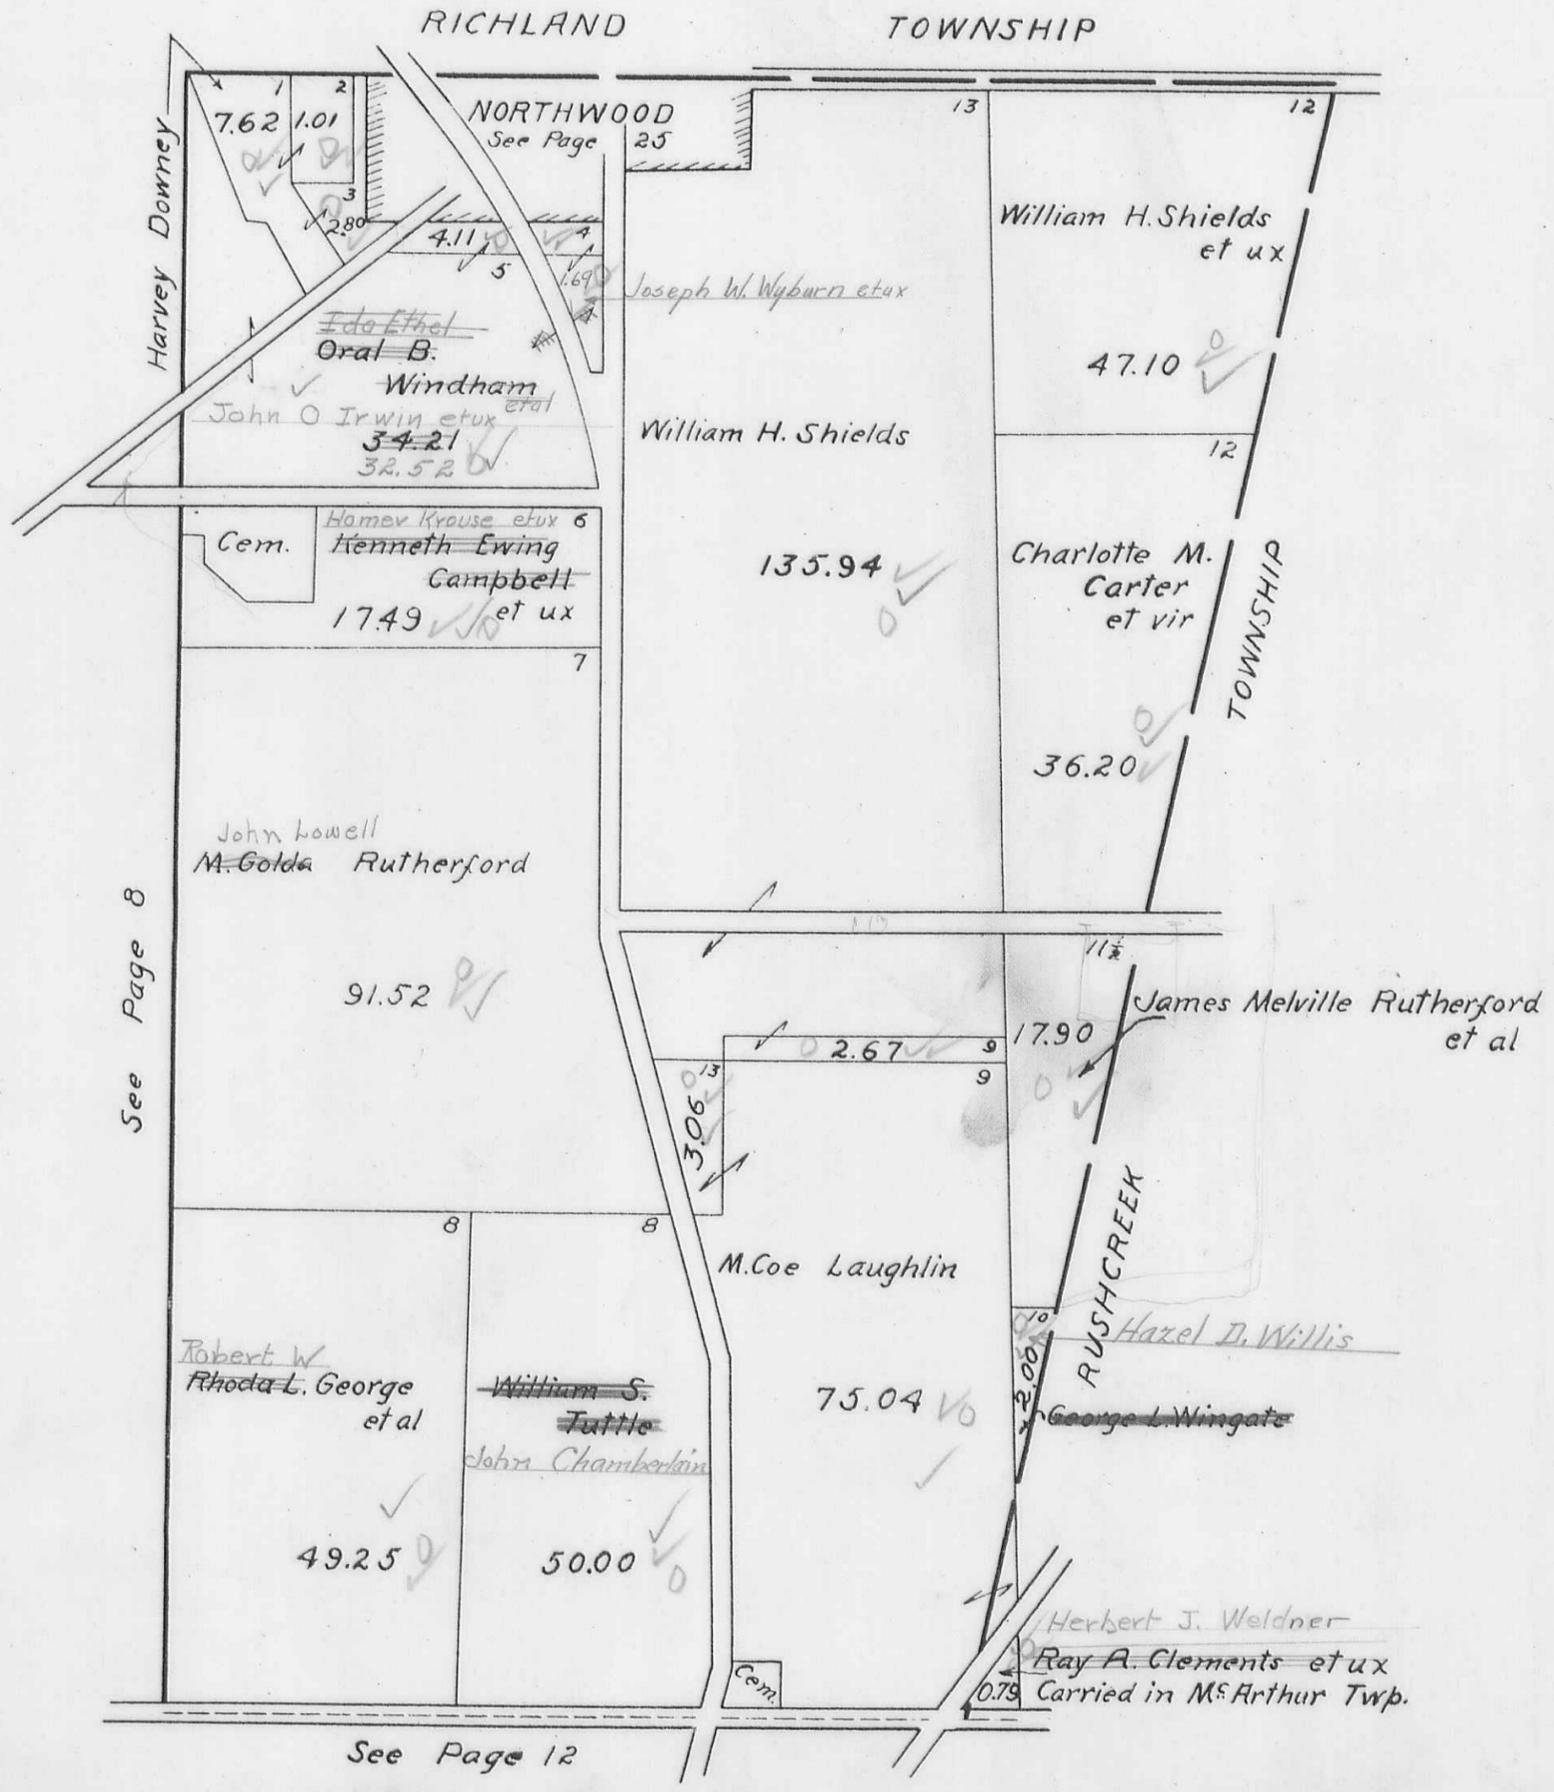

McARTHUR TOWNSHIP
 VIRGINIA MILITARY SURVEY 9905

SCALE 10 CHAINS TO THE INCH

100 chains

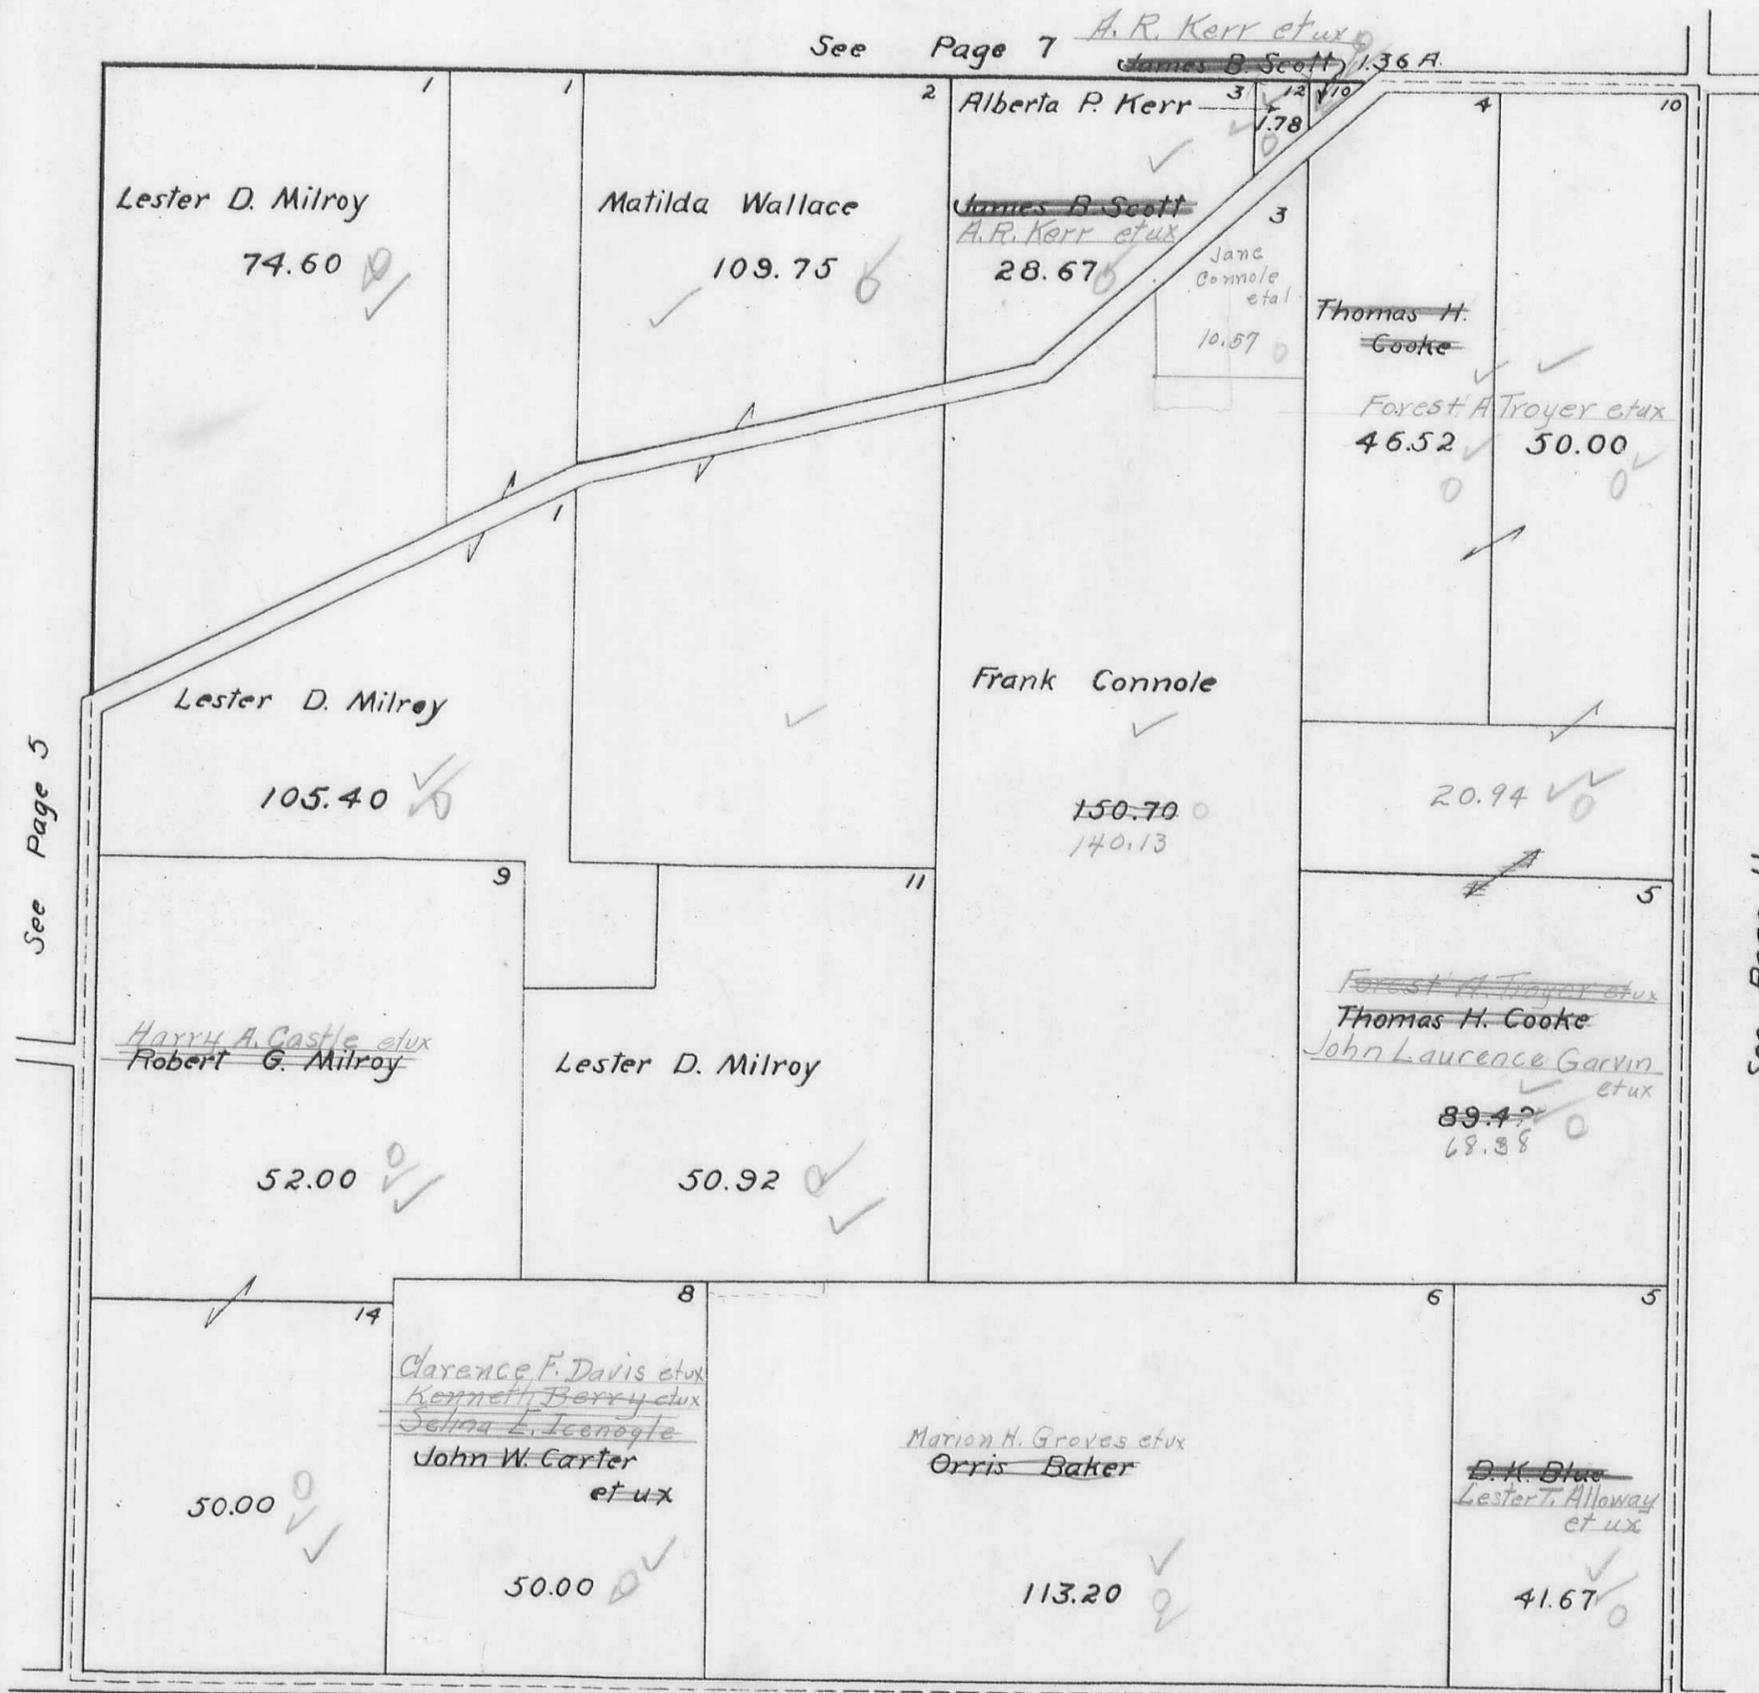

See Page 20

McARTHUR TOWNSHIP
VIRGINIA MILITARY SURVEYS

9906
14033

SCALE 10 CHAINS TO THE INCH




McARTHUR TOWNSHIP
 VIRGINIA MILITARY SURVEY 9907

SCALE 10 CHAINS TO THE INCH

Note: George M. Long 0.74 A.
 To: State of Ohio; By Perpetual
 Easement dated November-13-1941

See Page 9

Recorders book
 171 Page 86

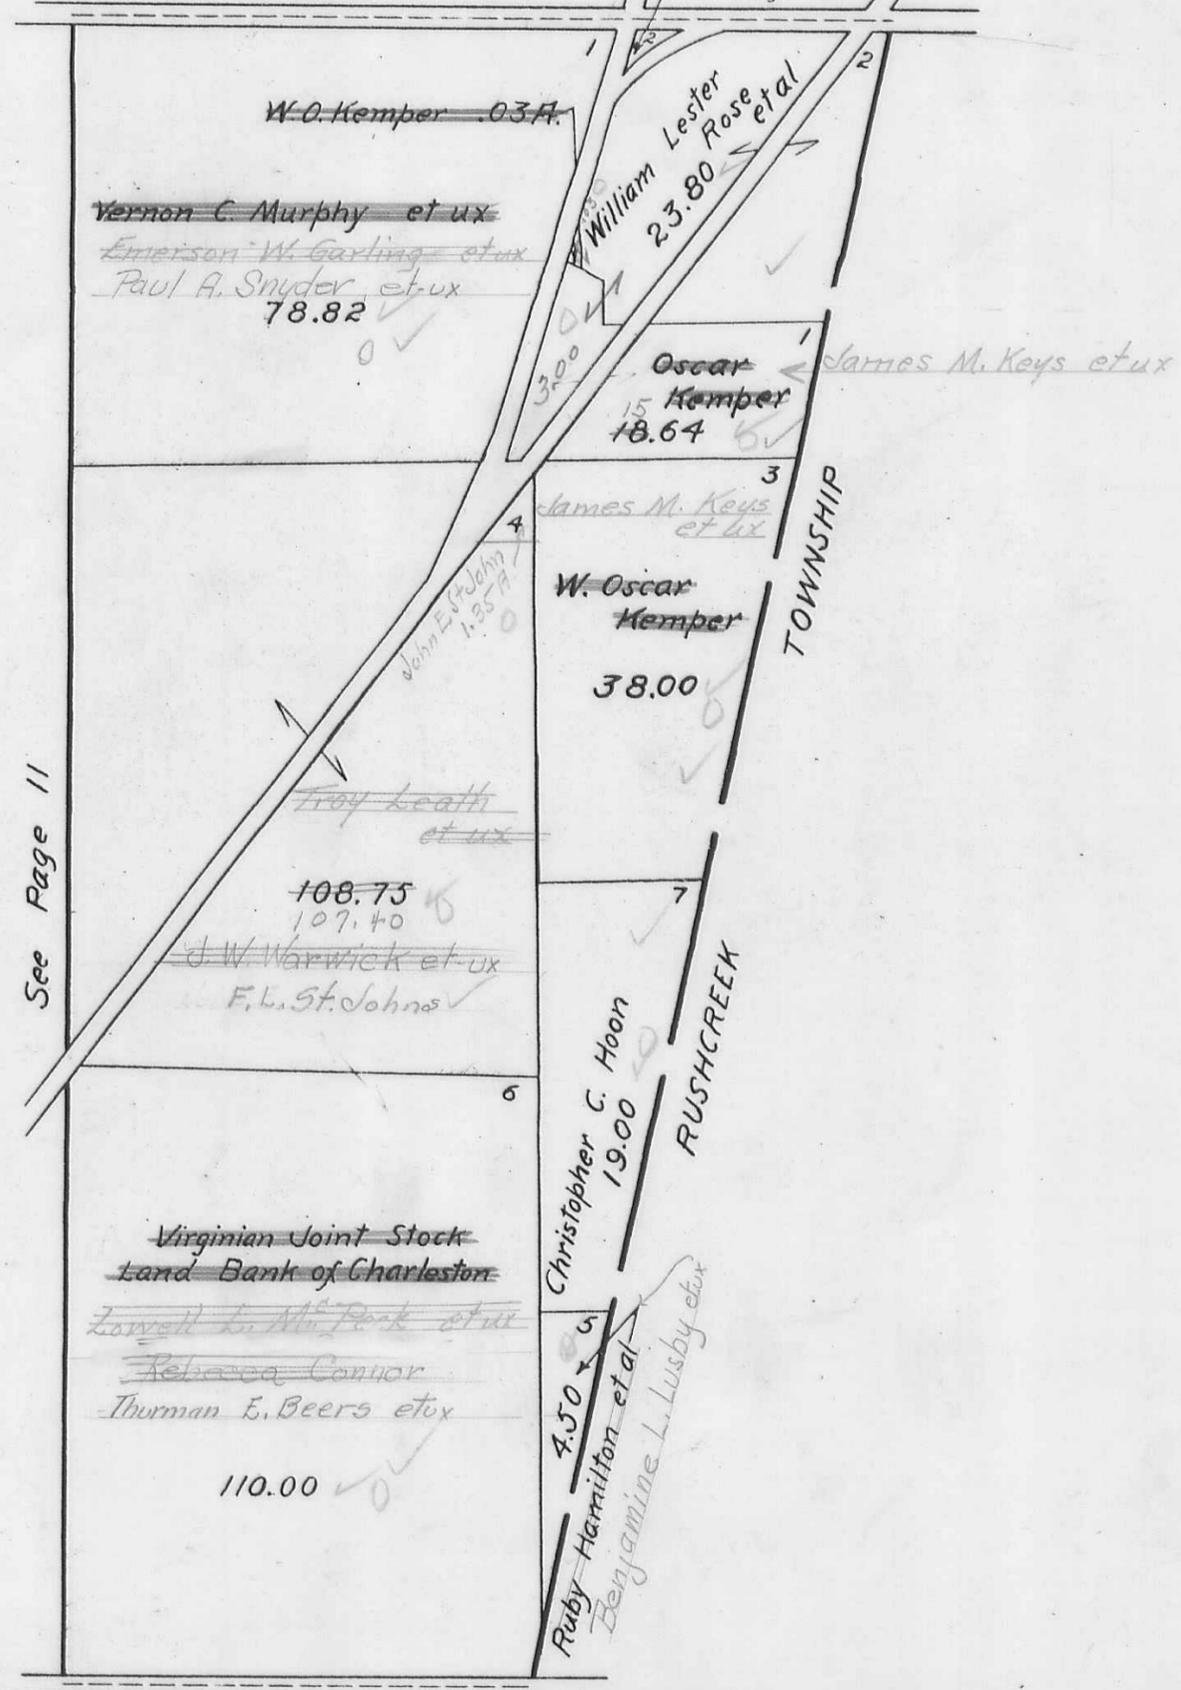


See Page 11

See Page 21

McARTHUR TOWNSHIP
 VIRGINIA MILITARY SURVEY 9902

SCALE 10 CHAINS TO THE INCH

See Page 2

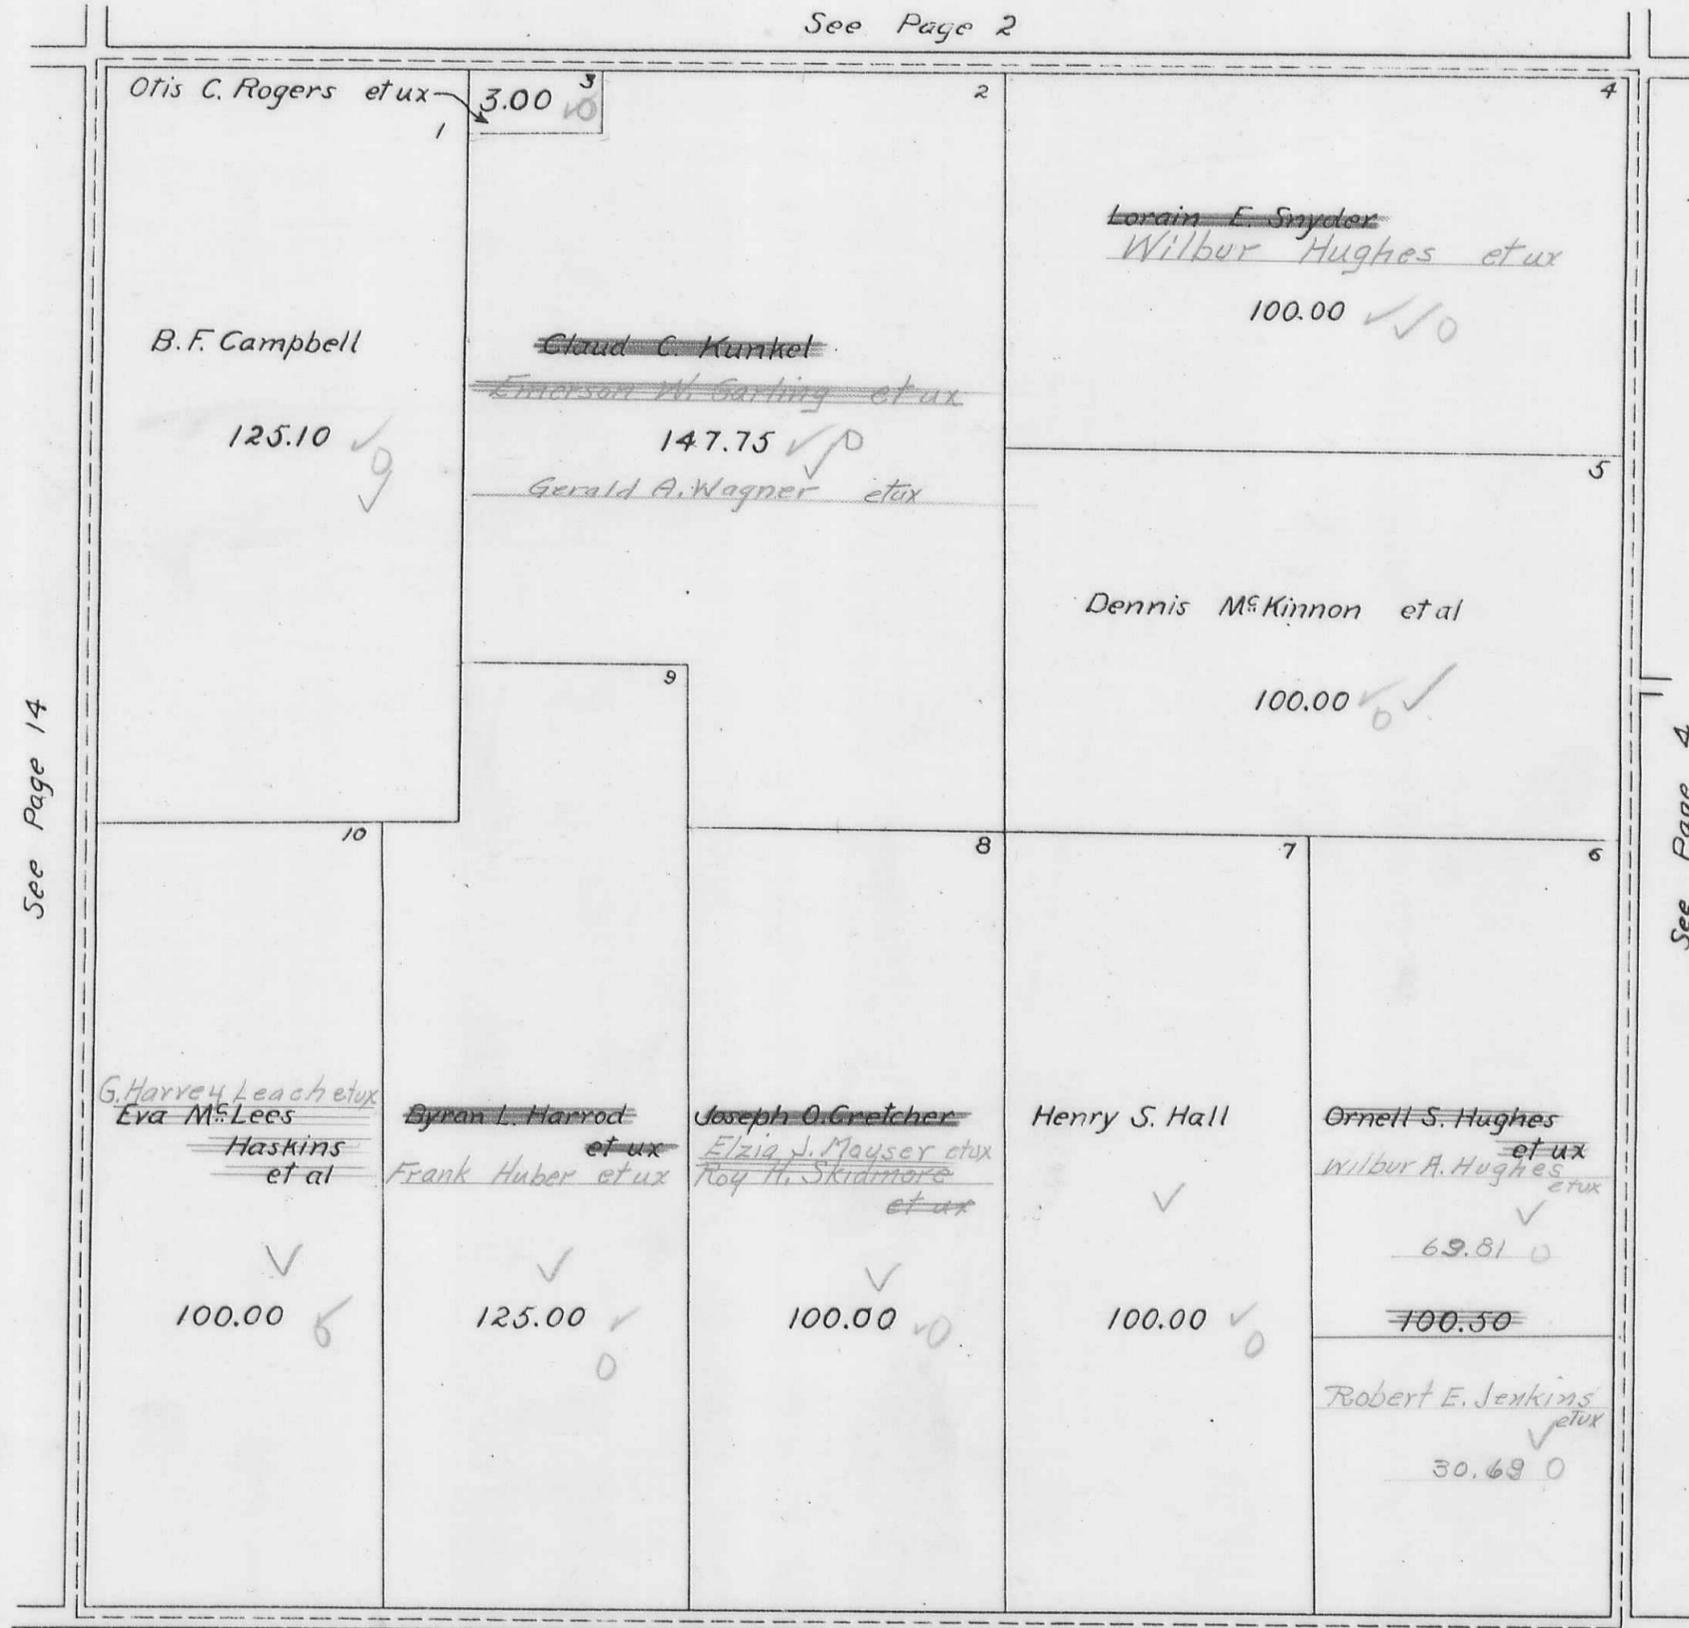


See Page 14

See Page 4


See Page 17

SCALE 10 CHAINS TO THE INCH

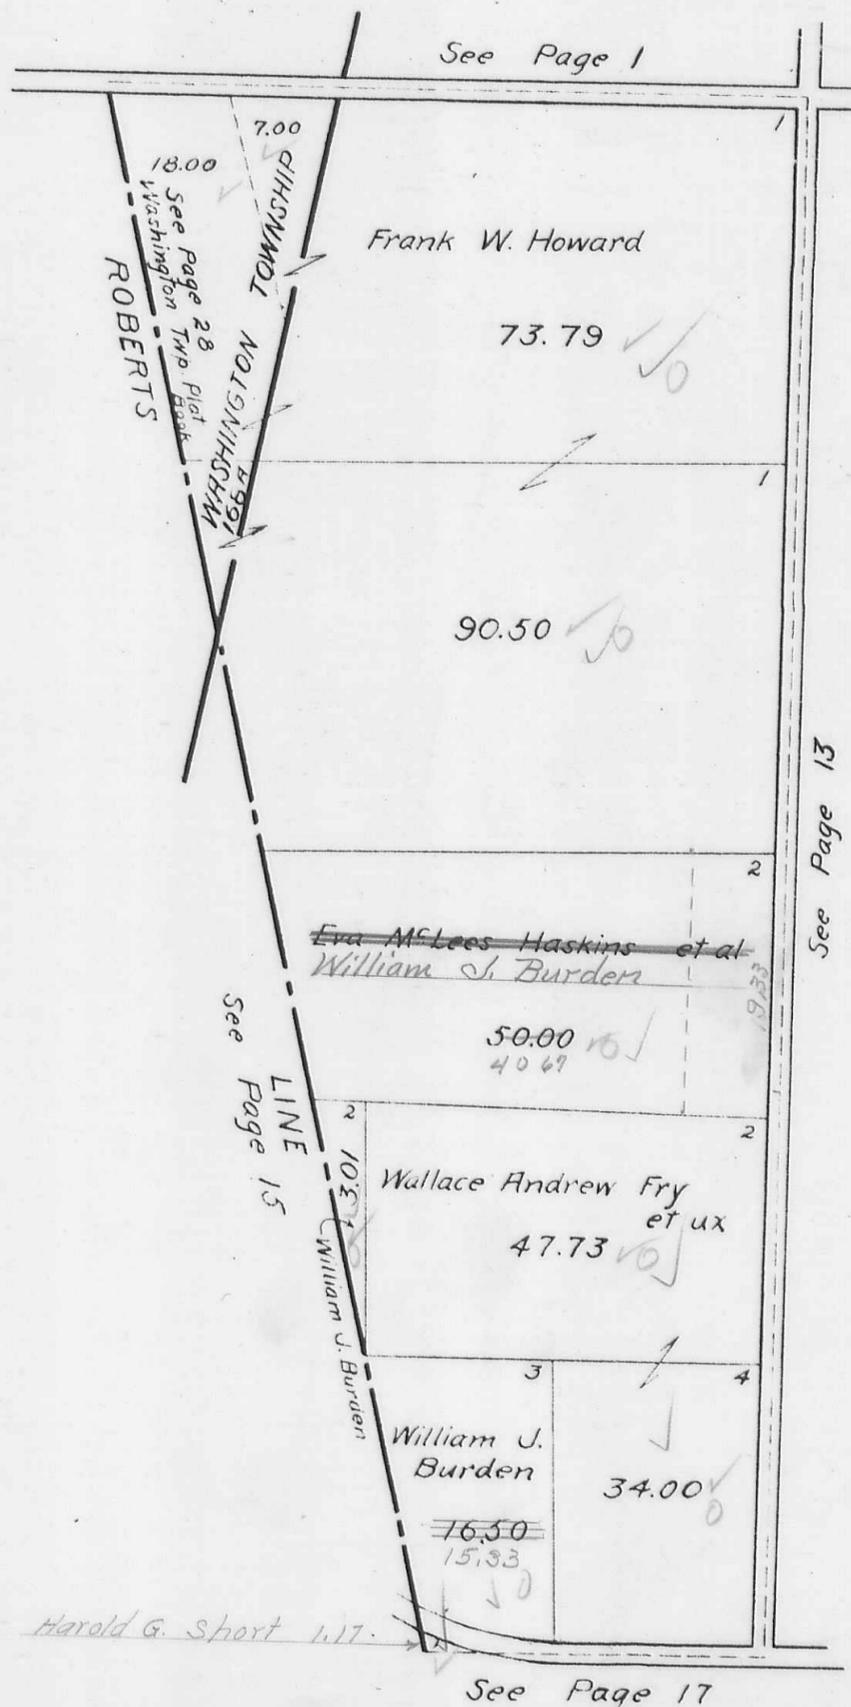

M: PHERSON SECTION TOWN 7 RANGE 9


SCALE 10 CHAINS TO THE INCH

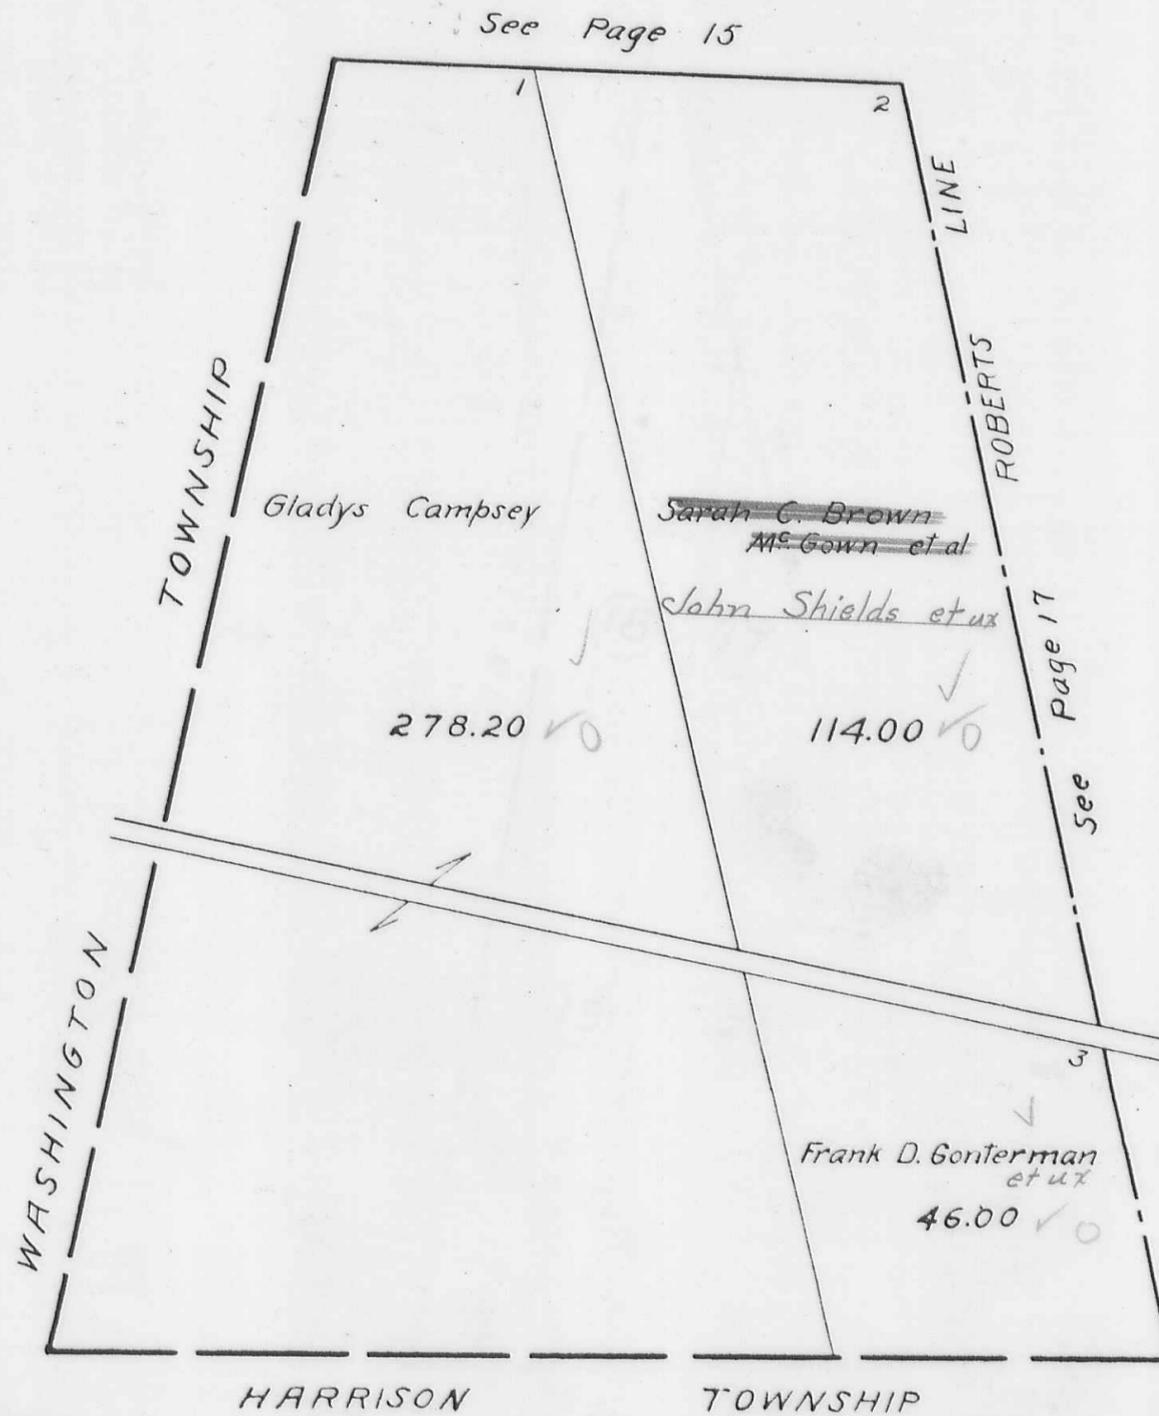

McARTHUR TOWNSHIP
VIRGINIA MILITARY SURVEYS

10122
10248
10249

SCALE 10 CHAINS TO THE INCH

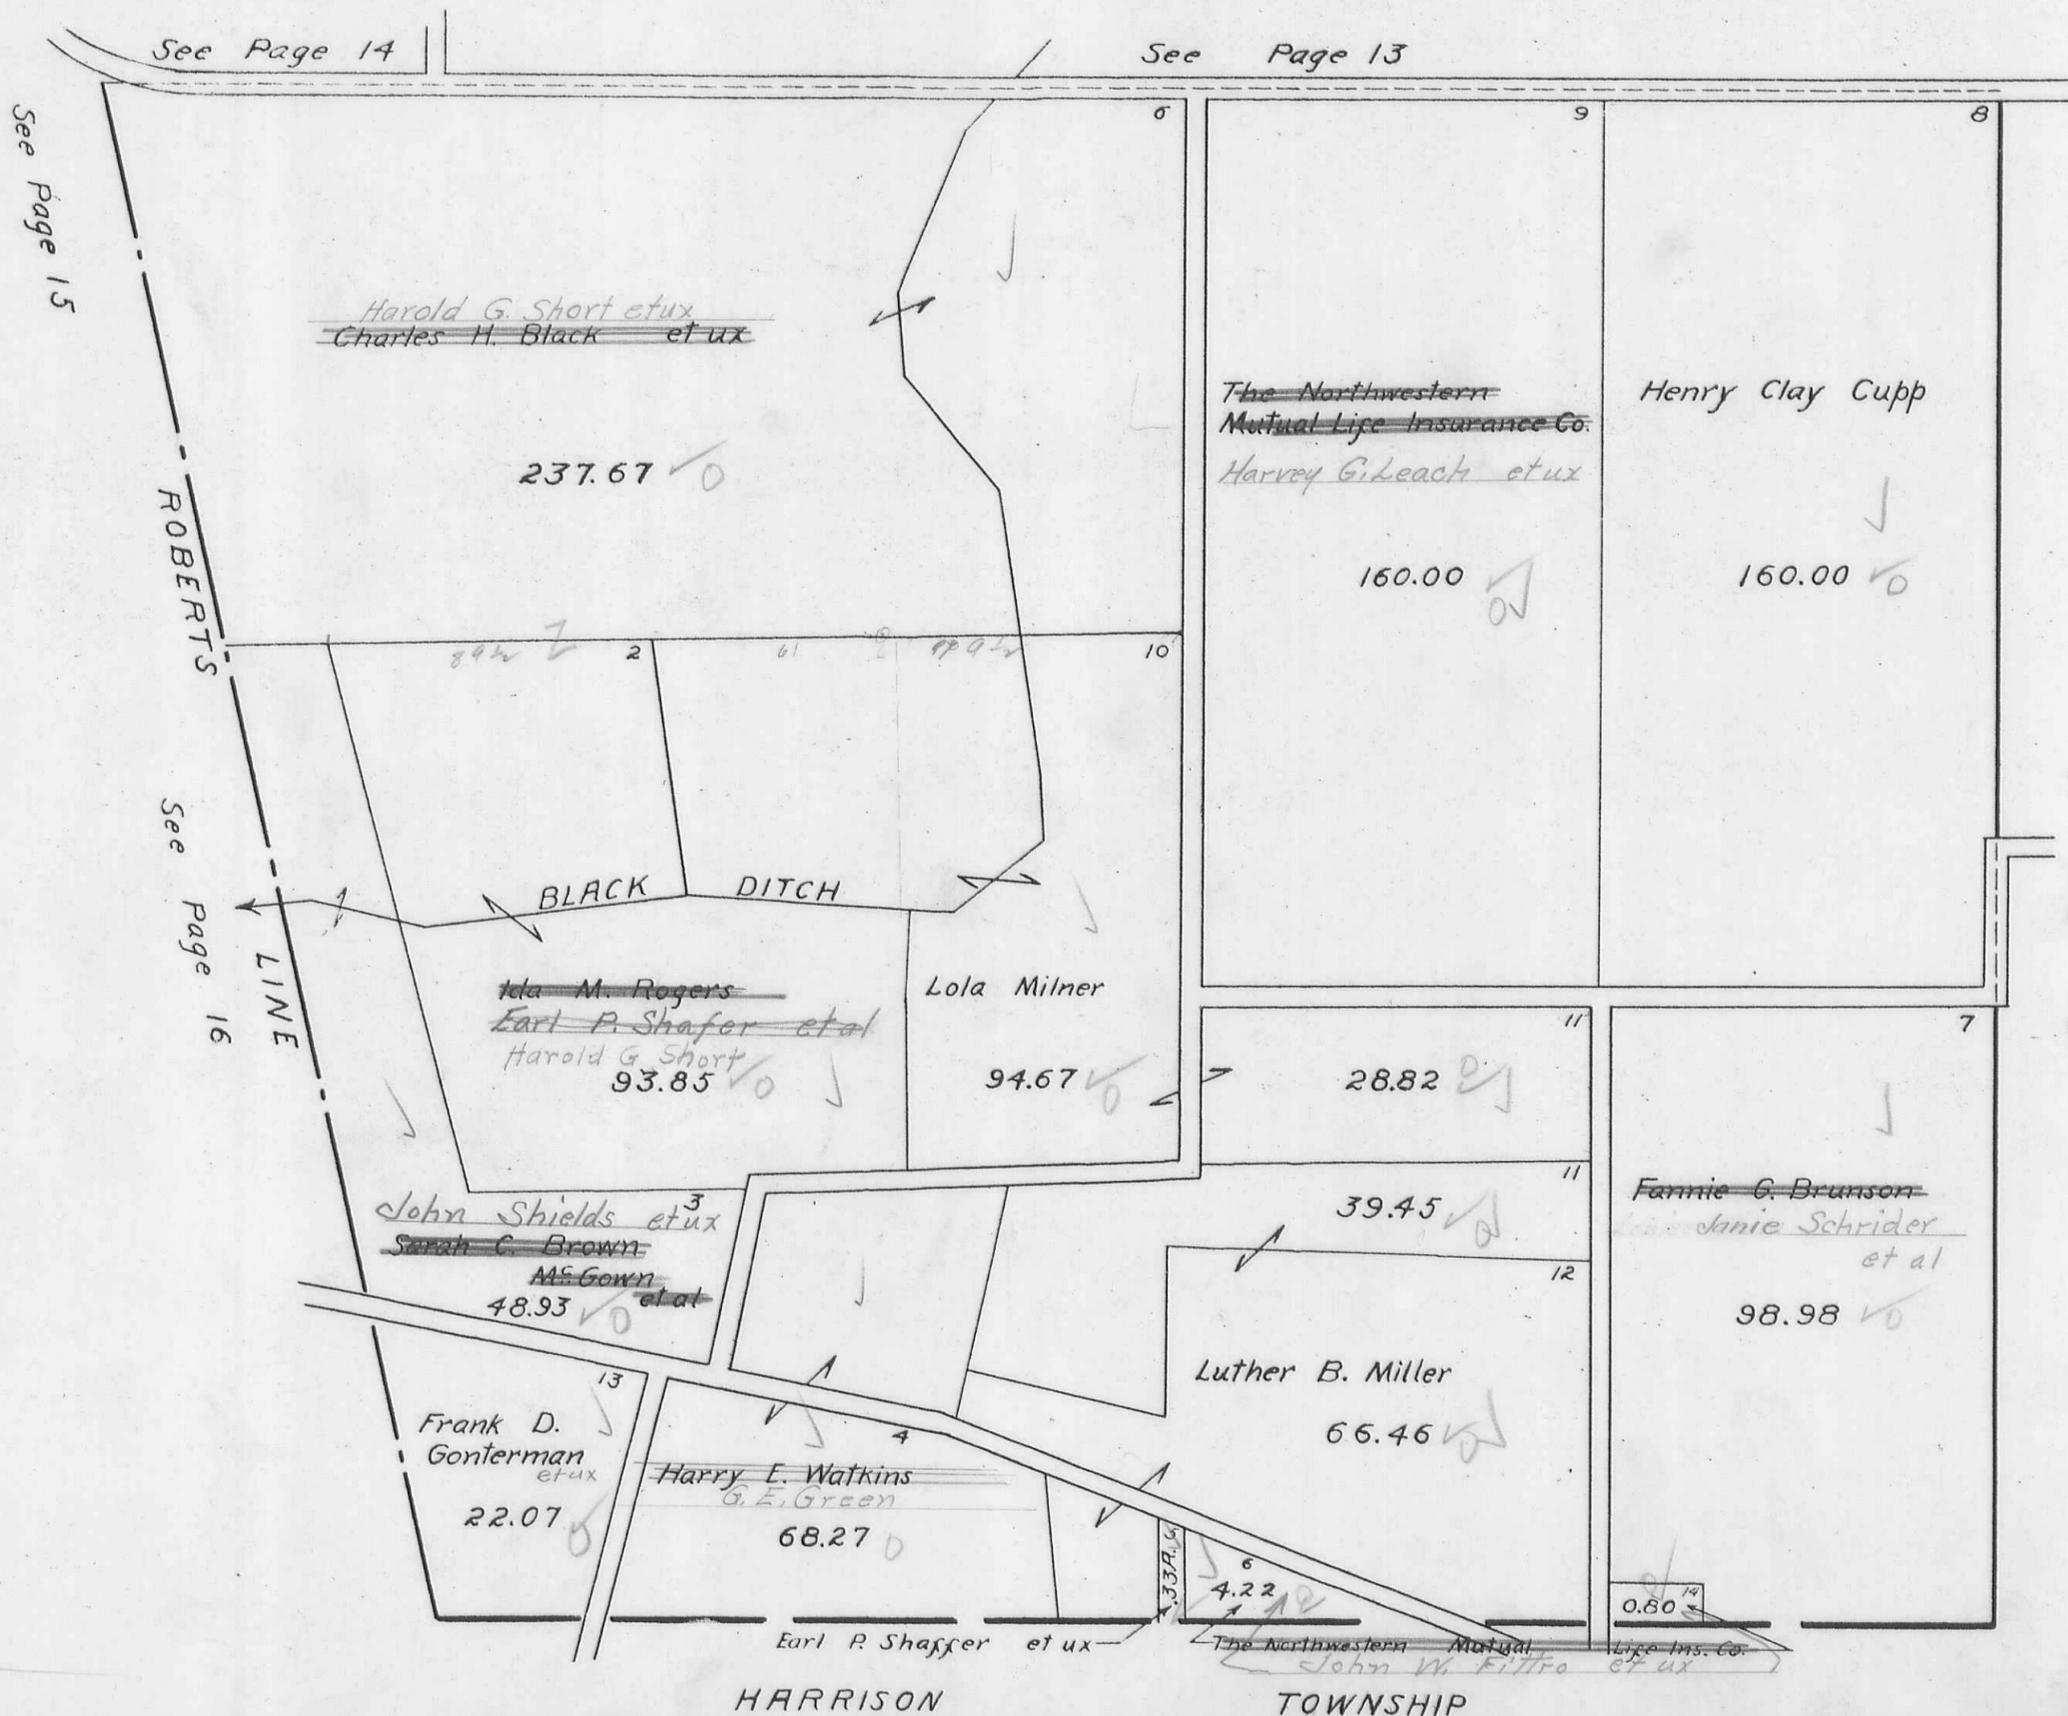

60.22
5.11
65.33

H.E.D.


HARRISON

TOWNSHIP

McARTHUR TOWNSHIP
 VIRGINIA MILITARY SURVEY 9881

SCALE 10 CHAINS TO THE INCH


1012 28
 1874

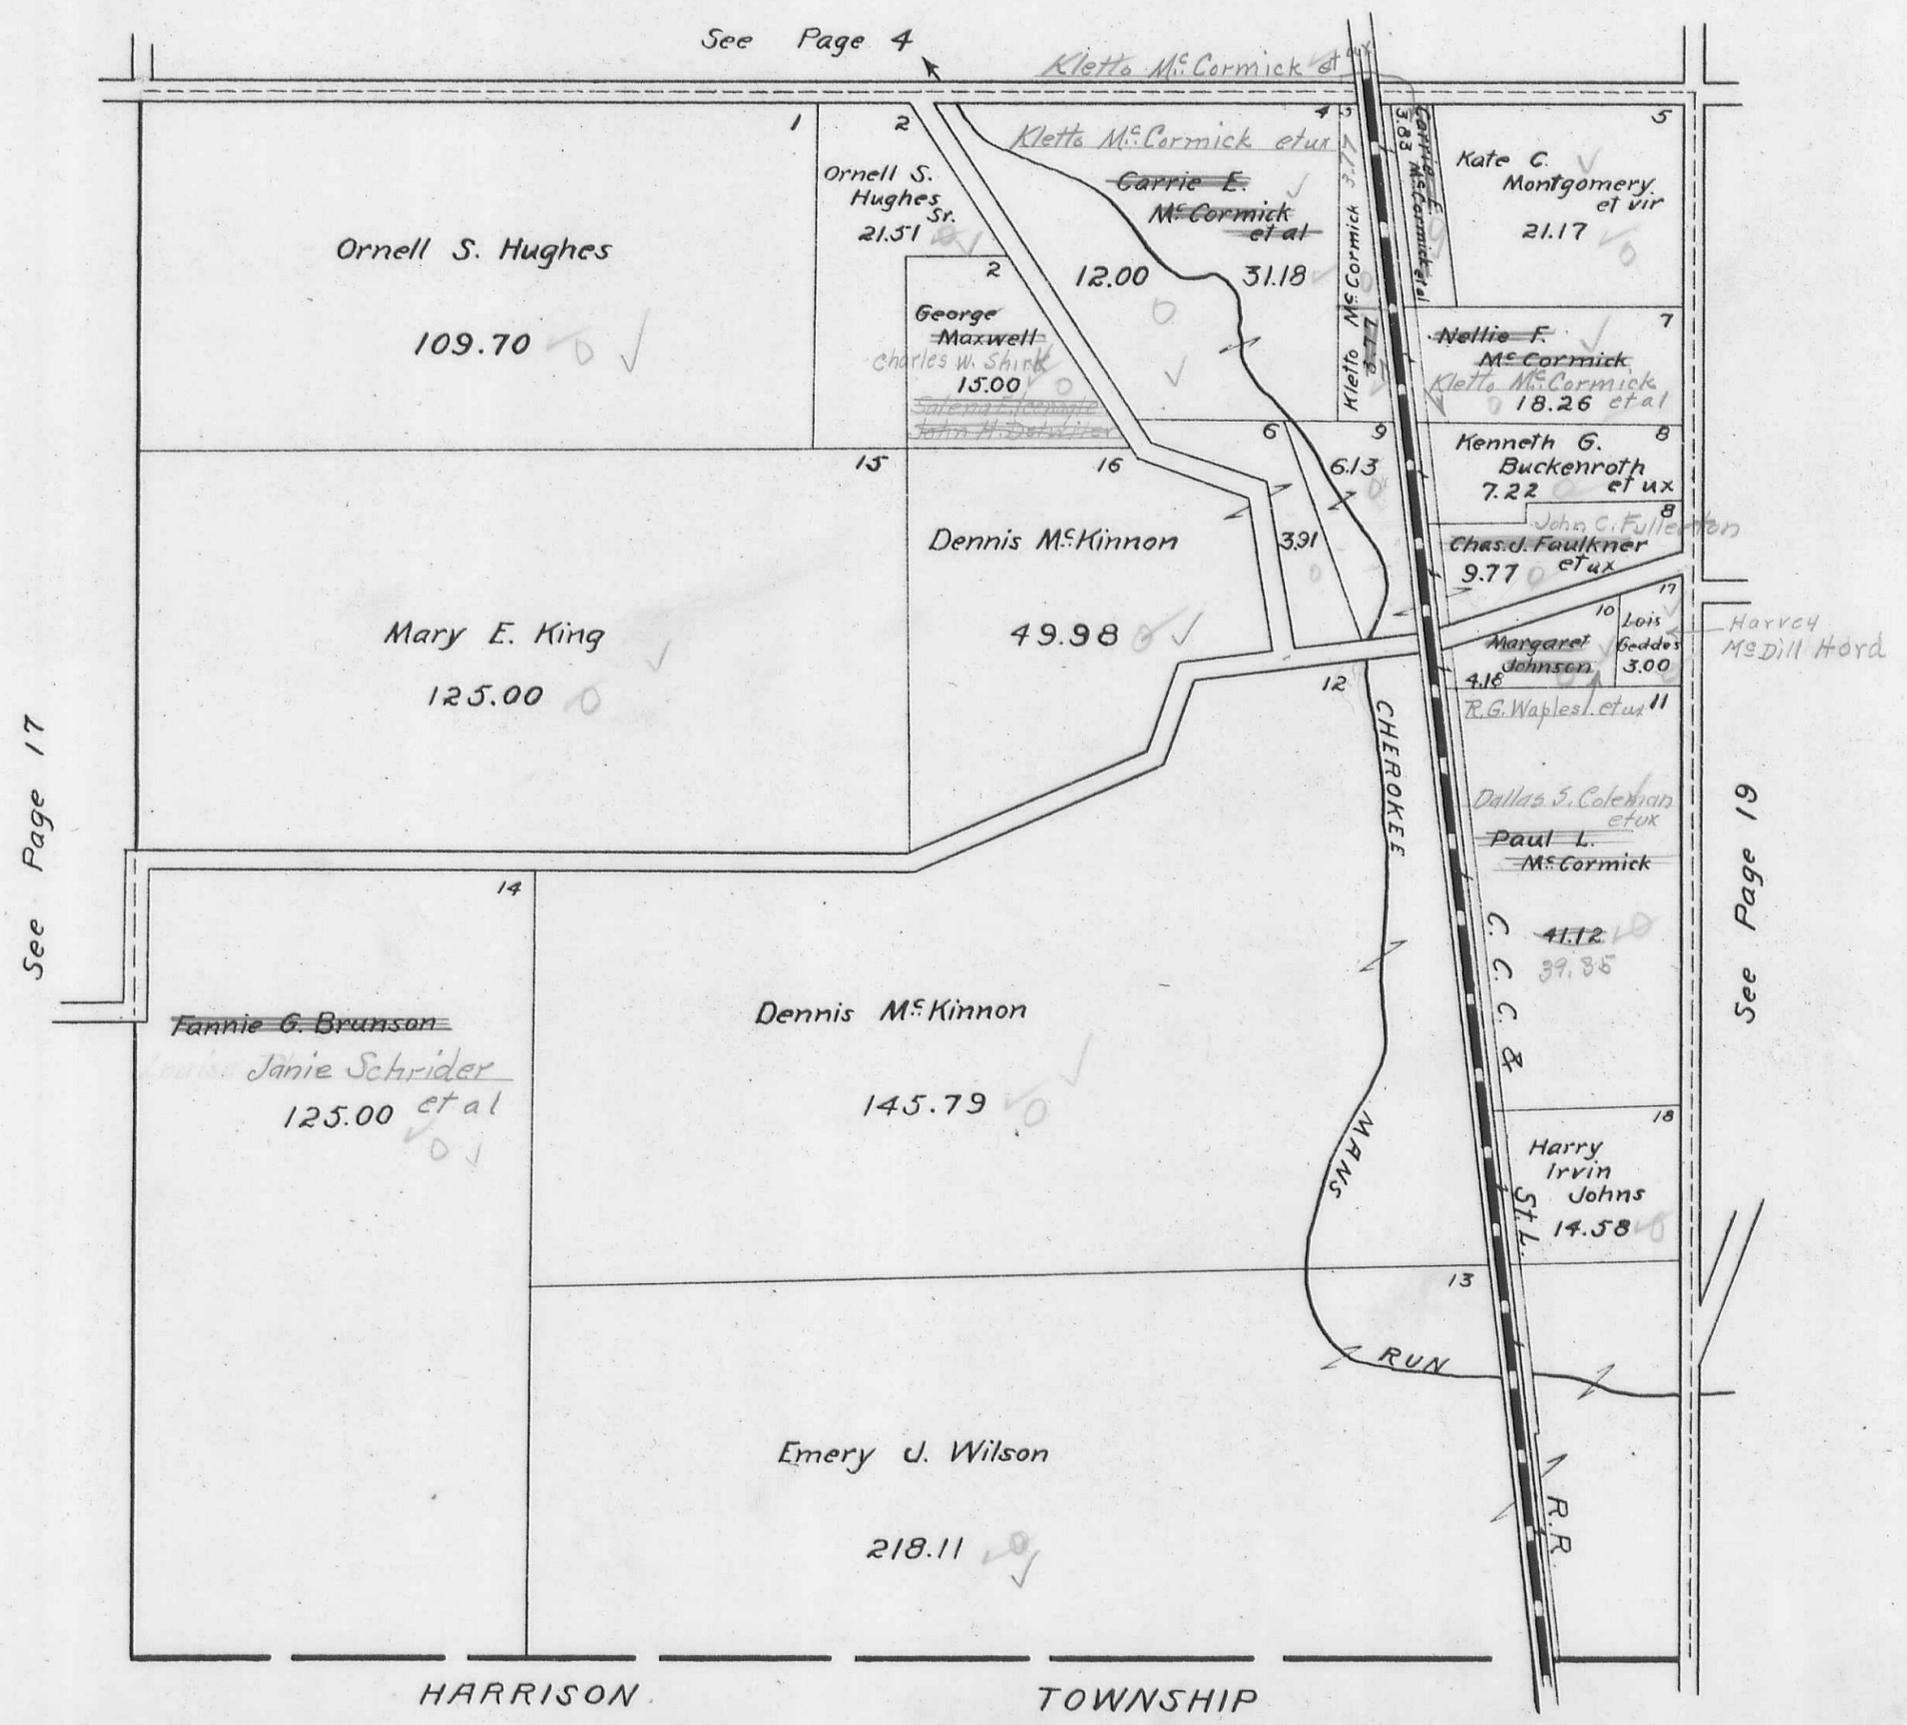

See Page 17

See Page 19


HARRISON TOWNSHIP

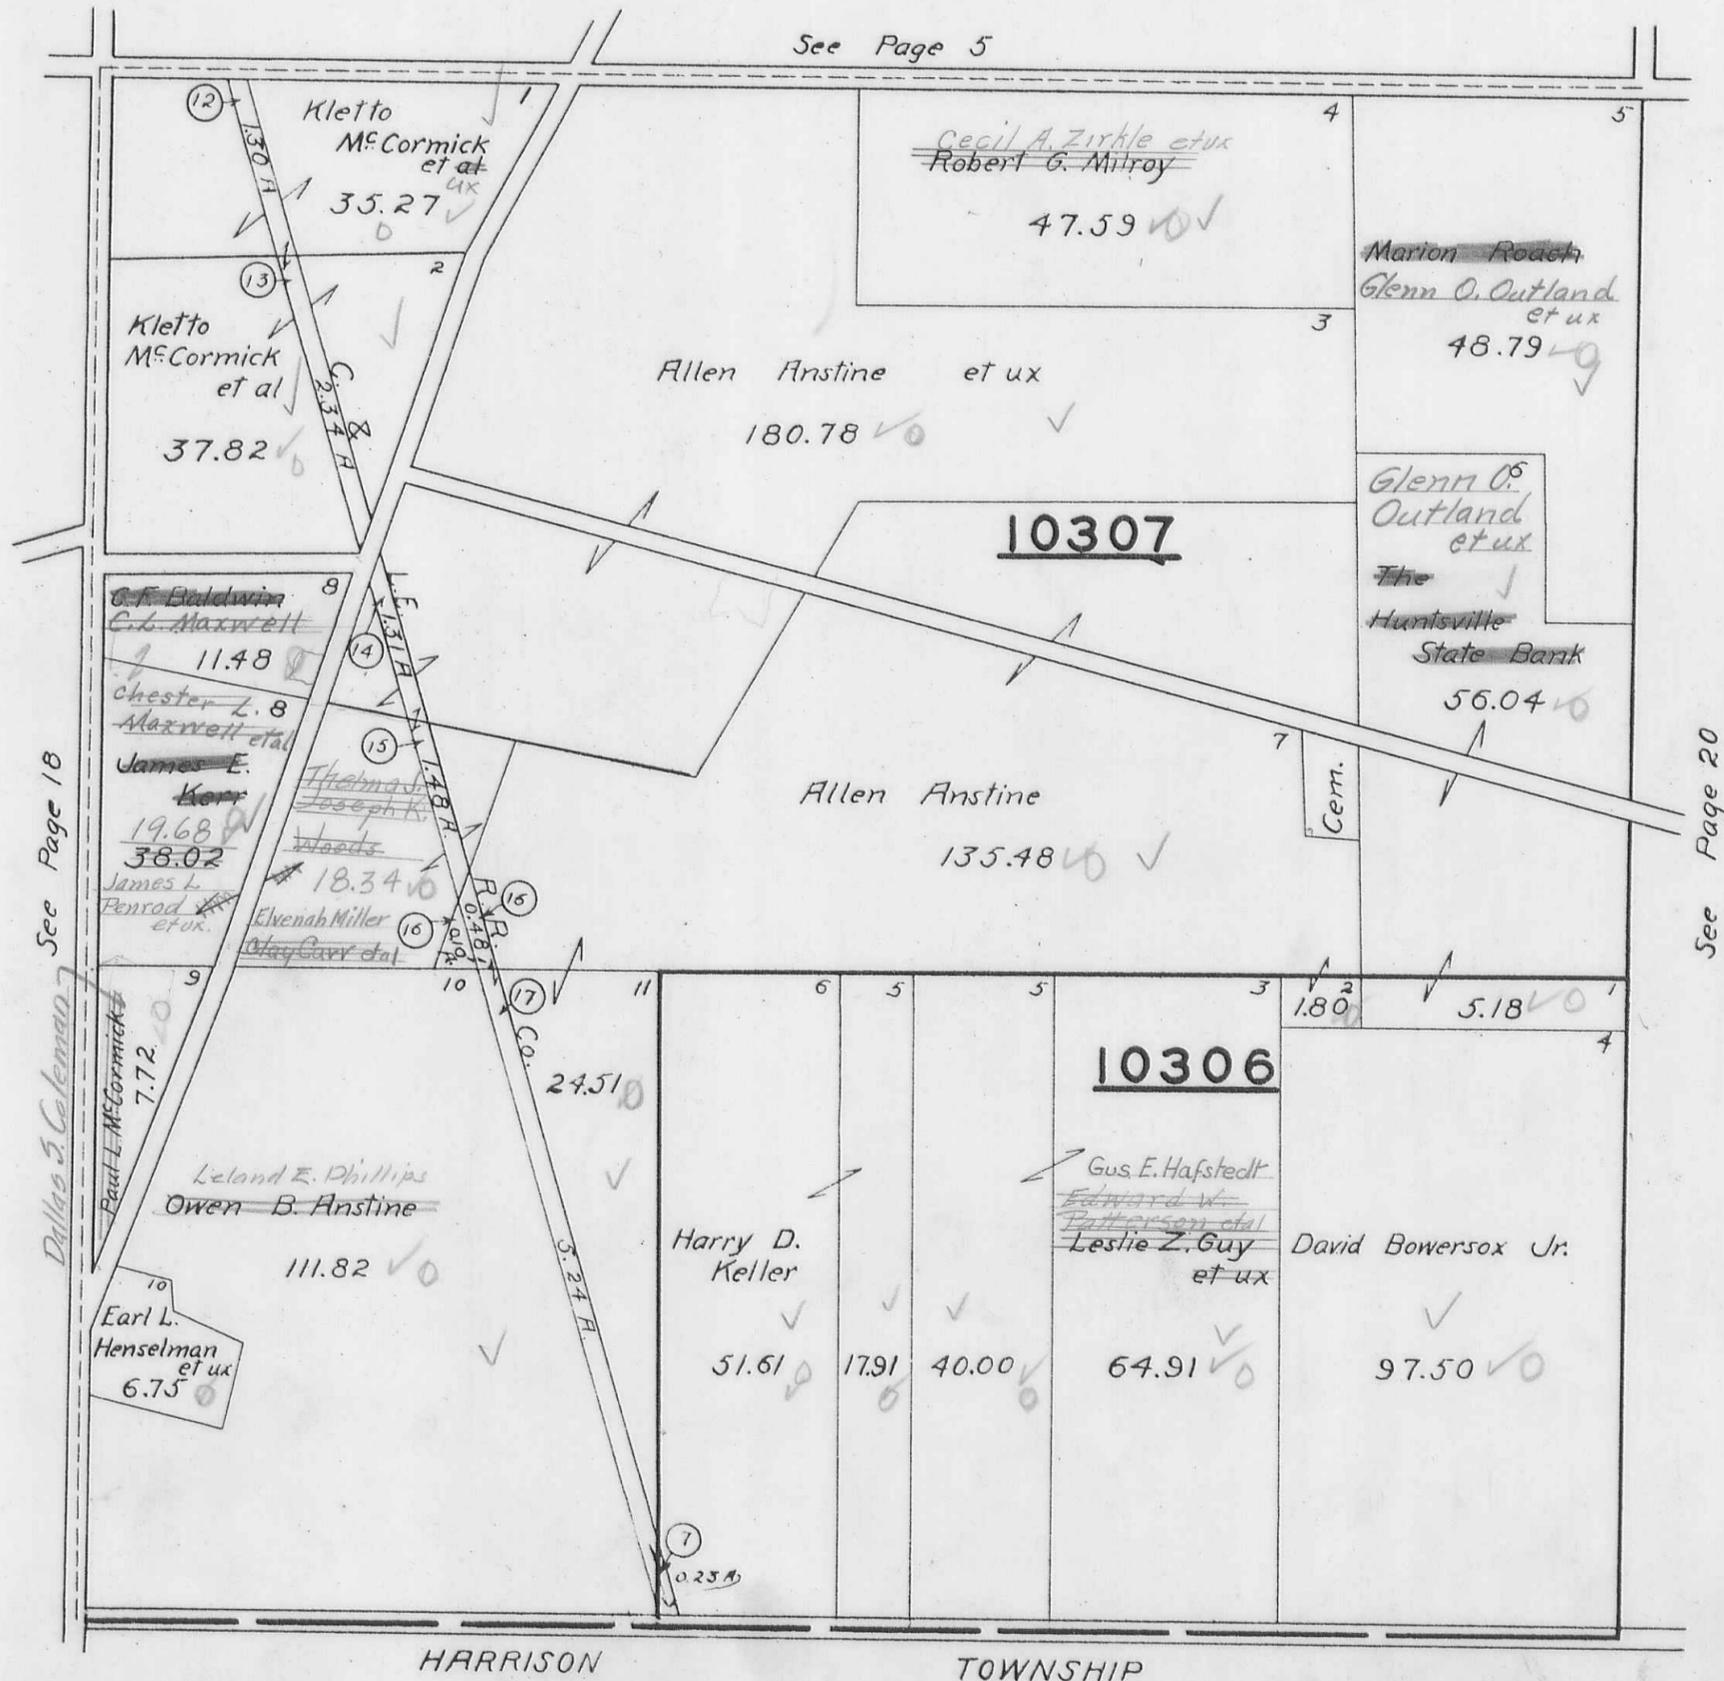

McARTHUR TOWNSHIP
VIRGINIA MILITARY SURVEY 9883

SCALE 10 CHAINS TO THE INCH

See Page 10

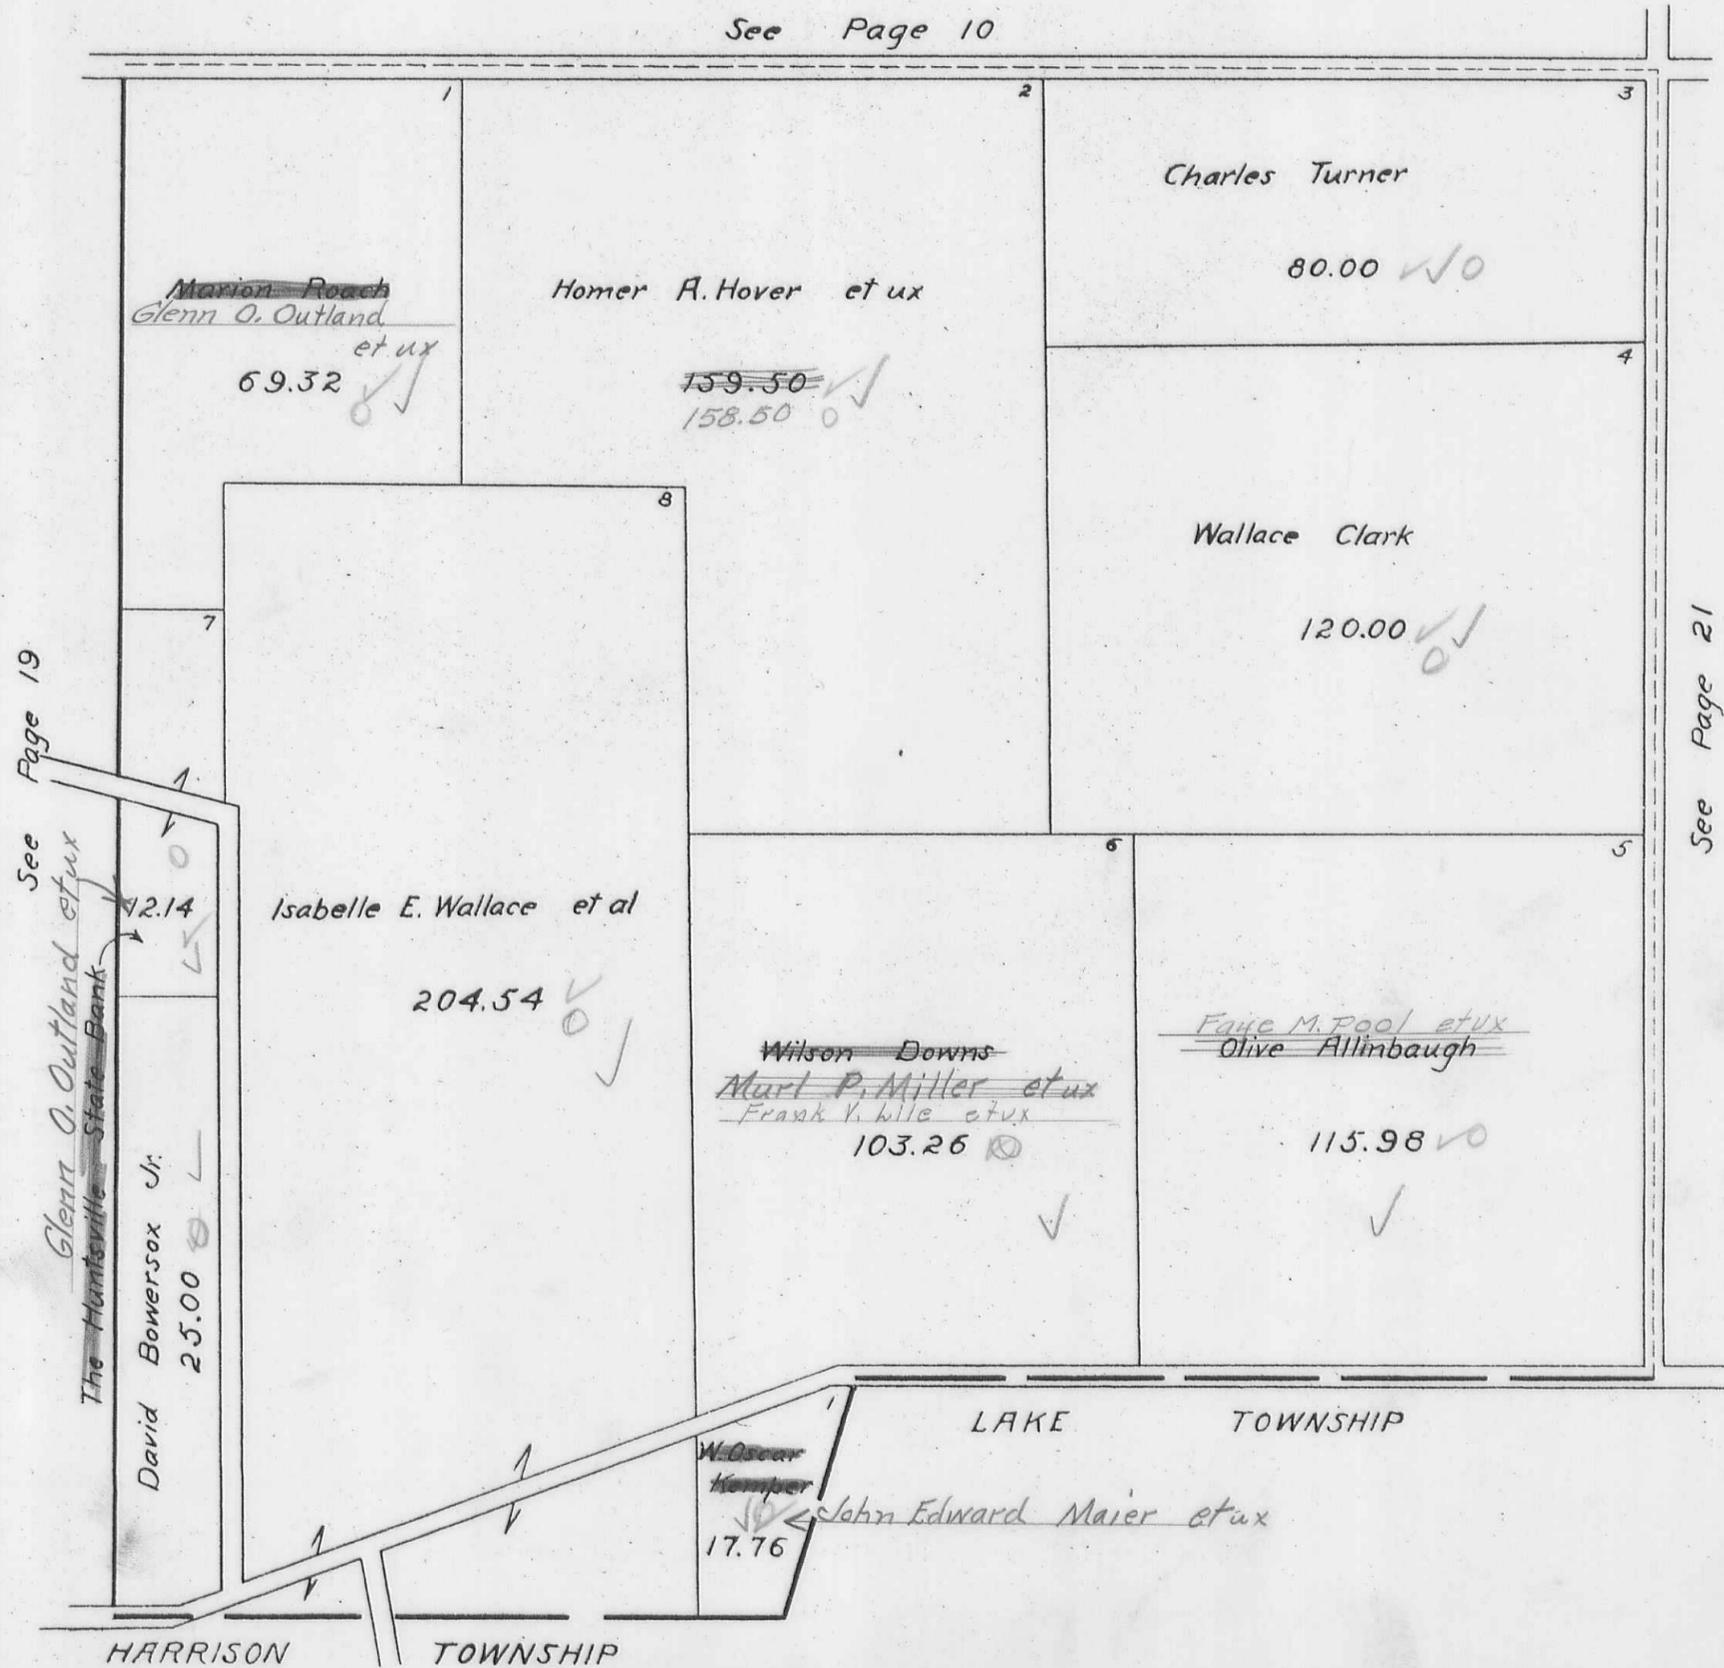

VIRGINIA MILITARY SURVEYS 9884 9885

SCALE 10 CHAINS TO THE INCH

See Page 11

See Page 12



See Page 20

41.62
51.25

93.37


HUNTSVILLE CORPORATION SOUTH PART

SCALE 200 FEET TO THE INCH

VMS 9928

VMS 9904

Note: C. & L.E. R.R. Co.
Part Lot 81-.03A
Part Lot 82-.03A
Part Lot 83-.01A

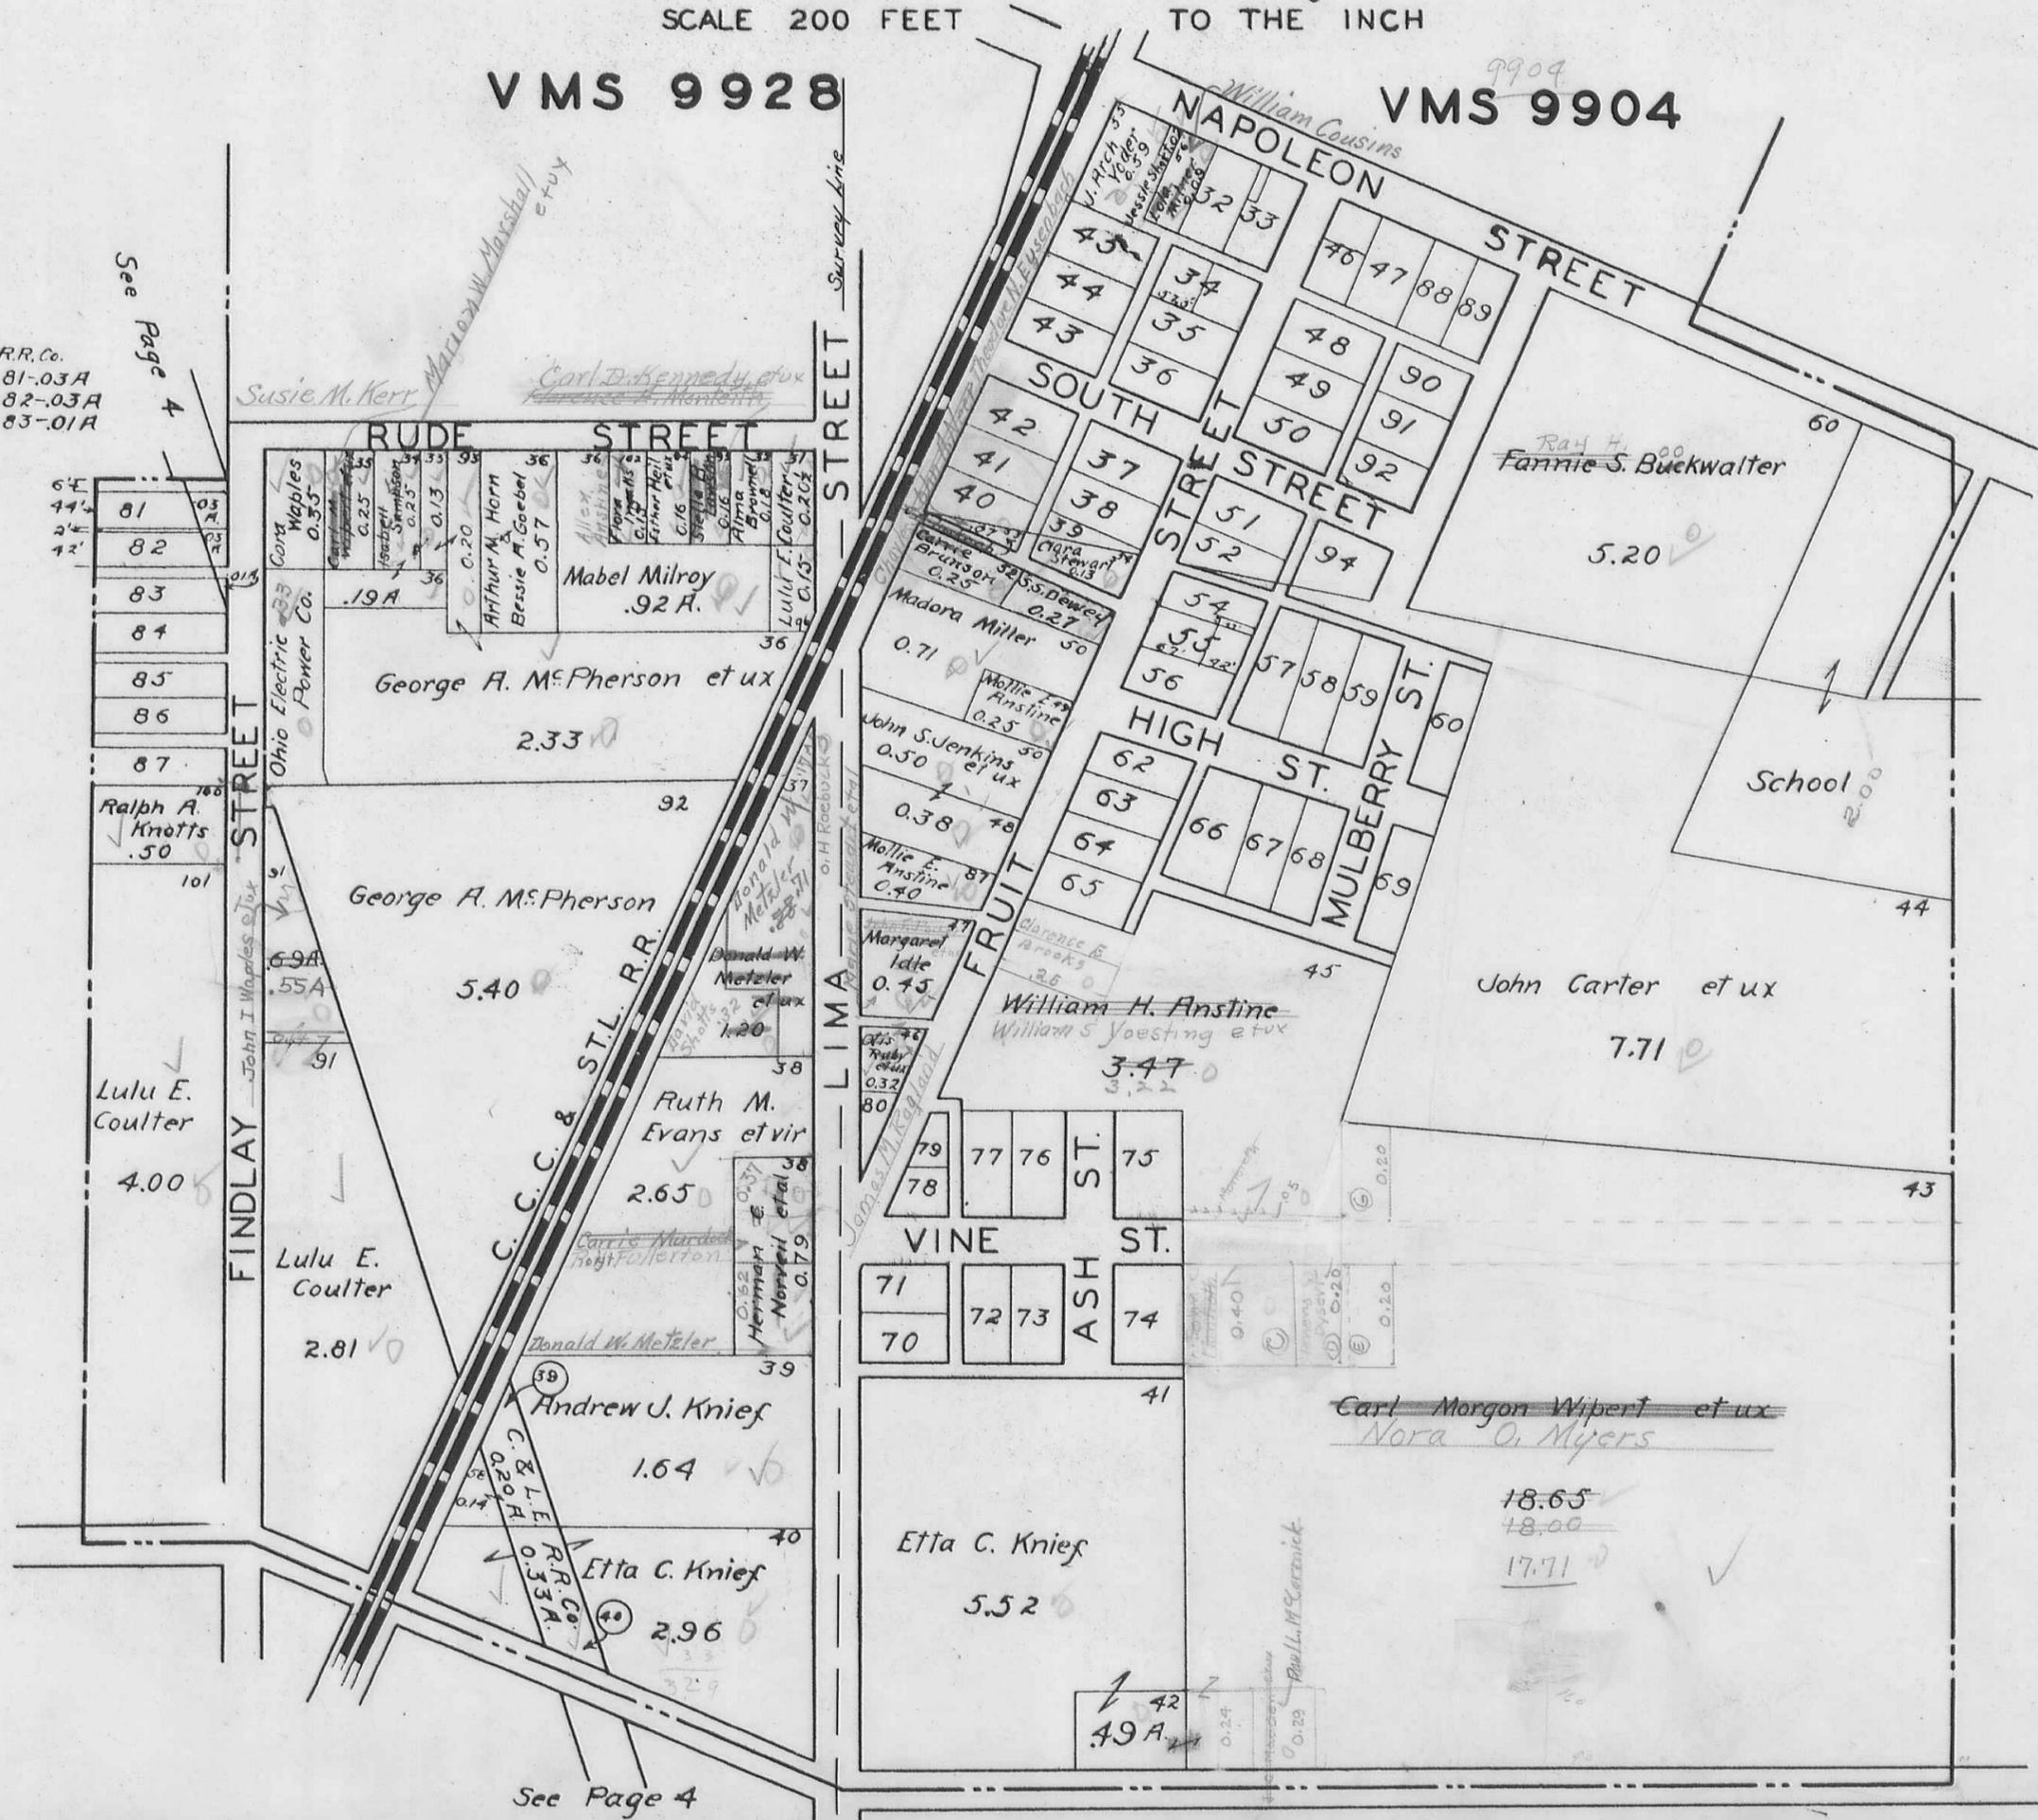

See Page 4


See Page 4

McARTHUR TOWNSHIP
 HUNTSVILLE CORPORATION NORTH PART

SCALE 200 FEET TO THE INCH

VMS 9928

VMS 9904

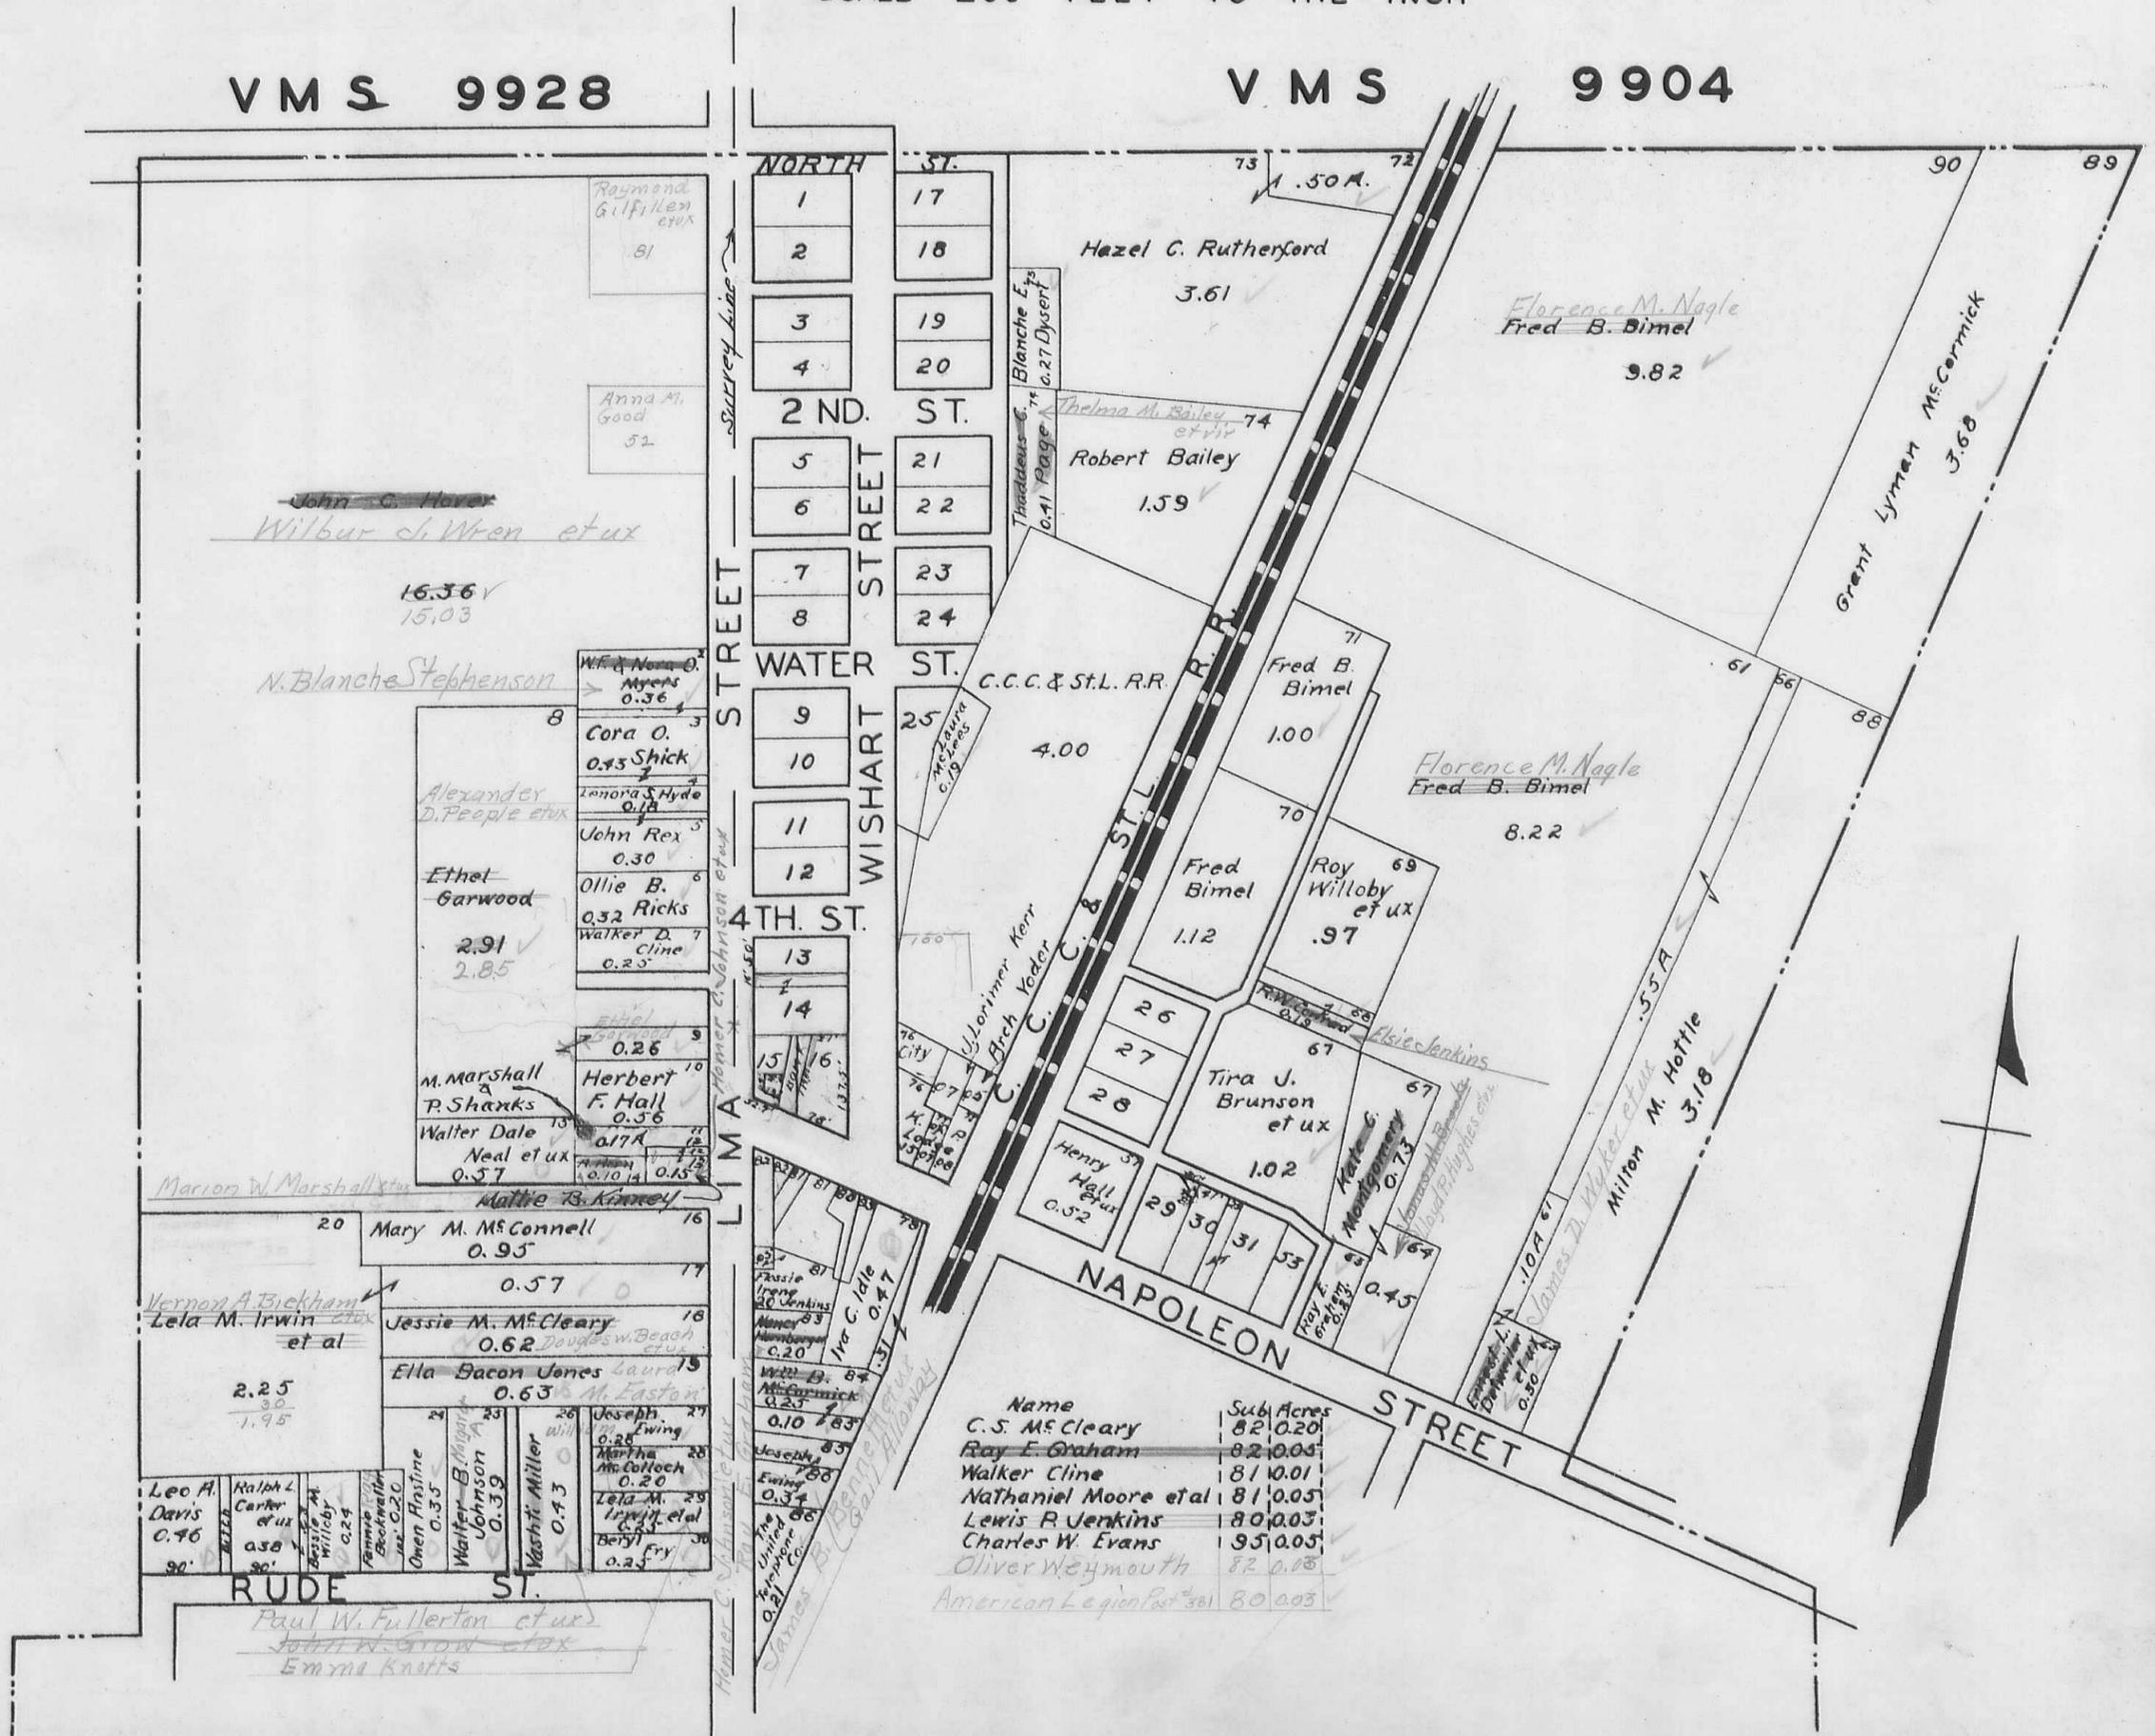

Name	Subl. Acres
C. S. McCleary	82 0.20
Ray E. Graham	82 0.00
Walker Cline	81 0.01
Nathaniel Moore et al	81 0.05
Lewis R. Jenkins	80 0.03
Charles W. Evans	95 0.05
Oliver Weymouth	82 0.03
American Legion	80 0.03

McARTHUR TOWNSHIP
HUNTSVILLE CORPORATION NORTH PART


New-PAGE 23

Jan 1-1948

SCALE 200 FEET TO THE INCH

9903
VMS 9928

VMS 9904

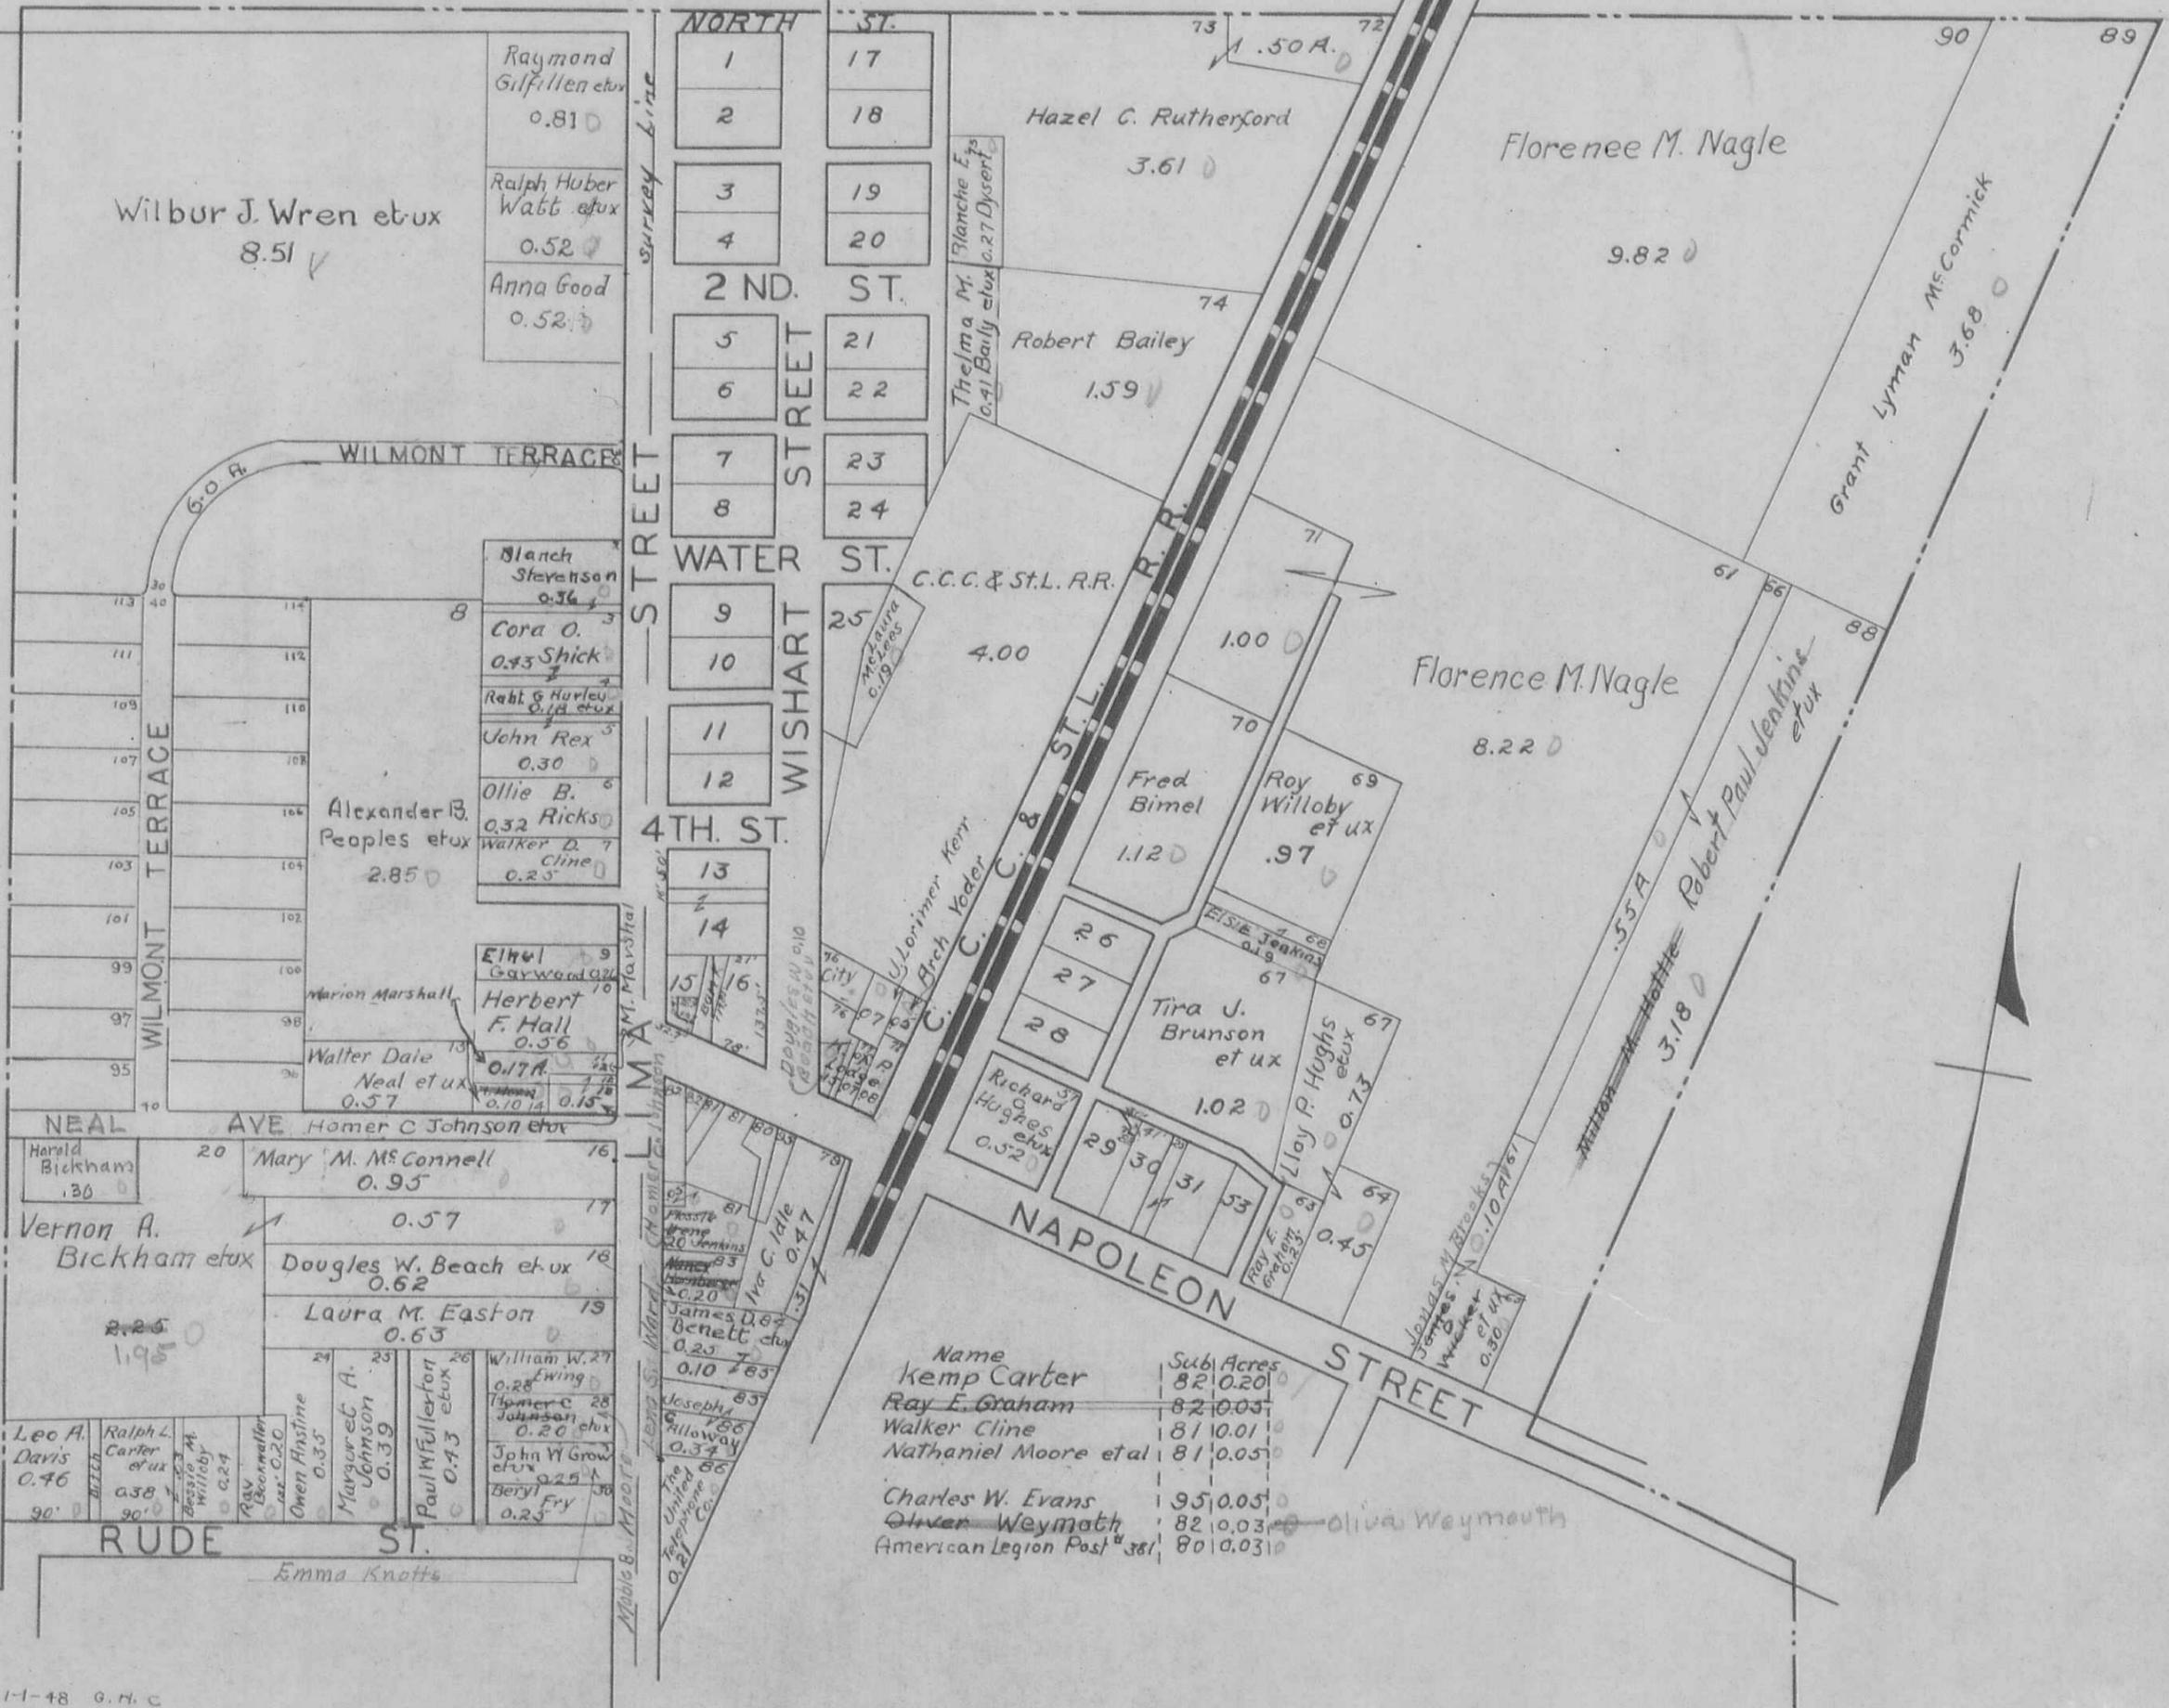

NORTHWOOD

SCALE 200 FEET TO THE INCH

*all streets & alleys
North of Main St.
Not vacated except
~~Detroit Street~~
Comm. Journal X - page 475
August 10 - 1931*

