

The original of this page is blank or missing.

(464)


Marie Addition.

499.16

156'	50'	52'	52'	52'	52'
2430					
2431					
2432					
2433					

Survey 52⁴⁵

5245+

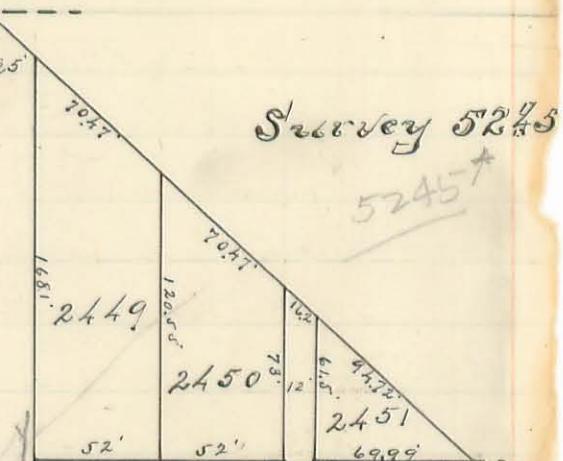

Grange Ave.

156'	50'	52'	52'	52'
2434				
2435				
2436				
2437				

156'	50'	52'	52'	52'
2438				
2439				
2440				
2441				

Patterson Ave.

156'	50'	52'	52'	52'
2442				
2443				
2463				

Scale 80' = 1"

• Stone Monuments.

Scale 80' = 1"

• Stone Monuments.

Palmer's Addition.

Kale Blvd.

Scale 80' = 1"

• Stone Monuments.

*The Irving Place Addition
to Beloit Avenue Block.*


Surveyor's Certificate: I the undersigned Surveyor do hereby certify that the annexed plat is a true and accurate representation of Irving Place Addition as surveyed and laid out by me on the 14th and 20th Days of June, 1900, and that the following is an accurate description of the same, commencing at a stone monument in the east line of Mad River St. and 90 feet N. of the continuation of the N. line of Palmer Addition; thence S. 87° E. 220 feet to a stone monument; thence S. 3° W. 68 feet to a stone monument; thence N. 81° 9' E. and with Rausenberger's N. line to a point being 20' E. of the center at right angles of Park Avenue; thence N. 3° E. and parallel and 20' E. of the center of Park Avenue to a stone monument and in line with a. b. a. a. Rausenberger's N.W. line; thence N. 60° 16' E. to a stone monument at the extreme E. corner of said Addition; thence N. 44° 33' W. 281.16 feet to a stone monument and at the S.E. corner of Maria Rathmels tract; thence N. 87° W. 479.16 feet to a stone monument and in the E. line of Mad River St. and at Maria Rathmels S.W. corner; thence S. 3° W. and with the E. line of Mad River St. to the beginning, containing 9.73 acres. All streets and alleys are parallel with or at right angles to Mad River St. excepting the south alley extending from Park Ave. to center Alley and have their respective distances marked in feet and tenths on line thereof. All intersections of streets and boundary lines are marked by stone monuments or iron pins as shown on the annexed plat and all angles are marked in degrees and minutes. I hereby subscribe my name this 31st day of July A.D. 1900.

Wilbur C. Gunn Surveyor.

The original of this page is blank or missing.

The original of this page is blank or missing.

Chillicothe Avenue.

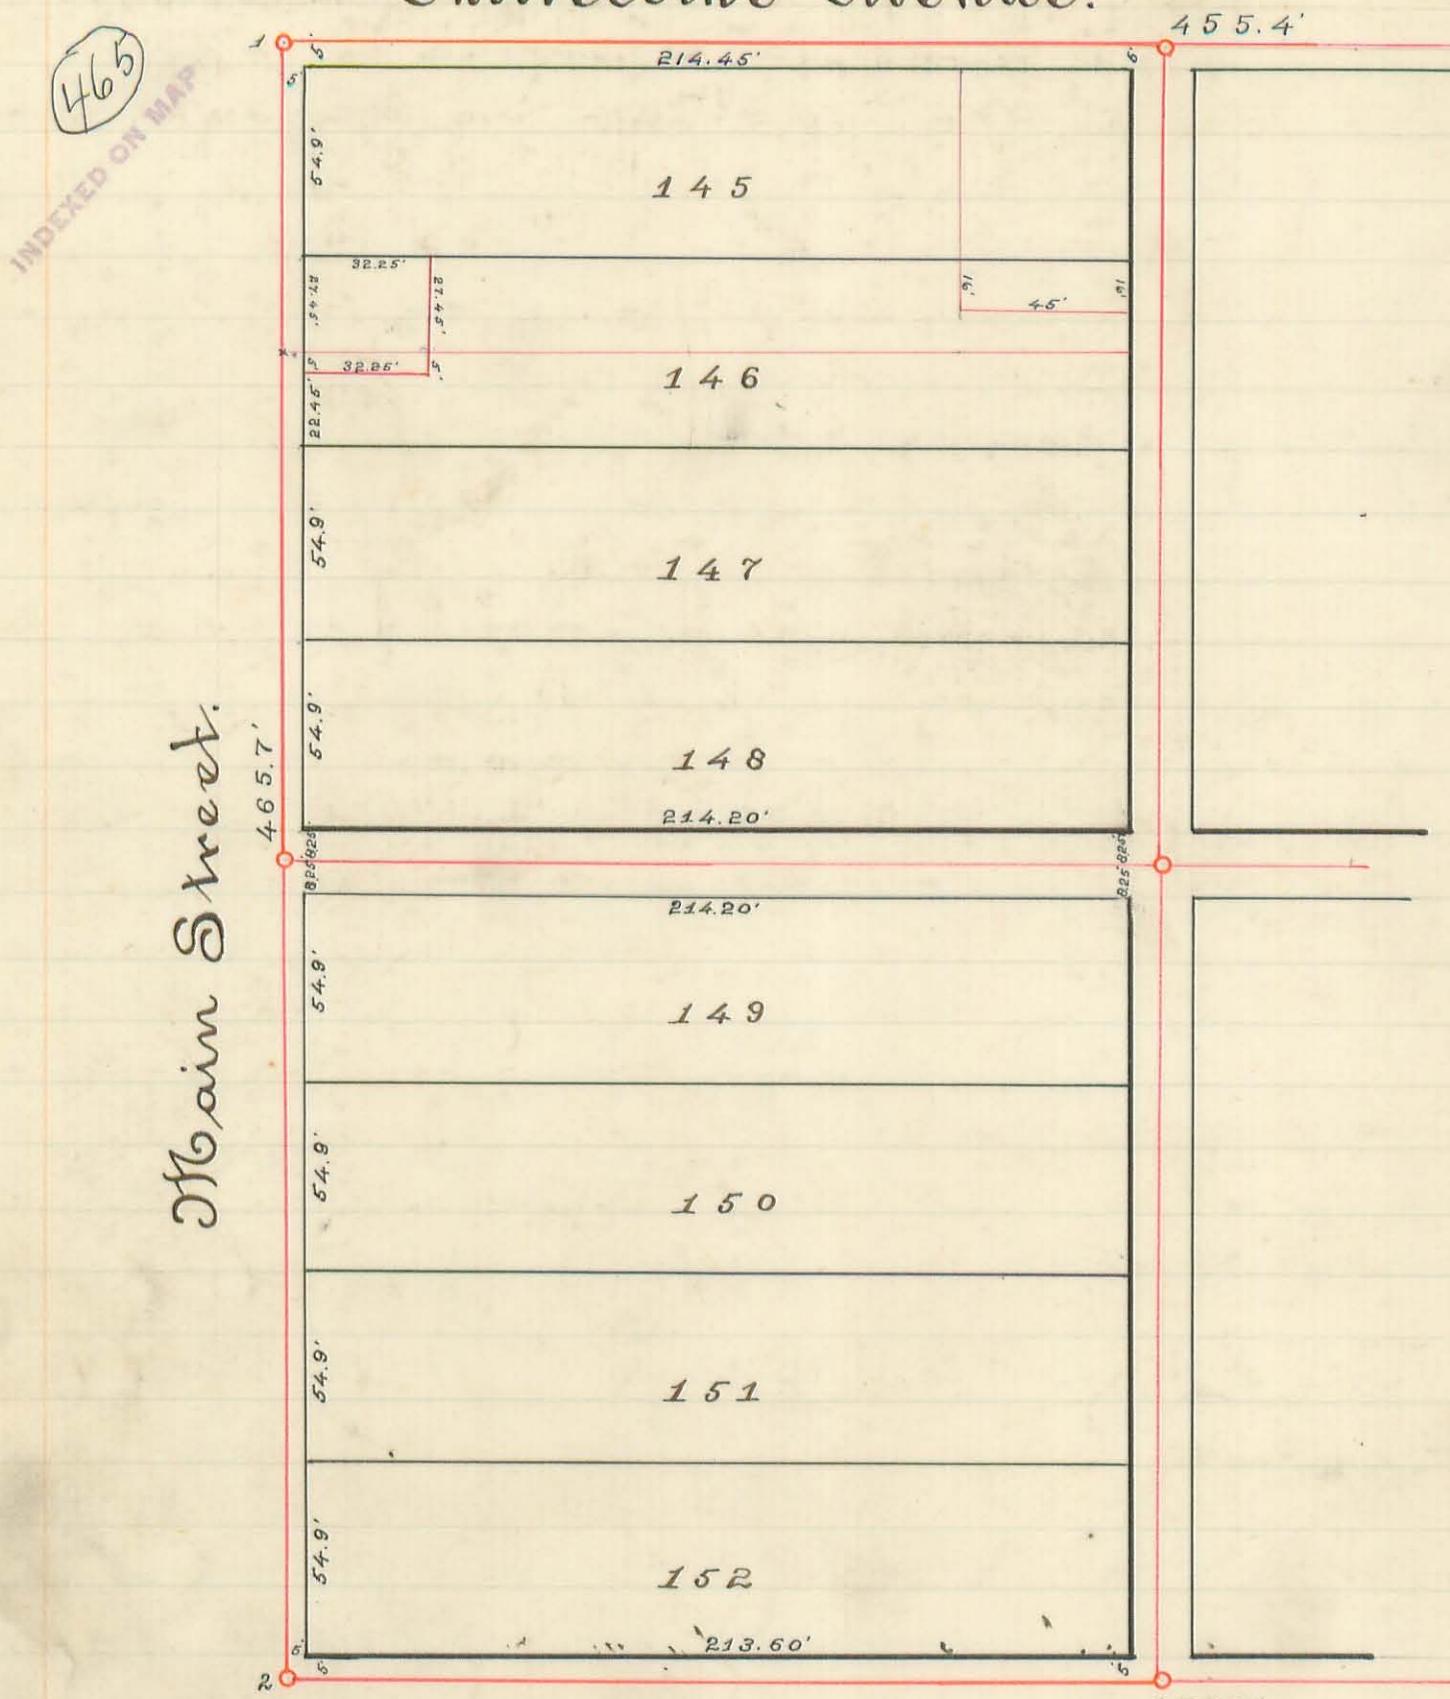

- N^o 1 Marked by $\frac{1}{2}$ inch hole bored in sidewalk stone 5 feet out from the true line of lots each way.
- N^o 2 Marked by $\frac{1}{2}$ inch bore and 18" long drove just below the surface and 5 feet out from lot lines each way.
- N^o 3 Not shown on annexed plat is 453.7' feet east of N^o 2 and is also marked with an iron pin 5' out from lot lines each way. It is also marked with a drill mark in S.W. stone in line with south line and 5' east. All lines surveyed around this block are 5' outside of lot lines.
- N^o 4 Marked with drill in S.W. stone 455.4' East of N^o 2. The mark here is also marked with guide stakes at line of lot and corner.

Survey. The above plat represents but half of the survey which was performed to establish the lines to lot N^o 146 and portion sold off the West end of it. To accomplish the object desired the centre lines of Main & Mad River Streets were established North and South also. Chillicothe and Auburn Avenues were established East and West all in line with the regular established monuments of the incorporation. Then offset lines were made to within 5 feet of the lot lines around the entire block. The measurement there made was distributed proportional across the block.

Surveyors Certificate

Bellefontaine Ohio Nov 1893.

I the undersigned Surveyor do hereby Certify that - the annexed plat is a true and correct representation of a survey as made by me in the incorporated village of Bellefontaine Ohio, and is a correct rendering according to the laws of Ohio of the division of the lots located and bounded by the streets and Avenues given on the plat. That in order to locate the premises described in a deed of General warranty made by G. W. Emerson Administrator of the estate of Mary Hulker to Phillip H. Leidigh and Geo C. Leidigh, made on the 12th day of March A.D. 1892.

Recorded March 30th 1892. Volume 49. Page 351. Logan Co Records.

Which said deed describes the north $\frac{1}{2}$ of lot No 146 in said village and also describes a portion from the south $\frac{1}{2}$ occupied and covered by a brick building and frame addition thereto on said lot No 146.

After making a careful measurement of the entire block of lots and dividing same in proportion to the original divisions marked on plat, I found that the north half of lot No 146 is entitled to Twenty seven and forty five hundredths feet front, by the length which is about Two hundred and fourteen and thirty three hundredths feet. The building described in the foregoing described deed to Phillip H. Leidigh and Geo C. Leidigh, extends over on the south half of said lot five feet wide North and south, by Thirty Two and Twenty Five Hundredths feet in length, this measurement made to the outside of the frame weather boarding on the east side of the building. The projecting eaves of the building extending eight inches farther East, upon completion of this measurement the old Brick building and frame addition were torn down and a new brick building supplying the same place erected.

Willard A. Ginn


County Surveyor

James F Fisher.

C. Stover, C. Moore Assisting as Chainmen & Flagmen Co.

The original of this page is blank or missing.

The original of this page is blank or missing.

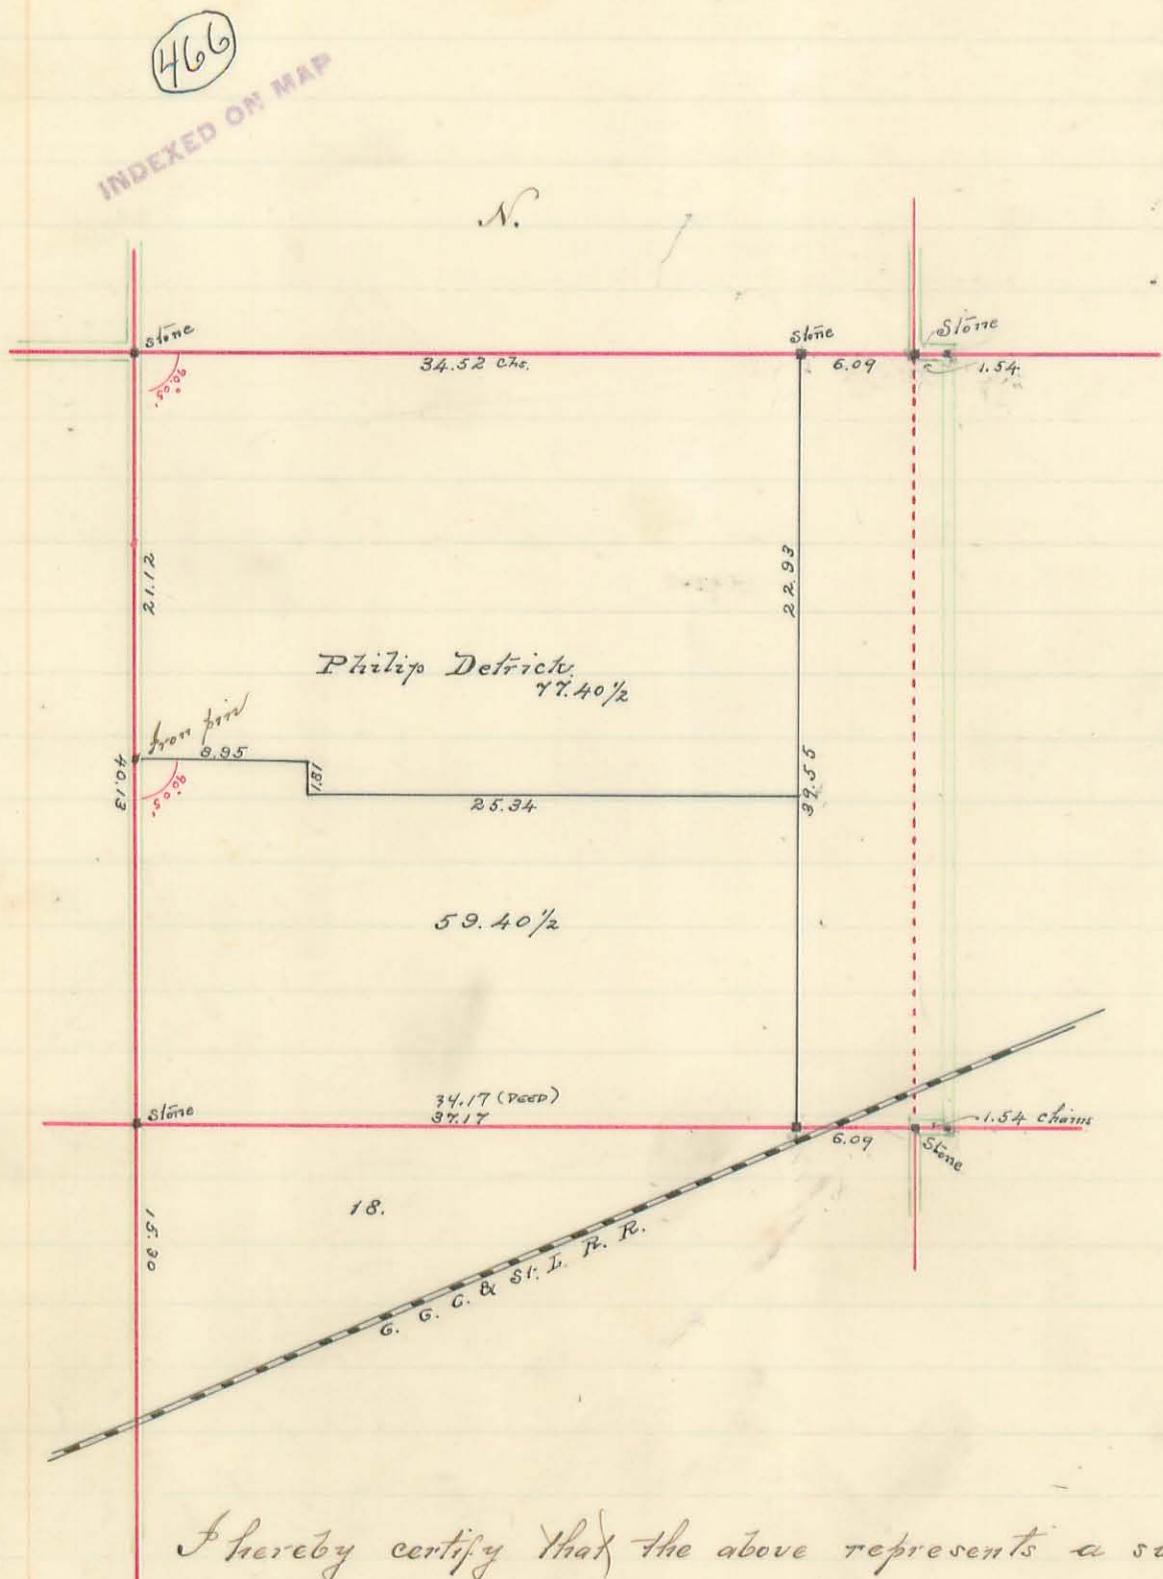

Survey of Tract of Land for
Philip Detrick

= 112 =

Harrison Township

Being The
S.W. 1/4 of Sec. 22, T. 3, R. 14.
Surveyed 1898

I hereby certify that the above represents a survey as made by me in
1898, for Philip Detrick. The corner stones were found from earlier survey
verified and the dividing line run as desired.

James F. Fisher, Deputy Co. Surv.

A. Detrick
Chas H. Moore } Chain men


The original of this page is blank or missing.

(461)

INDEXES ON MAP

Survey made March 12th 1894 for James H. Snapp
Bennett Snapp and Geo. C. Wolfinger.

Section 24 Town 3 Range 14 Harrison Township
Logan Co., Ohio

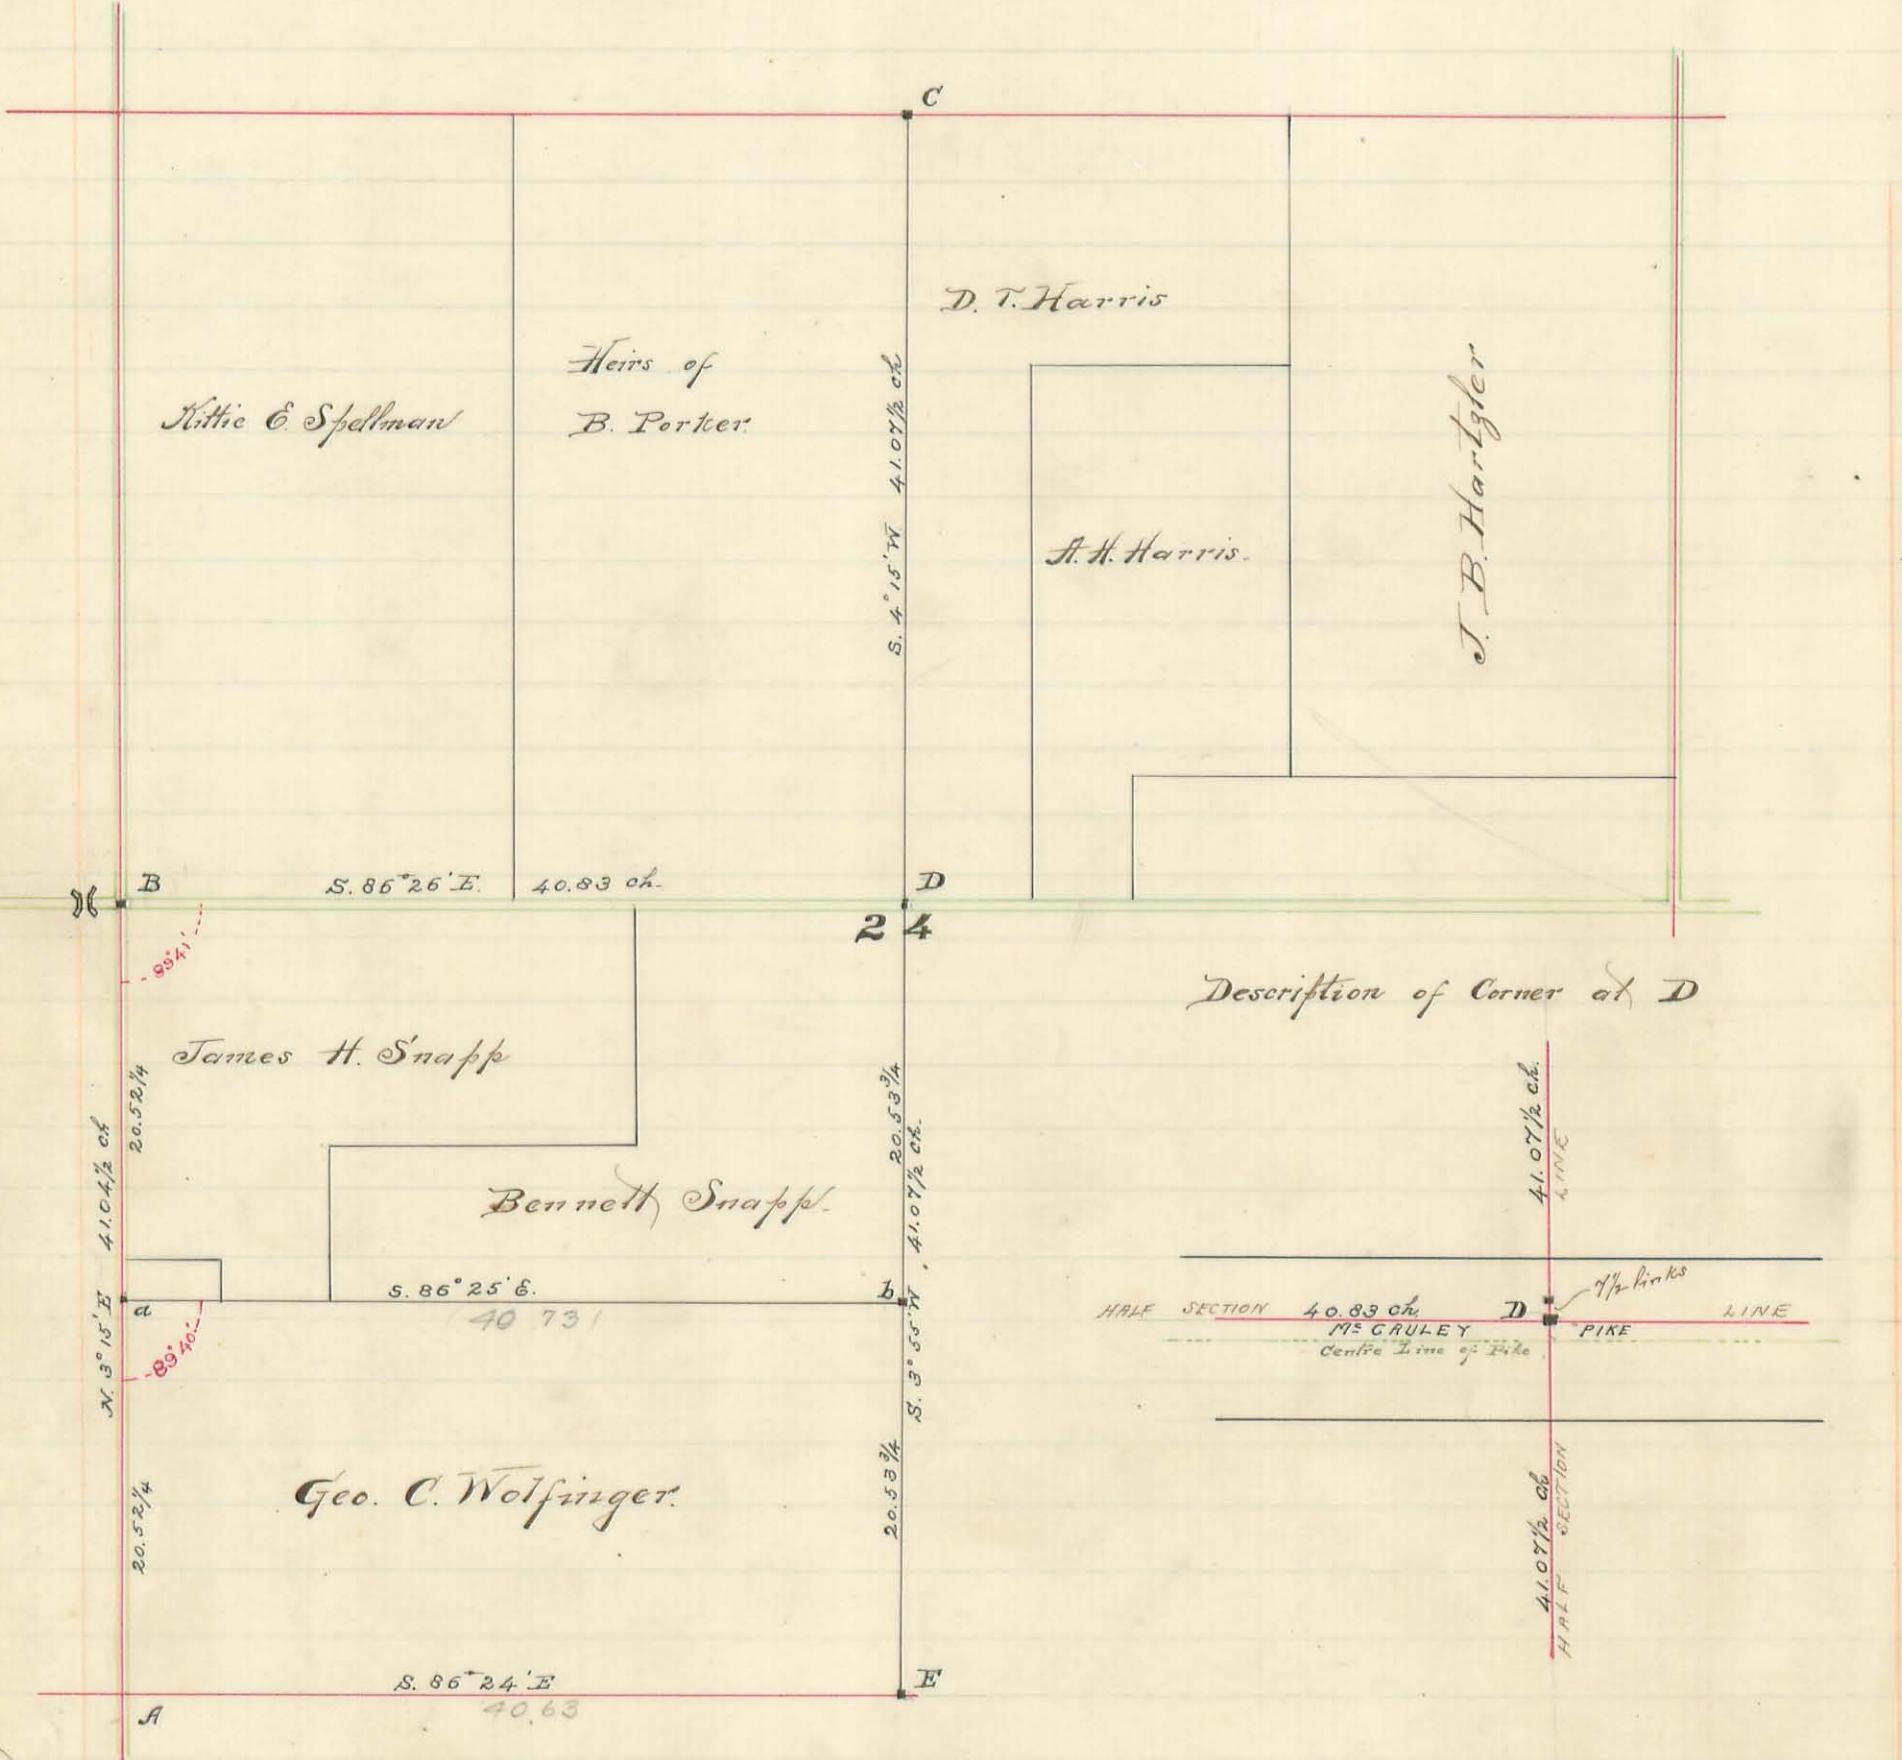

Witnesses and Monuments:

- A - Stone Granite Boulder - Two boulders, one on top of other - not marked -
- B - Stone Sandstone - End coping N.E. corner. 38 1/2 l. S.E. corner 38 1/2 l. Set on broken tile.
- C - Stone, White Boulder - marked with cross on top.
- D - Stone, 7/8 l. S. of a lime stone corner, cross marked on top.
- E - Stone, Boulder " " " " + 6" x 6" x 18" White Oak 6 l. S. on line.
- a - Stone, Lime, 6" x 6" x 18"
- b - Stone Lime 8" x 12" x 24"

C. Slover } charmen.
J. S. Snapp }

Walter A. Ginn, Surv. Logan Co.

The original of this page is blank or missing.


(468)
INDEXED ON MAP

= PLAT OF =
FAIRVIEW
 ADDITION

= TO =

Bellefontaine, Ohio -

Calculated by proportion
 Lots divided as above lots

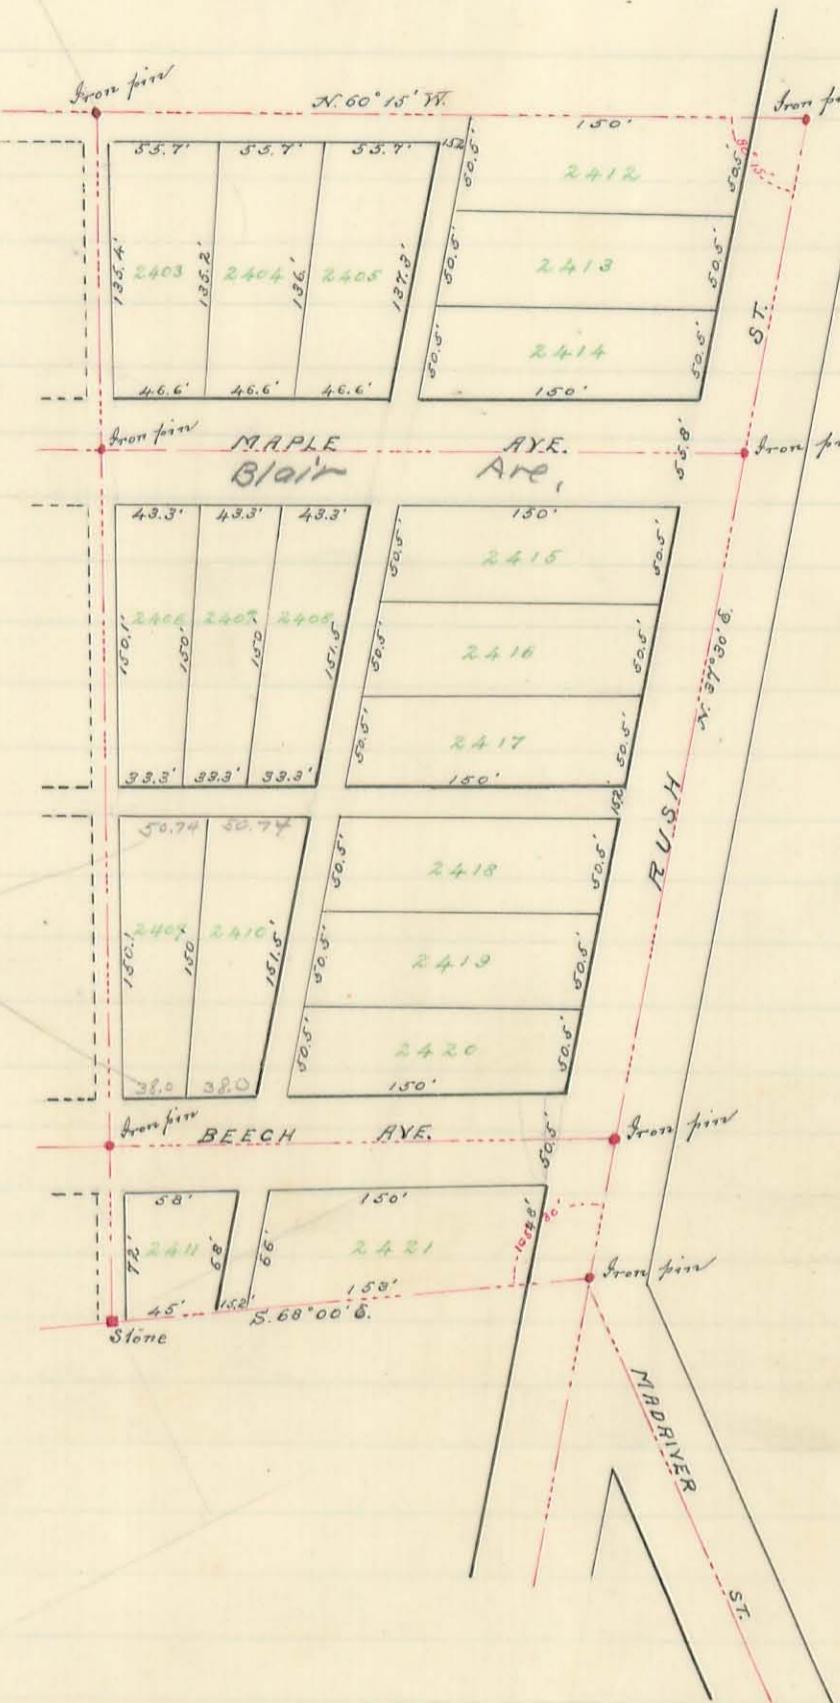

Surveyors Certificate:

I the undersigned Surveyor do hereby certify that the Fairview Addition to Bellefontaine, Ohio, is a subdivision of a $4\frac{1}{2}$ acre tract of land situated in the city of Bellefontaine, Ohio. Said Survey is Monumented as shown on above plat, which is a correct representation of the land as platted for the owners J.M. and E.M. Hamilton.

Chairmen } James T. Fisher
 Chas. A. Moore

Wilbur H. Ginn
 Surv. Legon Co.

Surveyed April 1899-


The original of this page is blank or missing.

Plat of McCracken and Cooke's Addition
to Bellefontaine, Ohio.

Sec. 35. T. 4. R. 14.

(469)

INDEXED ON MAP

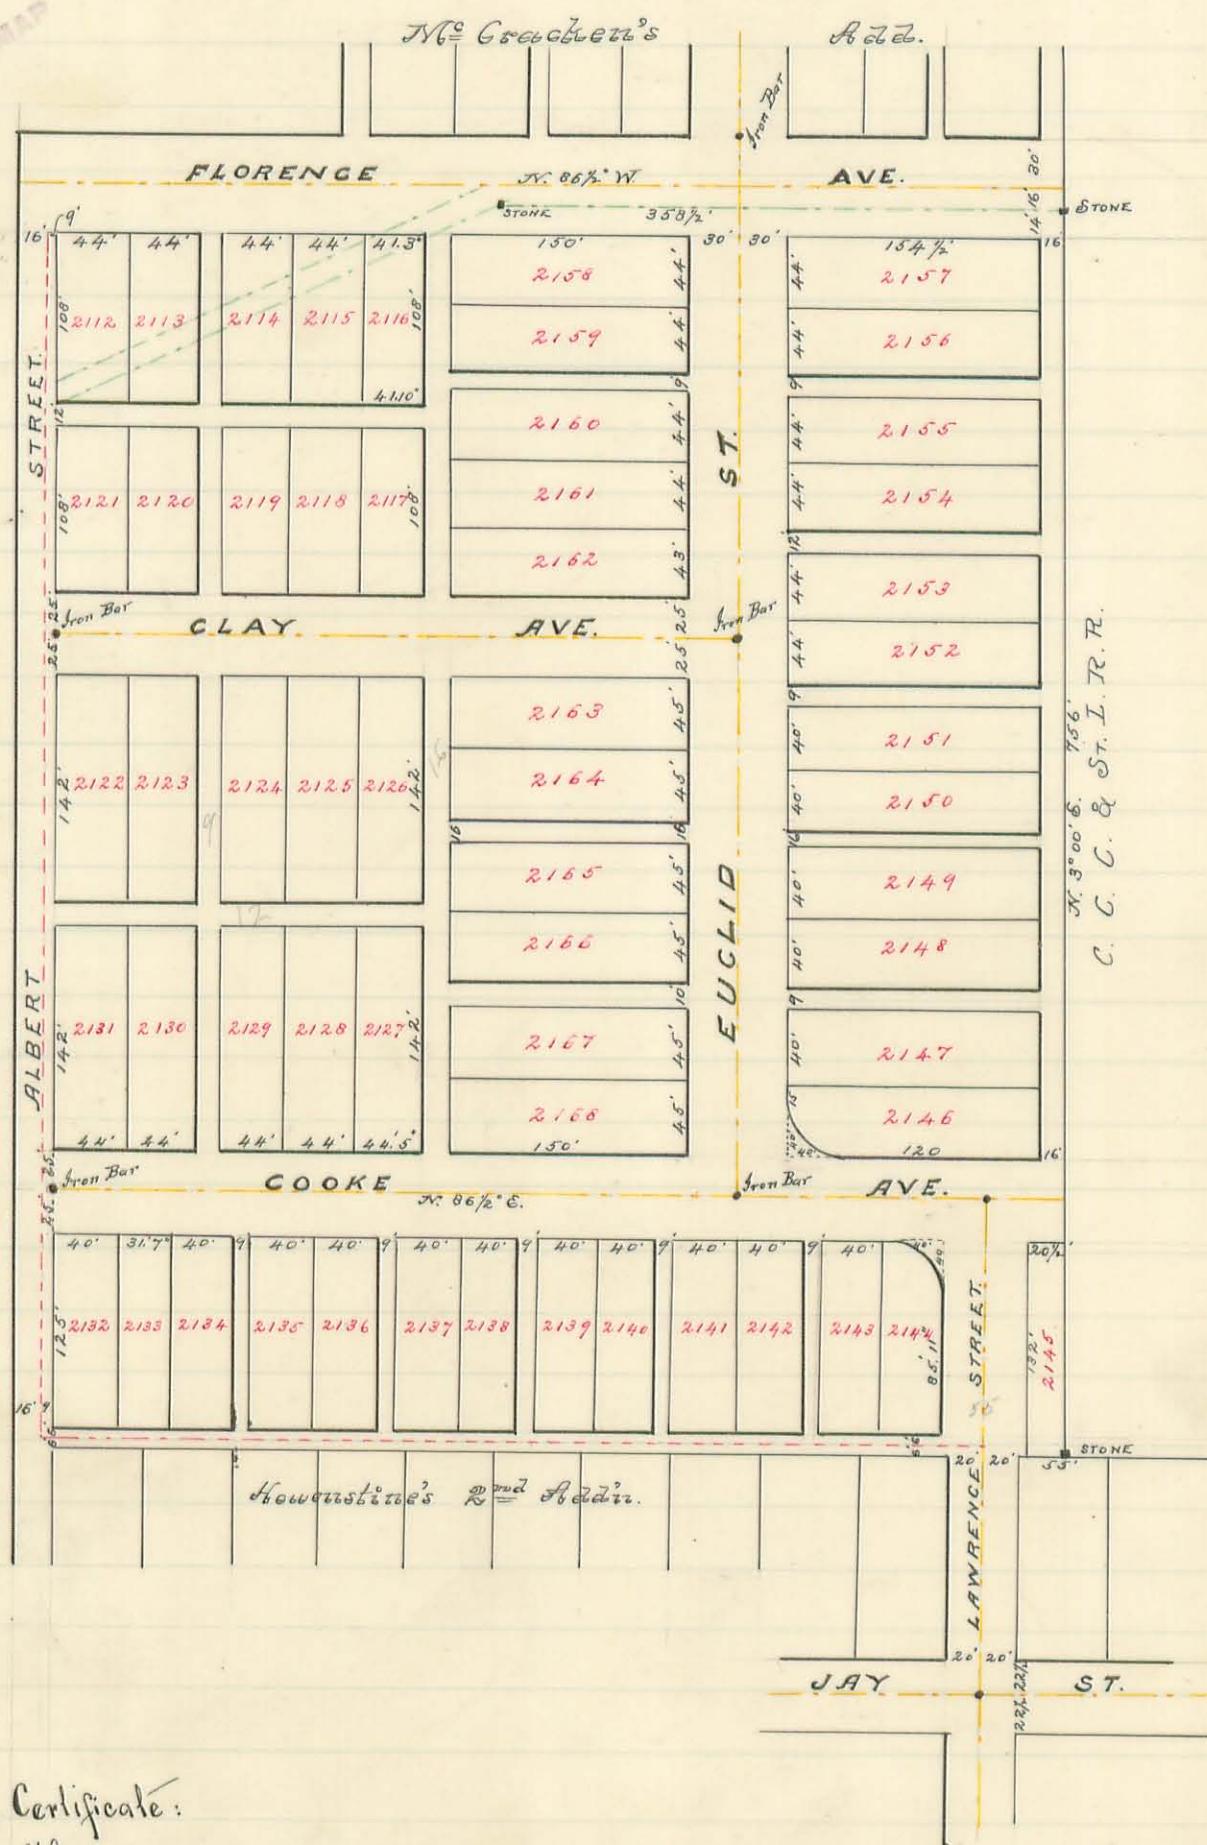

Surveyor's Certificate:

The above plat is a correct representation of lots surveyed by me, and laid out in January 1894 for the owners, Jas. E. McCracken, Thos. J. Cooke and Orrin S. D. Cooke, same being in Sec 35. Town 4. Range 14 Lake Township, Logan Co. Ohio. round iron bars about 2 feet long were driven where noted on plat.

H. C. Moore, Surveyor.

W. H. Ginn, County Surveyor.


The original of this page is blank or missing.

Survey for J.K.Elder.

220

V.III. Surveys - 10503 + $\frac{S12311}{S12878}$

INDEXED ON MAP
HJD

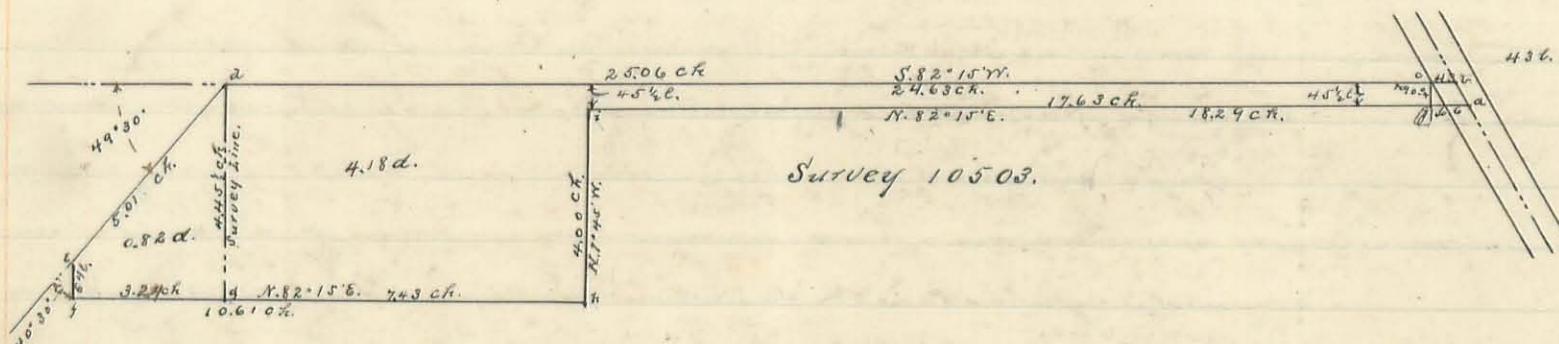

- c - Lime Stone monument. 6" x 8" x 24".
- d - Lime Stone monument. 6" x 8" x 24".
- e - Lime Stone monument. 6" x 8" x 24".
- f - Lime Stone monument. 6" x 8" x 24".
- g - Lime Stone monument. 6" x 8" x 24".
- h - Lime Stone monument. 6" x 8" x 24".
- i - Lime Stone monument. 6" x 8" x 24".
- j - Lime Stone monument. 6" x 8" x 24".

Lane - c-j - is 45 chains wide throughout.

f-g - is 318 chains.

g-h - is 748 chains.


points a+b in center Huntsville & Roundhead Pike.

Walter A. Ginn County Surveyor.

January - 1900.

Scale 4 chains to 1 inch.

Arthur Renick } Chairman,
Jess Bennett }

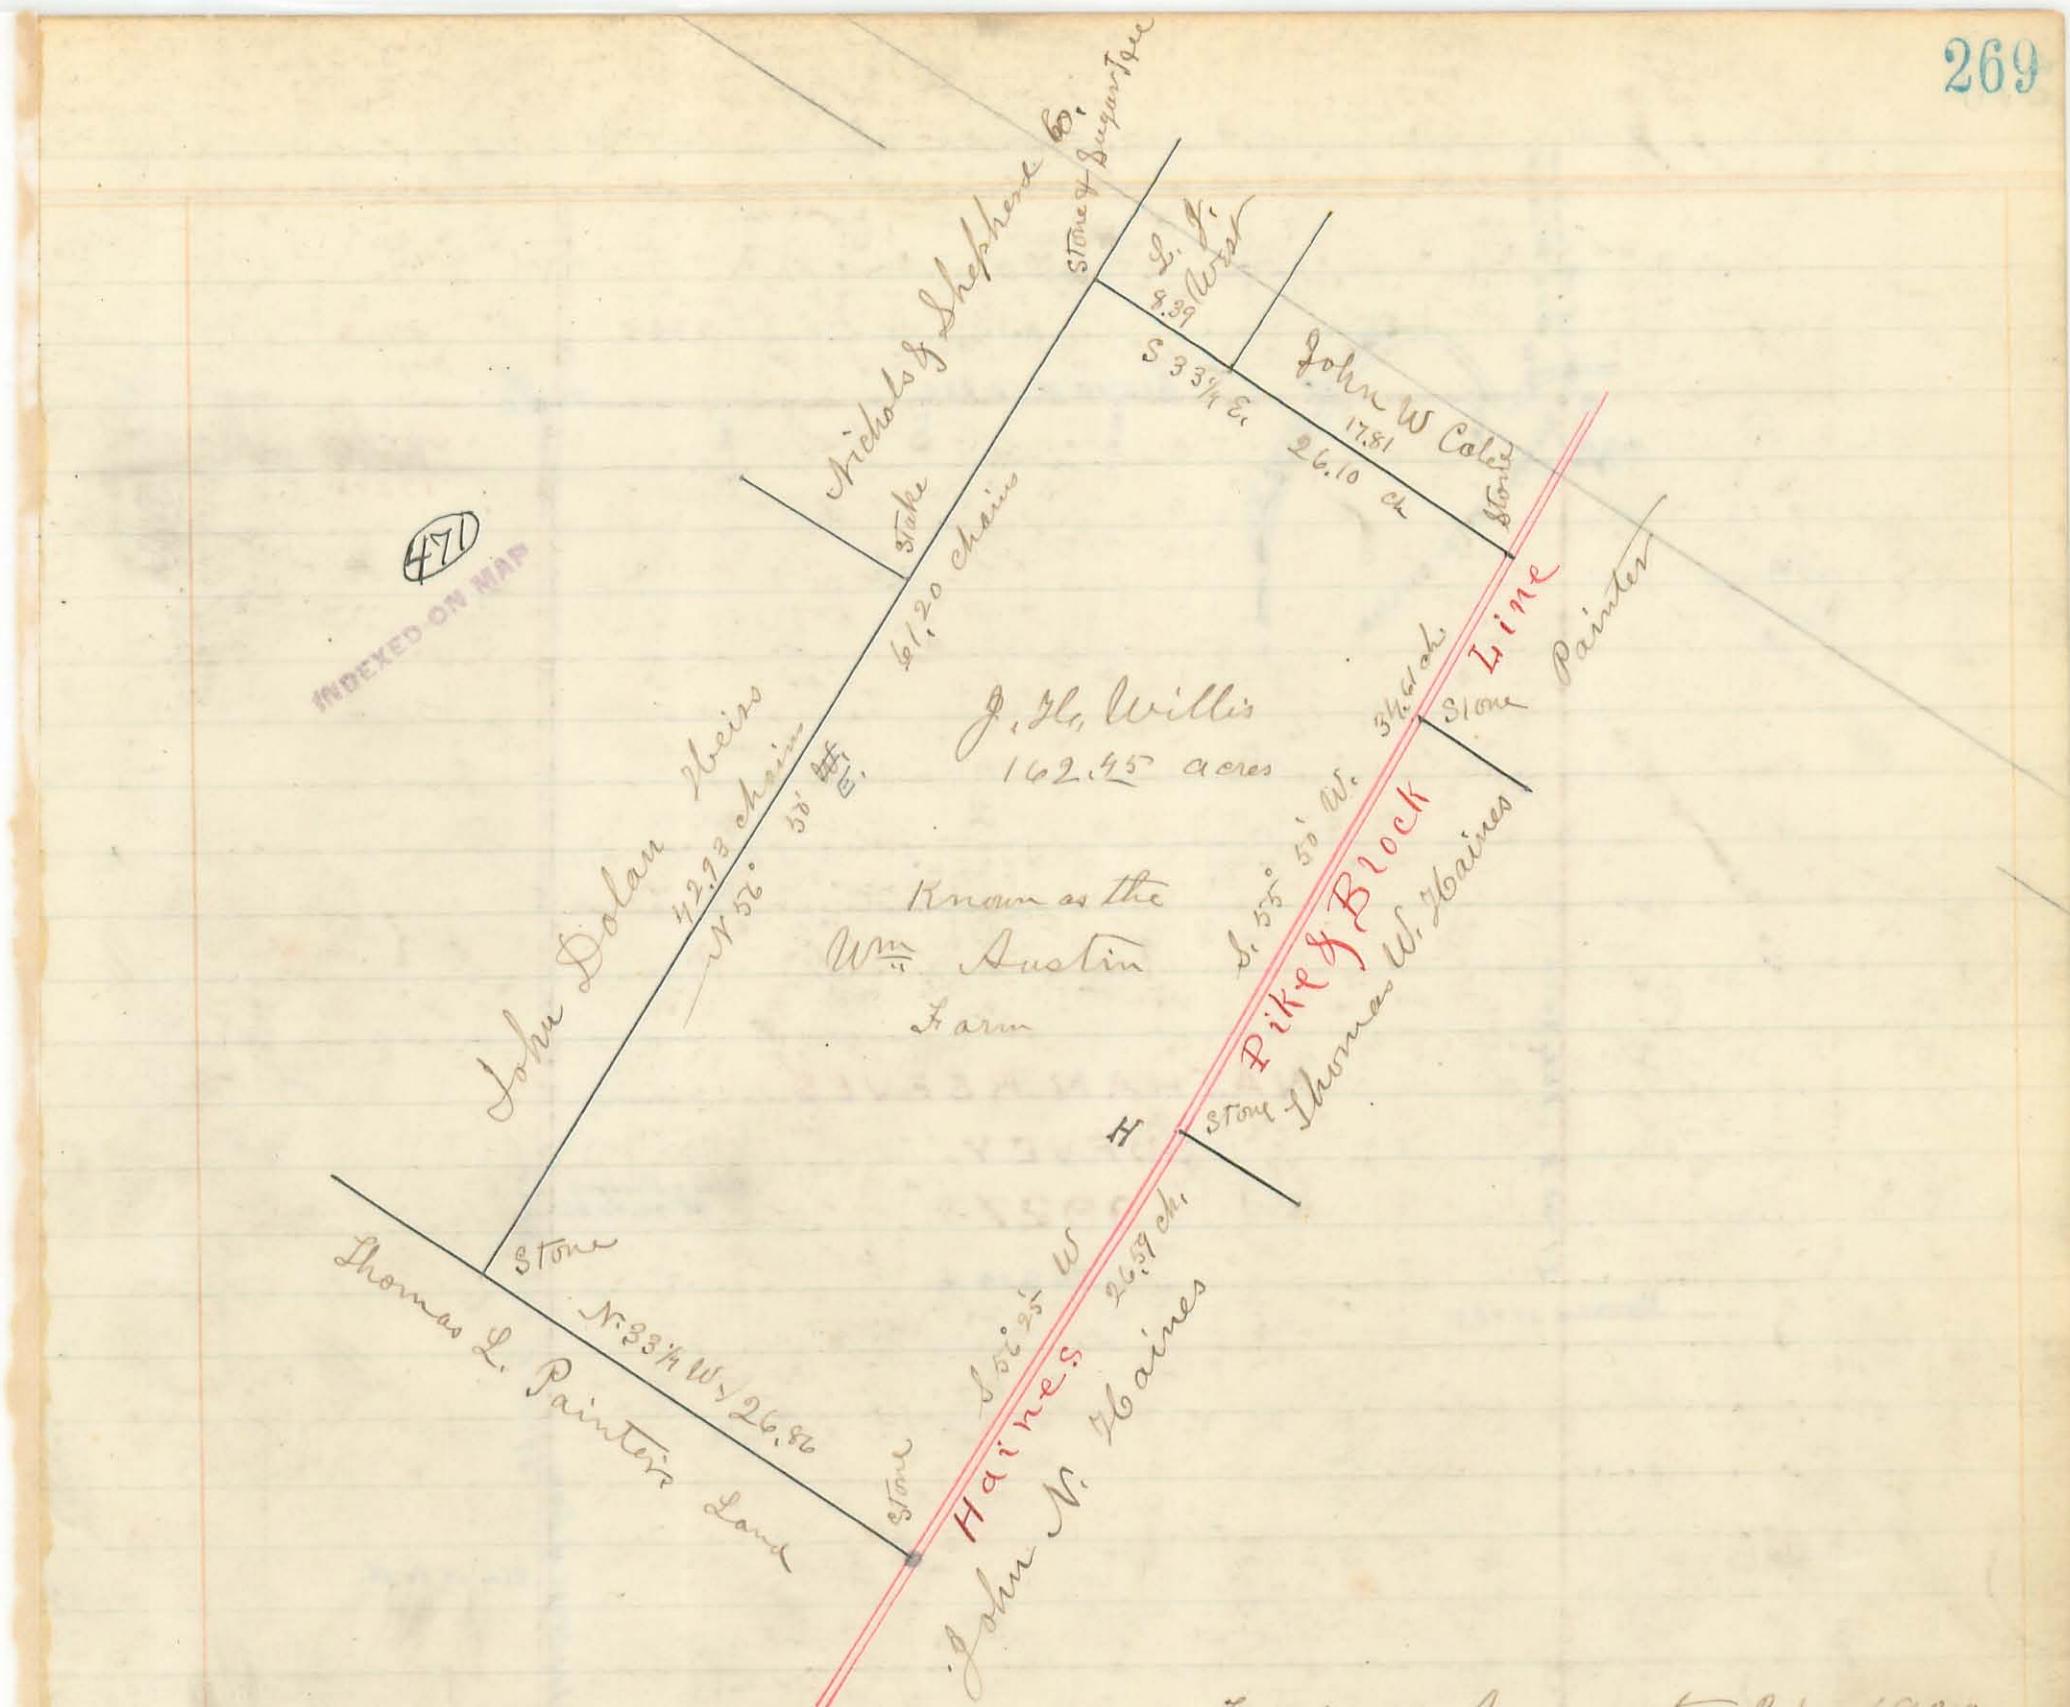


Friday August 24 1800

Surveyed for J. H. Willis the farm known as the "Wm Austin farm" being a part of O. V. M. Survey No 717, in Zane Township, Logan County, Ohio, as per the above Plot, Beginning at a stone at Thomas L. Painter's most eastern corner, in the Gaines pike, and the south east line of said Survey, thence with said Painter's N. E. line $N 33\frac{1}{4} W$, 26.86 chains to a stone at John Dolan's corner; thence with his line $N 55^{\circ} 45' E$, 61.20 chains, passing Dolan's eastern corner at $42^{\circ} 23'$ chains, to a stone between the roots and on the north side of a sugar tree three feet in diameter, thence $S. 33\frac{1}{4} E$, along the lines of L. J. West & John W. Coles lands 26.20 chains to the center of the Gaines Pike and in said Survey line, and there planted a stone in presence of John W. Cole, J. H. Willis, Wilber Reams, John Hudson, C. M. Hudson, Dolan West and others. thence with said Survey line and pike $S. 55^{\circ} 45' W$, 34.61 chains to a stone, corner between those W. Gaines & John N. Gaines; thence again with said Survey line and pike $S. 55^{\circ} 45' W$, 26.57 chains to the place of beginning, containing 162.45 acres. This Survey was made for the purpose of establishing the lines and corners, and obtaining the exact area of the said "Austin farm" for J. H. Willis.

John Hudson
Wilber Reams } C. M.

By H. C. Moore, Deputy Co. Surveyor
Wilber & Ginn Co. Surveyors
Logan Co. Ohio

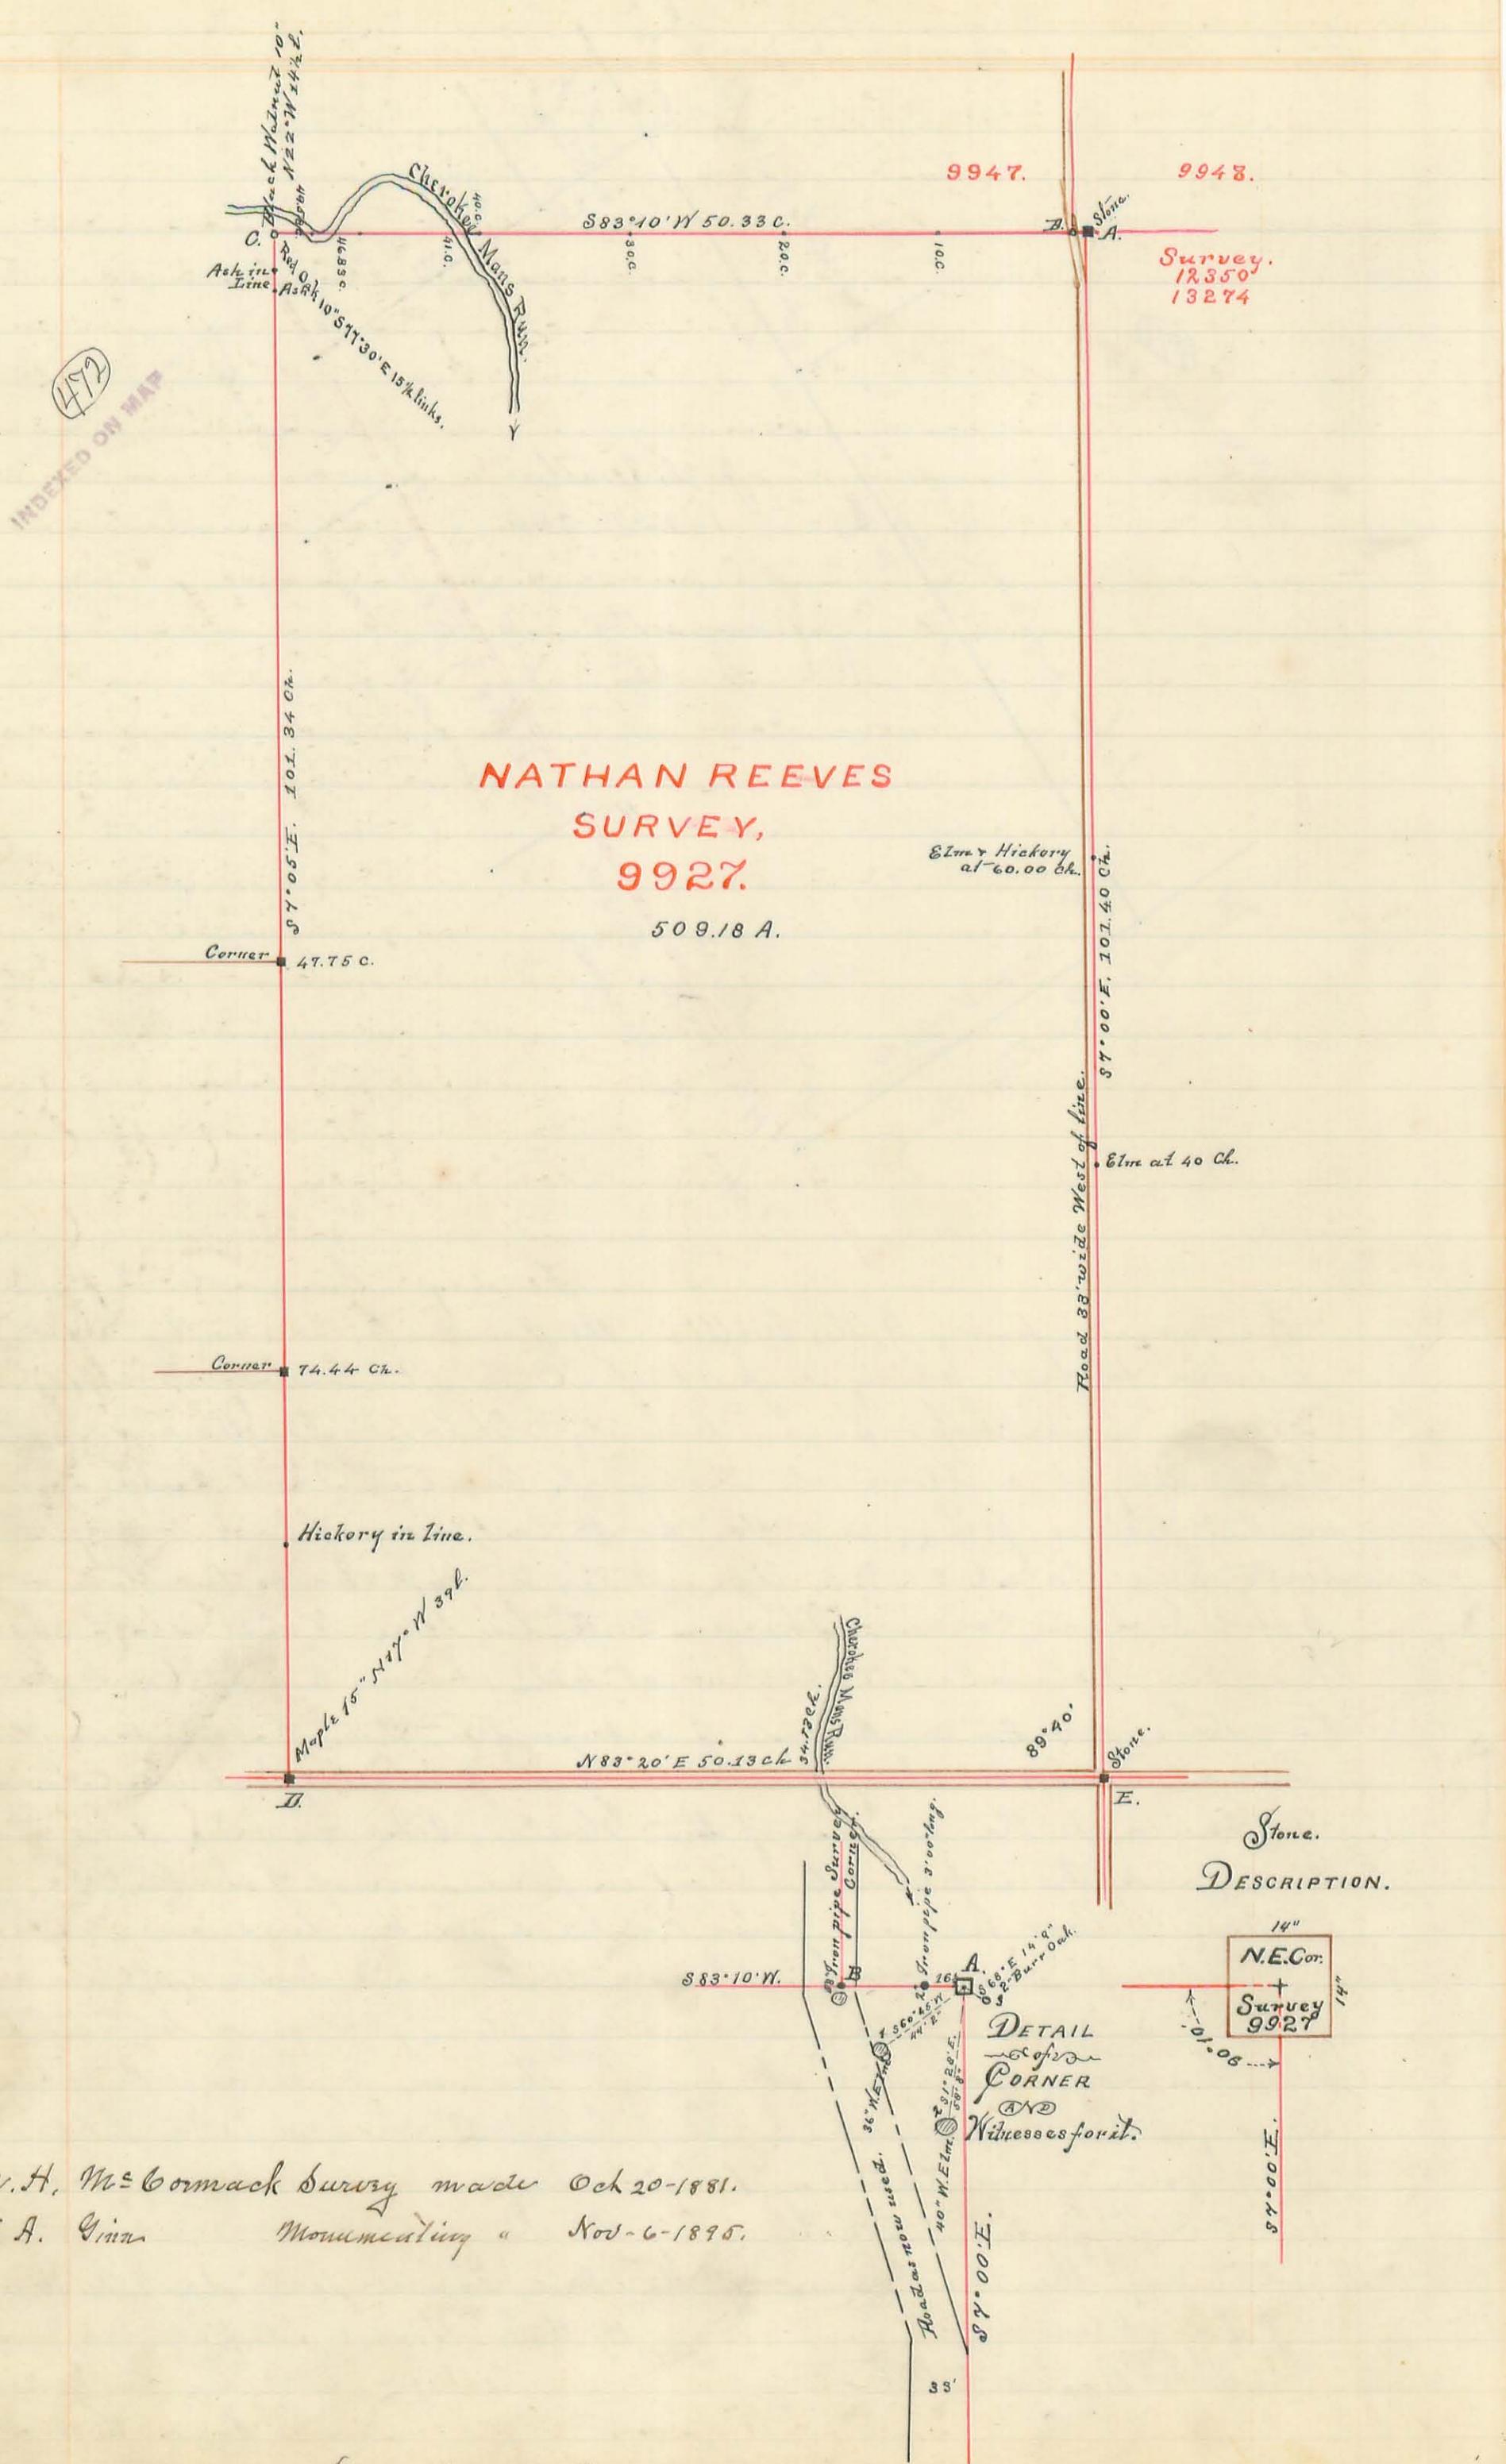

Bellefontaine Ohio November 26th 1895.

Office of County Surveyor.

I, the undersigned surveyor for the County of Logan,
State of Ohio, hereby certifies to the remonumenting & marking of the N.E. Cor.
of Nathan Reeves Survey 9927. The N.W. Corner of J. Galloway Survey 12350 and
13274. Also The survey corner between Geo Clark Survey 9948 S.W. corner. and
George Clark Survey 9947 S.E. corner.

N.E. Cor. V.M. § 9927

Description. On examination upon the ground I found the hickory named in
original Survey notes standing but dead. The black Oak dead, (now down)
almost decayed, a second hickory taken later, dead and decayed. after taking
the angles of the witnesses I made search for the corner and found 10 inches
under the surface a stake of Red Oak 12 inches of the point of which was well
preserved, measured 16 $\frac{1}{2}$ feet west and found stake as described in the
Road Survey, made to establish the Road on the west side of Survey line
9927. by S.A. Buchanan Co Surveyor.

Monumented the point first described with a Bellefontaine quarry lime
stone, 14 x 14 inches square on top and 30" deep planted about 1 foot
below the surface of the ground. Witnessed by (1) Water Elm 36 I.d. S $60^{\circ}45'W$
14 feet and 2 inches (No 2) Water Elm 40 I.d. S $1^{\circ}28'E$. 58 feet and 8 inches also by
(No 3) Burr Oak 2. I.d. S $68^{\circ}00'E$ 14 feet and 9 inches. Iron pipe on N. line 3 feet long.
1 $\frac{1}{2}$ inches in diameter. Run the East line of Survey 9927. from it I turned
the angle 90° 10' from E to C. and established corner between surveys 9947 & 9948
Eighty (80) links distant on line, A. C. Monumented with
an iron pipe fifty eight (58) inches long. witnessed by a
Water Elm 36 I.d. South two (2) feet and seven (7) inches
all measurements of witnesses are made to the centre of the three
notches.

A. B. S $83^{\circ}10'N$. 80 links passing iron pipe at 16 $\frac{1}{2}$ feet, and ending 2 ft 7 in
North of 36" Water Elm. Angle A.E. C. 90° 10'


A. C. S $83^{\circ}10'N$. 50.33 ch passing hickory 6 I.d. N 20° E at 10 ch Red Oak 12 I.d.
S. 12° E at 20.64 ch. Ironwood 6 I.d. S 36 links at 30 ch. Sycamore
line tree at 33.93 ch. Pignut hickory 14 I.d. S 16 links at 40 ch
crossing Cherokee Mans Run at 41 chains. Entering the run
at 46.83 ch and leaving it at about 49.70 ch thence to corner
With Red Oak 10 I.d. S $77^{\circ}30'E$ 15 $\frac{1}{2}$ links and a black walnut 10
I.d. N 22° W 14 $\frac{1}{2}$ links. The original corner 2 buckeyes and
small ash in run. Thence S $7^{\circ}05'E$ 101.34 ch. passing

line tree 1 $\frac{1}{2}$. 2 $\frac{1}{2}$. & 89 ch. passing other corners 1 at 47.75 ch 1 at
74.44 ch. Thence to corner at 101.34 ch. This Witnessed by Maples
I.d. N 17° W 39 ch. Original corner Swamp Ash, thence with road

D.E. N 83° 20' E 50.13 ch to a stone corner, crossing same run as
E.A. before described at 34.13 ch. Thence N 7° 00' W 101.40 ch passing
elm line tree at 40 ch Elm & Hickory at 60 ch to the N.E. cor.
and place of beginning. The above Survey made by M.H.
McBroomack Co Surveyor Logan Co. O. for the N.E. corner as
described, monumented and witnessed by me in the
presence of Thomas Dunn, David Hughes, G.C. Morris
Ezra Kulow, W^m Antum, Wilbur Johnson Co Surveyor.

The original of this page is blank or missing.

(473) INDEXED ON MAP
Part of
Survey 1892
Bell Central, Logan Co., Ohio

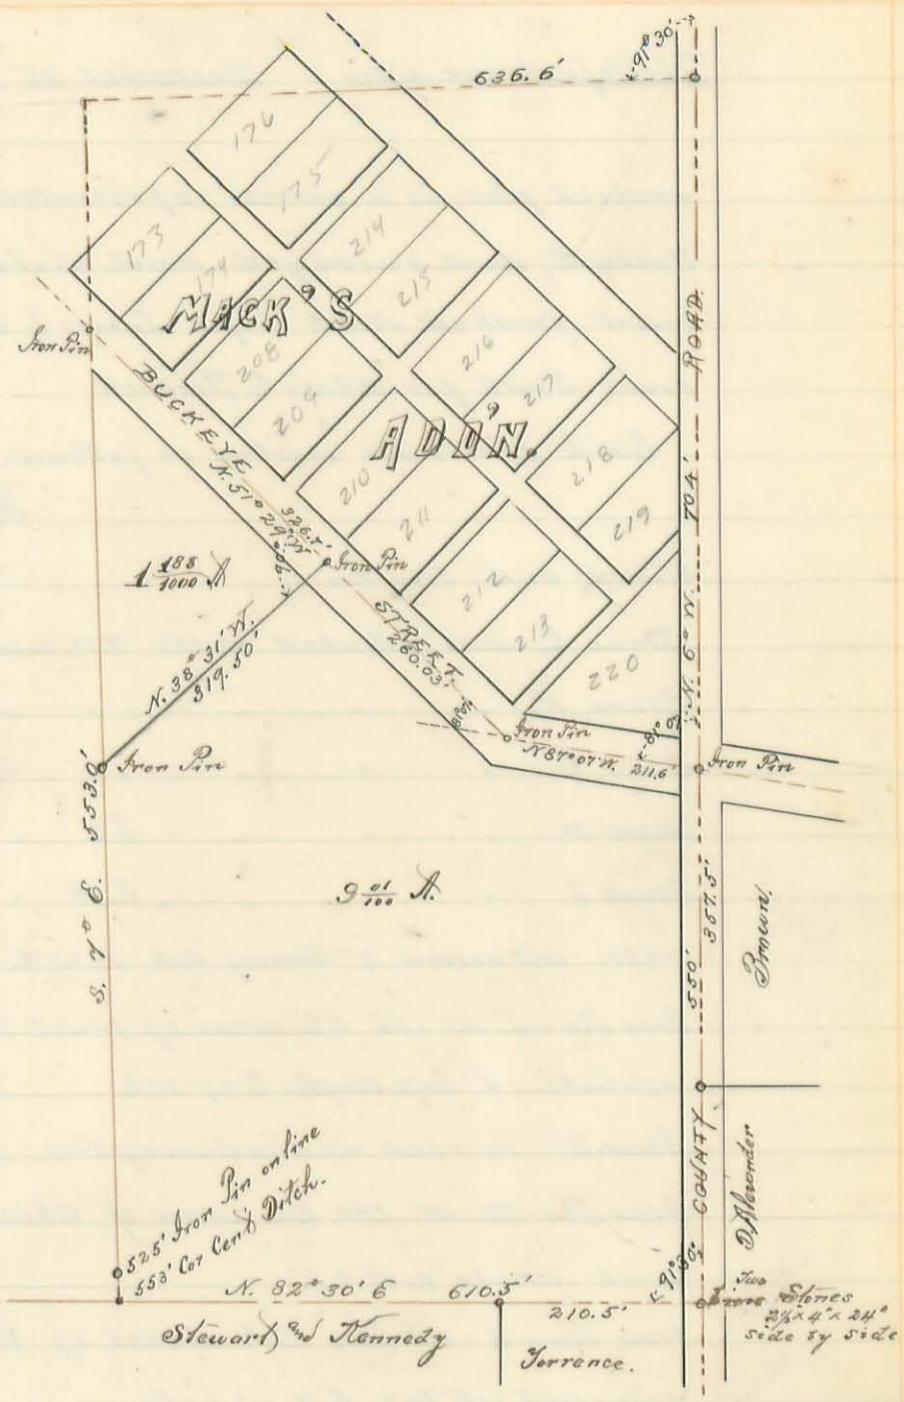

Bellefontaine, O. Co. Surveyor's Office 1898.

The above is a correct representation of a parcel of land as surveyed by me and monumented as shown on above plat.
 Wilcox & Ginn
 Co. Surveyors

Bellefontaine Ohio : December 11th 1899.

I, the undersigned Surveyor, do certify that the annexed plat is a correct representation of a tract of land, formerly belonging to Isaac Roebuck, and surveyed and divided into three equal tracts of 55.05 acres each: the tract farthest North is for James L. Roebuck, the center tract for William D. Roebuck and the tract South for Abner G. Roebuck.

Said tracts are marked as follows:

Stone C. was planted by me and placed in line with Stone B,
Stone P, and Iron Pin O.

Stone E. was planted at the S.W. corner of the N. tract.

Stone F. " " " " " Center "

Stone G. " " " " " S. " and in Survey Line.

Stone H. " " " S.E. " of Survey 9987 & the S.W. corner of 9988.

Stone I. " " " S.W. " short strip of land lying south of 9988 and in Survey
9971. witnessed 8" Swamp Ash N. 27° E. 26 links; 10" Hickory S.E. 23 1/4 links.

Iron Pin J. at the S.E. corner of tract 16 South and in County Road; witness 5" Soft Maple N. 73° 30' E.
47 1/2 links; 5" Soft Maple S. 77° 30' E.

Stone K. in road and in Survey Line - in line with Stones G, H, and I.

Iron Pin M. at the N.E. corner of Abner Roebuck's land; S.E. corner of Wm Roebuck's land & in line
with points O, N, & K.

Iron Pin N. at the N.E. corner of Wm Roebuck's land and S.E. corner of Jas. L. Roebuck's land.
witnessed 15" Oak S.W. 117 links.

Iron Pin O. at the N.E. corner of Jas. L. Roebuck's Land and S.E. corner of Marion King's Land.
and in line with points B, C & P.

Stone P. in line with points O, C & B. and in Survey Line between Surveys 9987 and 9986.

Wilbur A. Ginn,

County Surveyor.

Nat. Roebuck. } Chairman.
Clarence Watson. }

Clarence Miller, } Marker & Flagman.

9971 10.94 a.

9987 100.00 a.

9988 55.98 a.

16670

474

INDEXED ON MAP

Stone, A.

Survey and Division of the Isaac Roebuck Land.inRickland Township, Logan County Ohio.December, 1899.