

Surveyed for
Heirs of Simon K. Miller

10122
Part of Survey 10248
10249

McArthur Township

Oct. 2nd Nov. 1906

(150)
INDEXED ON MAP
see Note Book 57
Page 38

J.K. Miller

A. Murk

W.D. Dring

I. Fullerton

W.H. Plumb

J.G. Wall (Church)



40 scale

Compared


Surveyed for
W. J. Orr

Being W 1/2 of S 1/2 of Subdivision No.
20, of Survey No. 4990.

Bellefontaine, Ohio

May 21, 1907

(152)
INDEXED ON MAP

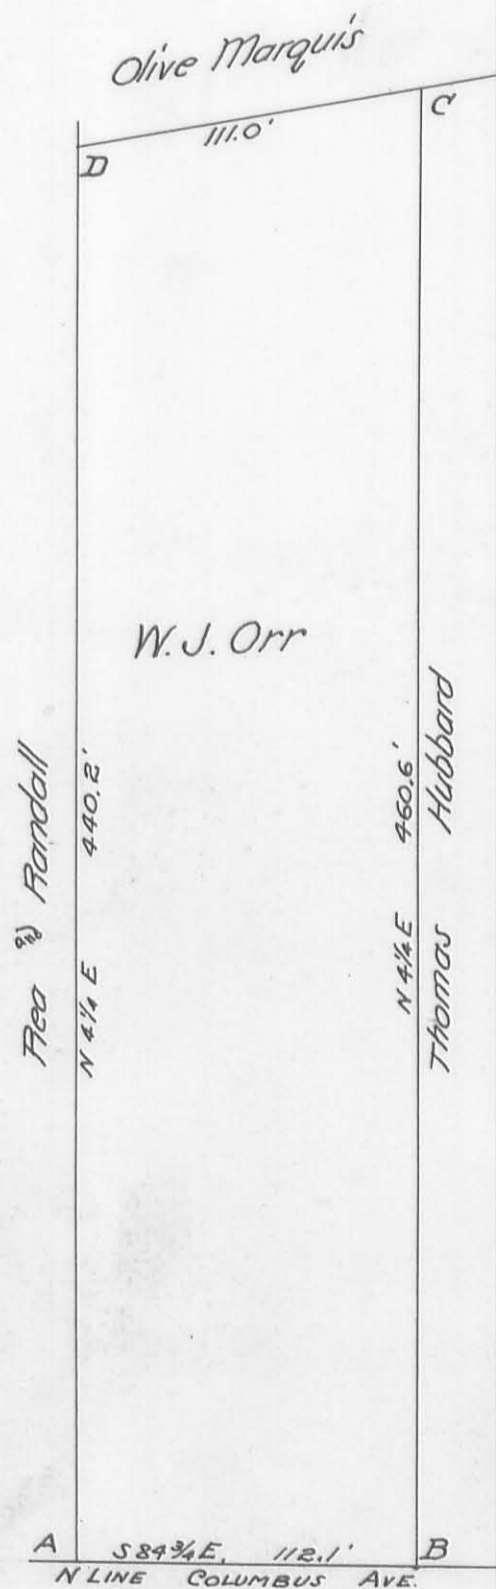

- Description of Corners -

- A. Stone at S.E. corner of Rea & Randall's tract. Set by H. C. Moore
Wit: - Sugar, 7", north 3.55'; Ash, 10" N. of E. 22.2'
White Oak, 21", W. of N - 9.4'
- B. Stake at S.W. corner of Thos. Hubbard's tract, Set by J. C. Wonders. Planted sandstone 4" x 4" x 18"
Wit: - Red Oak 24", N. of W. - 11.0'
White Oak, 21", W. of N - 9.4'
- C. Stake set from old wit:
New wit: - Apple, 7" east 22.3'
Apple, 8" N.W. 12.2'
- D. Stake at S.W. corner of Olive Marquis tract.


Compared

Surveyed for
J. W. Harmon

Pt. S.W. Qr. Section 34, Town 4, Range 14
Lake Township

Apr. 10, 1907.

(151)

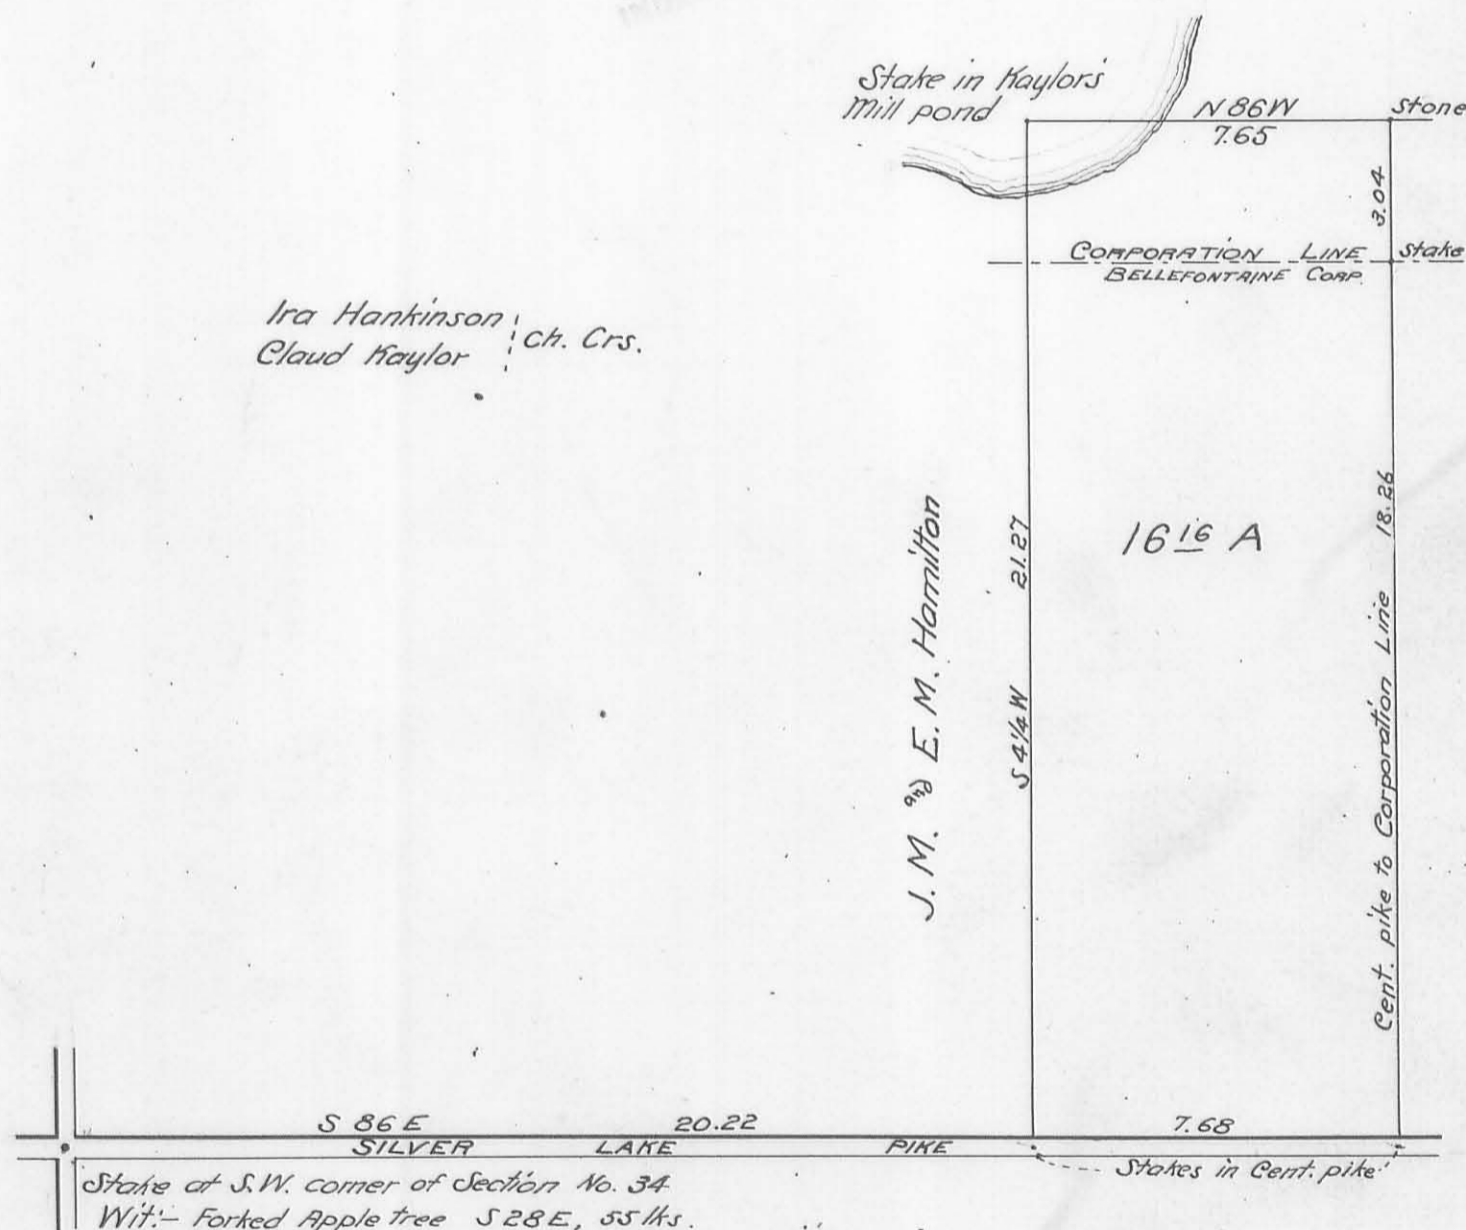


Surveyed for
R. T. Short et-al

Pt. of Survey { 4493
4525

Monroe Township
L. C. O.

Nov. 8th & 14, 1907

O. S. Fultz
Henry A. Grimes ch. crs.

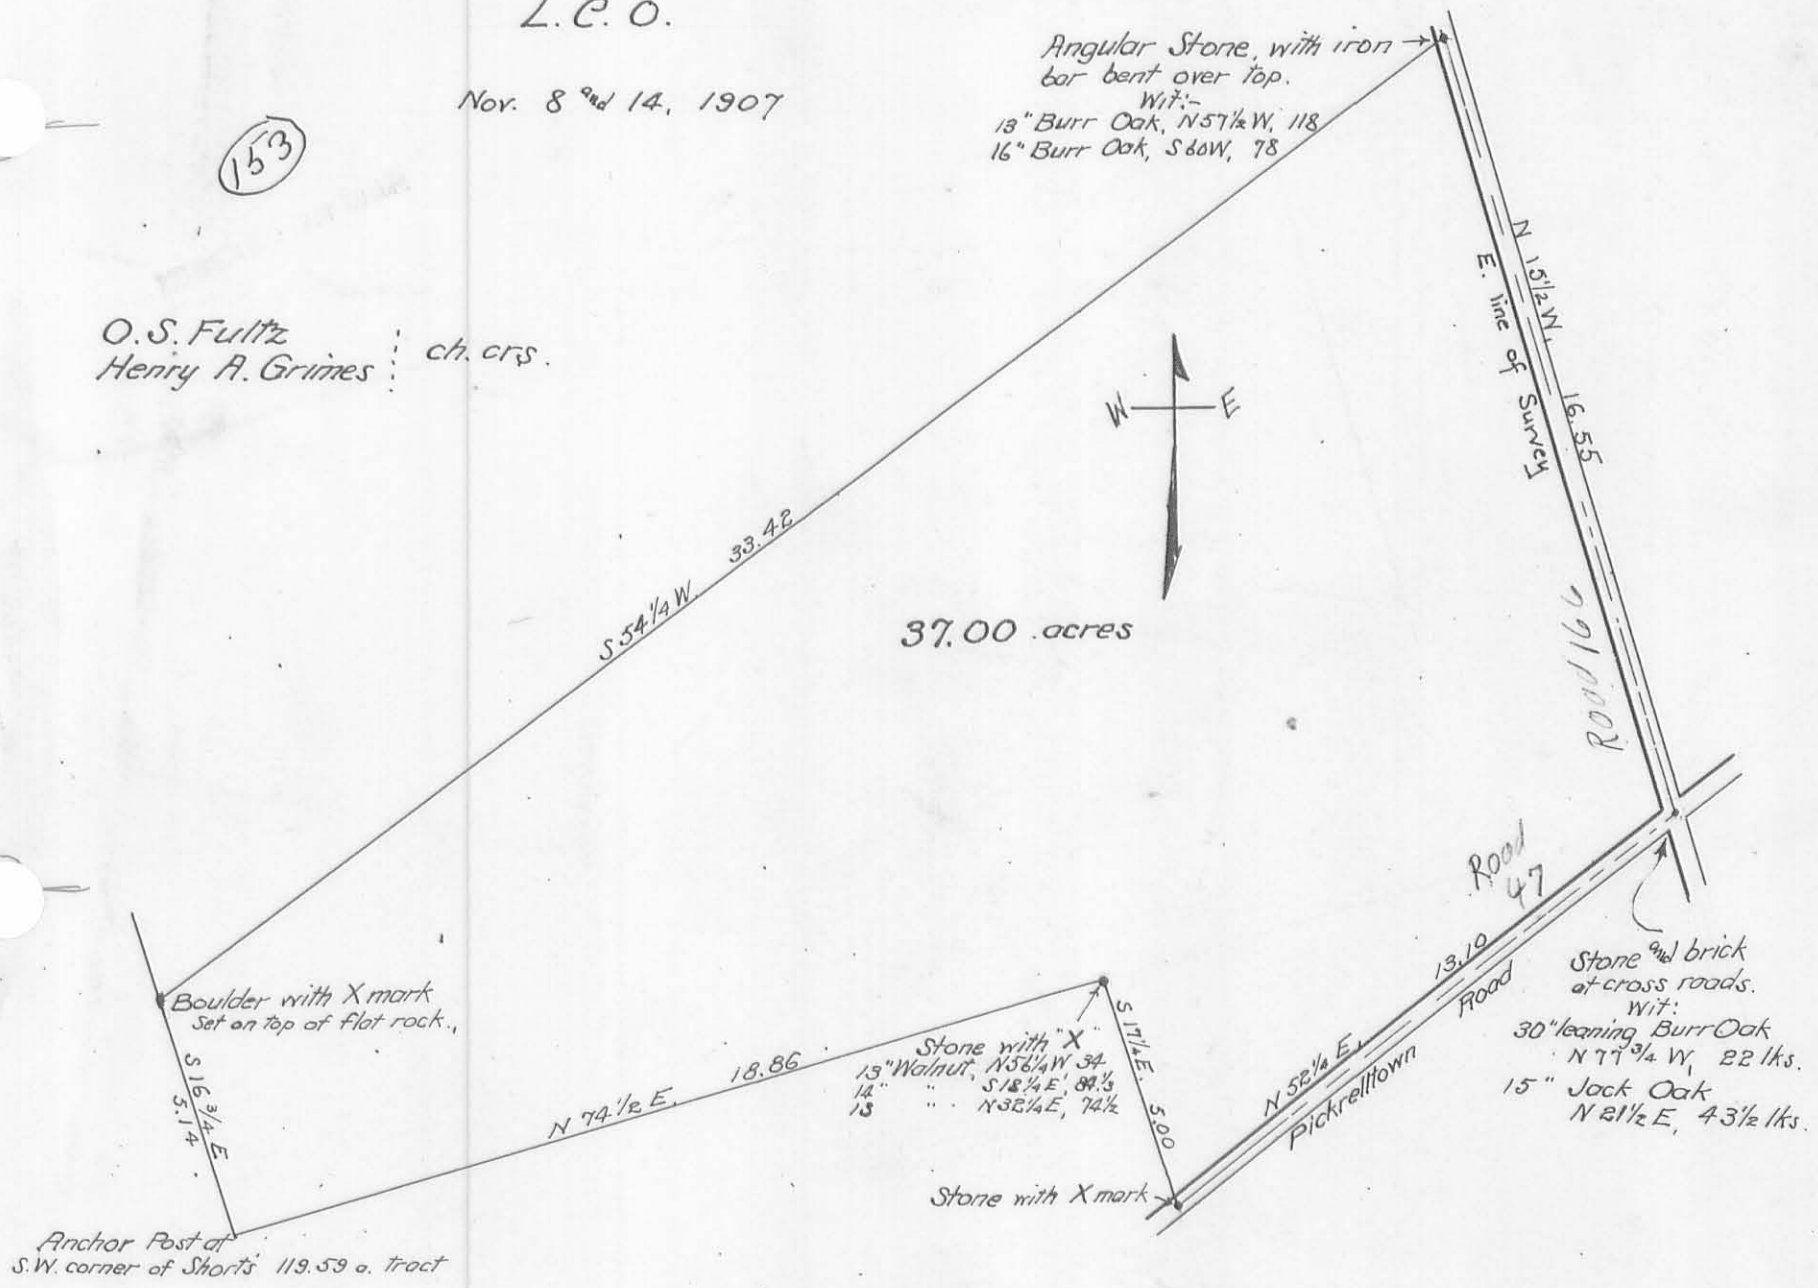

Surveyed for
Mrs. Adelaide Hadley

Pt. of survey 4957


Monroe & Jefferson Townships

July 12, 1907

154

INDEXED ON MAP

Oliver C. Fitchey
Wilson Drumm ch. crs.

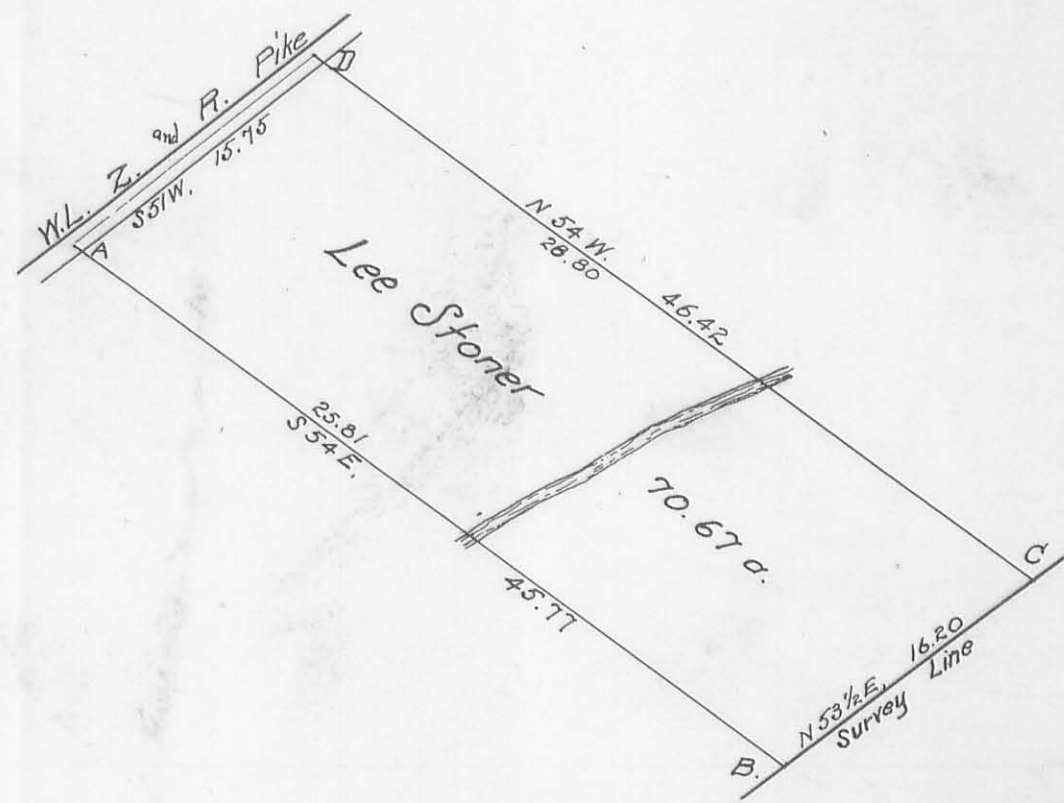

— Description of Corners —

- A. Quarry stone & 3 bricks in center of pike
Wit:- 36" Walnut (line tree) S 54 E, 45 1/2 links
28" Walnut, S 86 1/2 E, 119 links.
- B. Stone in Survey Line
- C. Post. Wit:-
24" Beech, N 57 W, 40 links
15" Ash, N 36 E, 83 links
- D. Sandstone & 3 bricks in center of pike

Field Notes Book 55 Pages 18-19-20


Surveyed for —
Heirs of Robert Smith

Pt. surveys 6516 and 4479

Monroe Township

Mich. 15th 23, 1907

(155)
INDEXED ON MAP

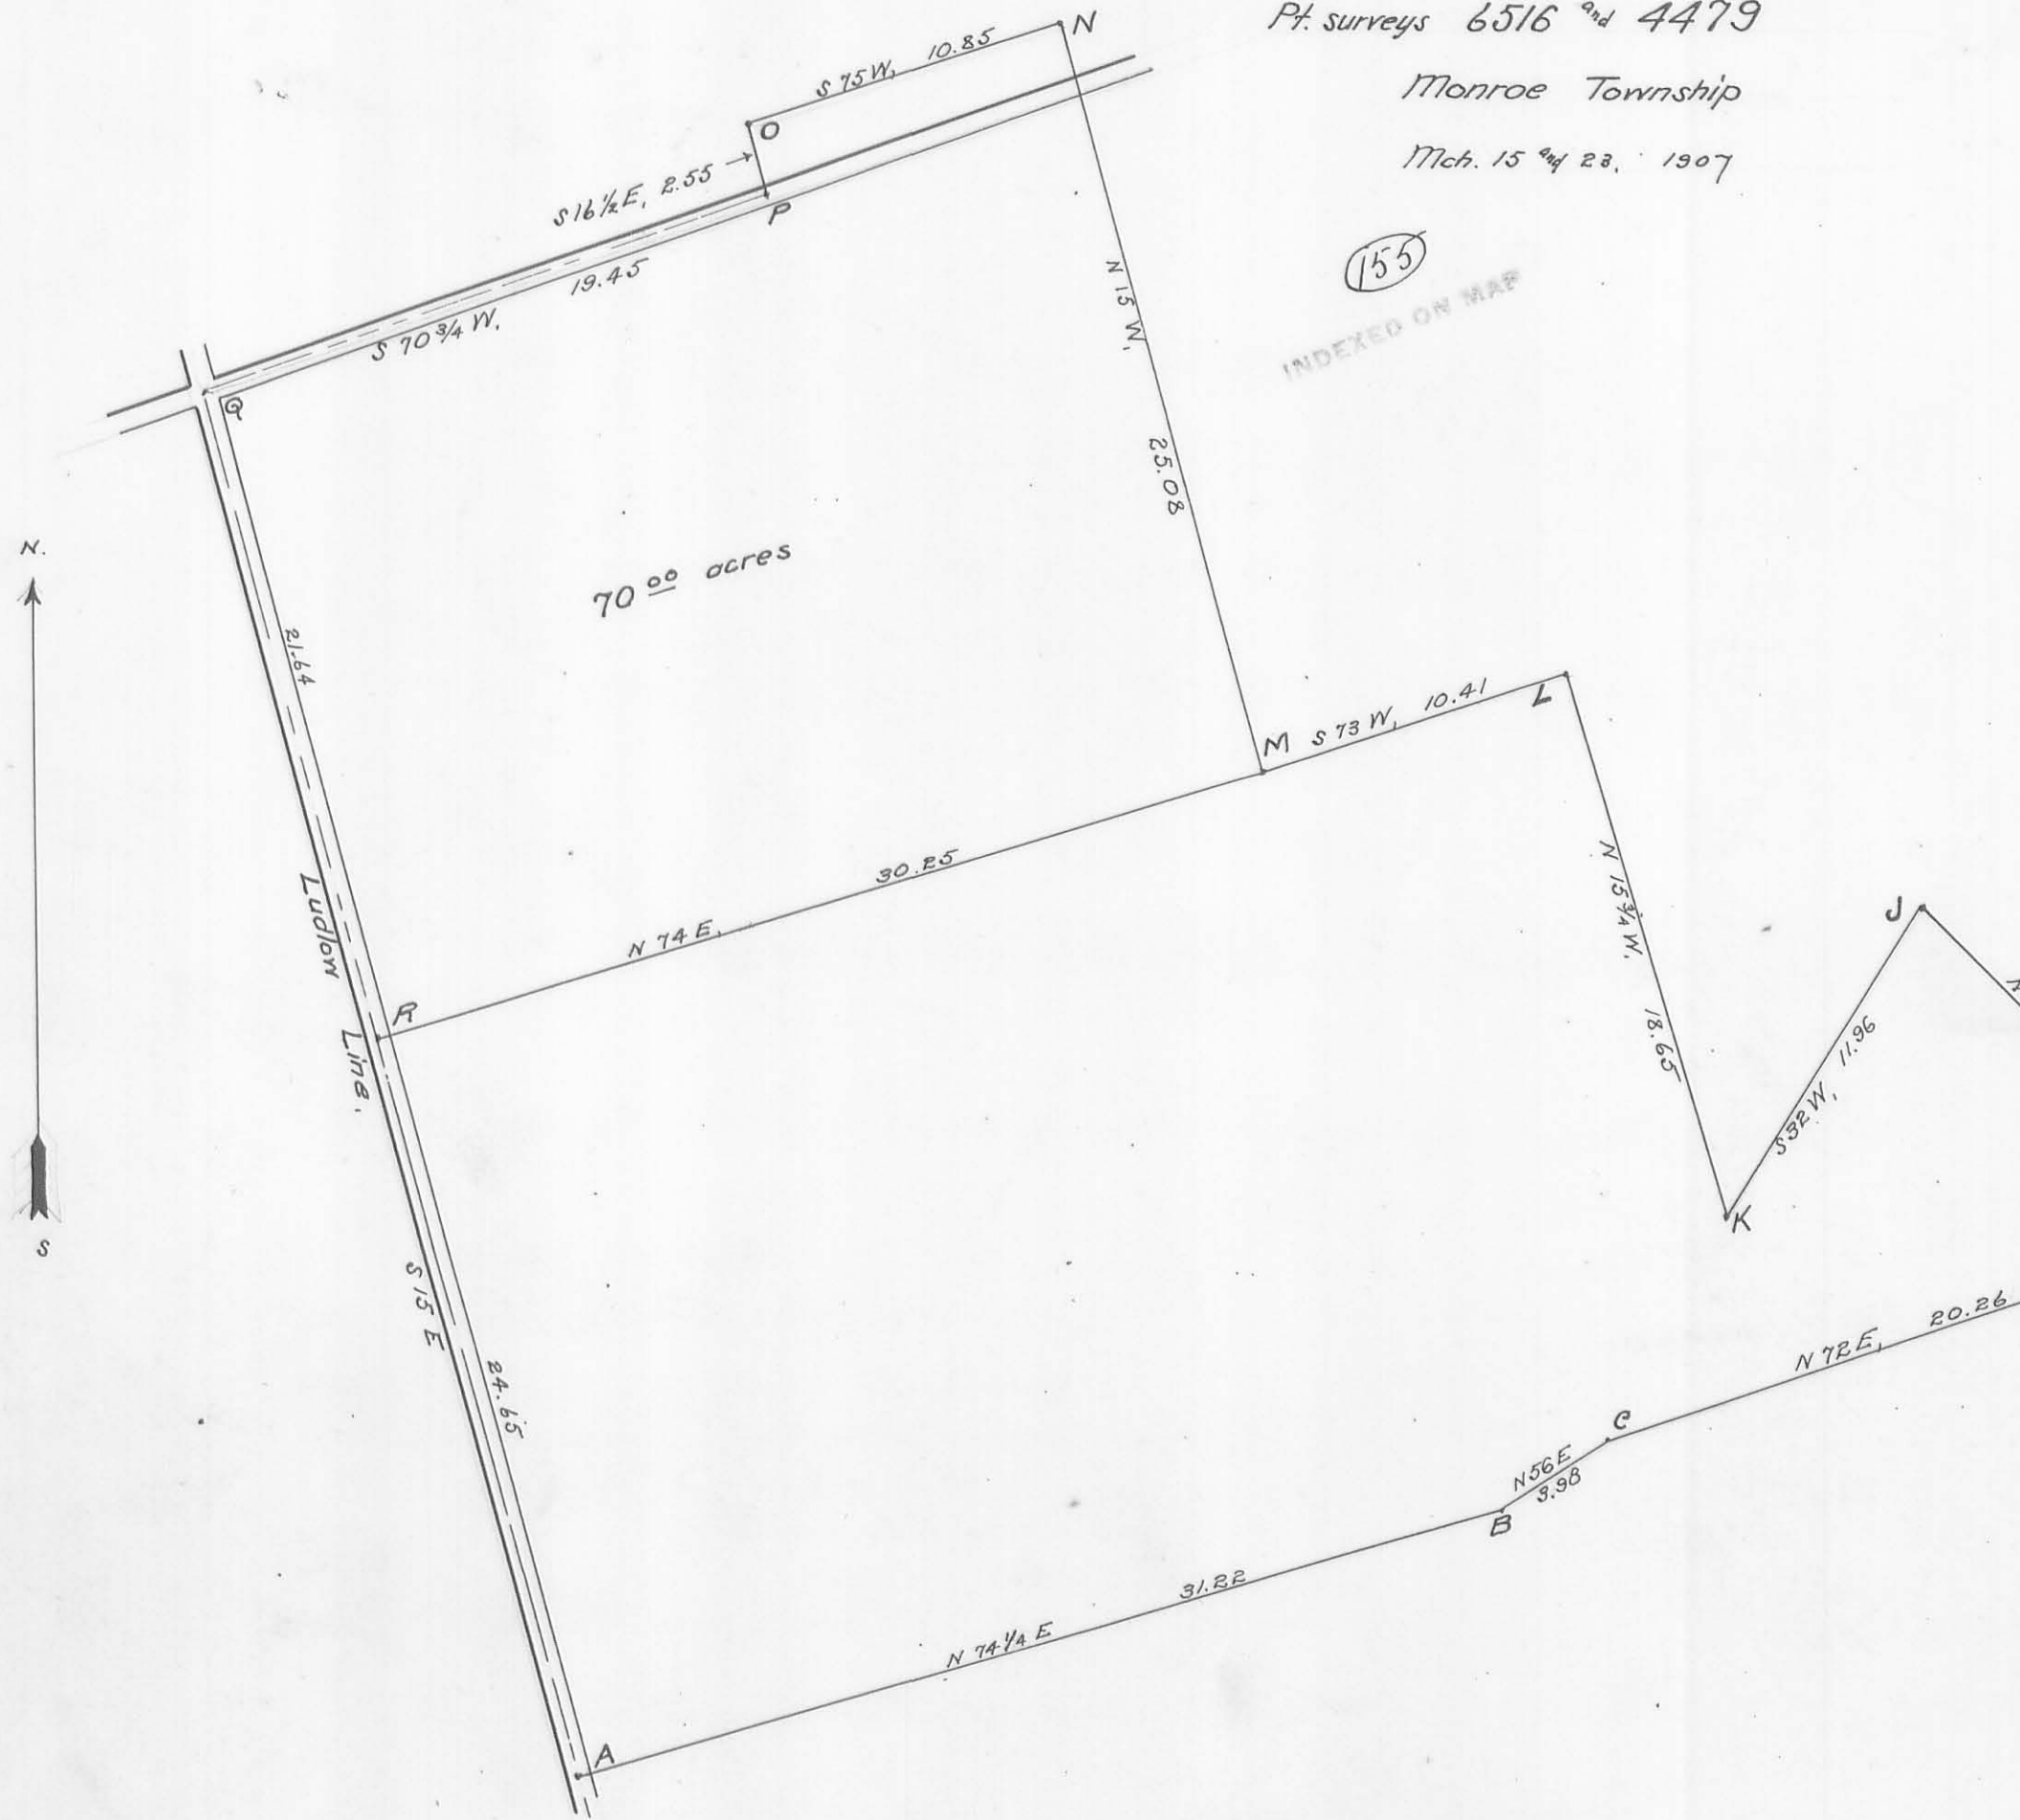

— Description of Corners —

- A, Large stone in Ludlow Line, S.W. cor. Surv. 6516
- B, Stake
- C, Stone at N.E. cor. lands formerly owned by Donn Platt.
- D, Stone, E. Stone
- F, and G, Stones at E. side Mochocsee Creek
- H, Stone I. Stone
- J, Stone, N. line of Survey 4479
- Wit: Large White Oak (orig. line tree) S 32 W, 117 links
- K, Stone, Wit: 24" White Oak, S 3 W, 5 links
- L, Stone, Wit: 15" Hickory, S 27 E, 4 1/2 links
- M, Stake, at 3 large White Oaks
- N, Large boulder, in N. line of Survey, planted in decayed stump, orig. cor. tree
- O, Stone
- P, Stone in road
- Q, Stake in center of road and Ludlow Line
- R, Stone.

D. to E,	N 43 1/2 E,	2.79
E. to F,	N 80 1/2 E,	3.98
F. to G,	N 9 E,	.66
G. to H,	S 78 1/2 W,	4.27
H. to I,	S 43 3/4 W,	1.67

Courtesy

— Plat —


Sarah E. Knepper Surv.

in Surv. 10041

May 14, 07

156

INDEXED ON MAP

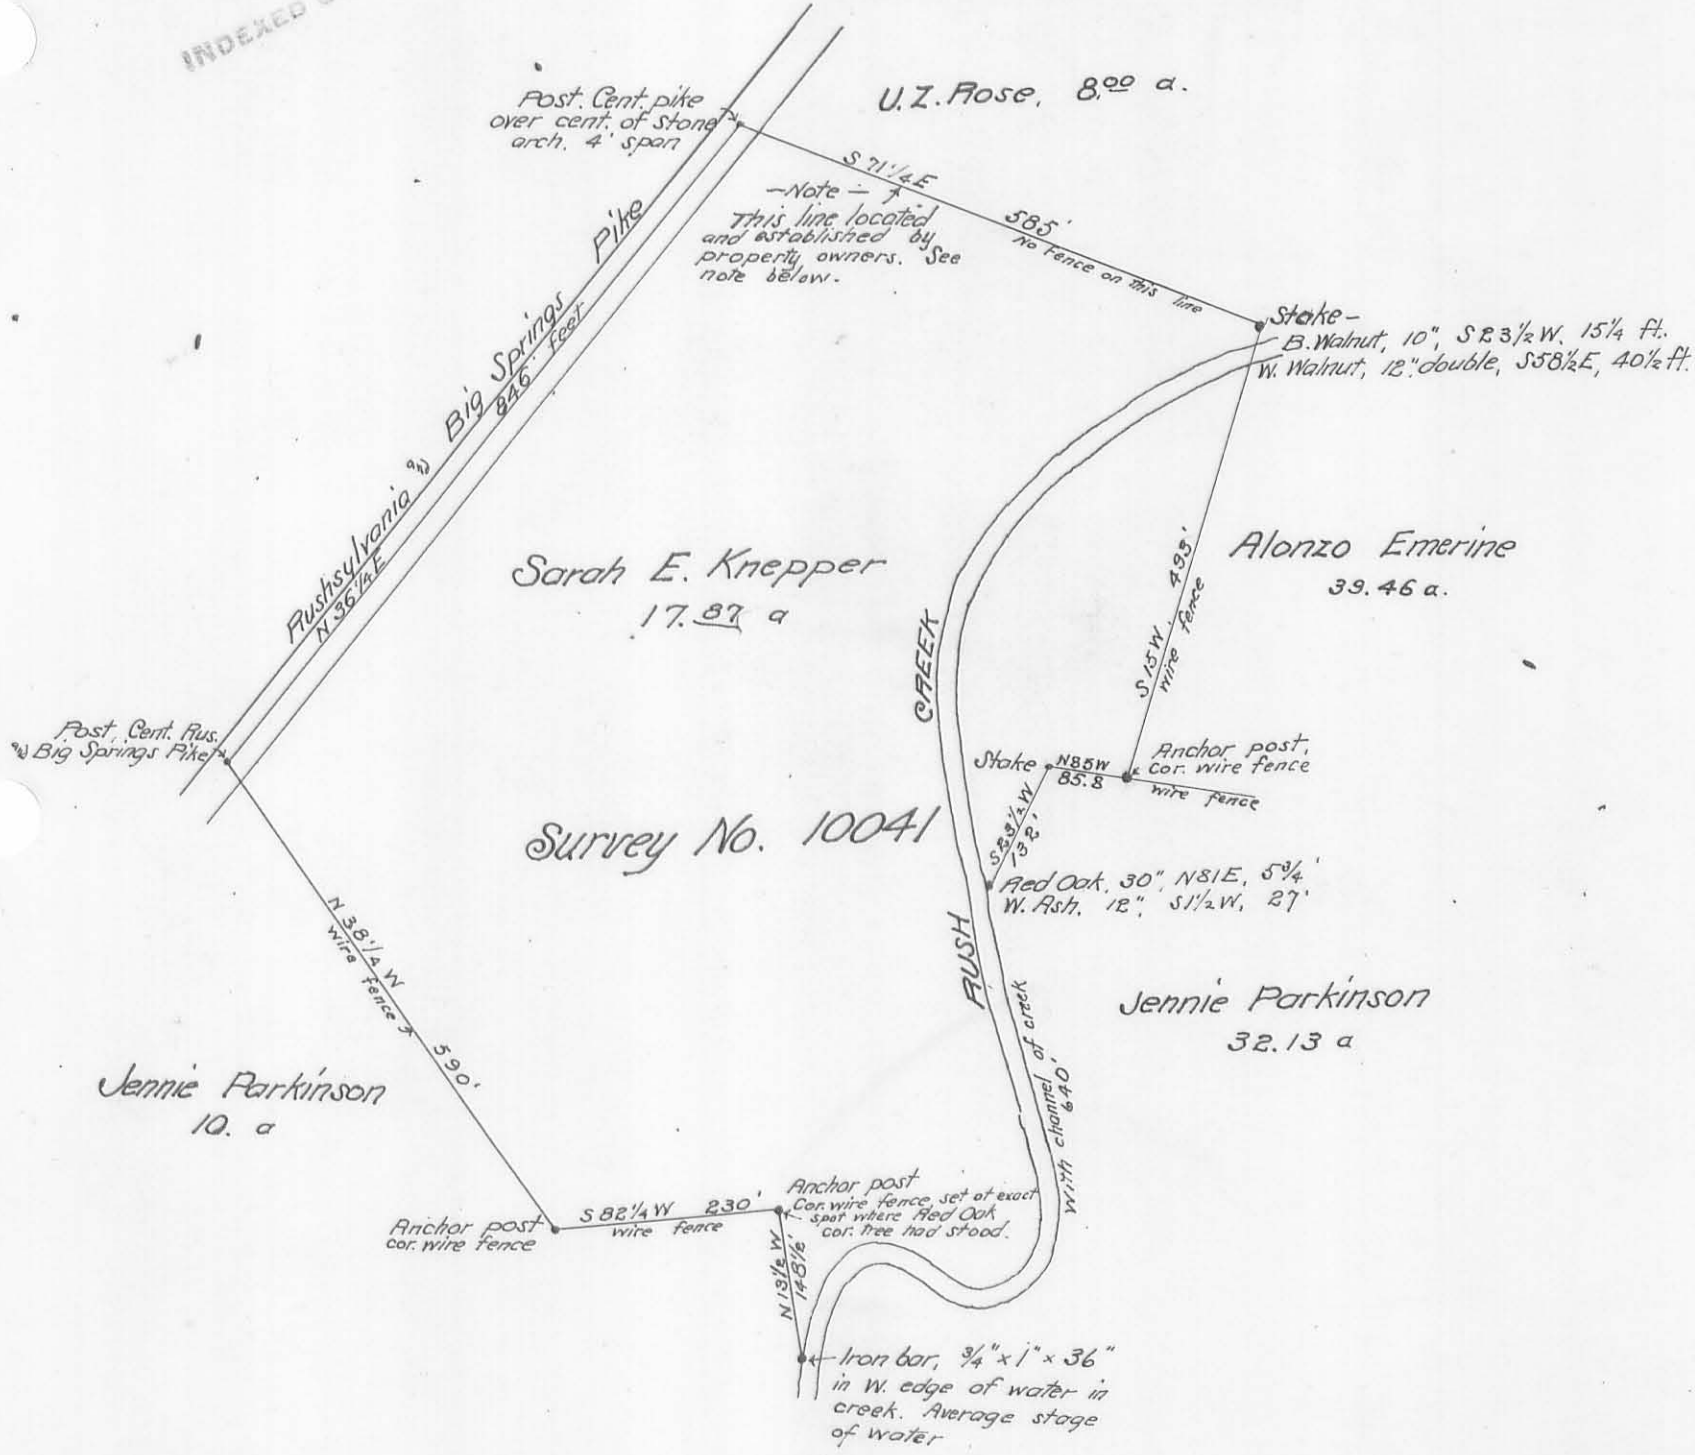

Note - The line between the lands of Sarah E. Knepper and U.Z. Rose, located and established this day by U.Z. Rose and Dr. A.V. Knepper, authorized agent for said Sarah E. Knepper.

May 14, 1907.
S.A. Buchanan,
Surveyor.

not Compared

Surveyed for -
Chas. A. Stephenson


Pt. Survey 3317

Lake Township

July 18, 1907

157

INDEXED ON MAP

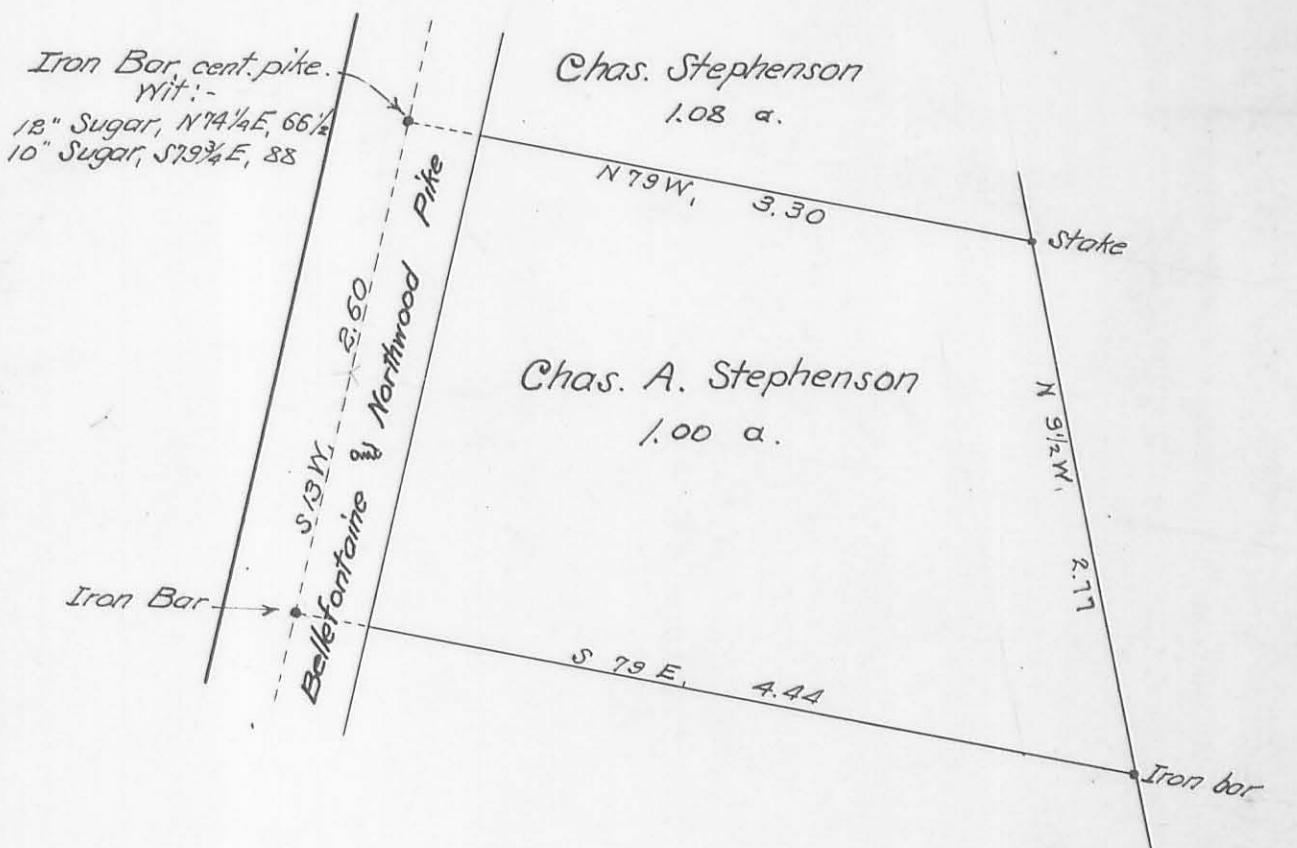

Field Notes Book 55 Page 22
H.S. Dalkey surveyor.


not compared
Field Book 55

Surveyed for
Eber Hodge

To locate line between Hodge & Sherer

Pt. of Sec. 27, T.2.R.8, Bloomfield Township

May 4, 1907

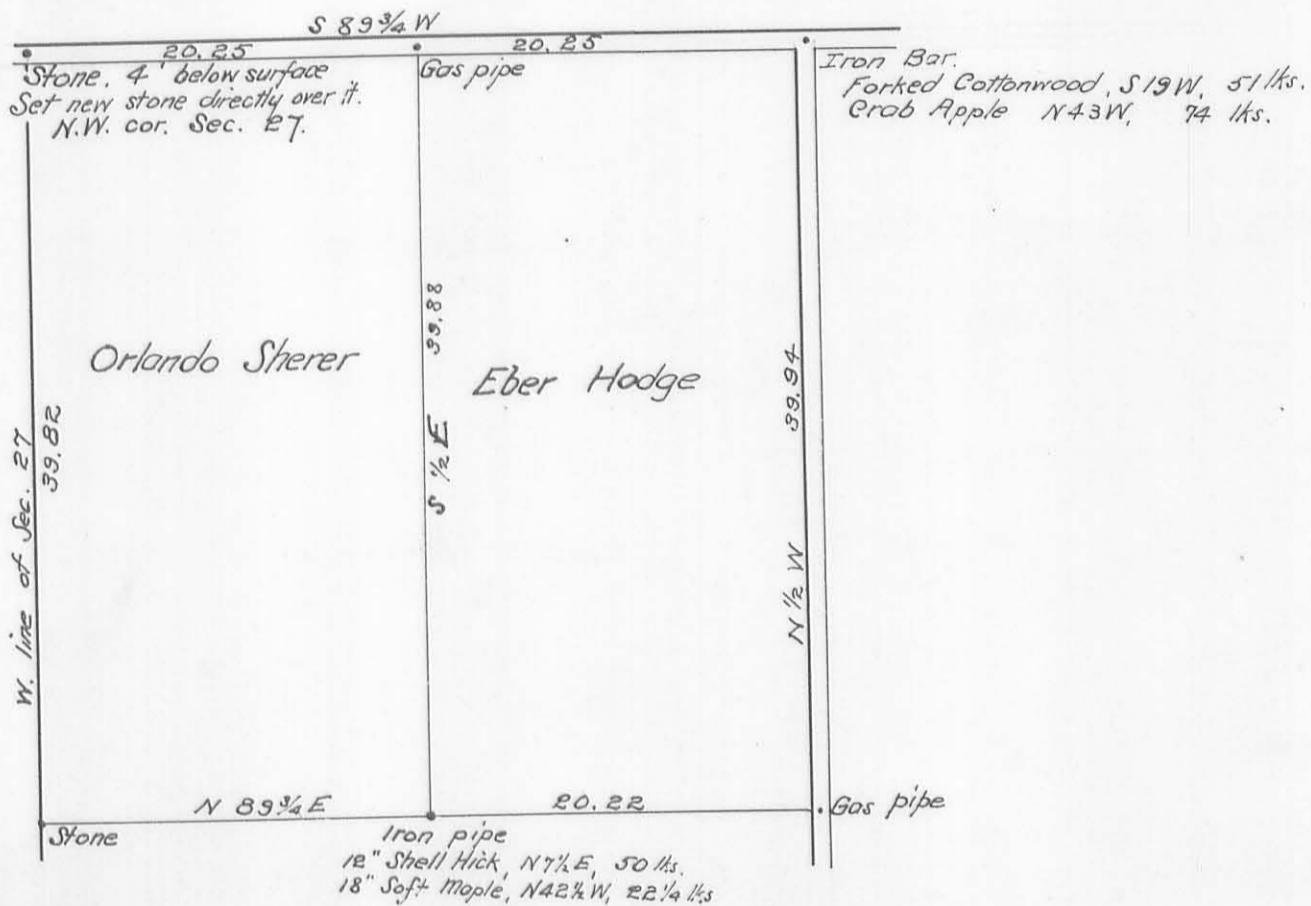

Field notes Book 55
Pages 6 To 7

confirmed

Surveyed for
C.M. Faulkner & F. Taylor


Pt. Sec. 29, T.6. R.8

Stokes Township

April, 1907

See Drawer R


1130 # 1011

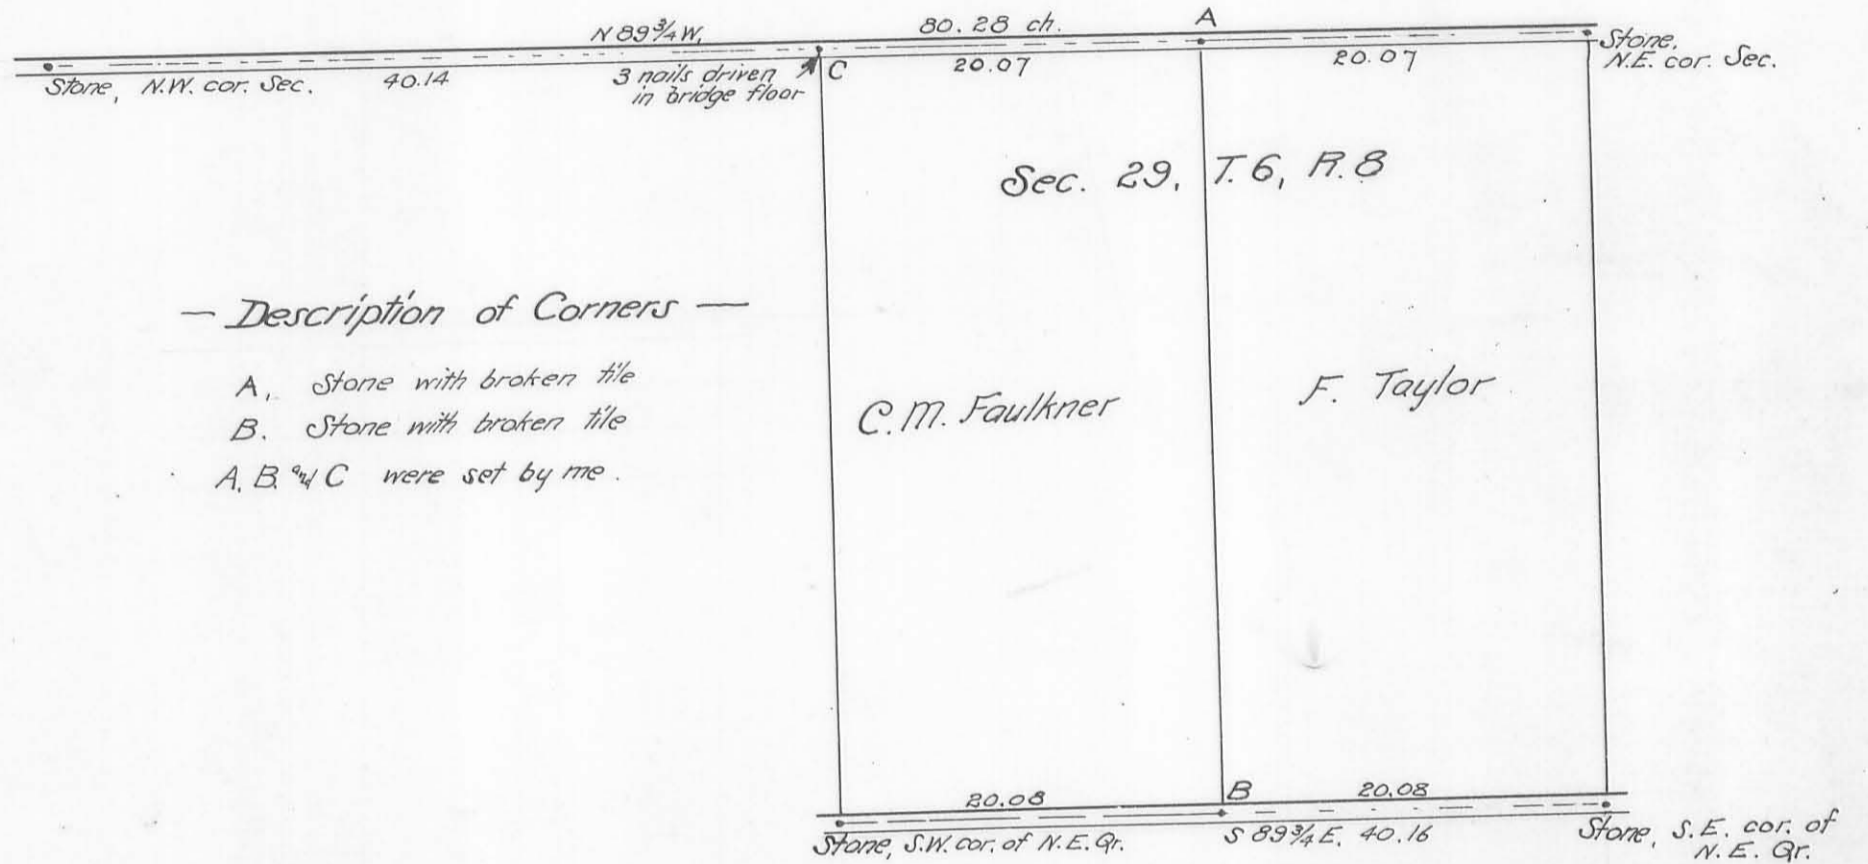

- Description of Corners -

- A. Stone with broken tile
- B. Stone with broken tile
- A, B & C were set by me.

Detail of C

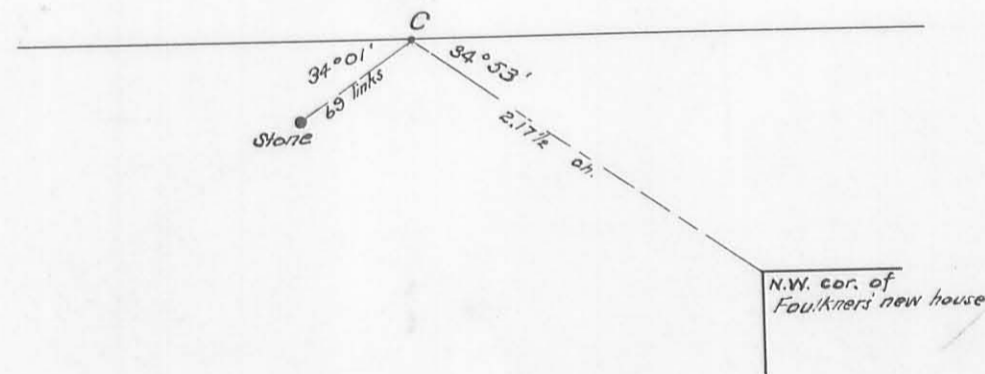

159


INDEXED ON MAP

Charles M. Richey
County Surveyor

Surveyed for
 W. H. Longbrake & James Hogan

Pt. Sec. 29, T. 7, R. 8
 Bloomfield Township
 Feb. 25, 1907

(160)

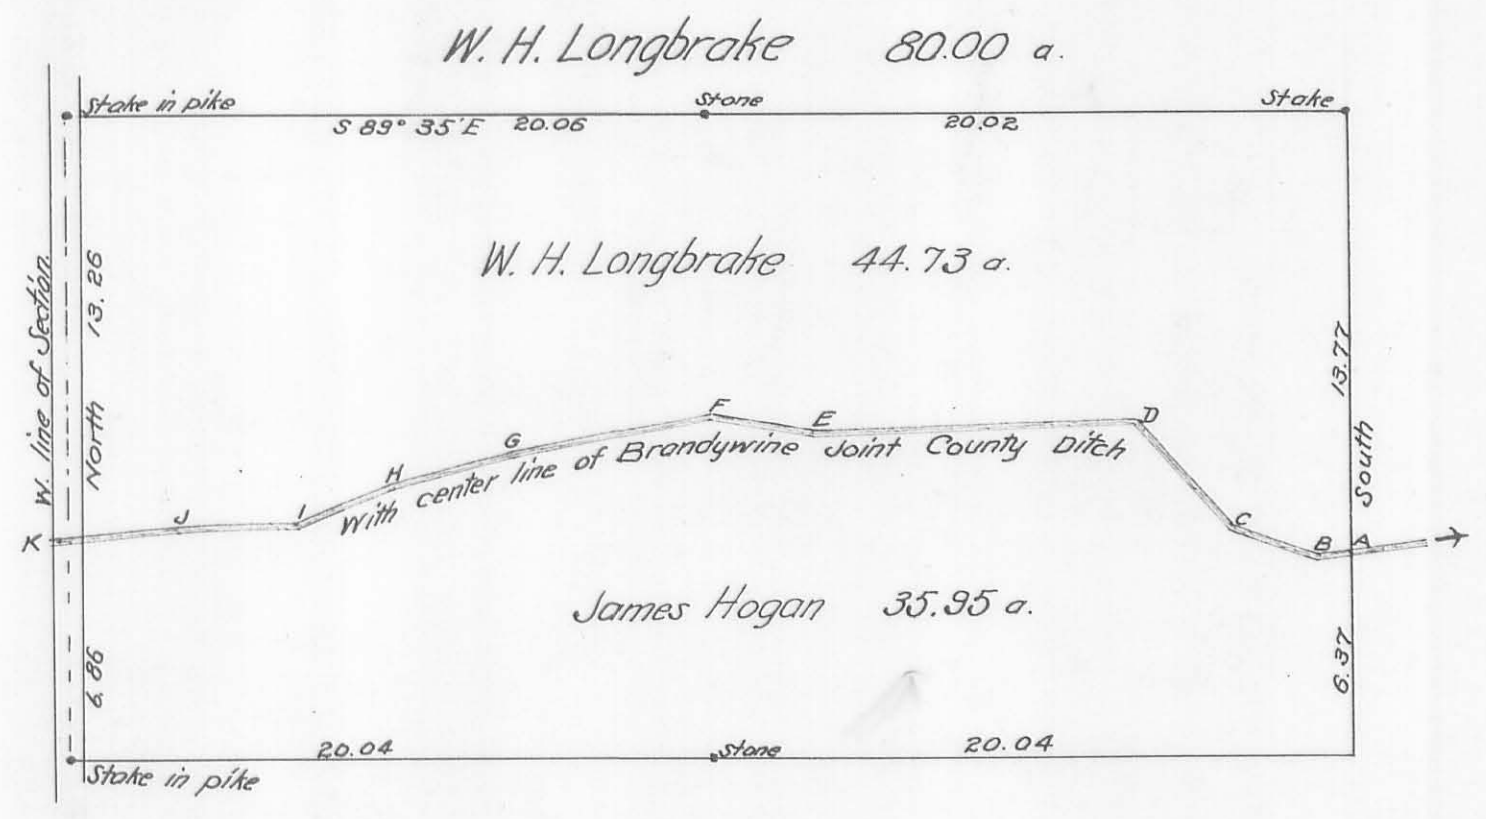

—Description— along line of Brandywine Ditch —


A. to B.,	S 87 1/2 W,	1.02 chains
B to C,	N 72 1/4 W,	2.75 "
C to D,	N 43 W,	4.56 "
D to E,	S 88 1/2 W,	10.22 "
E to F,	N 81 W,	3.36 "
F to G,	S 79 1/2 W,	6.48 "
G to H,	S 75 1/2 W,	3.57 "
H to I,	S 69 3/4 W,	3.22 "
I to J,	S 89 1/4 W,	3.70 "
J to K,	S 83 W,	3.34 "

John Prince
 H. Hodge Longbrake } ch. crs.

Surveyed for
 Dr. Ed. Henning et-al

Pt. Sec. 4, T. 4, R. 14 and Pt. Sec. 34, T. 5, R. 13
 Liberty Township
 May 28, 1907

(161)
 INDEXED ON MAP

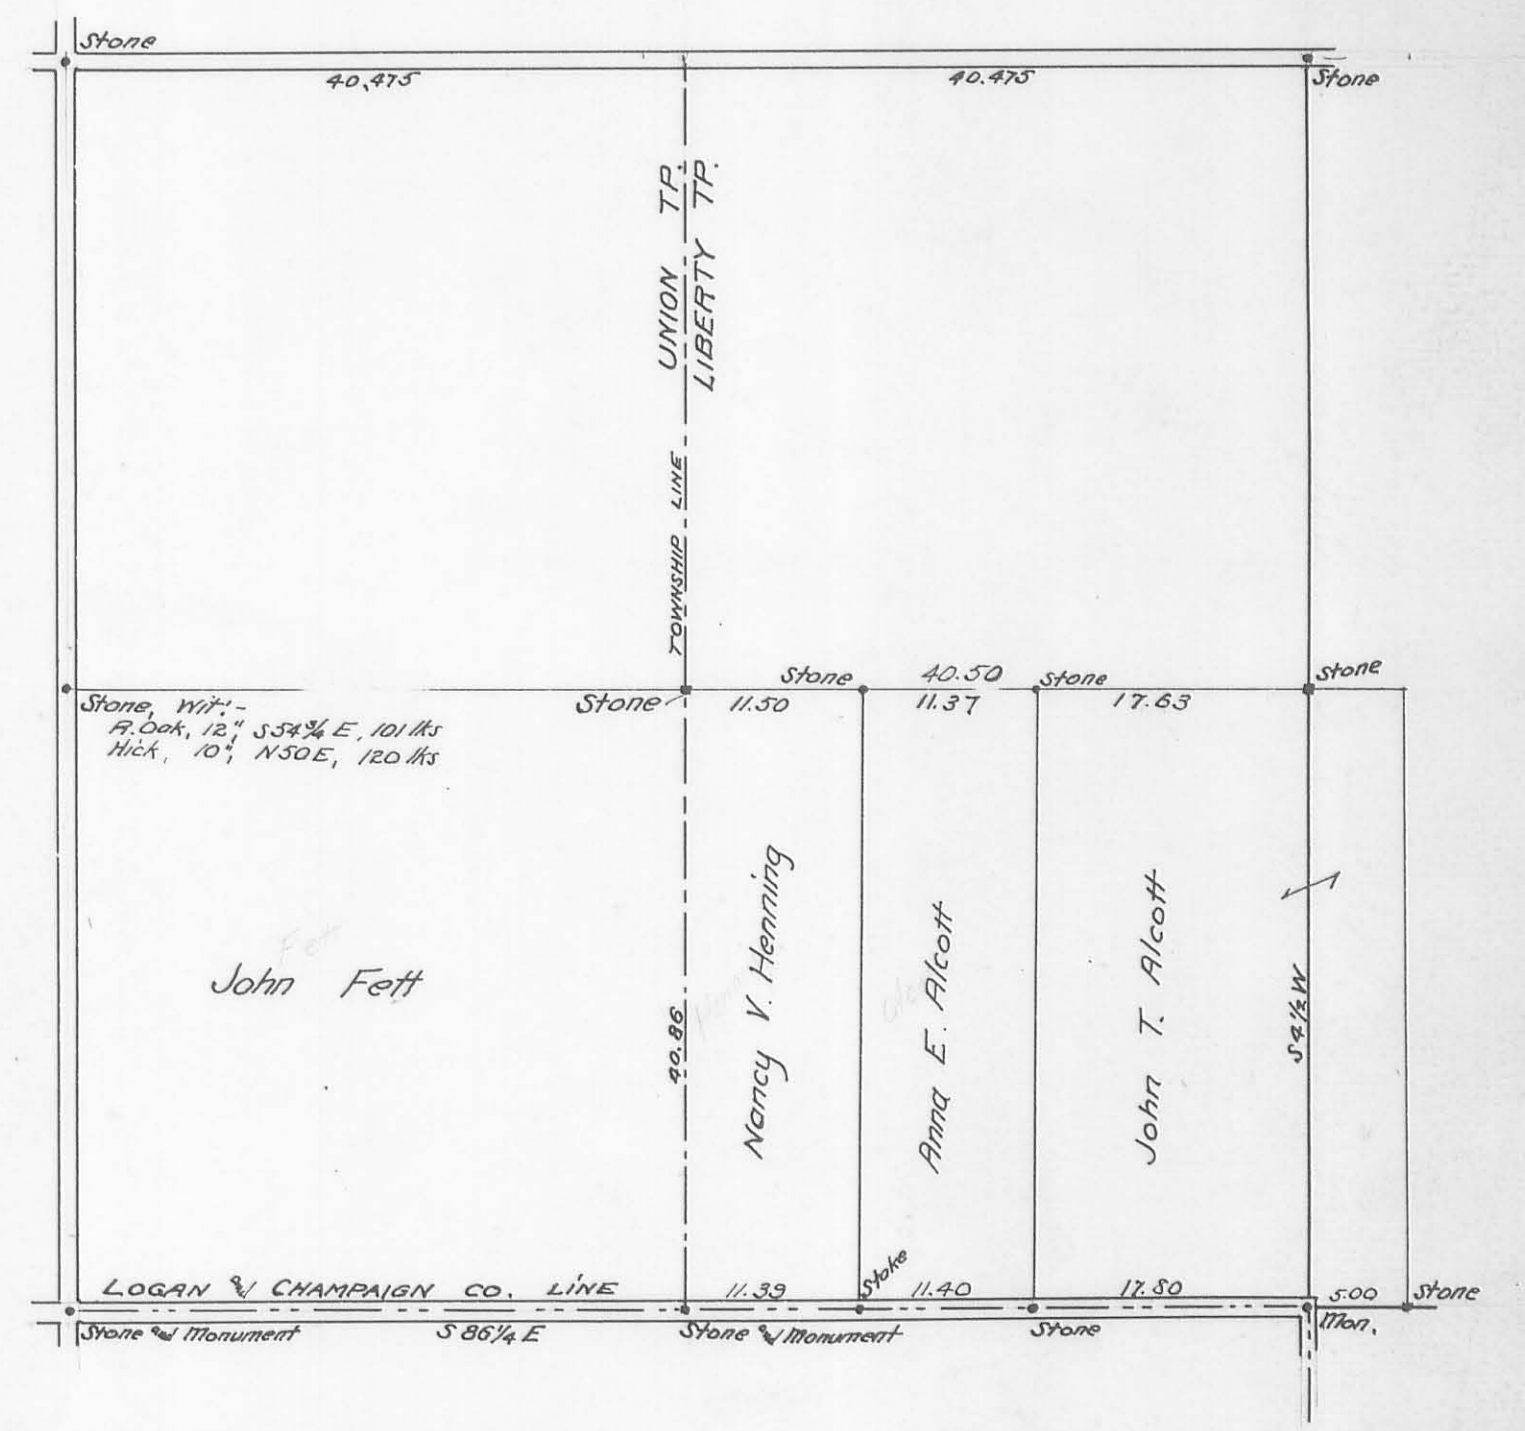

Field Notes Book 55
 Pages 11-12

Not completed


Surveyed for
Lewis S. Plum

Pt. Sec. 23, T. 7. N. R. 9

Washington Tp.

May 14, 1907

(162) INDEXED ON MAP

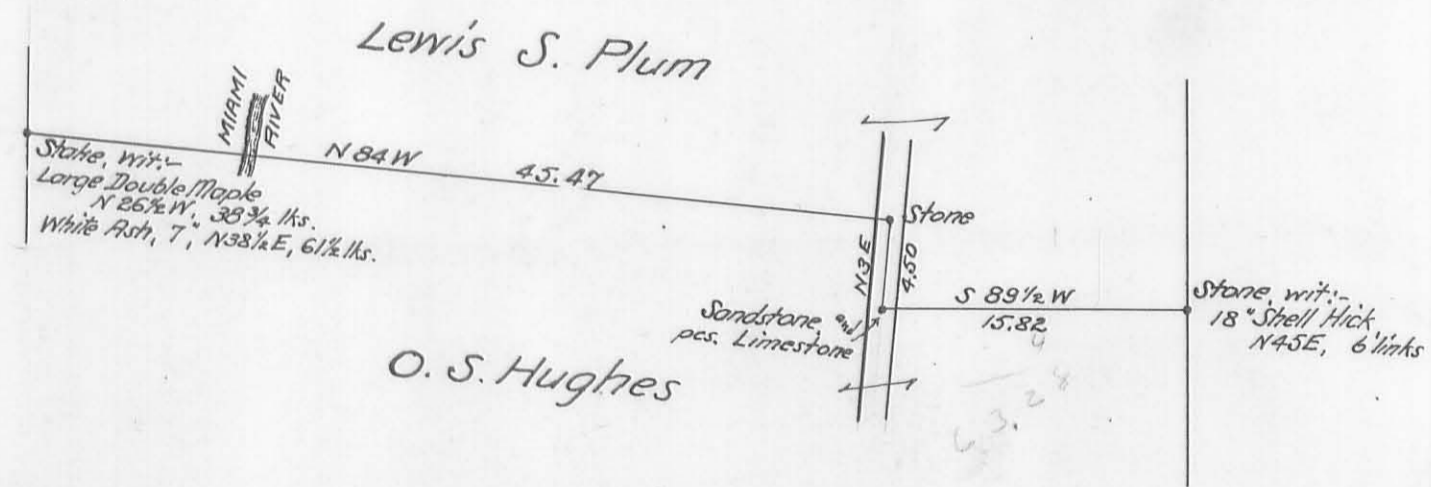

O. C. Richey
Fred Jackson } ch. cr.

Field Notes Book 55
pages 8 and 9

45.47
181.28


Surveyed for
J. H. and J. A. Elder

Survey 10503 Richland Tp., Logan Co., O.

Surveyed in July 1906

(163) INDEXED ON MAP

See Drawer R
163 & 977

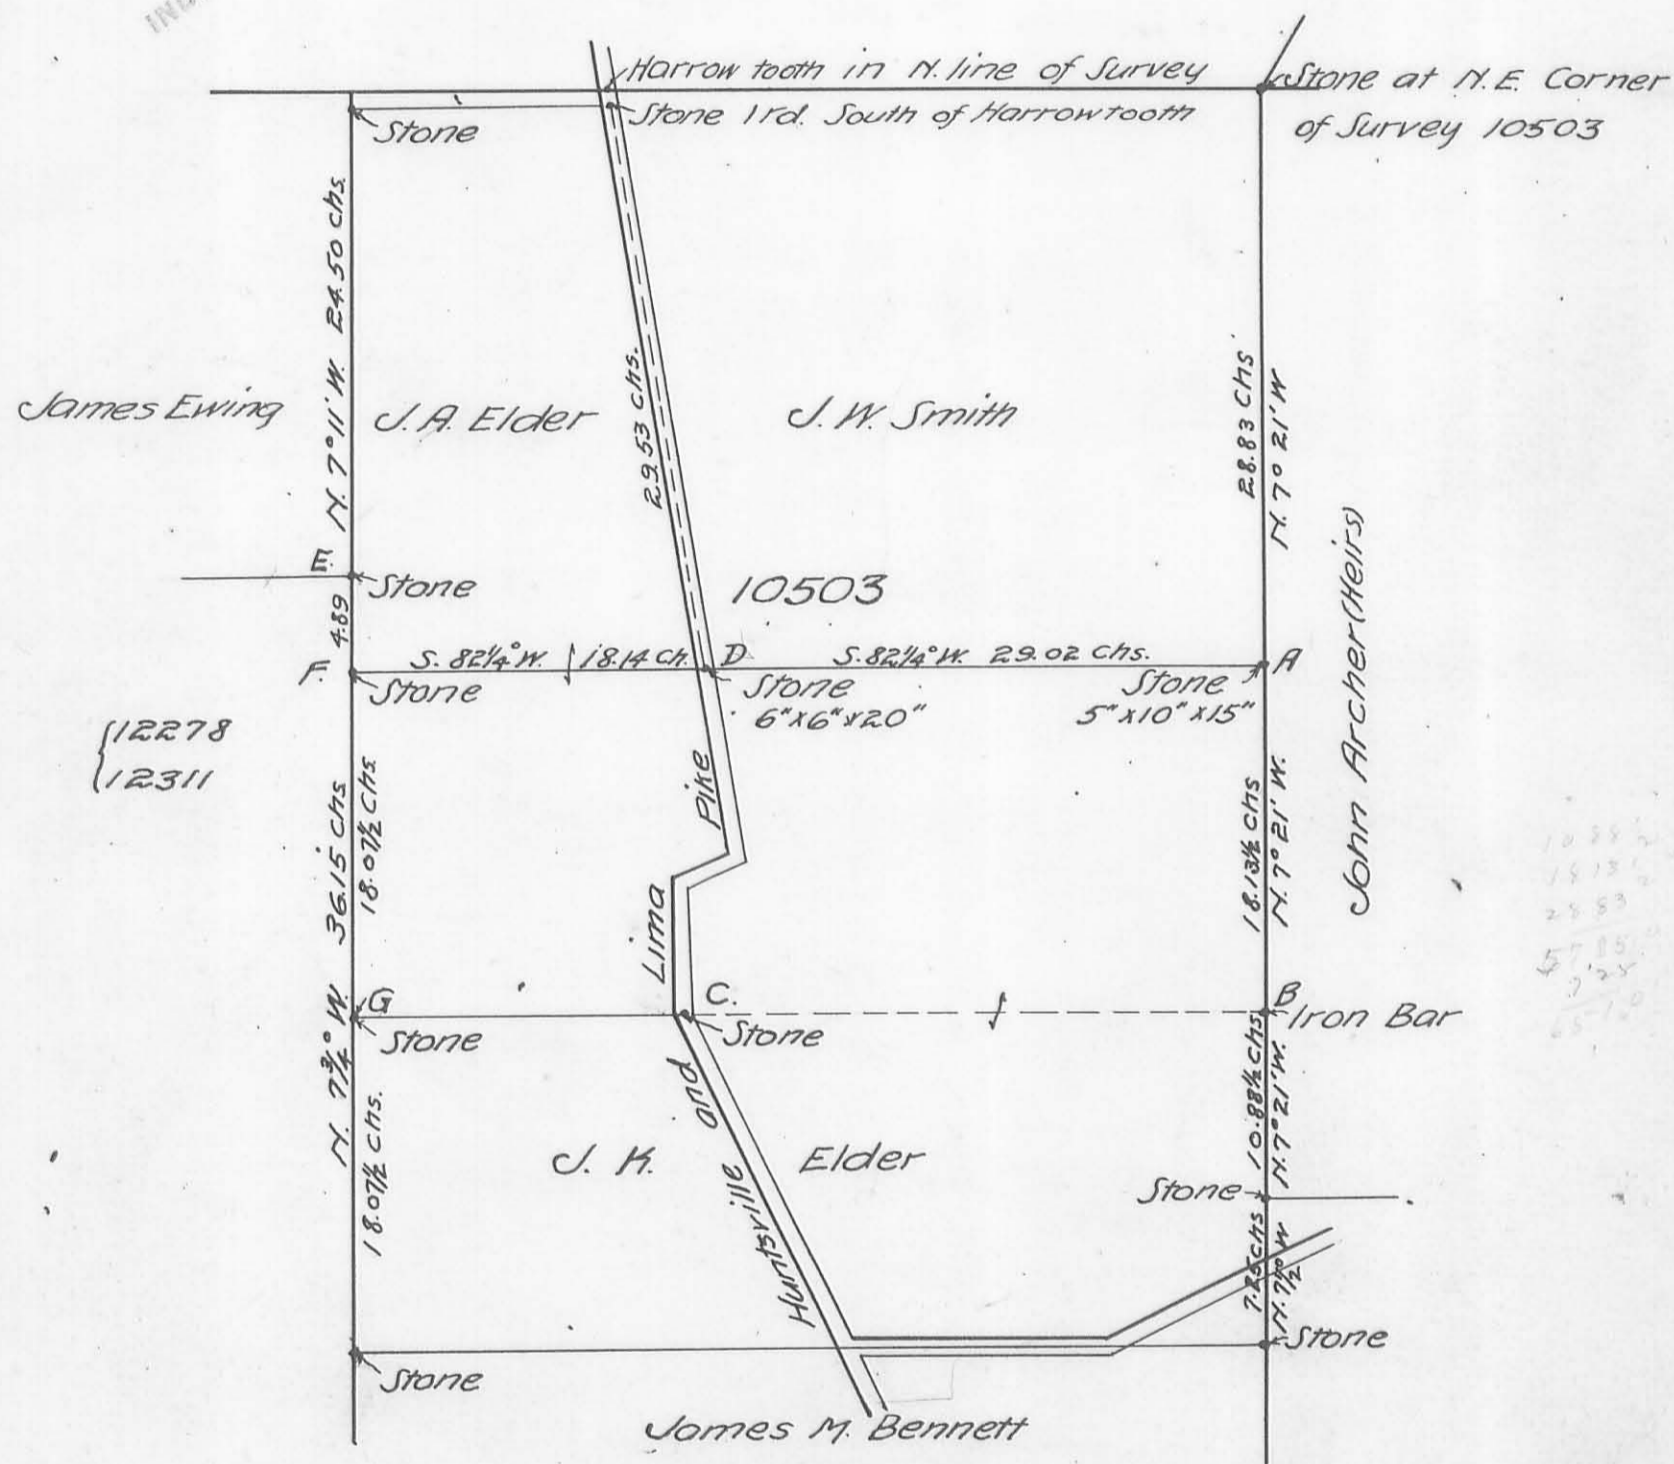

12278
12311

Corners A, B, C, D, E, F, & G were set by me



Dep. Co. Surveyor
Charles Richey

Surveyed for —
David Moury
Bellefontaine, Ohio
Aug. 31. 1908

Surveyed for —
Frank E. Strayer
Pt. N.W. Qr. Sec. 2, T. 1. R. 3
Pleasant Township.

(16A)
INDEXED ON MAP

(165)
INDEXED ON MAP

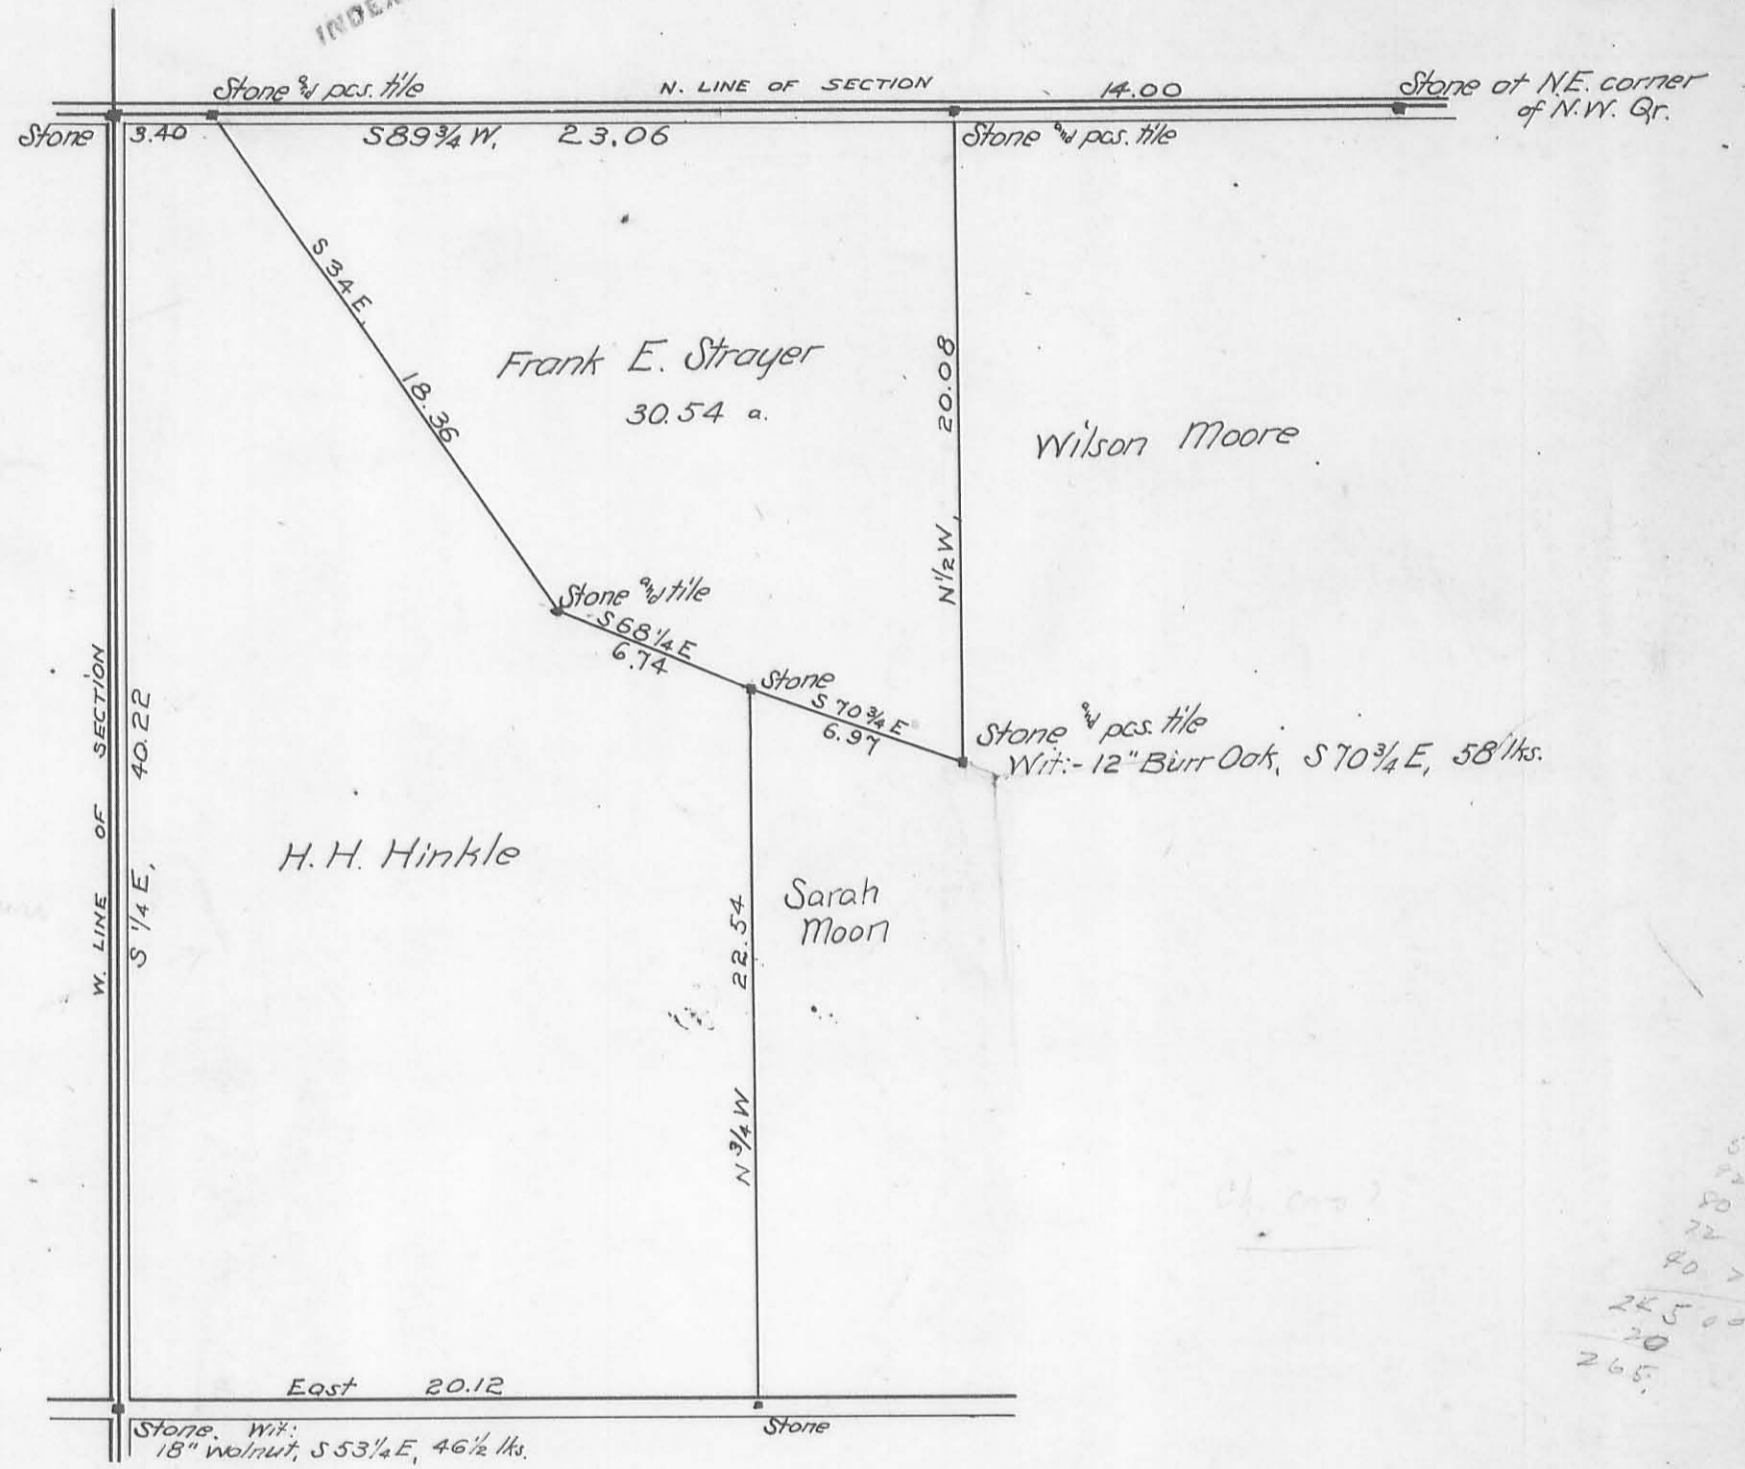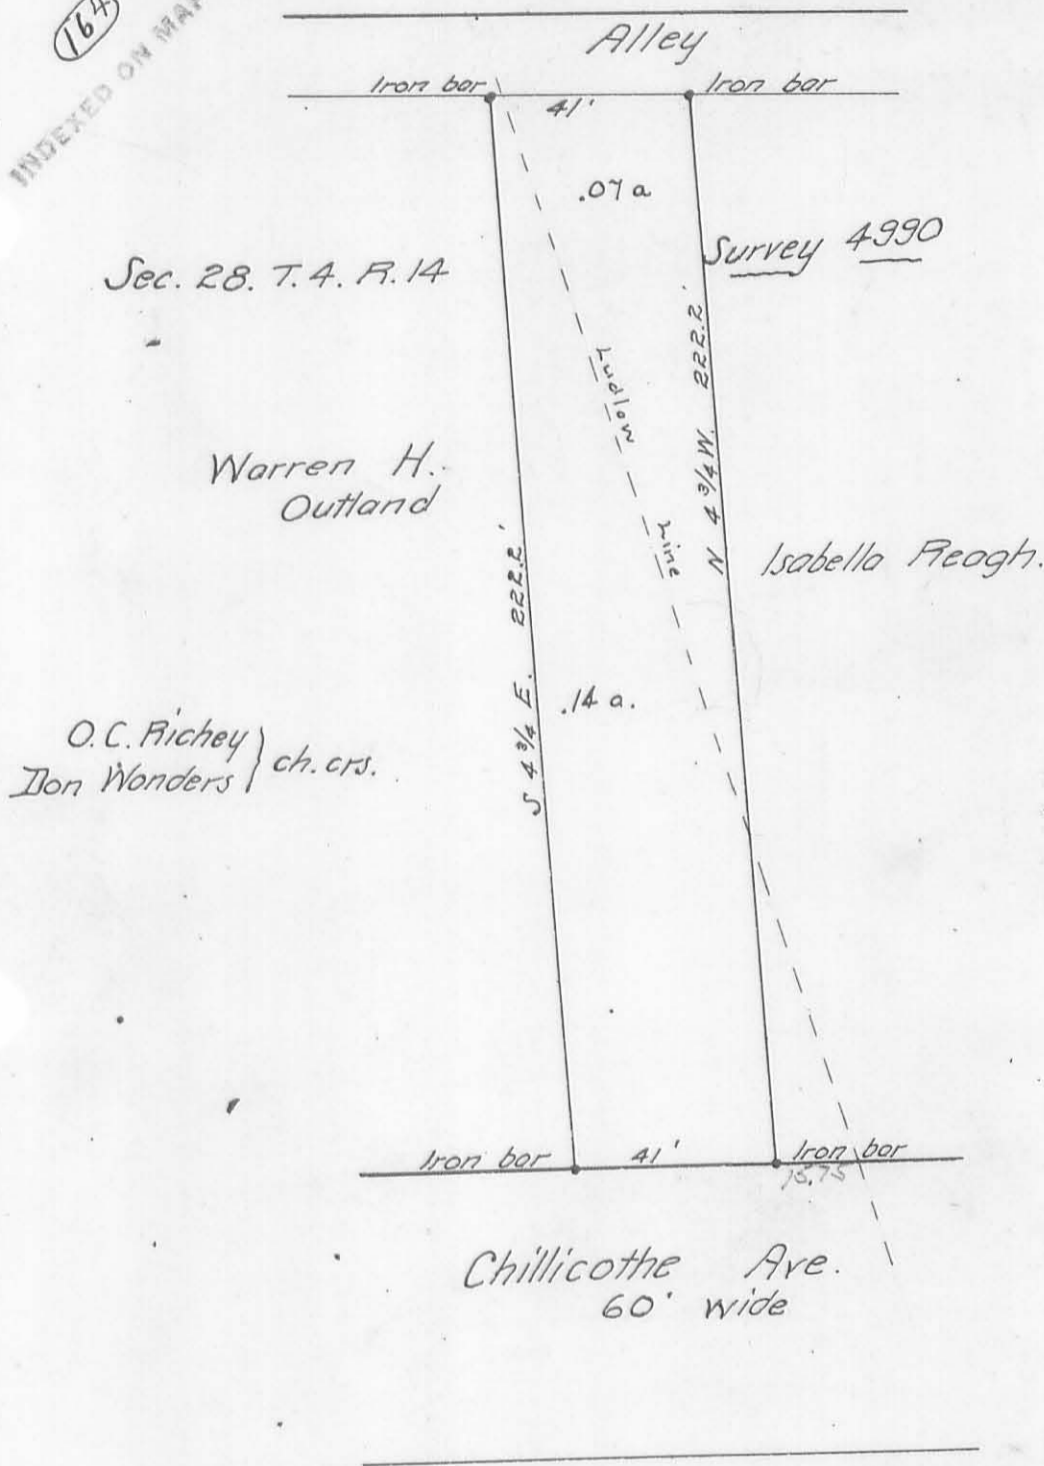

265
20
265


The purpose of this survey was to establish the line between the tracts of David Moury and Isabella Feagh. Since this line could not be established by measurements from Stanley Street or from Powers Street and in absence of other evidence, this was done by starting at remains of an old line fence post near Chillicothe Ave. line, and thence running northerly, following the line of remains of several old fence posts about 2/3 the distance across the lot, and producing the line so found to the south side of an alley, to a fence post pointed out by Miss Mary Feagh, which she stated had been recognized as line for over 30 years. The west line of Moury tract was located by measuring westward 41 feet.

Harry S. Dailey
Deputy County Surveyor

H.S. Dailey

Surveyed for —
Board of Education
Belle Center, Ohio

(No 6)

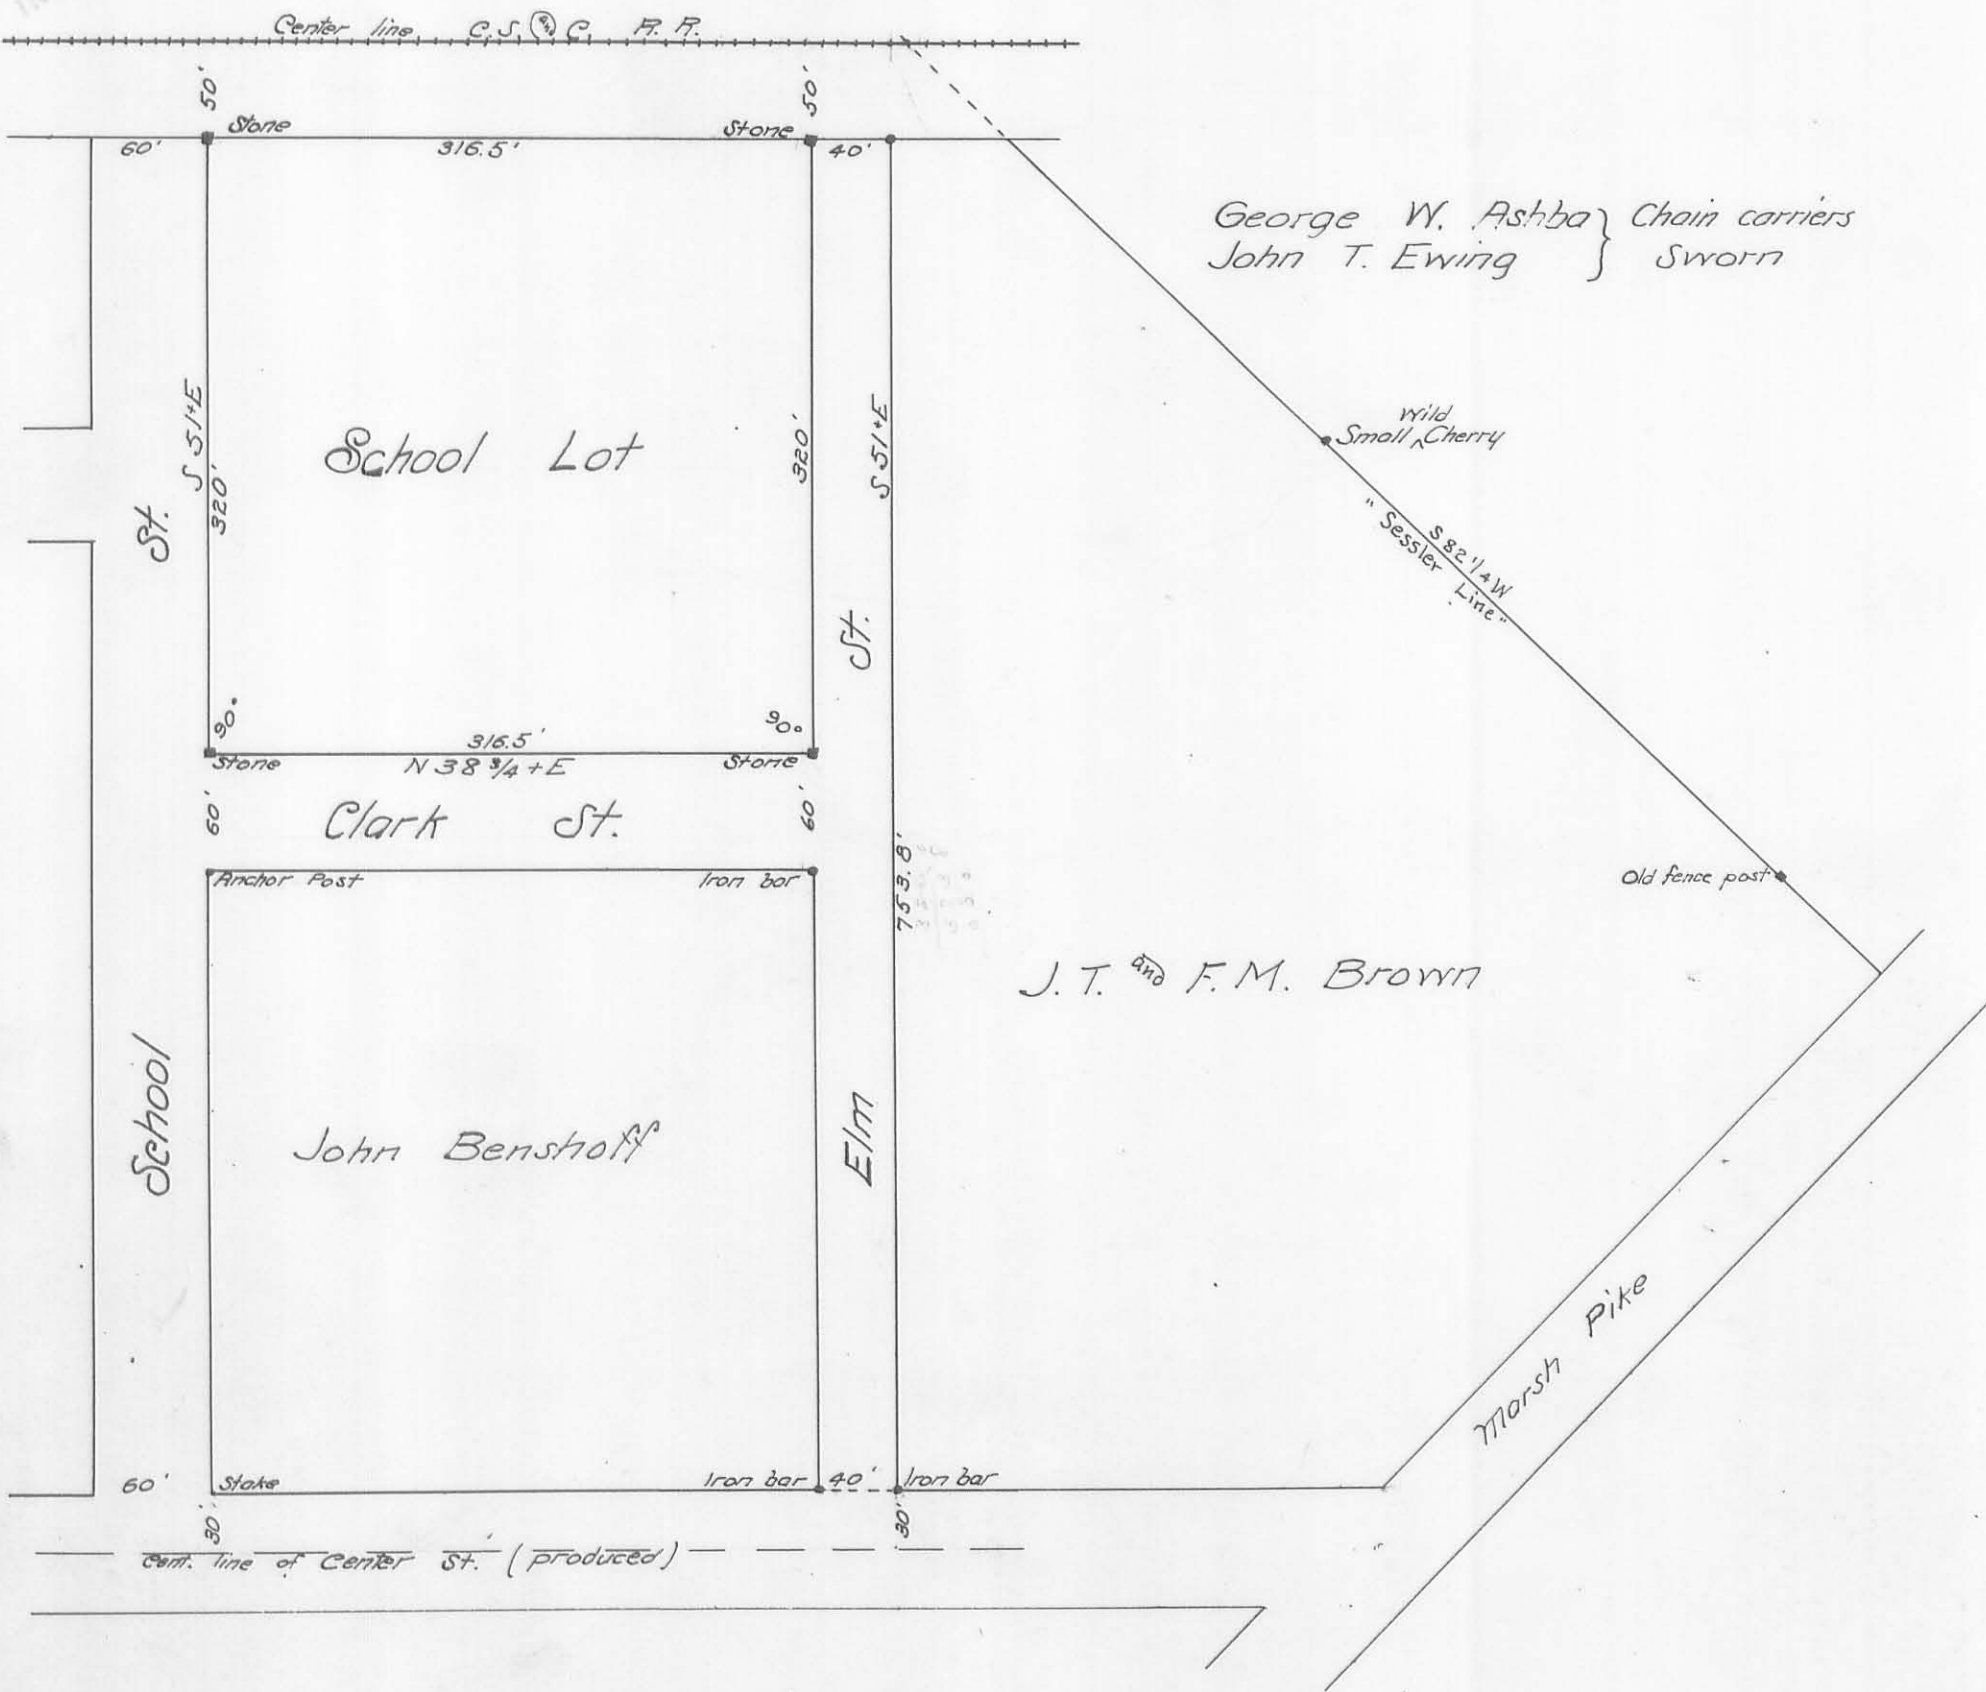

Scale, 1" = 100 ft.

Surveyed as shown above, Nov. 15, 1907.
Harry S. Dailey
Deputy County Surveyor

— Deposition taken by County Surveyor —

In the Matter of the Application of Bd. Education of Belle Center for survey of a certain tract of land.
Deposition of John T. Ewing taken before me, a Deputy County Surveyor of Logan County, Ohio, in the above case of Belle Center on the 15 day of November, 1907.
Said John T. Ewing of lawful age, being by me first duly sworn, as hereinafter certified, deposes and says as follows:

1st. Ques: - State your name, age, occupation, and place of residence.
Answer: - My name is John T. Ewing. I am 54 years of age, I am a Justice of Peace by occupation, and my place of residence is Belle Center.

2d. Ques: - What do you know about the fence on the north side of your property?
Ans: - Do not know that it is just on the line.

Q: - What do you know about the fence at the south side of the Benstoff tract?
Ans: - I believe this fence is on the line, and has been there for some 17 years.

Signed by
John T. Ewing.

— Certificate to Deposition —

The State of Ohio, Logan County, SS.
I, Harry S. Dailey, Deputy County Surveyor of Logan County, Ohio, do hereby certify that the above named John T. Ewing was by me first duly sworn to testify the truth, the whole truth, and nothing but the truth, and that the deposition by him subscribed as above set forth was reduced to writing by me, and also so written in the presence of the witness aforementioned, and was subscribed by said witness in my presence, and was taken at the time and place specified in the caption hereof.

IN WITNESS WHEREOF, I have hereunto set my hand and affixed my seal of office this 15 day of November, A.D. 1907.
Harry S. Dailey
Deputy County Surveyor

Deposition Taken by County Surveyor

In the Matter of the Application of the Bd. Education, Belle Center, for Survey of a certain tract of land.

Deposition of David A. Benshoff taken before me, Deputy County Surveyor of Logan County, Ohio, in the above case, at Belle Center on the 15 day of November, 1907.

Said David A. Benshoff of lawful age, being by me first duly sworn, as hereinafter certified, deposes and says as follows:

1st. Ques - State your name, age, occupation, and place of residence.

Answer - My name is David A. Benshoff. I am 34 years of age, I am a farmer by occupation, and my place of residence is Roundhead.

2d. Ques - What do you know about the wire fence at your south line?

Ans. - My father placed this fence where the old fence was, and he always understood the old fence to be on the line.

Signed by David A. Benshoff

Certificate to Deposition

The State of Ohio, Logan County, S.S.

I, Harry S. Dailey, Deputy County Surveyor of Logan County, Ohio, do hereby certify that the above named David A. Benshoff was by me first duly sworn to testify the truth, the whole truth and nothing but the truth, and that the Deposition by him subscribed as above set forth was reduced to writing by me, and also so written in the presence of the witness aforementioned, and was subscribed by said witness in my presence, and was taken at the time and place specified in the caption hereof.

IN WITNESS WHEREOF, I have hereunto set my hand and affixed my seal of office this 15 day of November, A.D. 1907

Harry S. Dailey Deputy County Surveyor

Deposition Taken by County Surveyor

In the matter of the Application of the Bd. Education, Belle Center for Survey of a certain tract of land.

Deposition of Joseph T. Brown, taken before me, Deputy County Surveyor of Logan County, Ohio, in the above case at Belle Center on the 15 day of November, 1907

Said Joseph T. Brown of lawful age being by me first duly sworn, as hereinafter certified, deposes and says as follows:

1st. Ques. - State your name, age, occupation, and place of residence.

Answer - My name is Joseph T. Brown. I am 60 years of age, I am a hay dealer by occupation, and my place of residence is Belle Center

2d Ques - Mr. Brown, - Can you locate the Sessler line?

Ans. - (Pointing to stub of post) This was corner post of old barn on Sessler land, and the line passed about 2 feet south of said corner post. (Pointing to short stub of old fence post)

This post was in old fence line which separated the two tracts of land. This Sessler line (or fence) running west, past old post at barn, and near a small wild cherry tree to the railroad.

Q - Can you locate accurately any corners to your land.

Ans. - Not only by description in deed.

Q - How about the wire fence between your land as occupied and the School lot Benshoff tract?

Ans. - It was placed where old fence had stood for 30 years and was always considered the line of this 6 acre tract.

Signed by Joseph T. Brown

Certificate to Deposition

The State of Ohio, Logan County, S.S.

I, Harry S. Dailey, Deputy County Surveyor of Logan County, Ohio, do hereby certify that the above named Joseph T. Brown was by me first duly sworn to testify the truth, the whole truth and nothing but the truth, and that the deposition by him subscribed as above set forth was reduced to writing by me and also so written in the presence of the witness aforementioned, and was subscribed by said witness in my presence, and was taken at the time and place specified in the caption hereof.

IN WITNESS WHEREOF, I have hereunto set my hand and affixed my seal of office this 15 day of November A.D. 1907.

Harry S. Dailey Deputy County Surveyor

Surveyed for -

A. R. Richey


Bellefontaine, O

Aug., 1909

Charles M. Richey
County Surveyor

A. R. Richey } ch. crs.
J. G. Marquis }

(67)
INDEXED ON MAP

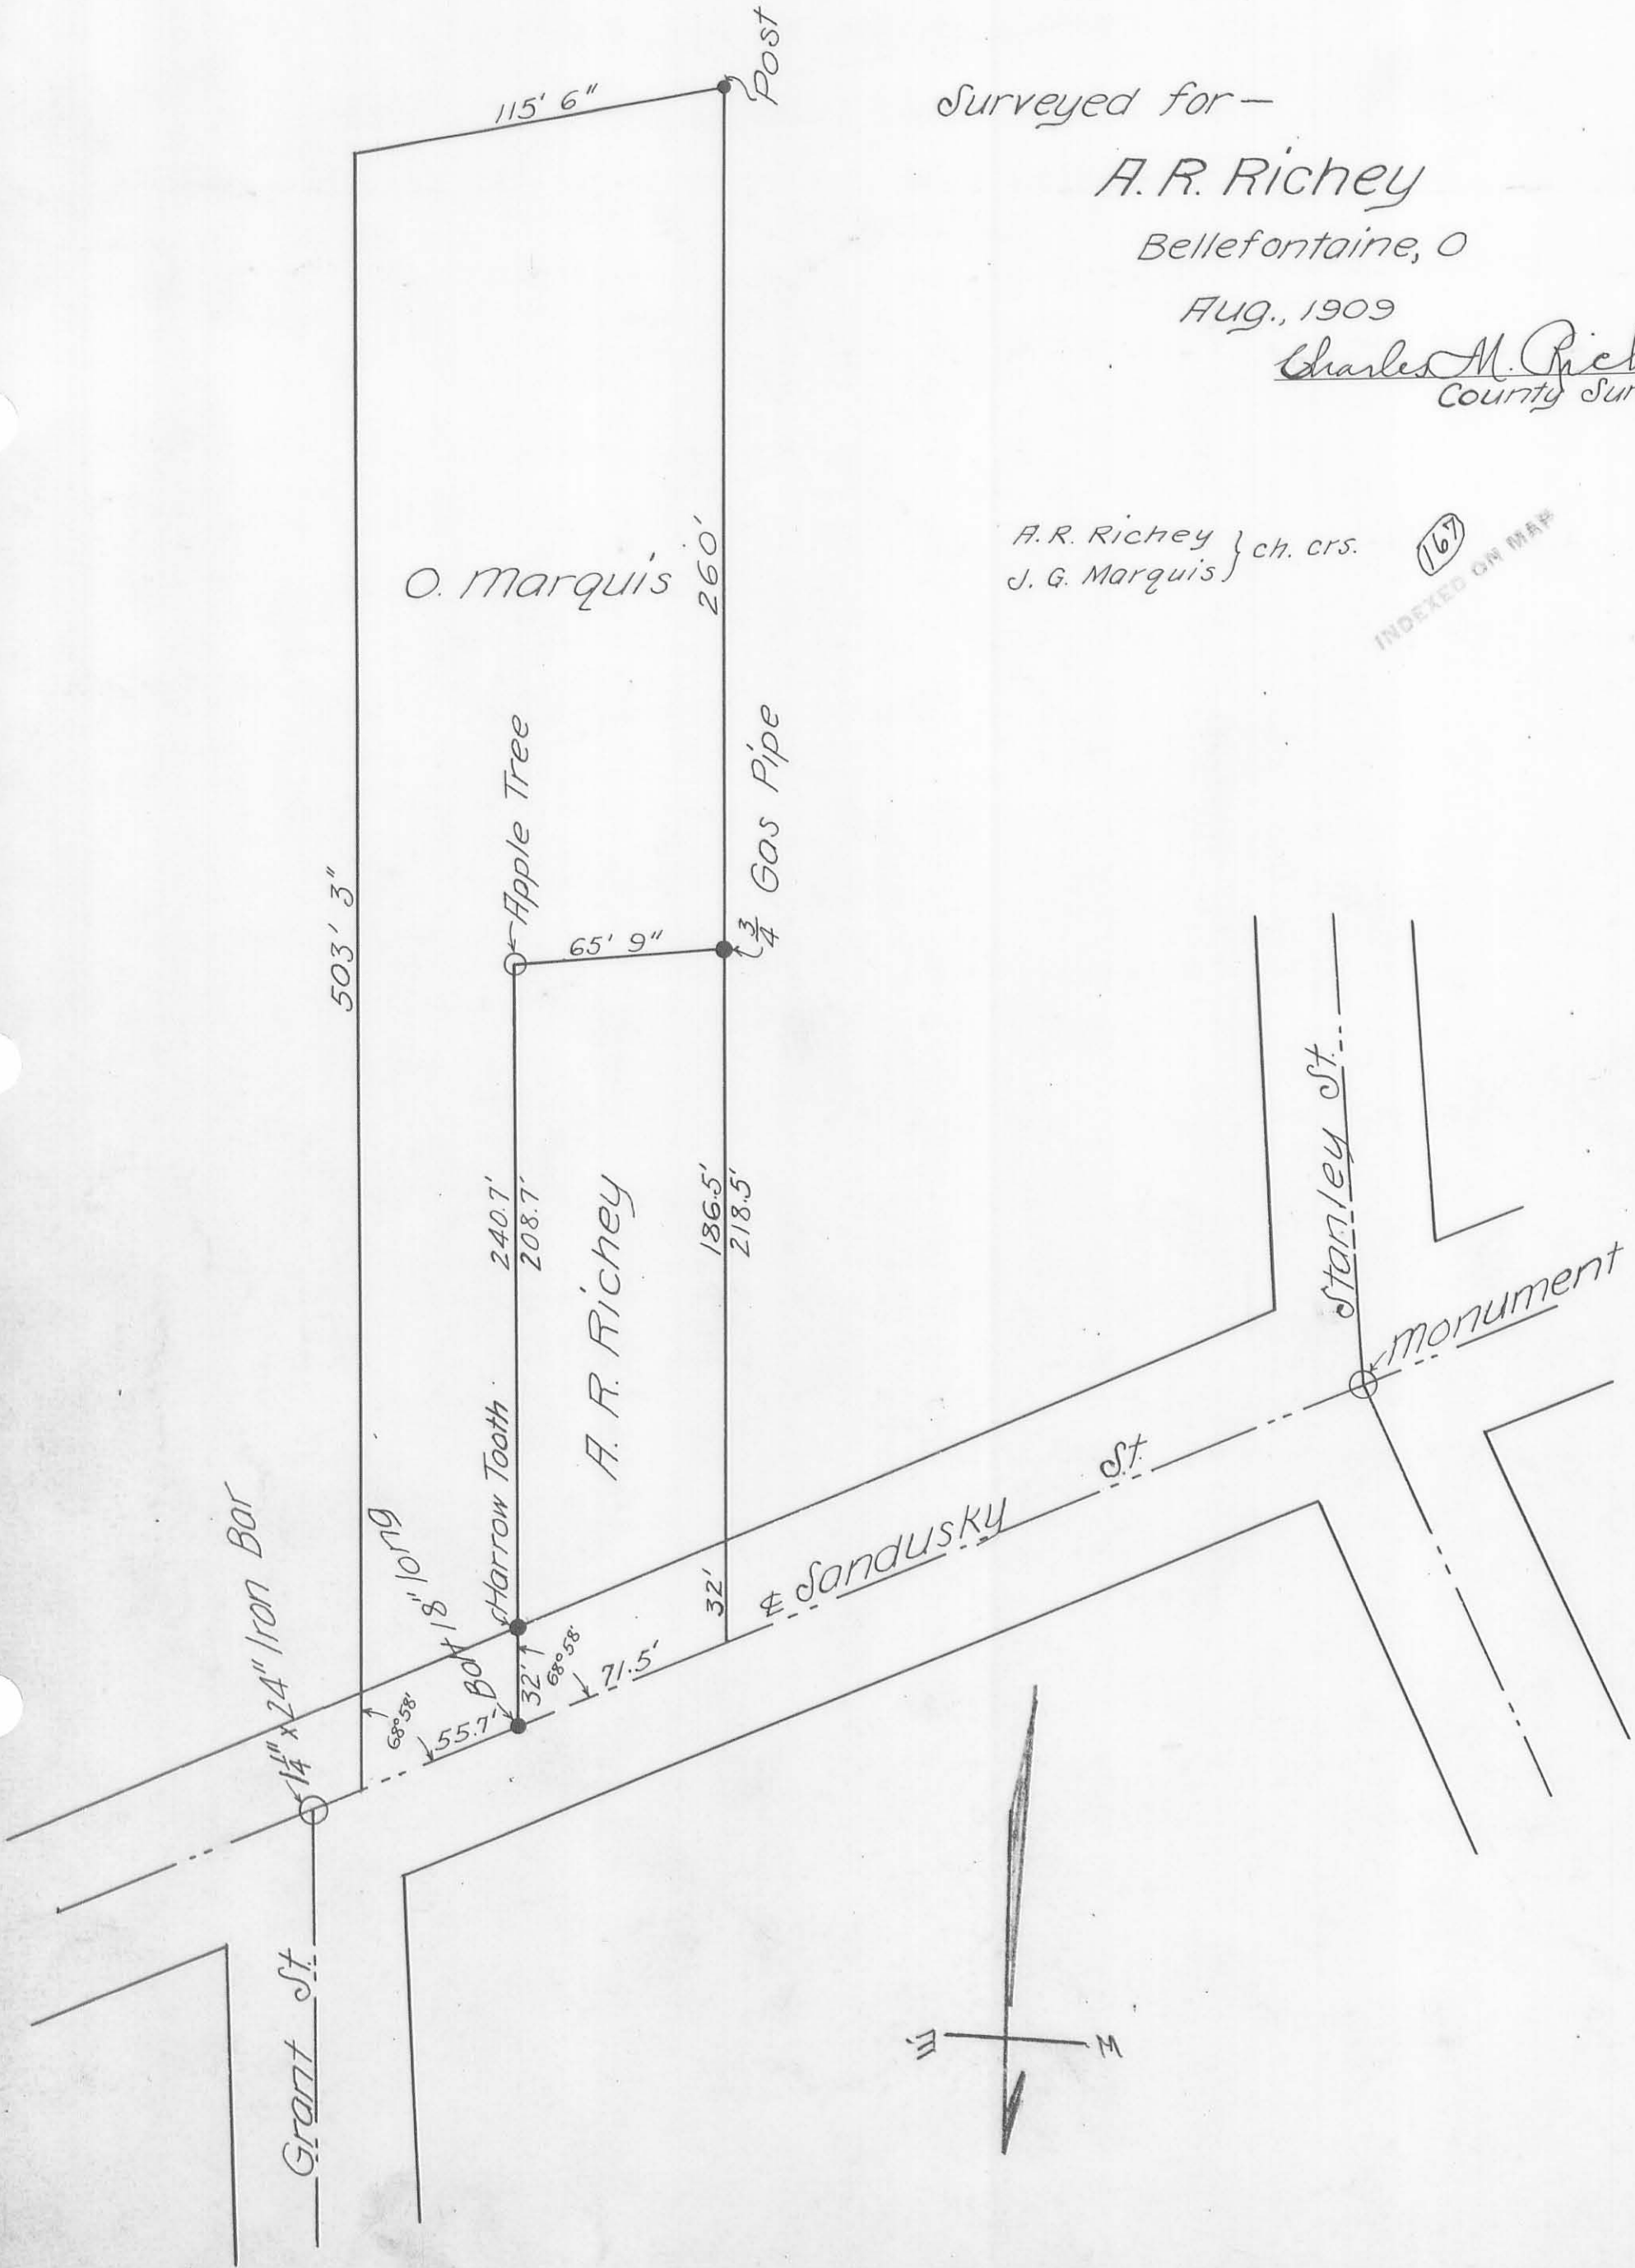

OFFICIAL APPOINTMENTS

To H.S. Dailey:

By the authority vested in me by the Statutes of Ohio, I hereby, as County Surveyor of Logan County, Ohio appoint you, H.S. Dailey, my Deputy, to do and perform all works, acts and things pertaining to the office as required of you by me as such County Surveyor and the laws of Ohio. Such appointment to begin on the 3rd day of September 1906 and to end on the 6th day of September 1909.

Charles M. Richey, County Surveyor of Logan County, Ohio.

State of Ohio, Logan County, S.S.:

H.S. Dailey being first duly sworn deposes and says that he will support the Constitution of the United States of America and of the State of Ohio, and will faithfully, honestly, and skillfully and impartially do and perform all the duties required of him by the said County Surveyor of Logan County, Ohio, or the laws of said State of Ohio

Sworn to before me September 3rd, 1906. Subscribed in my presence this 28th of March, 1910.

Charles M. Richey, County Surveyor of Logan County, Ohio.

To E.H. Bushong:-

By the authority vested in me by the Statutes of Ohio, I hereby, as County Surveyor of Logan County, Ohio, appoint you, E.H. Bushong my Deputy, to do and perform all works, acts and things pertaining to the office as required of you by me as such County Surveyor and the laws of Ohio. Such appointment to begin on the 3^d day of September 1906, and to end on the 6th day of September 1909

Charles M. Richey
County Surveyor of Logan County, Ohio.

State of Ohio, Logan County, SS:-

E.H. Bushong being first duly sworn deposes and says that he will support the Constitution of the United States of America and the State of Ohio, and will faithfully, honestly, skillfully and impartially do and perform all the duties required of him by the said County Surveyor of Logan County, Ohio, or the laws of said State of Ohio

Edward H. Bushong.

Sworn to before me September 3^d, 1906. Subscribed in my presence, this 29th day of March 1910

Charles M. Richey County Surveyor of Logan County, Ohio.

To F.W. McKinnon:-

By the authority vested in me by the Statutes of Ohio, I hereby, as County Surveyor of Logan County, Ohio, appoint you, F.W. McKinnon my Deputy to do and perform all works, acts, and things pertaining to the office as required of you by me as such County Surveyor and the laws of Ohio. Such appointment to begin on the 3^d day of September 1906, and to end on the 6th day of September 1909

Charles M. Richey
County Surveyor of Logan County, Ohio

State of Ohio, Logan County, SS:

F.W. McKinnon being first duly sworn deposes and says that he will support the Constitution of the United States of America and the State of Ohio, and will faithfully, honestly, skillfully and impartially do and perform all the duties required of him by the said County Surveyor of Logan County, Ohio, or the laws of said State of Ohio.

Fred W. McKinnon

Sworn to before me September 3^d 1906. Subscribed in my presence this 29th day of March, 1910

Charles M. Richey County Surveyor of Logan County, Ohio

OFFICIAL APPOINTMENTS

To H. S. Dailey:-

By the authority vested in me by the Statutes of Ohio, I hereby, as County Surveyor, of Logan County, Ohio, appoint you, H. S. Dailey, my Deputy, to do and perform all works, acts and things pertaining to the office as required of you by me as such County Surveyor and the laws of Ohio. Such appointment to begin on the 6th day of September 1909, and to end on the 5th day of September 1910.

Charles M. Richey

County Surveyor of Logan County, Ohio.

State of Ohio, Logan County SS.

H. S. Dailey being first duly sworn deposes and says that he will support the Constitution of the United States of America, and the State of Ohio, and will faithfully, honestly, skillfully and impartially do and perform all the duties required of him by the said County Surveyor of Logan County, Ohio, or the laws of said State of Ohio.

H. S. Dailey

Sworn to before me September 2^d, 1909.

Subscribed in my presence this 28th day of March, 1910

Charles M. Richey, County Surveyor of Logan County, Ohio

To E. H. Bushong:-

By the authority vested in me by the Statutes of Ohio, I hereby, as County Surveyor of Logan County, Ohio, appoint you, E. H. Bushong, my Deputy, to do and perform all works, acts and things pertaining to the office as required of you by me as such County Surveyor, and the laws of Ohio. Such appointment to begin on the 6th day of September 1909, and to end on the 5th day of September 1910.

Charles M. Richey

County Surveyor of Logan County, Ohio

State of Ohio, Logan County, SS:-

E. H. Bushong being first duly sworn deposes and says that he will support the Constitution of the United States of America and the State of Ohio, and will faithfully, honestly, skillfully and impartially do and perform all the duties required of him by the said County Surveyor of Logan County, Ohio, or the laws of said State of Ohio.

Edward H. Bushong

Sworn to before me, September 6th 1909.

Subscribed in my presence this 29th day of March, 1910

Charles M. Richey

County Surveyor of Logan County, Ohio.

To F. W. McKinnon:-

By the authority vested in me by the Statutes of Ohio, I hereby, as County Surveyor of Logan County, Ohio, appoint you F. W. McKinnon, my Deputy to do and perform all works, acts and things pertaining to the office as required of you by me as such County Surveyor and the laws of Ohio. Such appointment to begin on the 6th day of September 1909 and to end on the 5th day of September 1910.

Charles M. Richey

County Surveyor of Logan County, Ohio.

State of Ohio, Logan County, SS:-

F. W. McKinnon being first duly sworn deposes and says that he will support the Constitution of the United States of America and the State of Ohio, and will faithfully, honestly, skillfully and impartially do and perform all the duties required of him by the said County Surveyor of Logan County, Ohio, or the laws of said State of Ohio.

Fred W. McKinnon

Sworn to before me, September 6th 1909.

Subscribed in my presence this 29th day of March, 1910.

Charles M. Richey

County Surveyor of Logan County, Ohio.


SURVEY FOR
MILLIGAN ^{9/4} HOVER
Richland Tp.
Survey 9950

Charles M. Richey
County Surveyor.
See Drawer R

- Corners -

- A - Stone in Road. Wit: 24" Hackberry Stump S. 27 ³/₄° E 96 lks.
- B - Stone. Wit: 20" Sugar-tree Stump S. 83° W. 39 lks.
- C - Stone and Brick.
- D - Stone and Brick.
- L - Stone in ctr. Road.
- X - Stone.
- Z - Stake.


J. R. Shaw - chain Cr.
O. C. Richey - " "
Frank Wisecup - Flagman

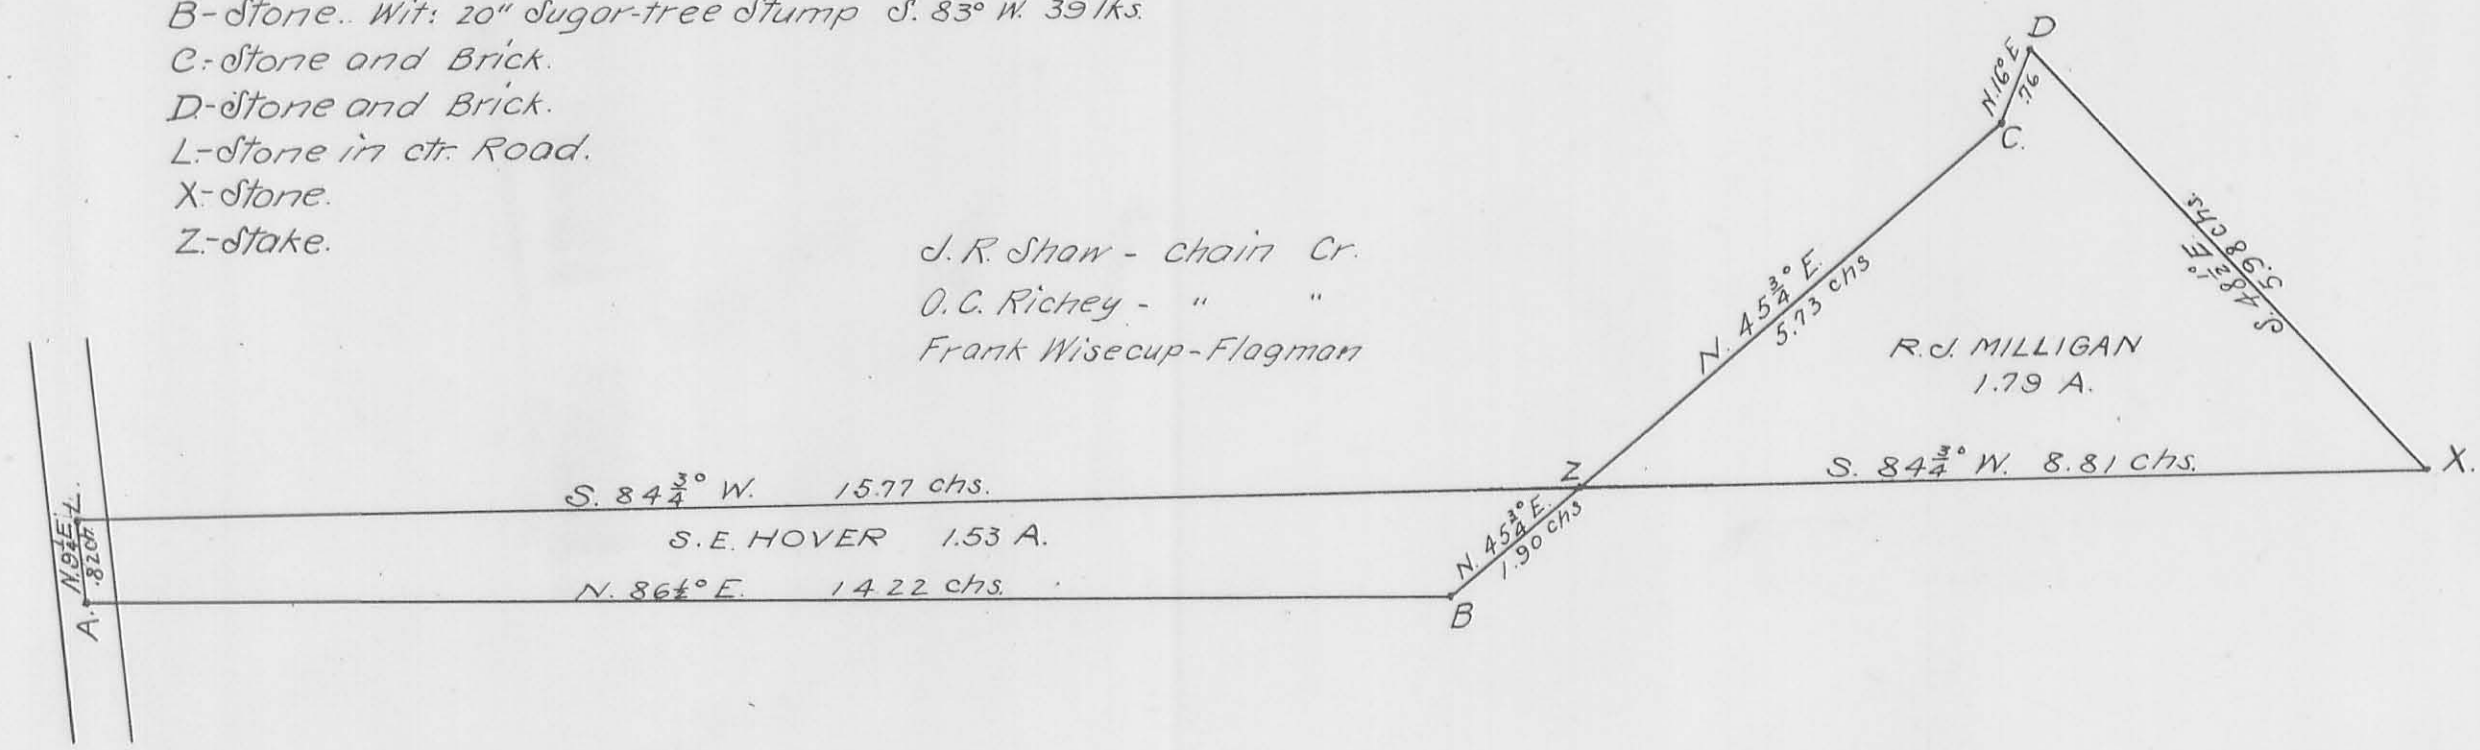

Survey of Line Between John Y. Foust,
L. W. Sidesinger, and Joseph Shoots,
Survey 9592 and Between Surveys 9592 ^{1/2} 4957.
Surveyed for Joseph Shoots May 14, 1909.
Stones at A ^{1/2} B were set by me. B. located
by walnut tree witness 24" in dia. N. 6° E. 110 lks.
Present when Stones were planted,
Joseph Shoots, L. W. Sidesinger, M. W. Parker,
John Cooper, Sam'l Jackson, Wm Jackson,
Jos. Jackson ^{1/2} A. Cooper.


Charles M. Richey
County Surveyor.

M. W. Parker - Chain Cr.
Joseph Jackson - Flagman.

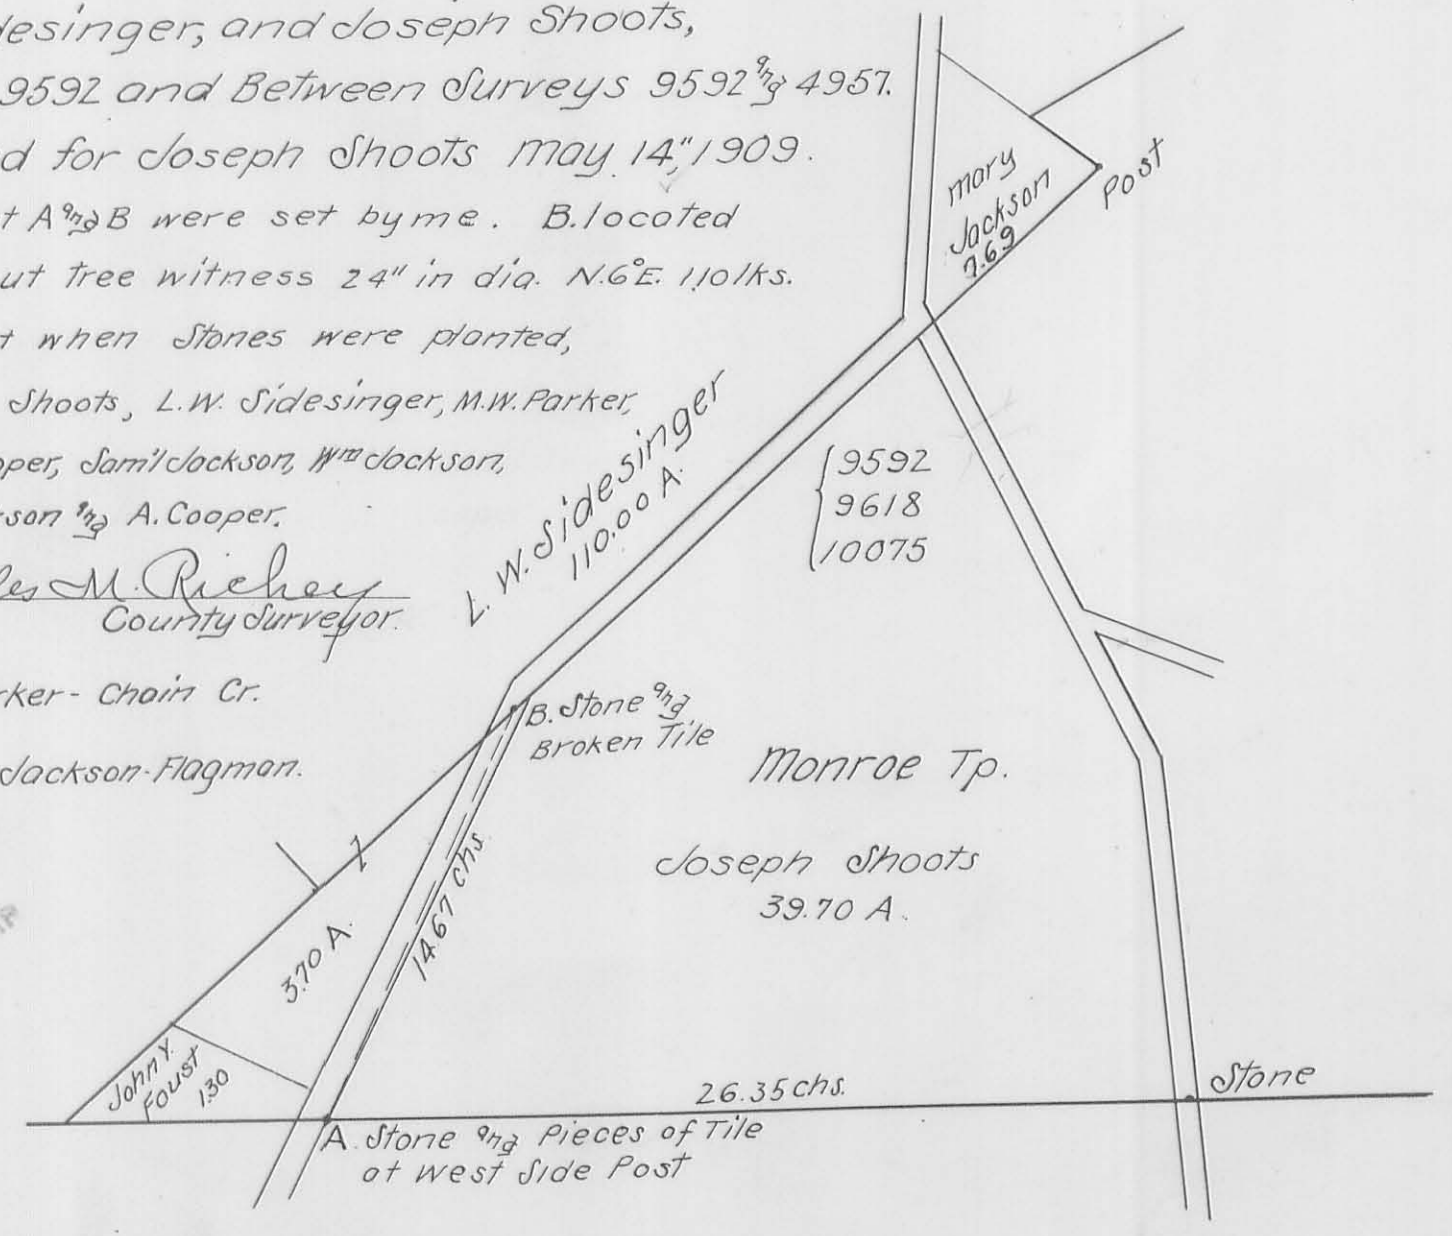

INDEXED ON MAP

(170)
INDEXED ON MAP

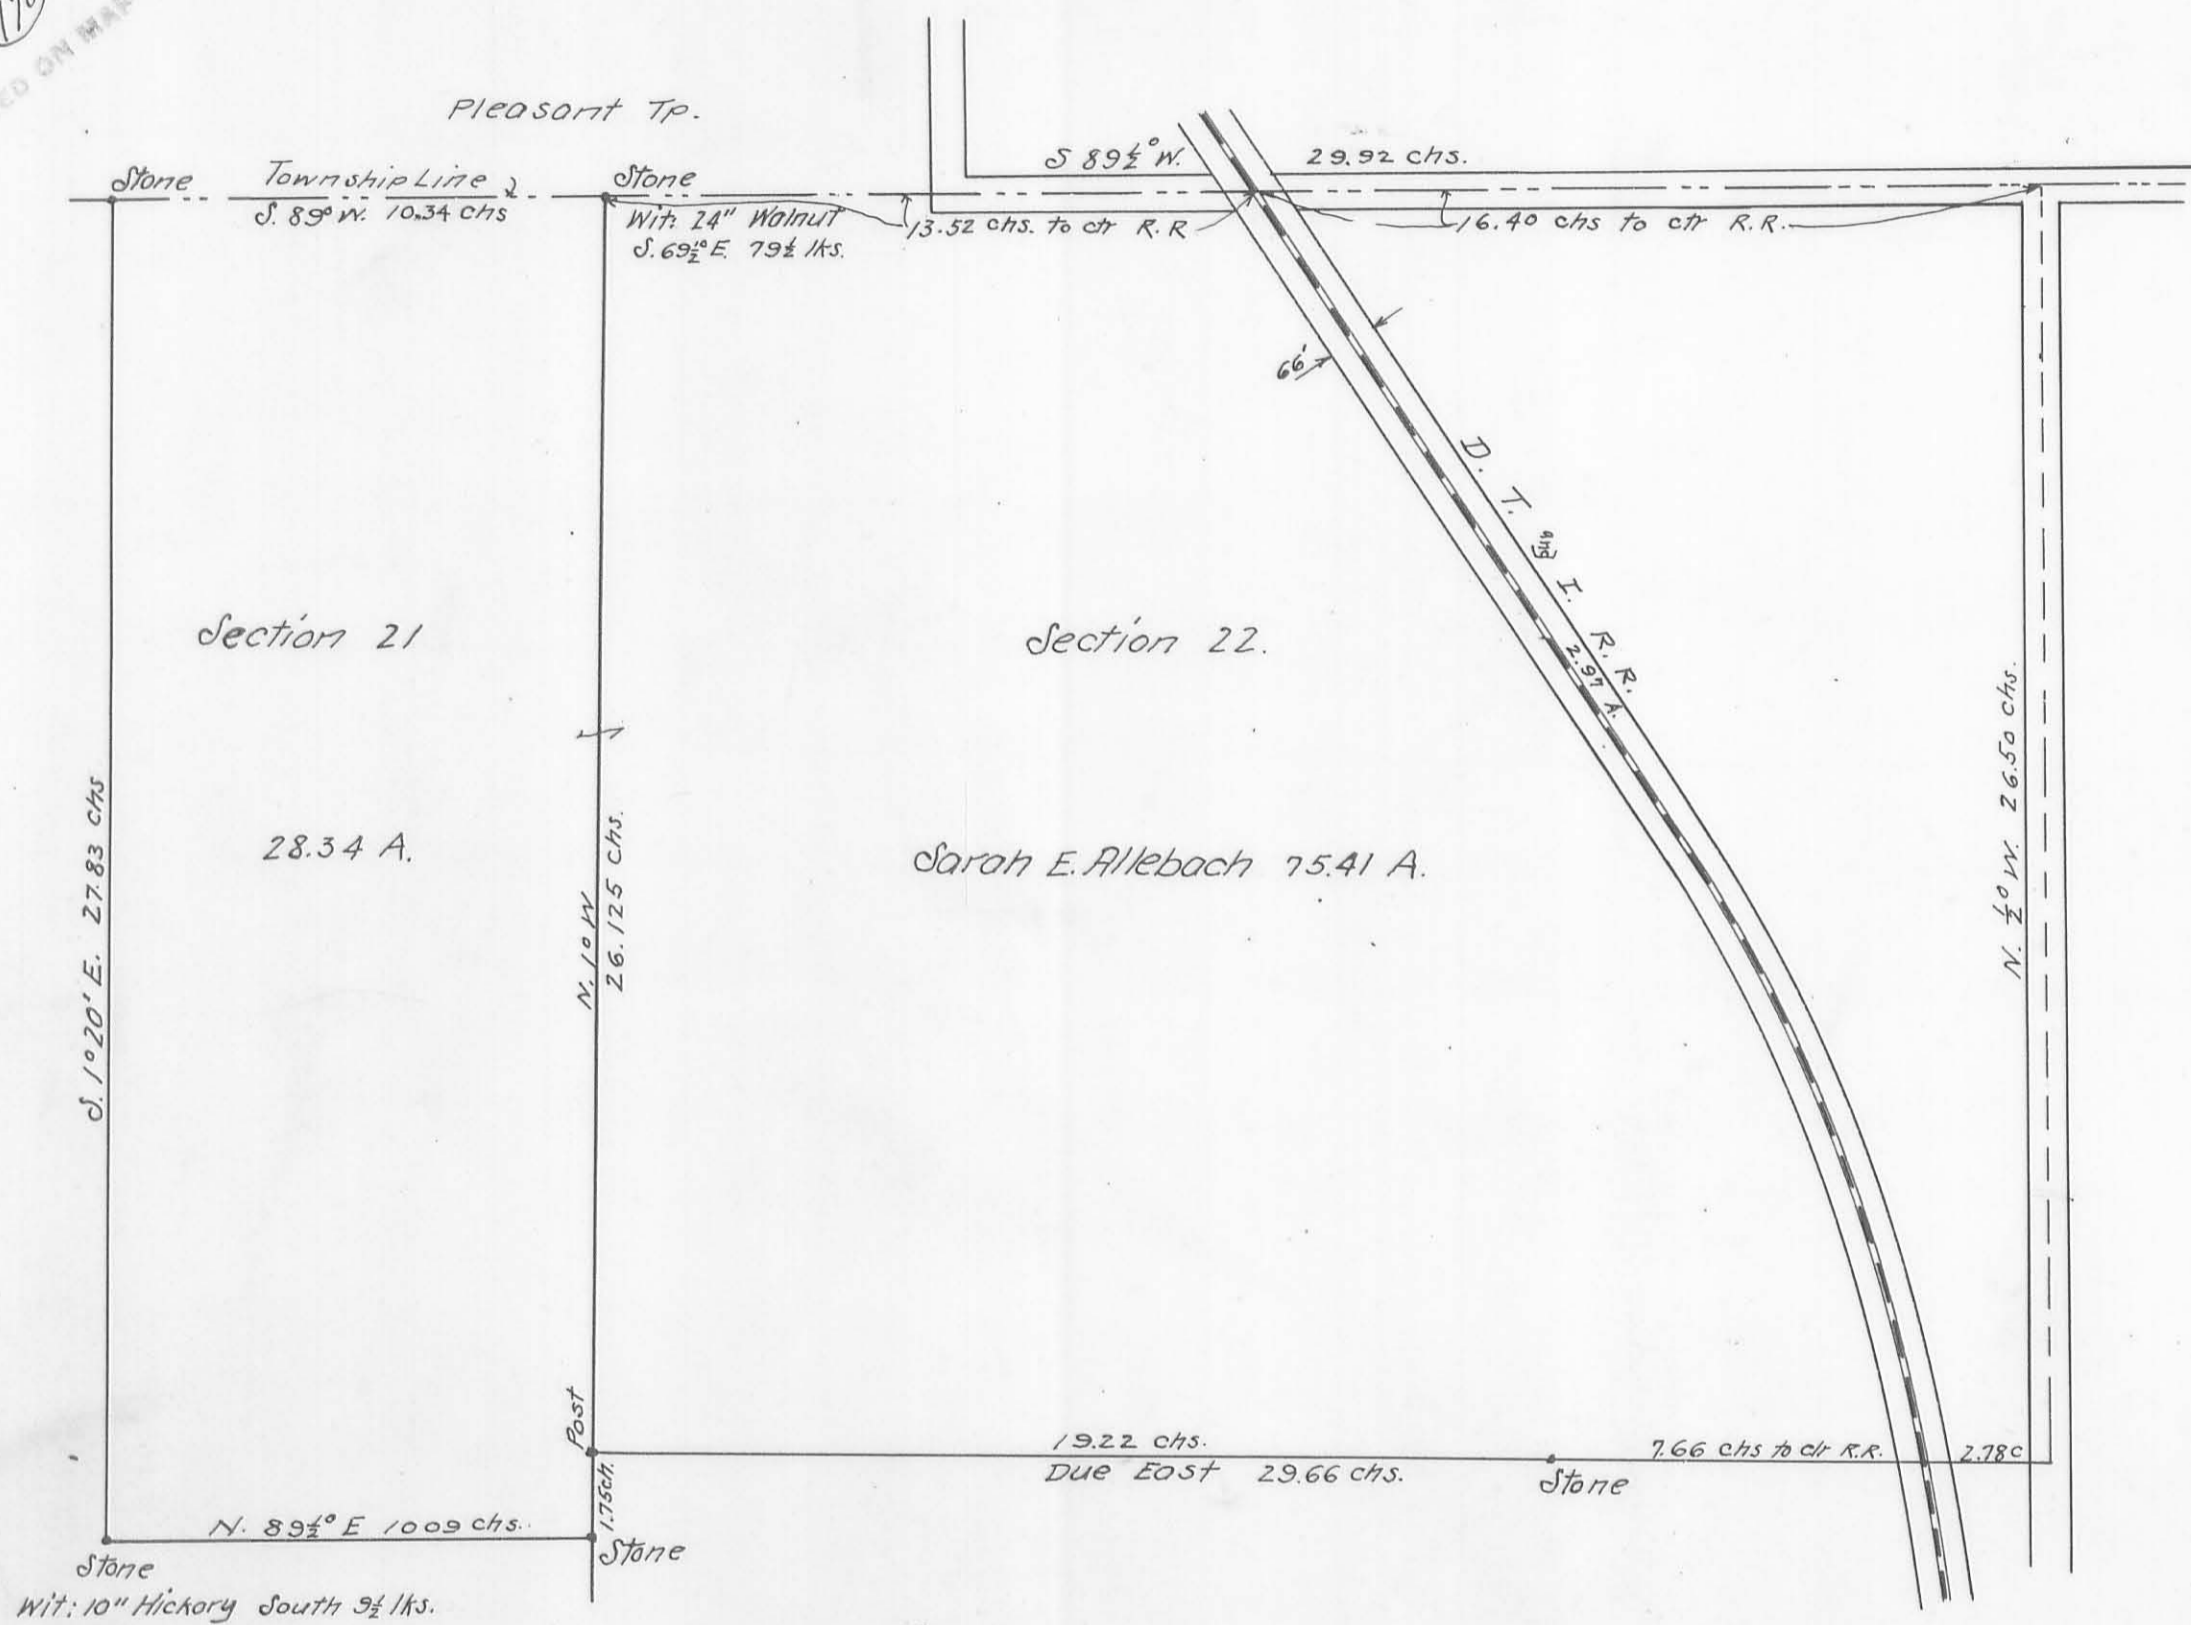


Pts. Secs. 21 & 22, T. 1, R. 8, Miami Tp.
 Sarah E. Allebach Estate
 Surveyed for Elmer Polk Adm.

Aug. 1909

Charles M. Richey
 County Surveyor

Marion Gasser } Ch. cr.
 O. C. Richey }

Wm Wert } Flagman.
 Elmer Polk. }

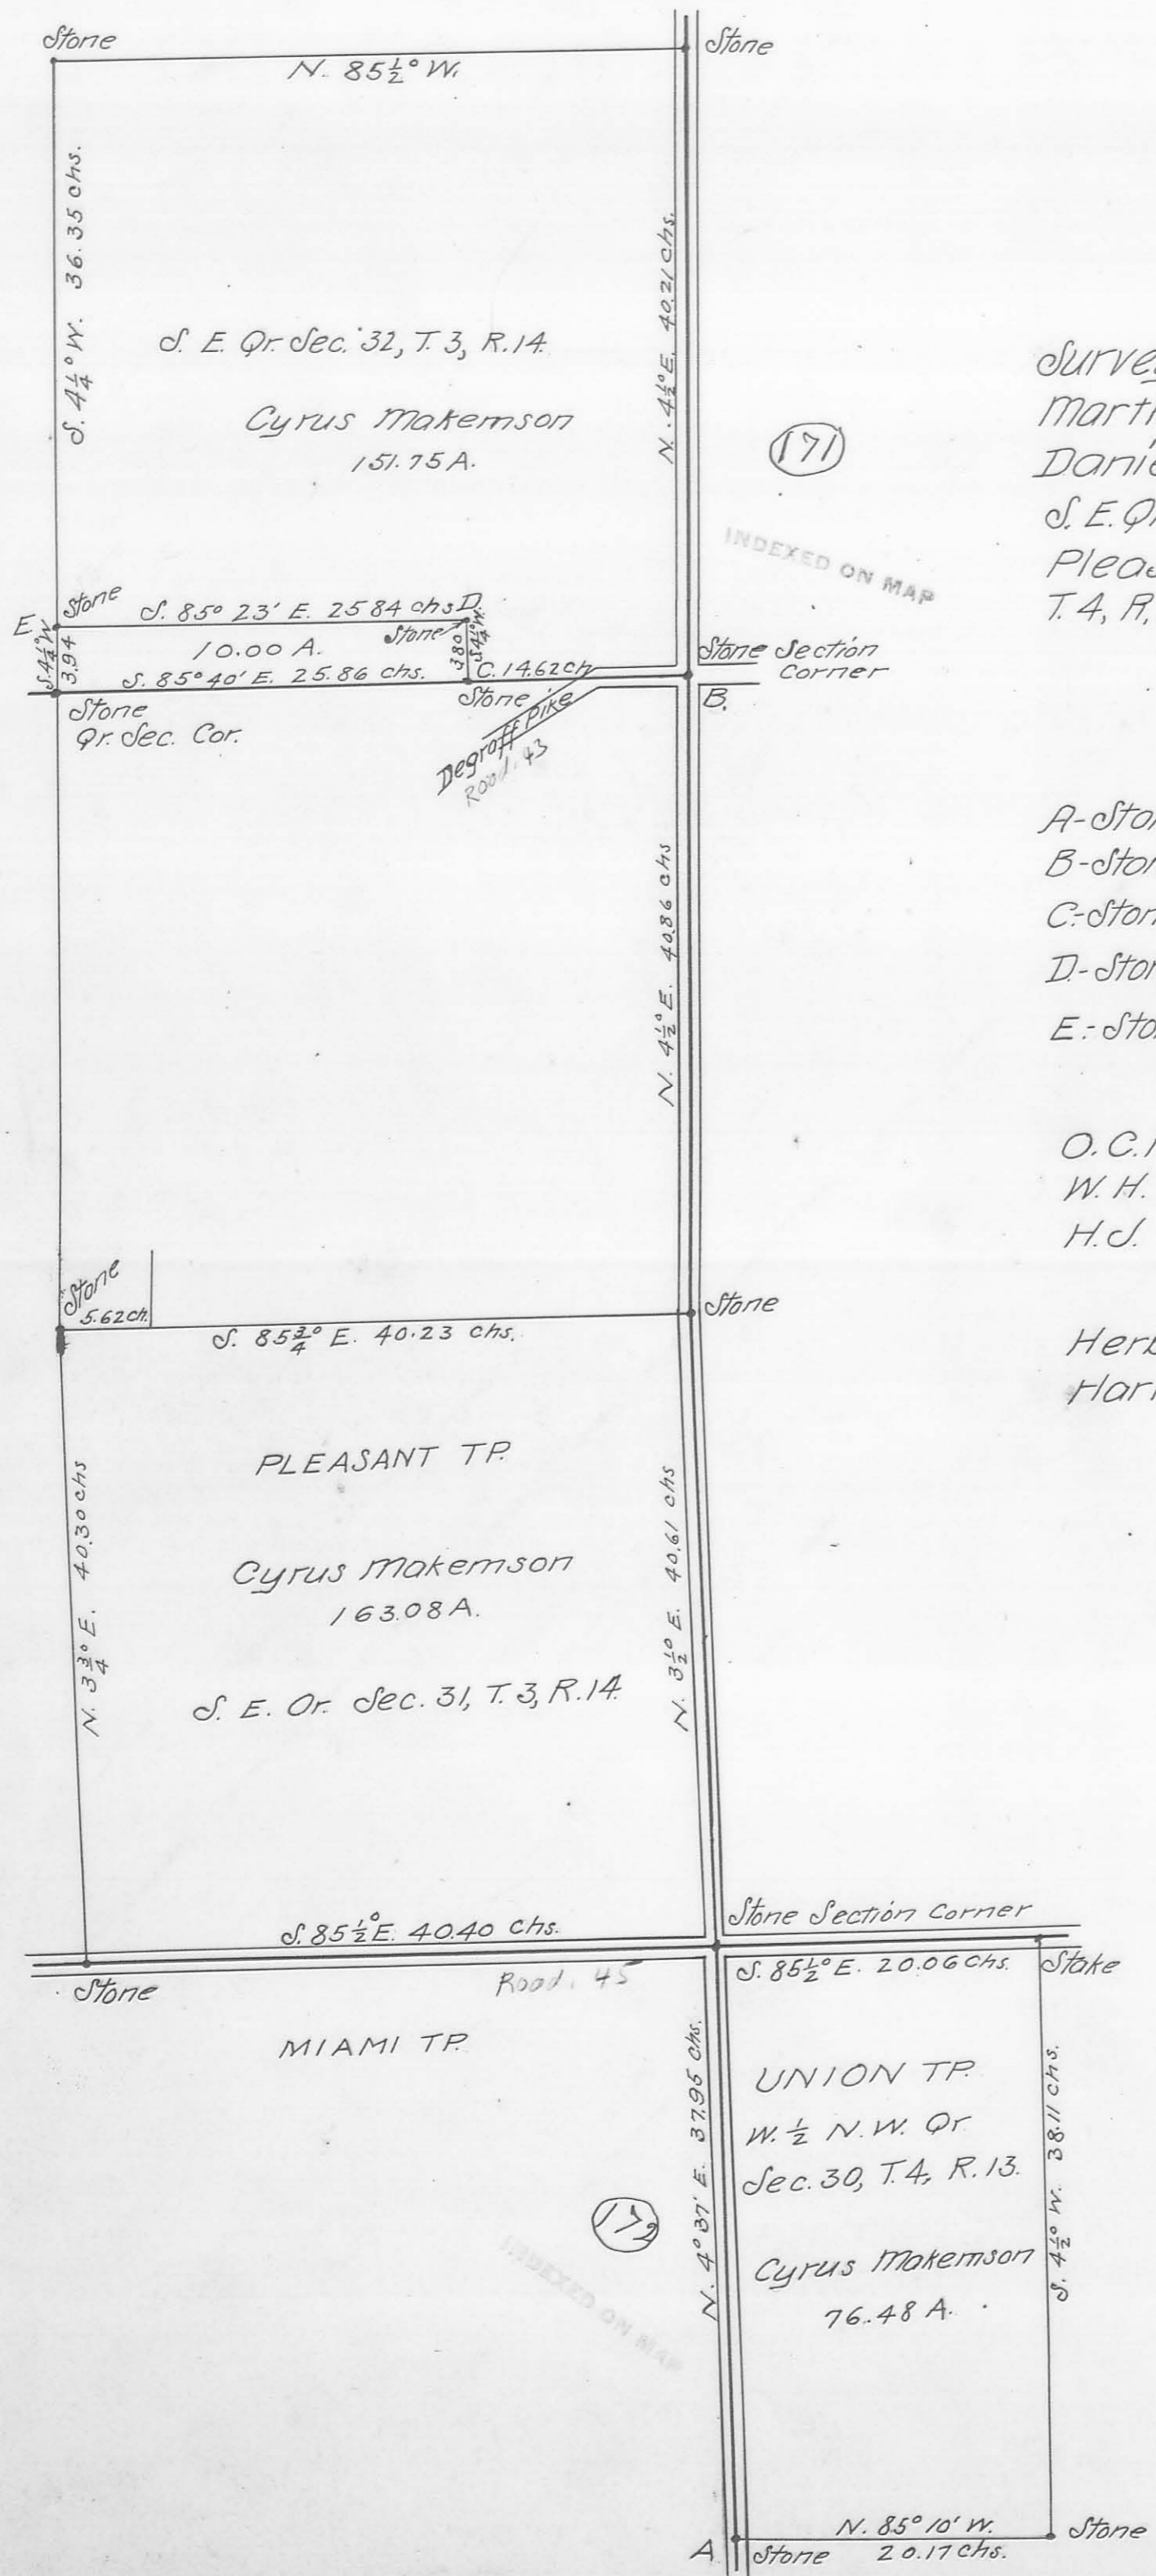

Surveyed for Partition Commissioners,
Martin Miller, Henry McKinnon and
Daniel W. Koch.

S. E. Qr. Sec. 31, 1/2 S. E. Qr. Sec. 32, T. 3, R. 14,
Pleasant Tp. 1/2 West 1/2 of N. W. Qr. Sec. 30,
T. 4, R. 13, Union Tp. Surveyed 14, 15 1/2 19, June 1907.

~Description of Corners~

- A - Stone, with five empty bottles.
- B - Stone 4ft. north of center of gravel on Degraff pike.
- C - Stone - Wit: Fence post 9 lks. north 3/4 12" Apple tree 18" S.E.
- D - Stone - Wit: 4" Peach tree 2ft. east 3/2 5" Apple tree 22 lks. S.E.
- E - Stone - 8" square on top, with pieces of drain tile.

O. C. Richey }
W. H. Tamplin } Chain Cr.
H. J. Tamplin }

Herbert Tamplin }
Harry Castle } Flagman



Scale: 1 in. = 10 chains

Charles M. Richey
County Surveyor

McMORRAN'S 1ST ADDITION

TO THE
VILLAGE OF McMORRAN

SEC. 30 T. 3 R. 14 HARRISON TP
SCALE: 1 INCH = 50 FT.

(173)
INDEXED ON MAP

Surveyed Sept., 1910, By O. C. Richey Asst. Co. Surveyor.

DENNIS MOORE
58.50 A.

MOORE AVE. N. 85° W.

178.2'

98'

60'

60'

132'

26'-20"

No. 9.

No. 8.

No. 7.

No. 1

HOUSE

J. E. & GRANT McMORRAN

132

No. 2

132

No. 3

132

No. 4

112 1/2

No. 5

61 1/2

No. 6

BRECONT STREET N. 4° 45' E.

FRANK B. CULP
78.75 A.

ELEVATOR

GRANT McMORRAN
1.81 ACRES.


OFFICE

ALICE MOORE
14.61 A.

McCAULLY BRIDGE PIKE N. 85° W.

ROBERT BRADEN
154. A.

- A. = 1/2" x 14" IRON BOLT
- B. = 1 1/4" x 18" IRON PIPE
- C. = 1 1/4" x 18" FOUND IRON BAR.

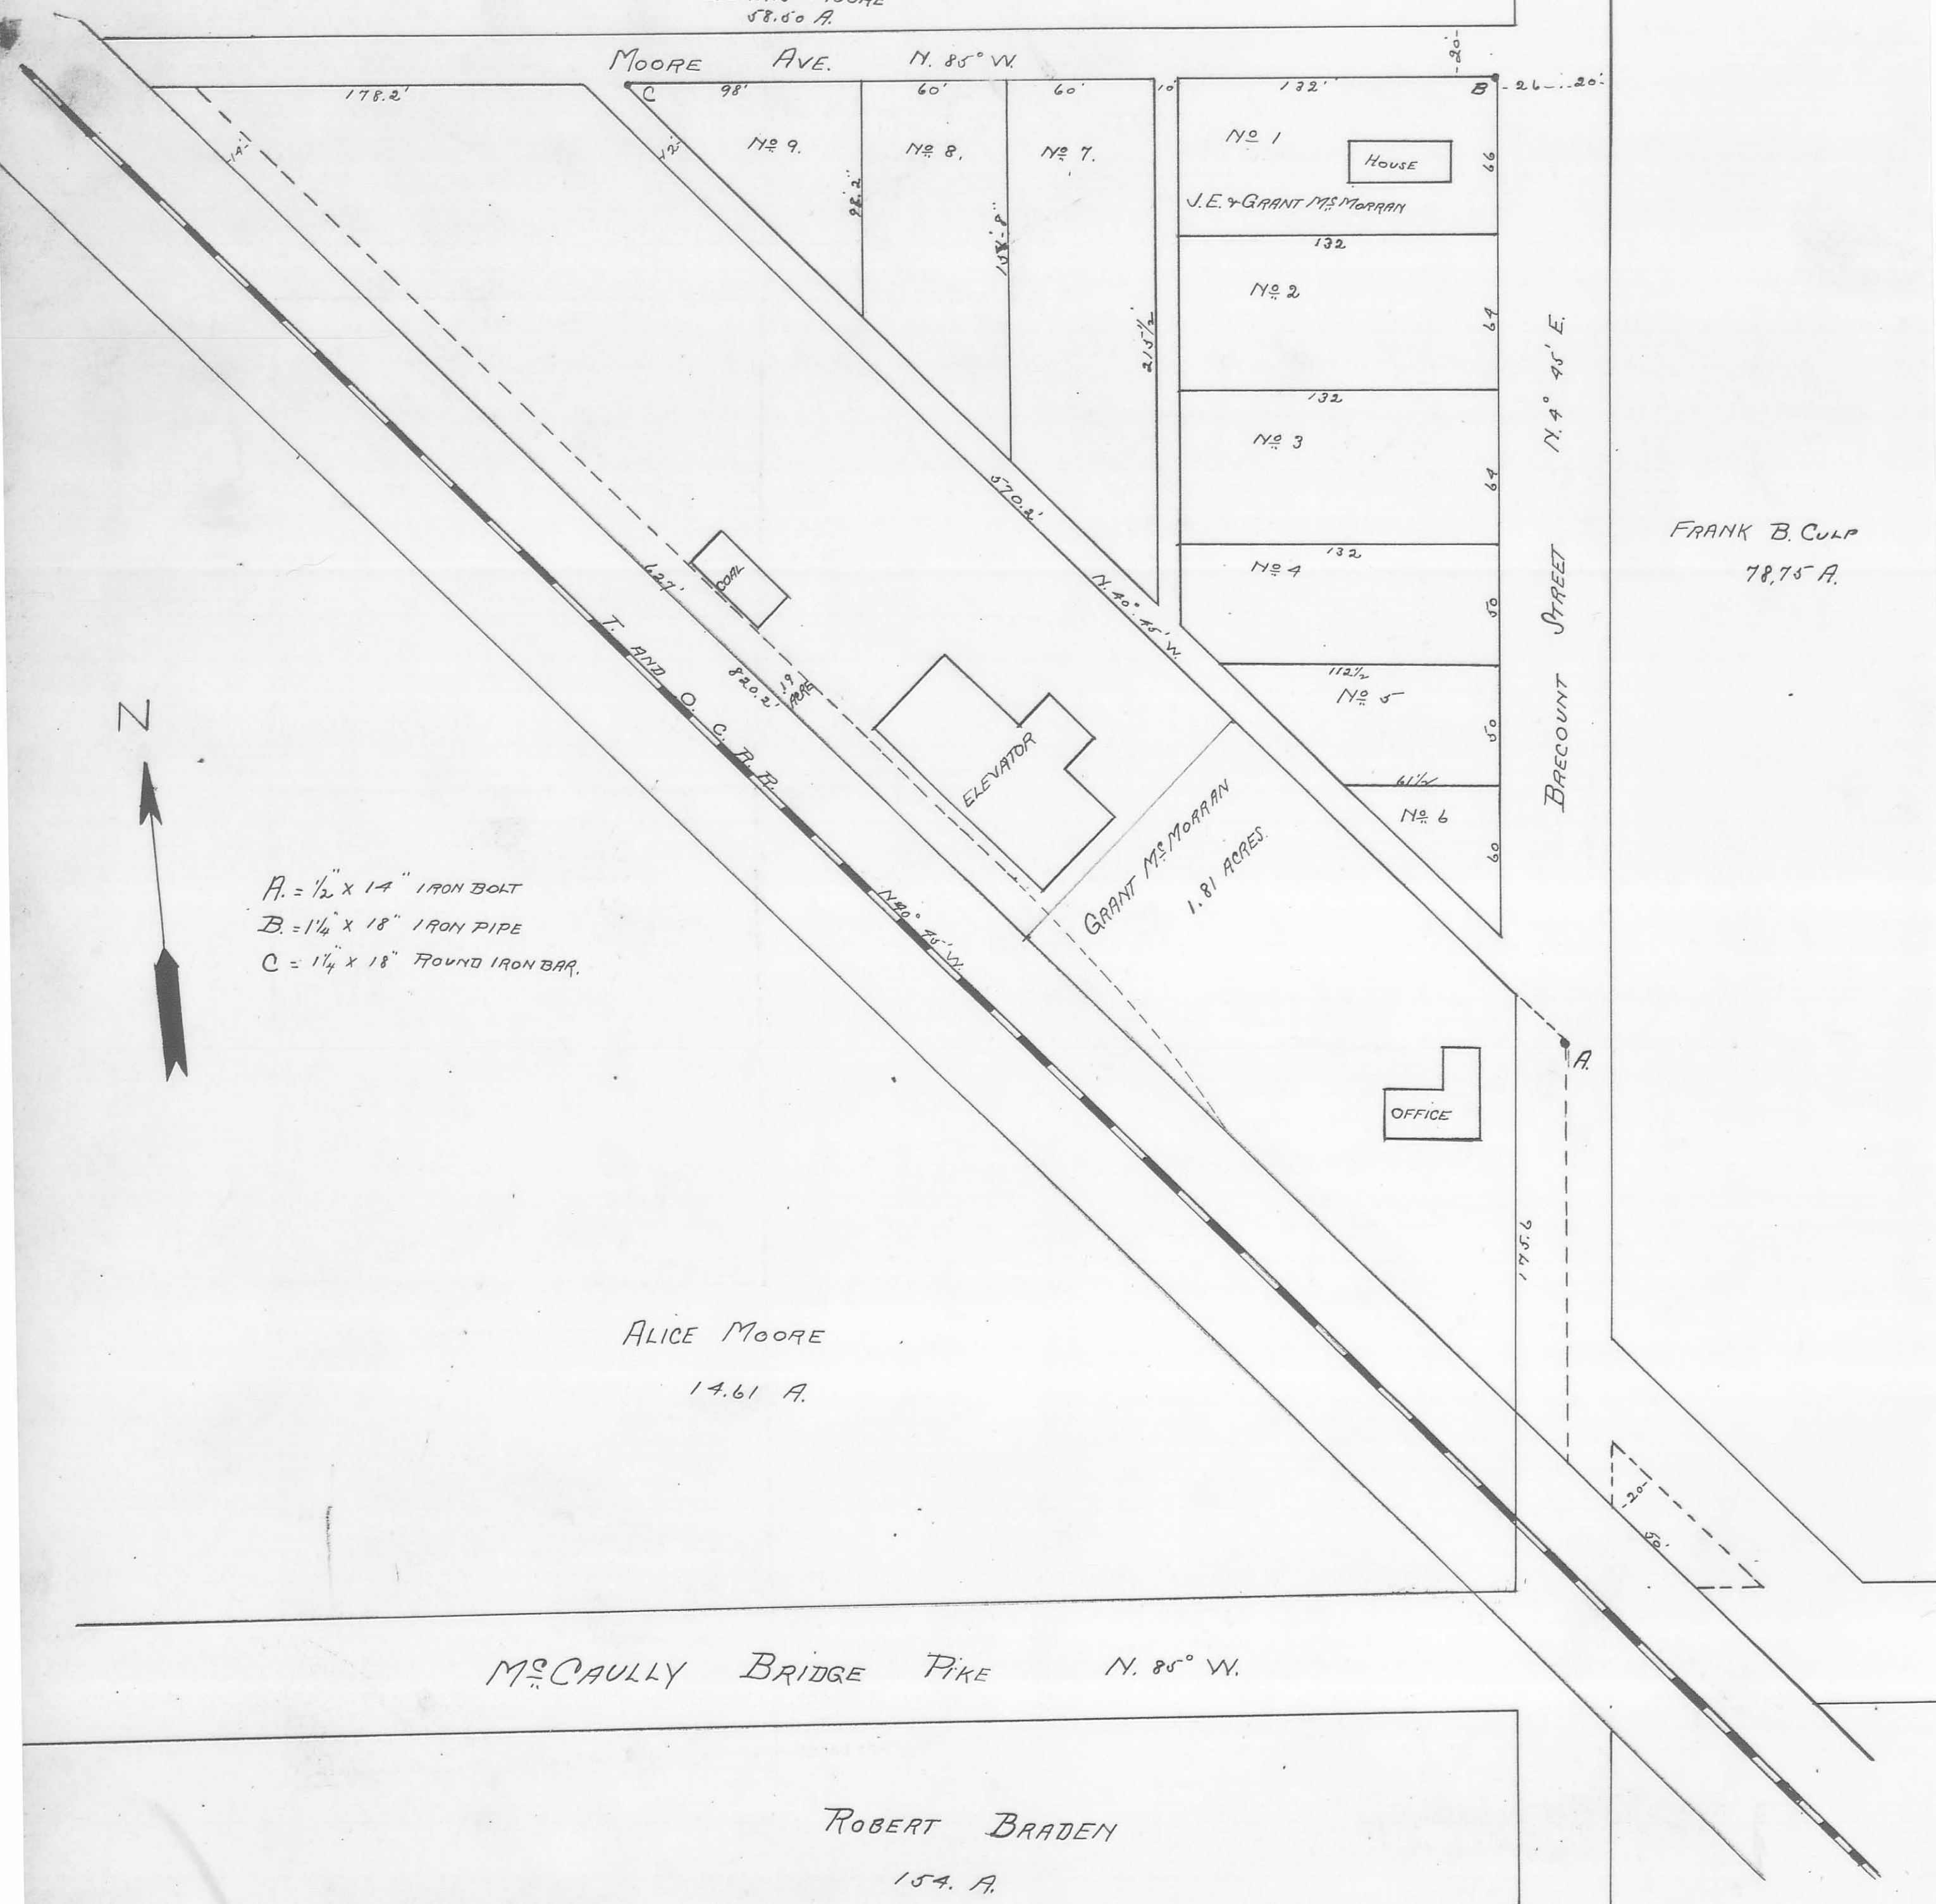


COTTAGE GROVE ADDITION


TO
LAKE VIEW, OHIO.

(174)

INDEXED ON MAP

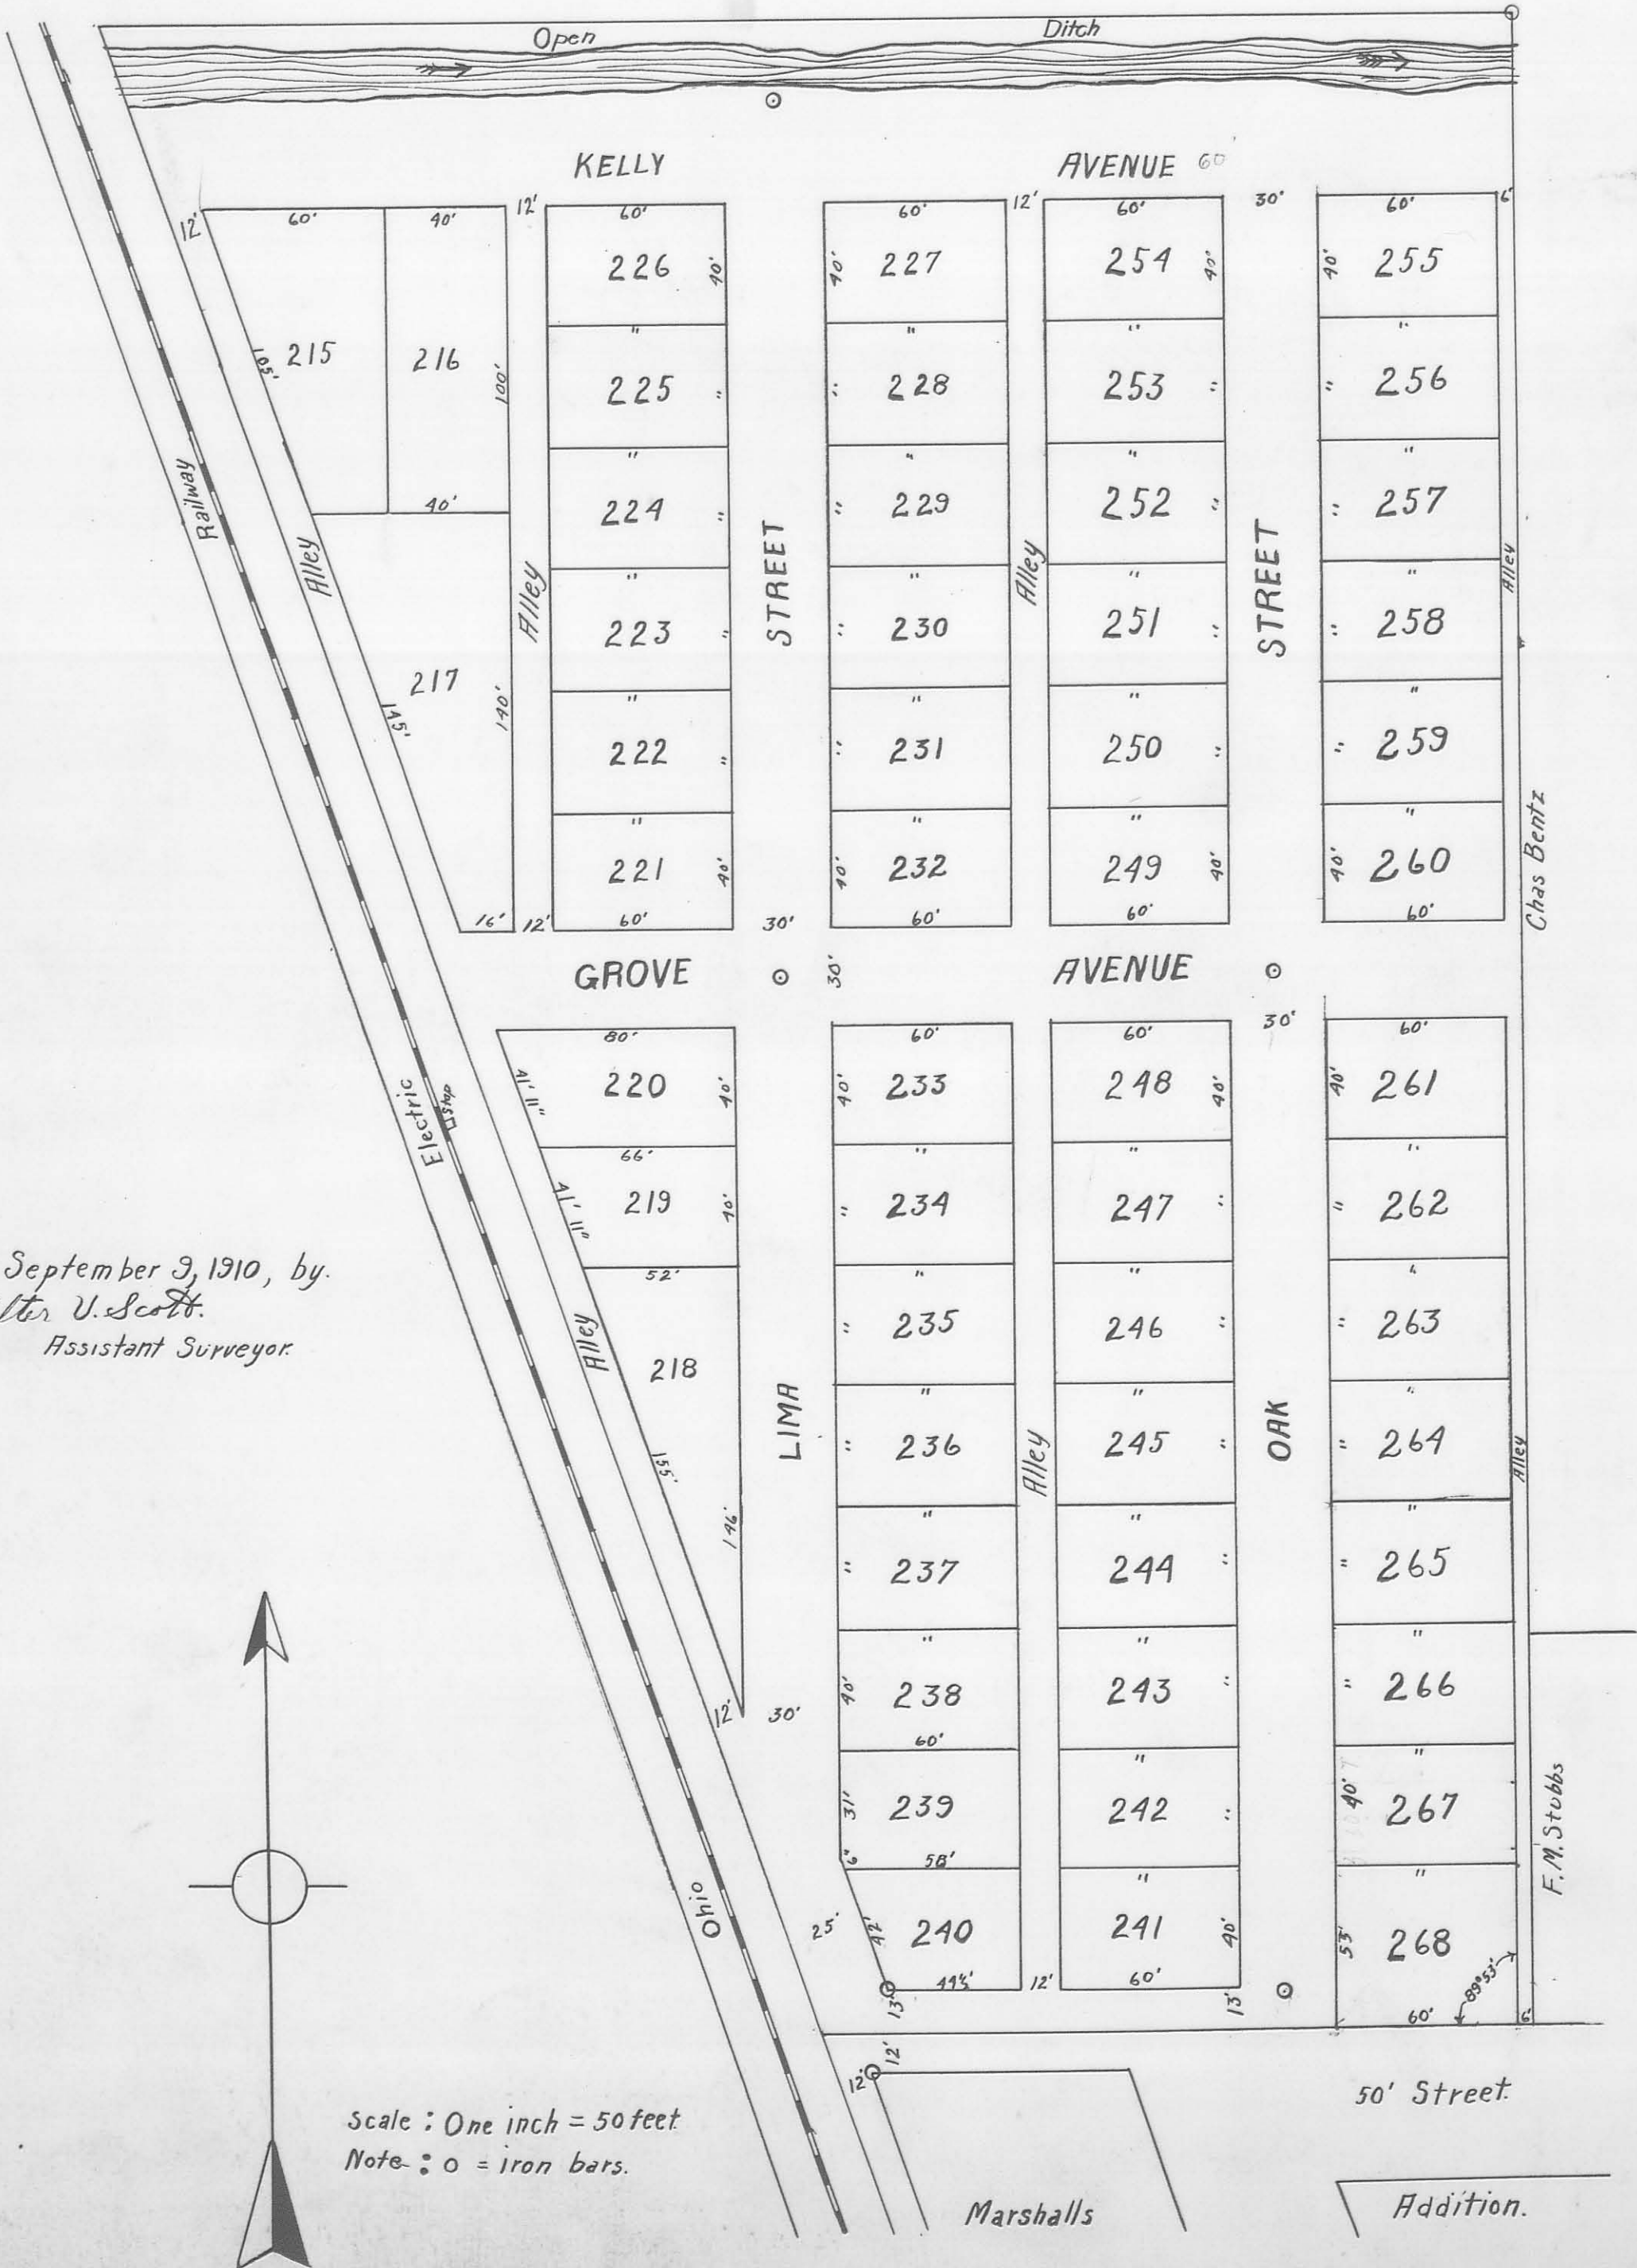

Surveyed September 9, 1910, by
Walter U. Scott.
Assistant Surveyor.

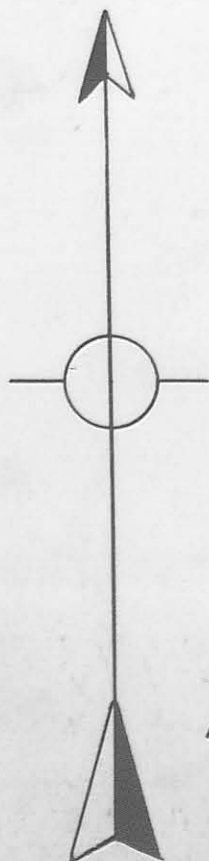

Scale: One inch = 50 feet
Note: o = iron bars.

50' Street.

Addition.

Surveyed for —
Harry W. Koogler

Part of Section 18, Town 3, Range 18,
Located in DeGraff, Logan Co. O.
SCALE: 1" = 60'

Survey Oct. 7, 1910.
H.S. Dailey, Depy. Co. Surveyor

(173)




Surveyed for —
Joseph Beckley

SCALE: 1" = 3 CHAINS. Oct. 18, 1910

State of Ohio

(176)
INDEXED ON MAP

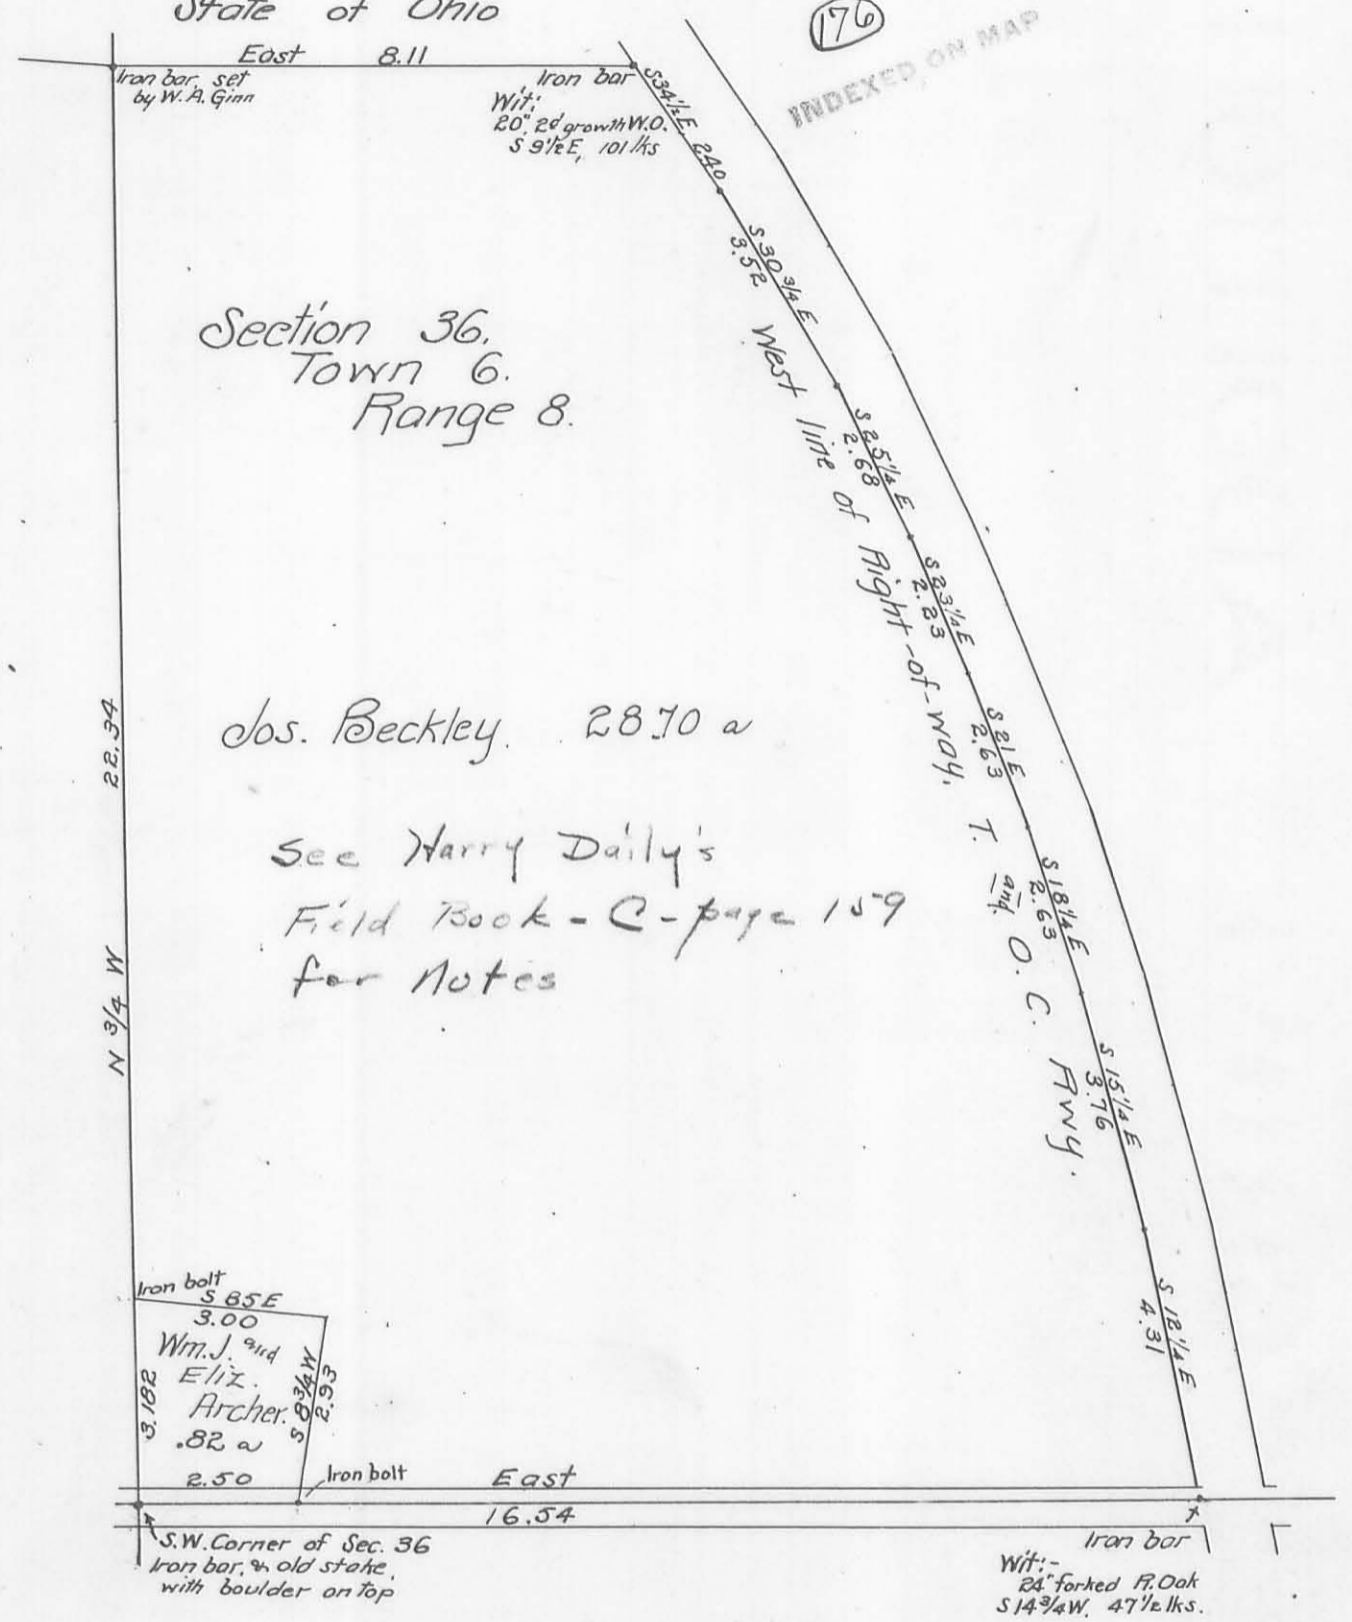

Ed. Snyder } ch. cr.
Clarence Dumm }
Harry S. Dailey, Depy. Co. Surveyor

Surveyed for -

L. E. Cordrey and J. A. D. McCulloch

Pt. Surveys 3220 and 6450. Jefferson Township, Logan Co. Ohio.

G. W. Godwin } Ch. crs.
Chas. Arbogast }

(177)
See Drawer R

J. A. D. McCulloch

Israel Kinney


L. E. Cordrey.
162.67 a

J. M. Small

E. T. Fawcett

Esther

McCulloch

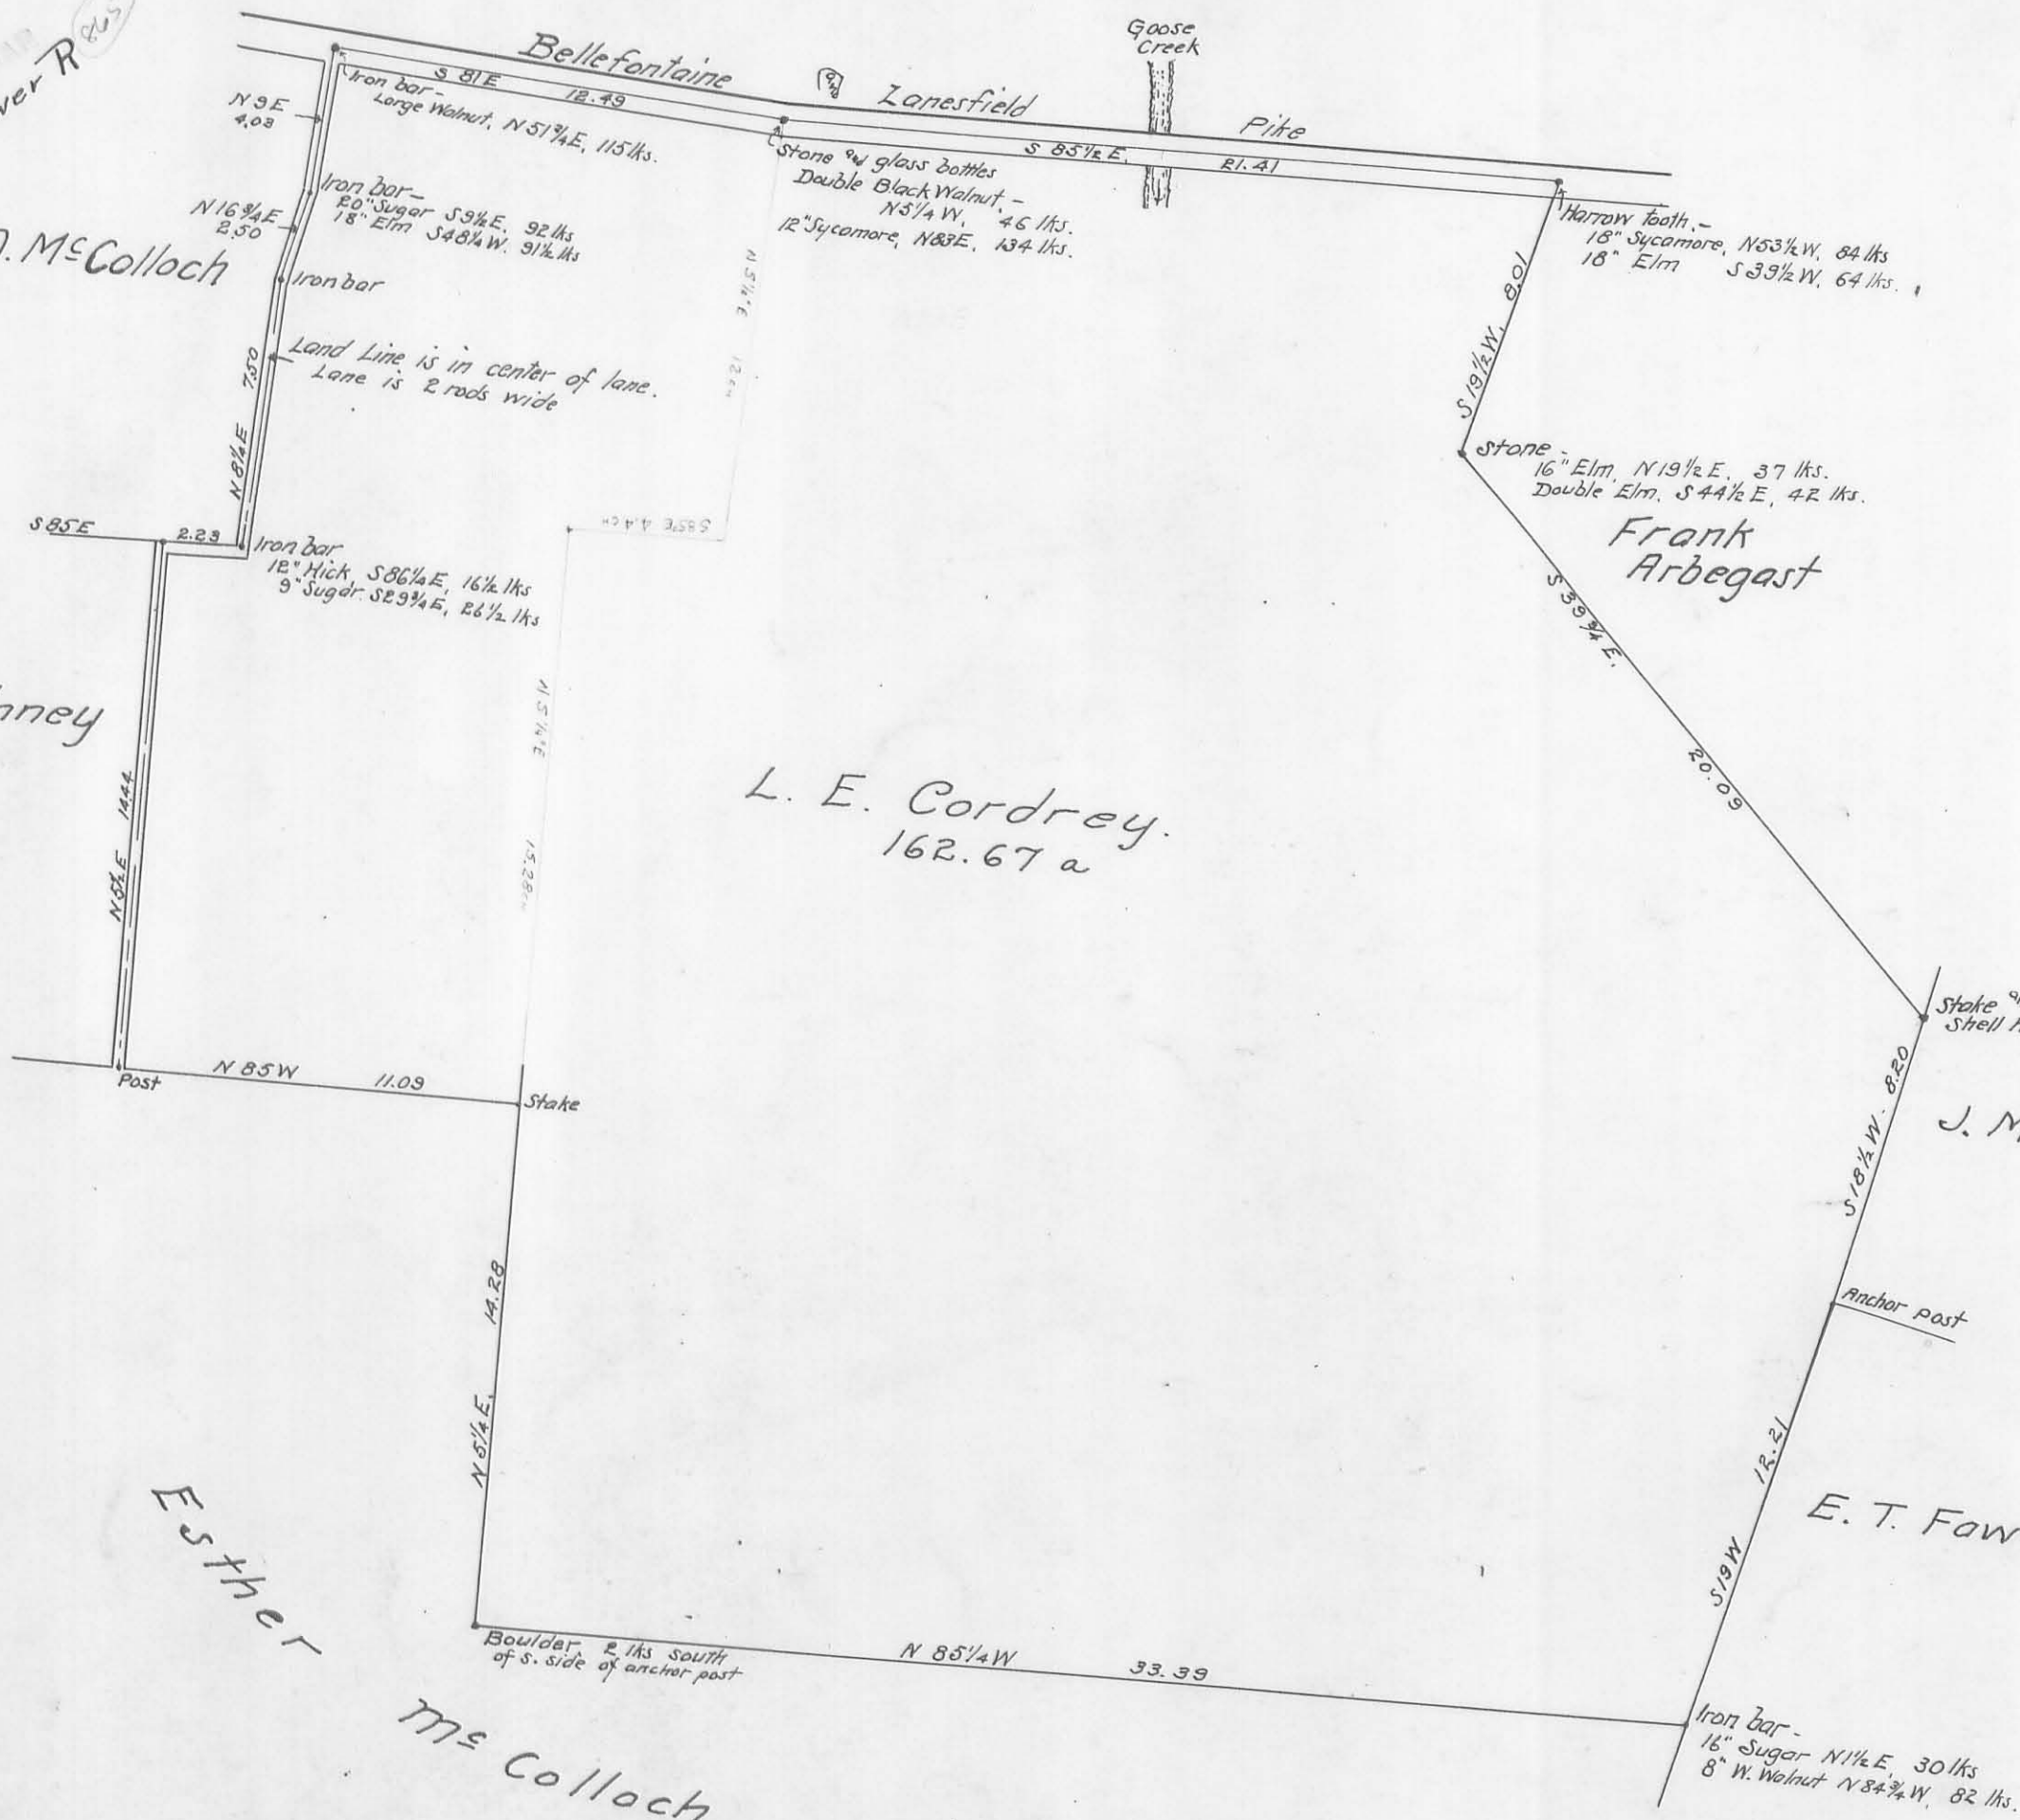

SCALE: 1" = 5 CHAINS

Surveyed as shown above
May 23, 25, & 26, 1911


Harry S. Dailey
Deputy County Surveyor

Surveyed for —
Heirs of E.S. Baughman.

Parts of Sections 29, 30 & 35, T.3. R. 13
Miami Township, Logan Co. Ohio

(178)
INDEX MAP

Earl Newell
J. S. Kroop
Wm. H. Bean
Elmer Douglas } Chain Carriers

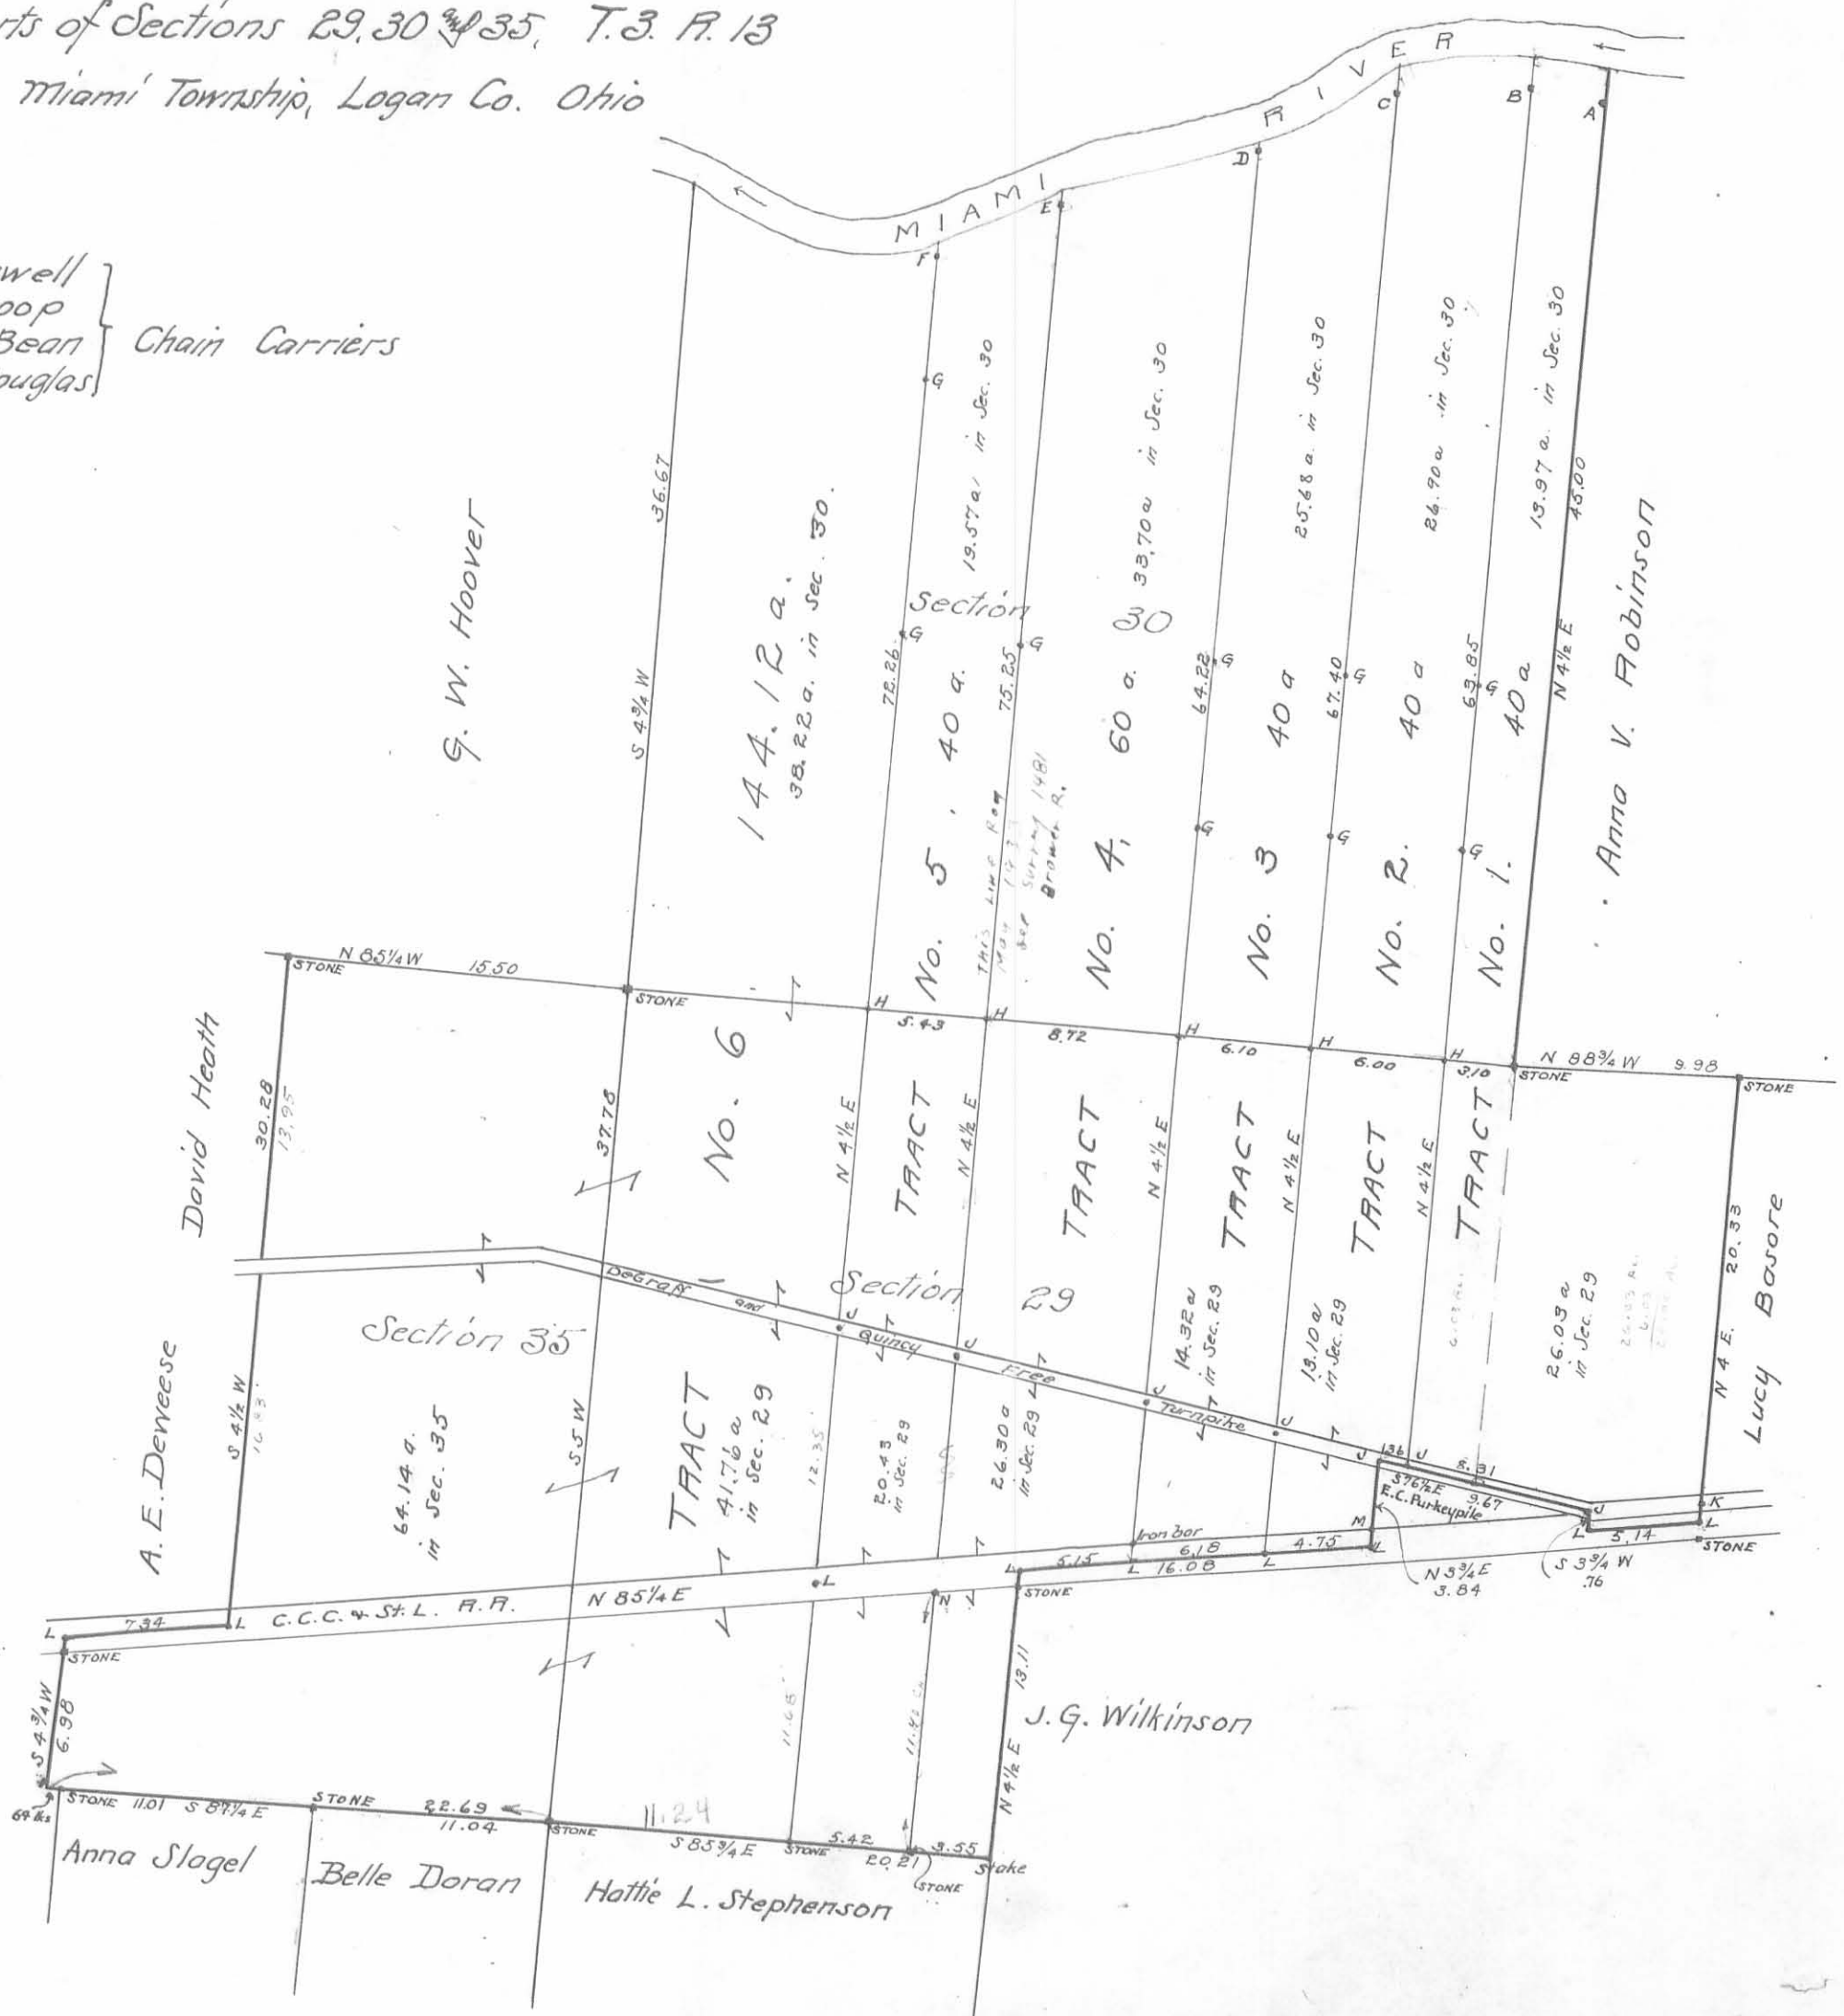

Description of Monuments.

- A. Line passes at east side of 30" hackberry
- B. - Stone - Wit: - 12" white walnut, N 60 1/2 W, 13 lbs
12" white elm N 19 3/4 E, 40 lbs
- C. - Stone - Wit: - 14" hackberry S 57 W 17 lbs
17" black hickory N 75 E, 22 lbs
- D. - Stone - Wit: - 13" white elm N 41 E, 16 lbs
10" black hickory N 50 W 6 lbs
- E. - Stone - Wit: - 26" sycamore N 21 1/2 E 84 lbs
17" white elm N 22 W 68 lbs
- F. - Stone - Wit: - 18" sugar N 25 E 51 lbs
22" black walnut S 25 1/2 E 80 lbs
- G. - Iron bars in line
- H. - Iron bars near Section line
- J. - Iron bars in center of DeGraff & Quincy Free Turnpike
- K. - Stone in center of pike
- L. - Iron bars in center of C.C.C. & St. L. R. R.
- M. - Stone in north line of rt-of-way

Scale of Plot, 1 inch = 8 chains

Total acreage by Sections

Section 29 =	141.94 acres
" 30 =	158.04 "
" 35 =	64.14 "
Total, Entire estate =	364.12 "

Surveyed as shown above.
July and August 1911

Harry D. Daily
Deputy County Surveyor