


We, the commissioners of Logan County, hereby certify that this is a true and correct copy of the county highway system of Logan County as previously approved by the director of highways, except that in addition it also shows revisions outlined with colored pencil which we do hereby submit to the director for approval.

 County Commissioners of
 Logan County

Approved _____ Date _____
 Director of Highways

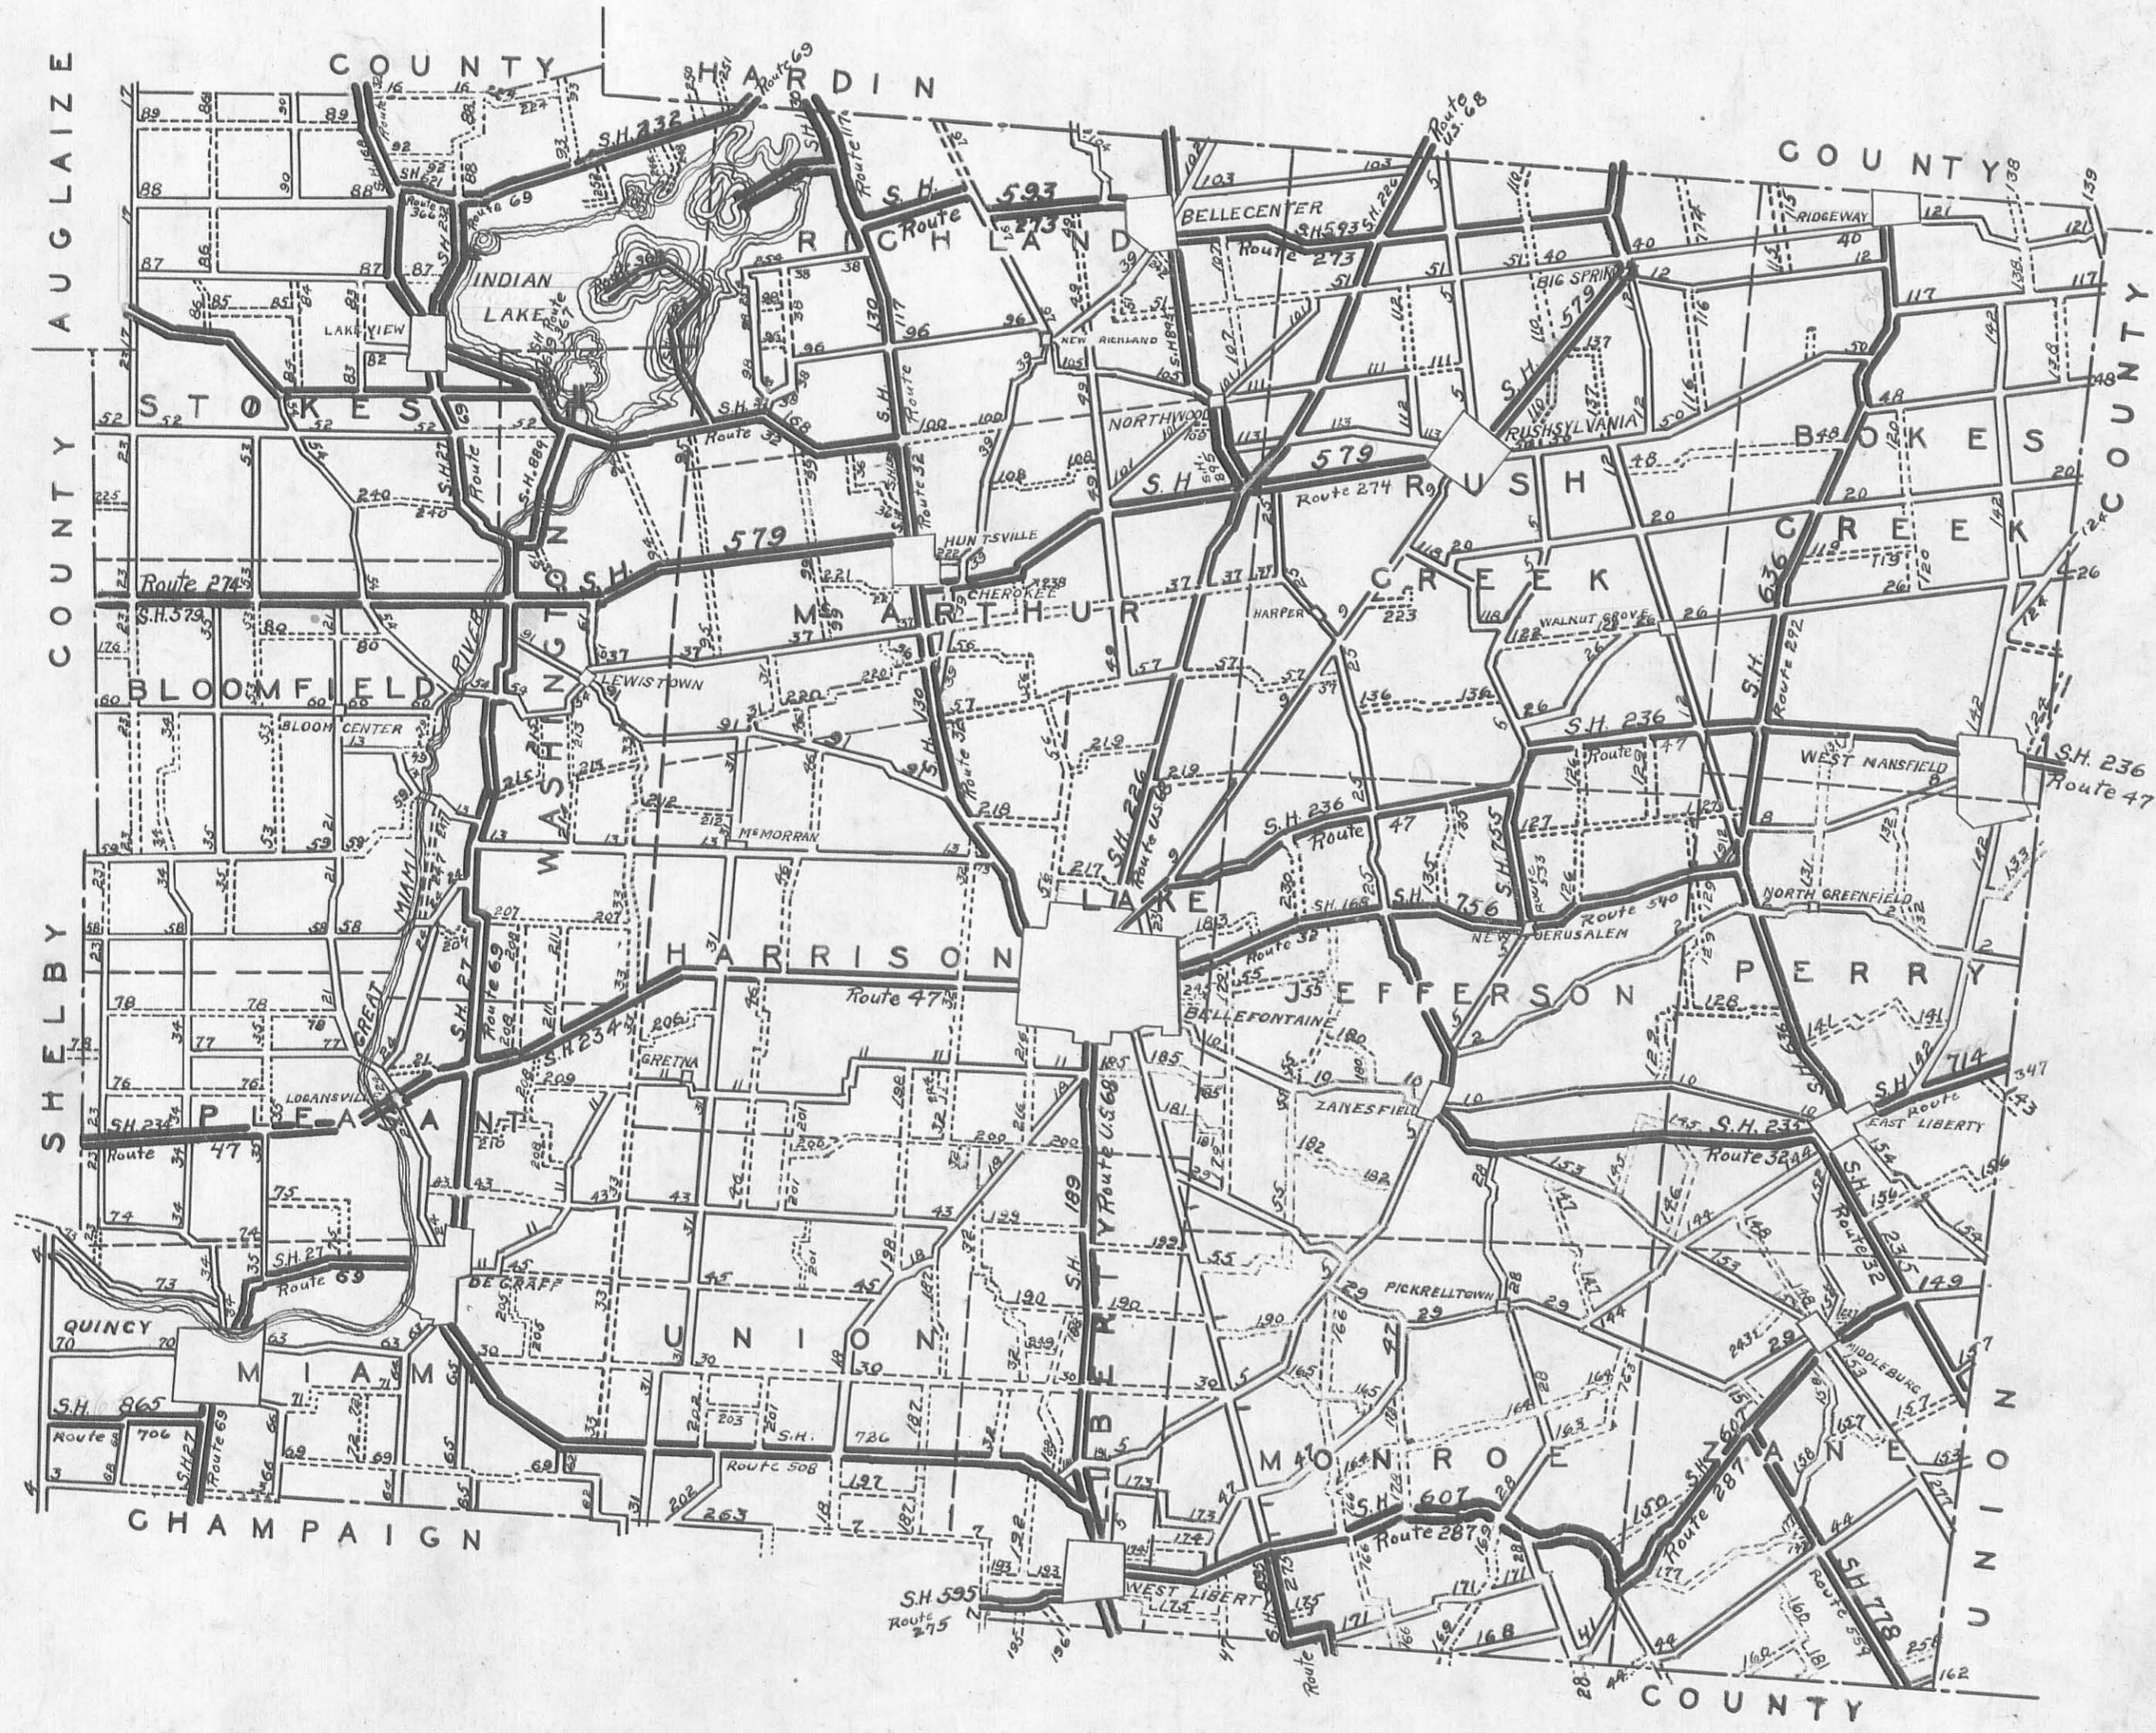

- TOWNSHIP
- BOKESCREEK
 - BLOOMFIELD
 - HARRISON
 - JEFFERSON
 - LAKE
 - LIBERTY
 - MARTHUR
 - MIAMI
 - MONROE
 - PERRY
 - PLEASANT
 - RICHLAND
 - RUSHCREEK
 - STOKES
 - UNION
 - WASHINGTON
 - ZANE

MILES

LEGEND

- STATE HIGHWAYS
- COUNTY HIGHWAYS ON SYSTEM
- COUNTY HIGHWAYS BEING ADDED
- COUNTY ROADS BEING REMOVED
- OTHER ROADS

MAP OF
 COUNTY HIGHWAY SYSTEM
 OF
LOGAN COUNTY
 SCALE: 1 INCH = 2 MILES
 1936

DRAWN BY J. MONTGOMERY