

DeGraff Road, # 256
Miami Township

Sec 12-T & R. 13

stakes placed 20' from &


7+96 & C.C.C. 957.4.

1306
INDEXED ON MAP

Aug-6-1930


25

cloudy
wright
bridge.

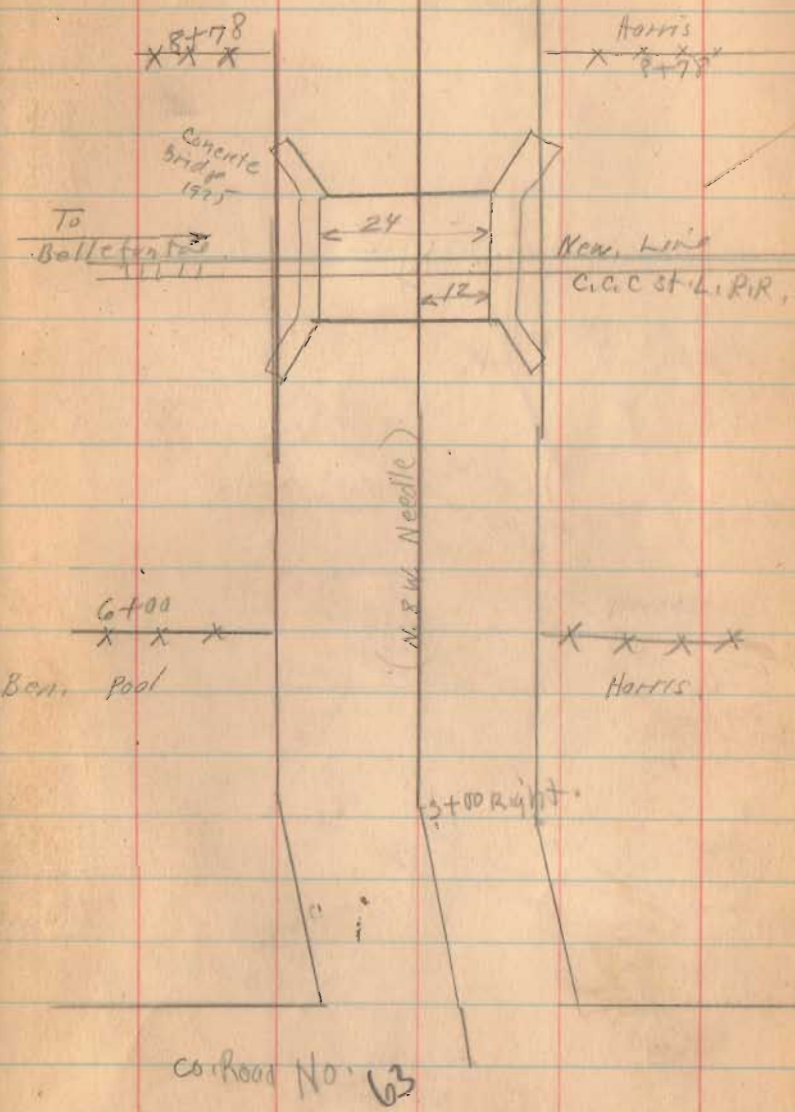


Road # 256

steel span pony truss
Wood Floor
stone abts

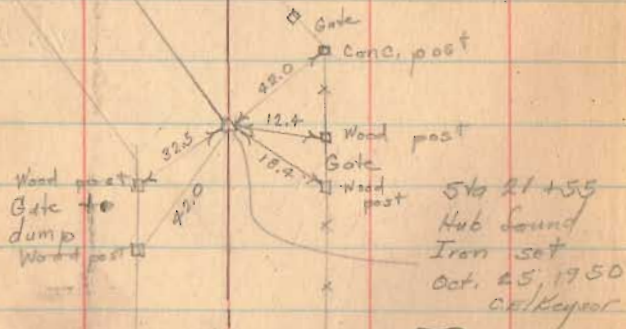


1306
INDEXED ON MAP

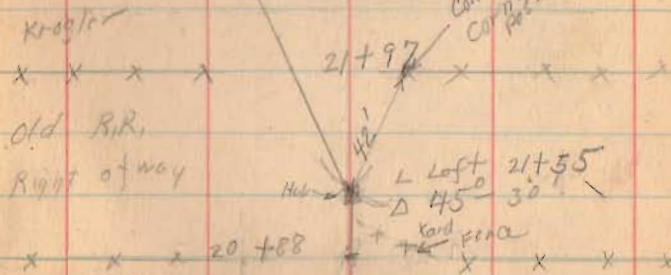

D = 32.0
T = 96.0
E = 15.28
R = 181.90



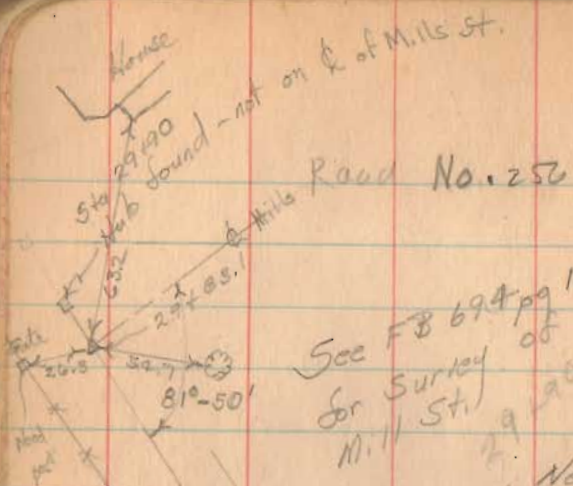


See FB 694 pg 1
for Survey of
Mills St.

New notes
Oct. 26 1952
CRK

Sta 26+56
Dug for hub,
no luck.
Set iron
42°-15' left

1306
INDEXED ON MAP

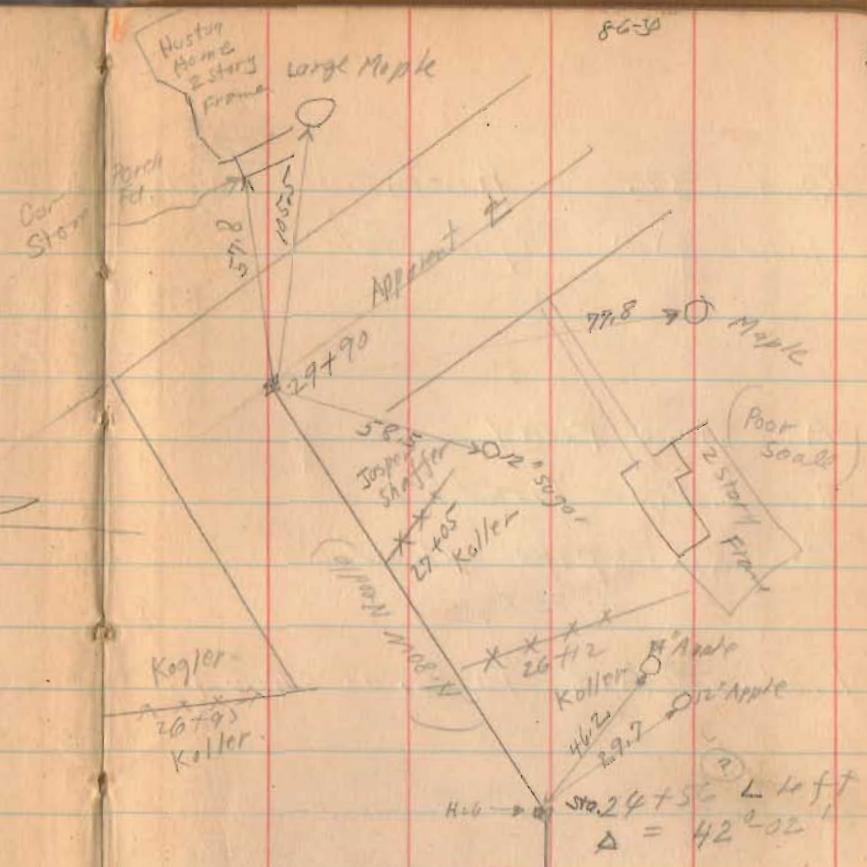

$\Delta = 42^{\circ} 02'$
D = 32°
E = 12.92
T₁ = 49.60
R₁ = 181.40

