


Indian Lake

Spillway at Indian Lake

Flat part on top of wall 3' wide

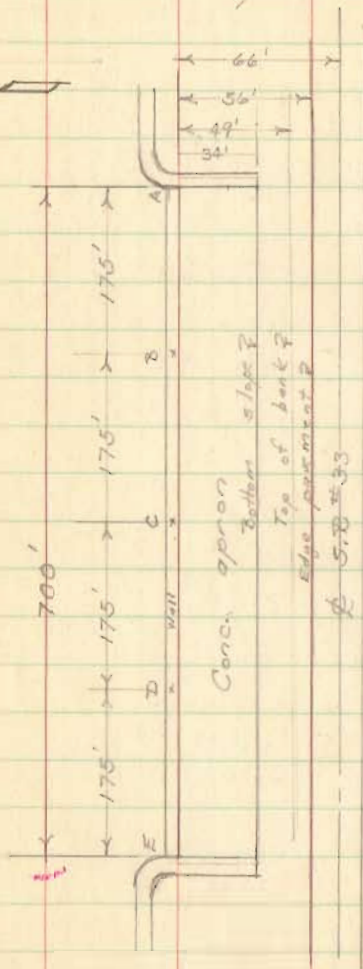


Oct. 22, 1953

C. Meyson

D. Dodson

T. Richardson

20

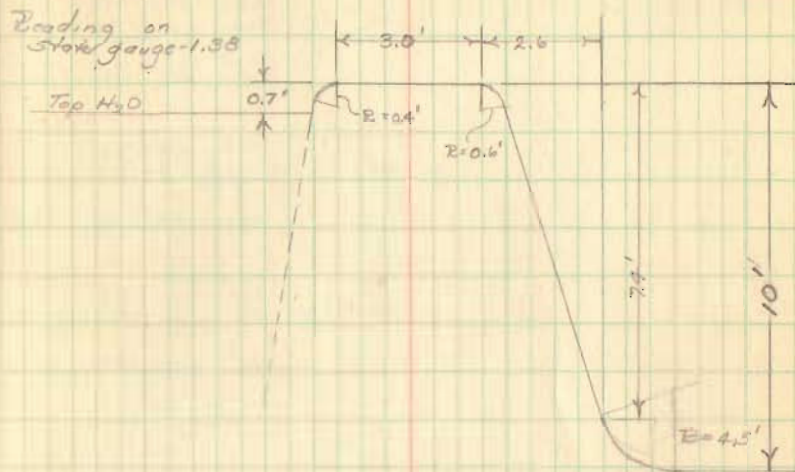

Cross-section Wall
at

INDEXED ON MAP

4381