

	Dist	Az	Description
Inst at (G)			
1	42'	256-10	Fence on Lt. Cor.
2	35'	218-35	Fence Rt.
3	38'	55-30	" Rt. Cor
4	90'	15-30	" Rt. Cor
5	128'	2-20'	" Lt in corner

Ex 8.0'

Ex 1.0'


Dist Fence Lt 23'

Dist Fence Rt 18'

Dist Fence Lt 23'

Dist Fence Rt 5'

Ex 6.6'

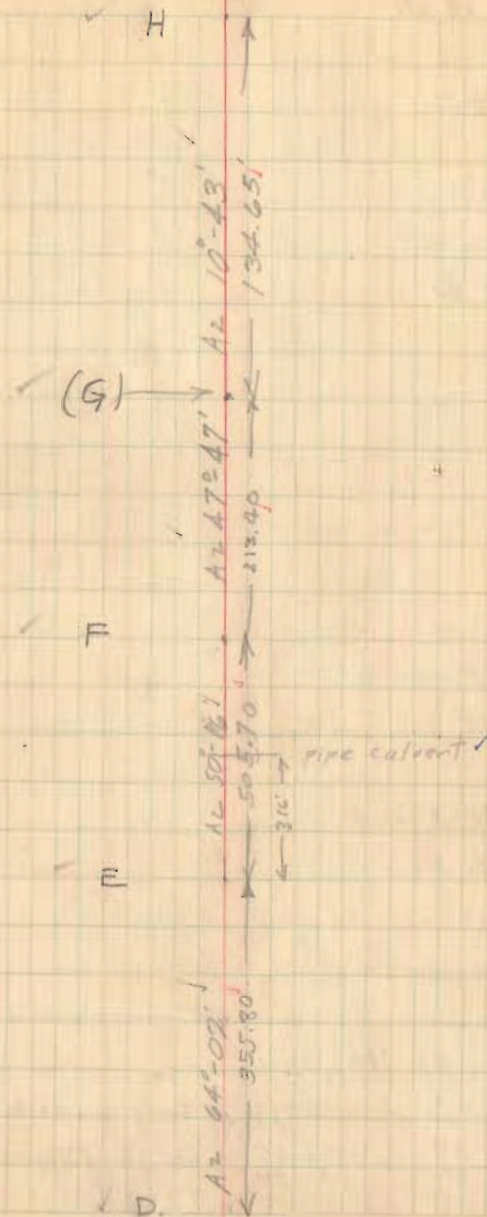

Fence Rt. 10'

Fence Lt. 36'

Ex 4.0'

Ex 4'

Fence 26' Rt

Fence 8' Lt.

7' Fence Rt

20' Fence Lt

Ex. 2.0'

15' Lt to Fence


16' Rt to Fence

Ex = 0.6'

Inst. at [H]

dir	Az	Description
23	160-10	Cor. in fence Rt.
27	103-55	Cor. in fence Rt.
64	86-40	Fence Rt.
34	60-10	Fence Lt.

Description  
 Cor. in fence Rt.  
 Cor. in fence Rt.  
 Fence Rt.  
 Fence Lt.

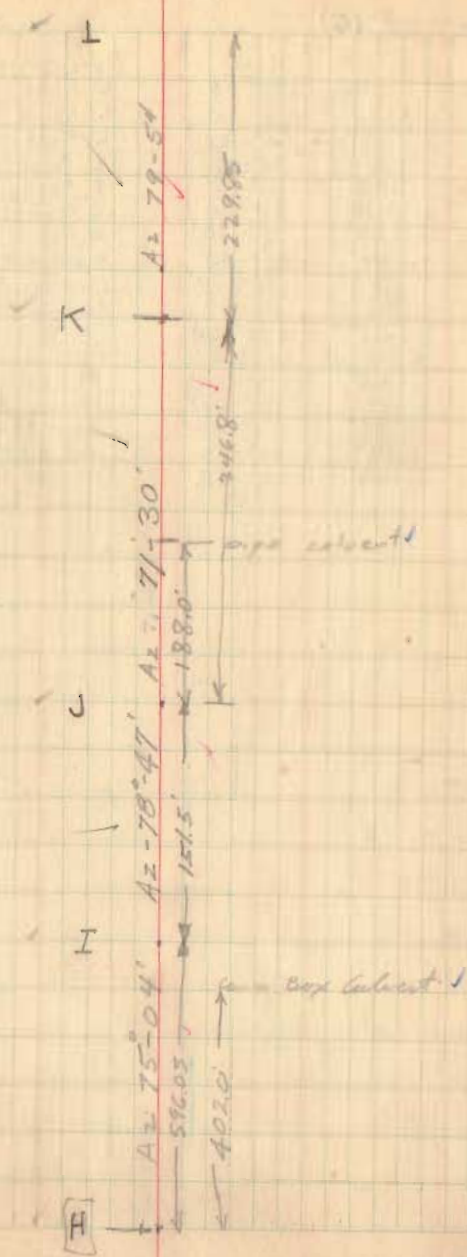

Inst at (0)

Dist	Az	Description
1 62	255-25	E Road
2 26	262-15	E Road
3 12	4-30	E Road
4 51	37-30	E Road
5 82	21-15	E Road
6 103	16-40	E Road
7 138	9-20	E Road
8 30	247-40	Fence Rt.
9 89	36-20	Fence Rt.
10 121	21-50	Fence Rt.
11 69	271-10	Fence Lt.
12 18	342-10	Fence Lt.
13 34	13-30	Fence Lt.
14 61	21-00	Fence Lt.
15 98	12-30	Fence Lt.
16 86	203-05	cor of House North Cor
17 165	241-45	Cor of Barn.

Fence 21 Lt

Fence 26 Rt

Ex. 0.5'


Fence 11 Lt

Fence 11 Lt

Ex 30



(Note - Road should be kept to Lt. of Present E around this curve.)

V (0)

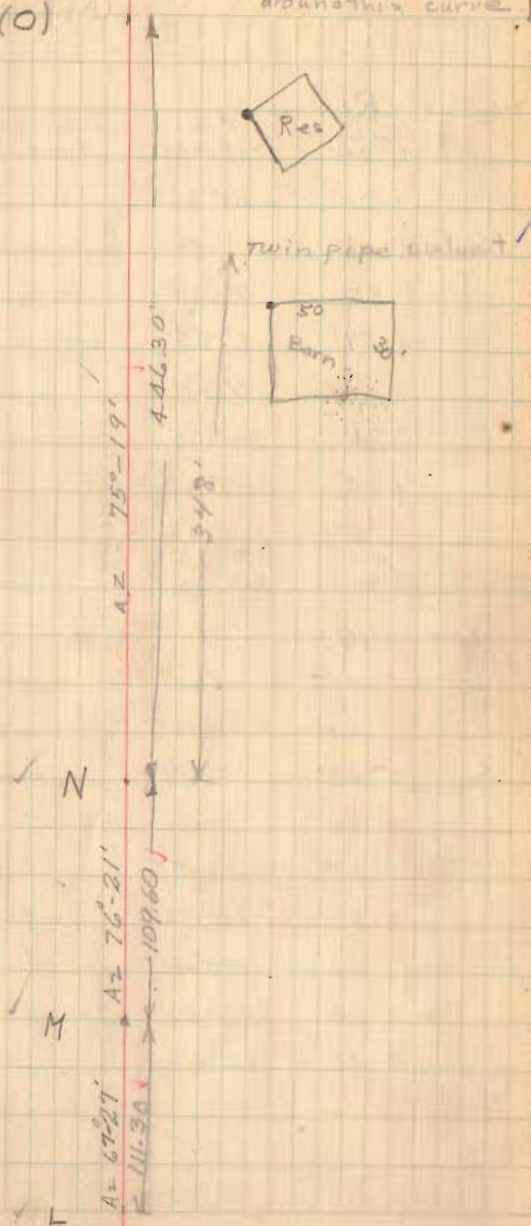


Inst at (R)	Dist	Az	Description
1	34'	180°-35'	Fence Right ✓
2	30'	28°-25'	" " ✓
3	106'	17°-50'	Corner Fence Rt. ✓
4	105'	8°-45'	⊥ Road ✓
5	59'	6°-25'	" " ✓
6	9'	0°-20'	" " ✓
7	31'	201°-56'	" " ✓
8	64'	202°-35'	
9	174'	263°-40'	Corner of Church ✓
10	45'	275°-35'	" " " ✓
11	70.5'	307°-10'	" " " ✓

Inst at (Q)	Dist	Az	Description
1	53'	125°-35'	Fence Rt. ✓
2	40'	57°-55'	Fence Pt. ✓
3	82'	33°-20'	" Rt. ✓
4	79'	22°-35'	⊥ Road ✓
5	33'	24°-05'	⊥ Road ✓
6	46'	159°-45'	⊥ Road ✓
7	34'	180°-50'	Fence Lt. ✓
8	40'	343°-30'	Fence goes straight on past South side of Church ✓

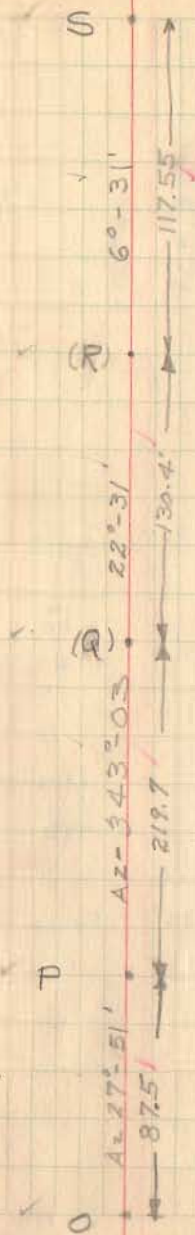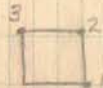

Ex 12'  
 Fence 2° E  
 Fence 27° RT

Inst of (S)	Dist	AZ	Description
1	24'	182° 05'	2 Road
2	9'	69° 20'	" "
3	42'	71° 25'	Fence Right
4	43'	162° 35'	" "

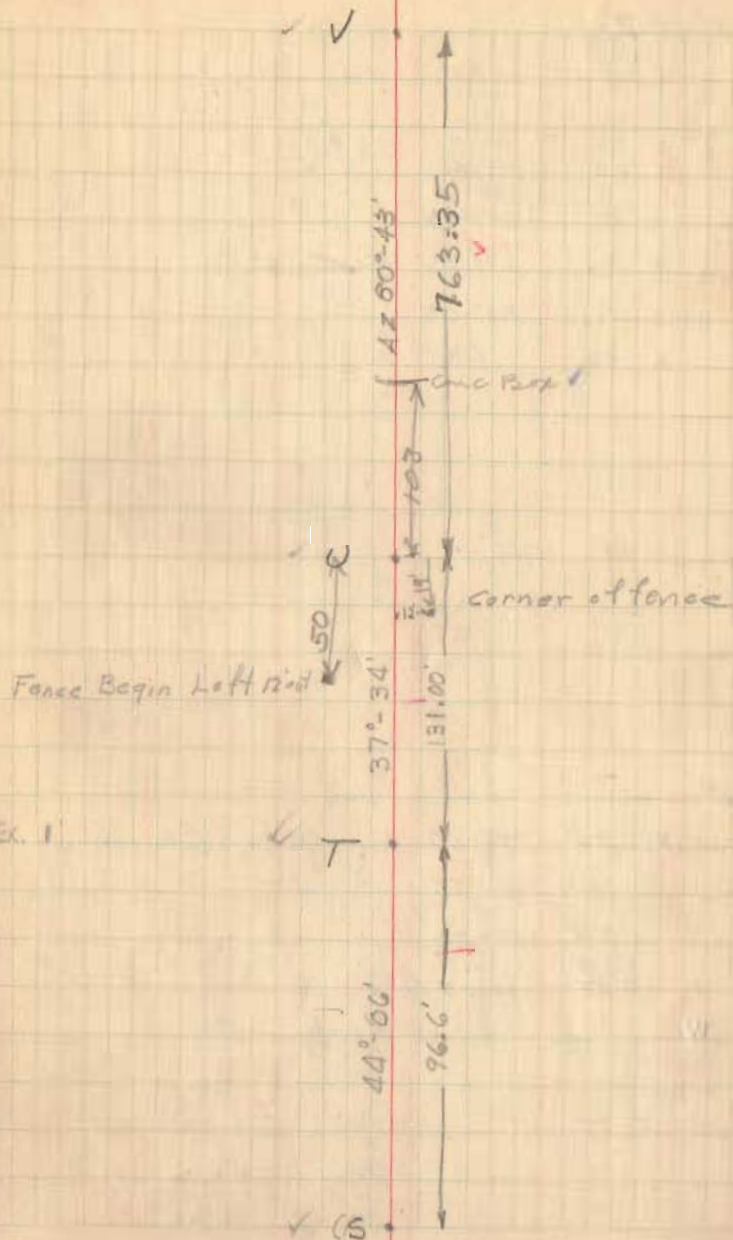

Ex. 1

Inst at (Z)

Dist	Az	
1. 54	245-30	Fence Rt ✓
2. 19	220-30	" " ✓
3. 98	130-10	" " ✓
4. 83	121-50	& Road ✓
5. 48	121-40	" " ✓
6. 9	149-20	" " ✓
7. 20	249-40	" " ✓
8. 52	272-35	Fence Lt ✓
9. 11	357-05	" " ✓
10. 55	111-30	" " ✓

Fence Rt 10.5'

" Lt 15'

Ex = 1.0'

Ex 20'	Dist	Az	Desc
Inst at (X)	1. 24	243-20	Fence Rt Beginning!
	2. 14.5	148-55	" Rt
	3. 28	126-25	" Lt
	4. 34	62-15	" Lt + curv of Bridge
	5. 23	294-05	⊙

(W)


Fence Lt 8'

Ex = 3.0'

Fence Rt 17'

Inst at (V)

Dist	Az	Desc
1. 28	66-00	End Fence Lt
2. 29	85-15	Go Bridge
3. 26	108-25	⊙

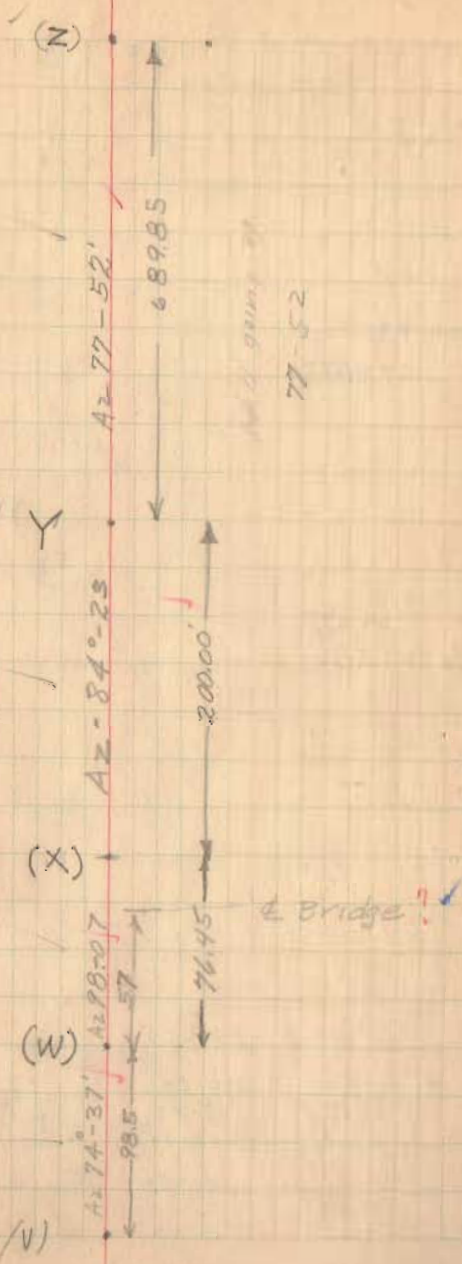

Ex = 40'

Fence Rt 9'

" Lt. 17

Fence Rt 17

" Lt 13

Ex = 20'

inst of (A)

1. 13'	254.50	Fence Rt.
2. 24	114.55	" "
3. 12	75.00	1/2 Road
4. 13	314.41	2 "
5. 21	346.25	Fence Lt.
6. 43	92.45	" "
7. 61	72.45	" "

Fence goes back on Left with Drive

E<sub>1</sub>

D<sub>1</sub>

C<sub>1</sub>

B<sub>1</sub>

A<sub>1</sub>

Z



Inst. at (H) I		
Dist.	Az	Desc.
1. 60'	207-35	Q Road ✓
2. 44'	232-50	Fence Lt. ✓
3. 45'	47-30'	Q Road ✓
4. 45'	35-25	Fence Lt. ✓
5. 57'	56-30	Seg. of fence ✓
6. 96'	53-35	Rt. ✓
7. 96'	46-40	Q Road ✓

Ex = 50'

Inst. at J		
Dist.	Az	Desc.
1. 78'	227-10	Q Road ✓
2. 69'	216-50	Fence Rt. ✓
3. 49'	243-45	Fence Lt. ✓
4. 32'	197-50	Fence Rt. ✓
5. 20'	272-55	Fence Lt. ✓
6. 20'	266-30	Q Road ✓
7. 24'	93-5'	Q Road ✓
8. 59'	96-15'	Fence Rt. ✓
9. 43'	68-18'	Fence Lt. ✓
10. 97'	78-00	Q Road ✓

Ex = 12.0'

Inst. at G H

Dist.	Az	Desc.
1. 147'	253-15	Q Road ✓
2. 97'	252-00	" ✓
3. 89'	261-10	" ✓
4. 27'	11-45	" ✓
5. 83'	25-40	" ✓
6. 97'	10-05	Fence Lt. ✓
7. 45'	275-40	" " Corner ✓
8. 50'	268-30	" " ✓
9. 50'	244-35	Fence Right ✓
10. 29'	109-15	" " ✓

Fence Lt. continues straight on Rd. and follow Rd.

Ex = 00

R. Fence 8'

L. 17.15'

Ex 8'

R. Fence 15'

L. Fence 27'

J, (H)






Fence 18' Rt  
" 14 Lt.  
Ex = 3.0'

Fence Rt 14'  
" Lt 16'  
Ex = 1.0'

18' Rt Fence  
11 Lt. Fence  
to Road 7' Lt. of PI.

Fence Rt 13'  
" Lt. 20'  
No External

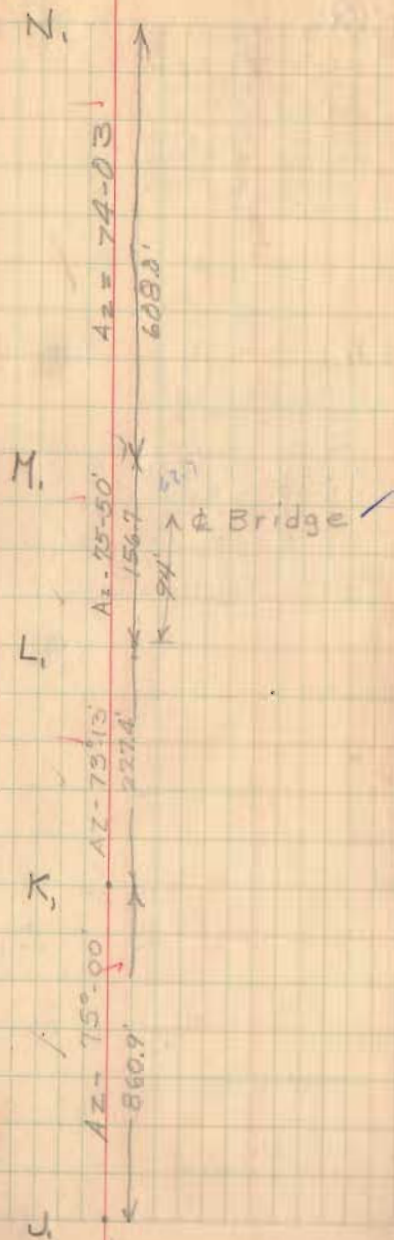

Inst. at (Q)

1. 90	82-20	Fence Rt.
2. 94	61-00	Fence Lt.
3. 89	69-35	£ Road.
4. 45	64-50	£ Road.
5. 14.5	34-00	£ Road.
6. 13	342-00	£ Road.
7. 34	305-00	£ Road.

Inst. at P

Dist	Az	Desc
1. 59	251-25	£ Road.
2. 22	339-30	£ Road.
3. 28	145-30	Cor fence Rt.
4. 86	236-25	Fence Rt.
5. 32	125-45	£ Road.
6. 101	156-55	Cor fence Rt.
7. 120	132-05	Fence Rt.
8. 109	112-10	Cor fence Lt.
9. 13	21-35	Reg fence Lt.

Ex 2

R Fence 10

Ex 2'

R Fence 18'

L Fence 12'

Fence 22 Lt.

Fence 17 Rt.

R.

E = 1.5'

AZ 75° 19'

145.40

1.00

9.25

Box Culv. ✓  
PIPE Culv. ✓

Q

AZ 122° 52'

181.95

(P)

AZ 72° 01'

395.8

Q


AZ 75° 40'

358.2

C.I.P 2+70'

Cor Pipe 1+68'

N<sub>1</sub>

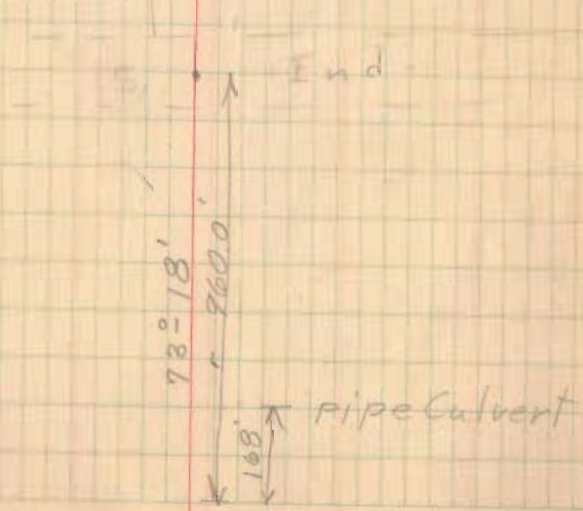

3-30-36

Fultz  
Howell  
Gashneau  
Young  
Smith  
Sheedy

⊕ +10  
100 10" stump

↗ +49  
11

18' oak ⊕  
17

— x — x — x — +04

↗ +67  
17

— x — x — x +30



PI  
+23.37

4



$\Delta = 14^{\circ} 42'$

$D = 5^{\circ} 00' R$


$T = 147.87'$

①  $PC = 2+75.5$

$PI = 4+23.37$

$PT = 5+69.5$

$L = 294.00'$

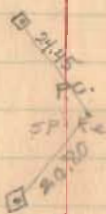

13

2

1

⊕ +00

+ on Tile

H & B Ticker



H & B with Ticker

PI.  
+45.48

19

(2)

$$\Delta = 11^{\circ}28' \text{ Rt.}$$

$$D = 6^{\circ}00'$$

$$T = 95.881 \checkmark$$

$$PC = 8+49.6'$$

$$PI = 9+45.48'$$

$$PT = 10+40.6'$$

$$L = 191.00 \checkmark$$

18

17

16

15



+90 Drive — — — Drive +00  
8 + 88 / 15 8" stump

1 + 79 / 11

8" stump 73 / 11

8 + 98 / 12 8" stump

12" stump 73 / 16

1 + 94 / 11

8 + 76 / 12 8" stump

1 + 76 / 11

on other page

$\Delta = 13^{\circ}43' L$

$D = 5^{\circ}00' L$

$T = 137.86'$

$L = 274.33$

$PC = 4+06.63$

$PI = 15+44.49$

$PT = 16+80.96$

PC+06.63 spike

14



113

PT+08.32 spike



12

PI+89.09 Hub

$\Delta = 11^{\circ}57' L$

$D = 6^{\circ}00'$

$L = 199.17'$

$T = 99.94'$

$PC = 10+89.15$

$PI = 11+89.09$

$PT = 12+88.32$



11

PC+89.15 spike

3



PT+88.32 spike

10

+30/15

10" stamp +37/18


+36/10 15" stamp.

+63/12 20" stamp

+81/12 22" stamp

+110/12 20" stamp

+61/20

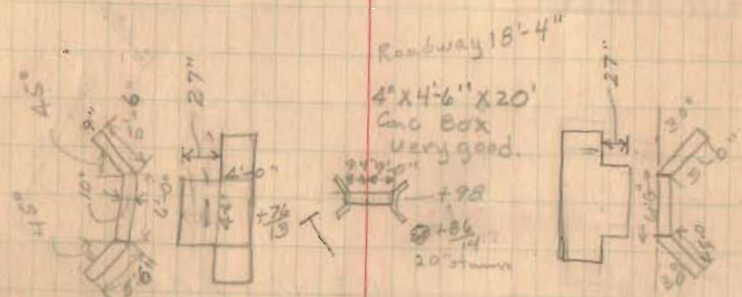

24" stamp +14/21

19

18

17

PI + 80.96 spike

16

PI + 44.49 Hub

15

PI 15 + 44.49

$\Delta = 13^\circ - 43' L$

$D = 52.00'$

$T = 137.86$

$L = 274.33$

$PC = 14 + 06.63$

$PT = 16 + 80.96$



(4)

2-12" stumps  $\frac{+92}{19}$   $\frac{+92}{11}$   $\odot \odot$   $\nearrow \frac{+85}{09}$

$\odot \frac{+27}{19}$  12" stumps

$\frac{2' \times 2'}{+50}$  (Recommend 18" at least)  
12" X 16' C.M.P.  
Good

14" stump  $\frac{+15}{16}$   $\odot$   
10" stump  $\frac{+04}{17}$   $\odot$

$\nearrow \frac{+94}{10}$

$\odot \frac{+61}{12}$  16" stump

7" Tree  $\frac{+13}{20}$   $\odot$

$\nearrow \frac{+06}{09}$

27" Tree  $\frac{+13}{18}$   $\odot$   
28" stump  $\frac{+05}{20}$   $\odot$   
25" Tree  $\frac{+03}{19}$   $\odot$

24

$$\Delta = 25^{\circ}00' R$$

$$PI = 23 + 86.47$$

$$D = 5^{\circ}00'$$

$$\textcircled{5} T = 254.12'$$

$$L = 500.00'$$

$$E = 27.82'$$


PC +14.35

23

$$P.C. = 23 + 14.35$$

$$P.T. = 28 + 14.35$$

Should be 68.47

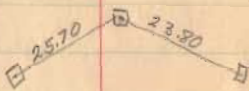


22

21

20

8-31-36

Fultz  
Gastinau  
Howell  
Young  
Smith  
Sheedy

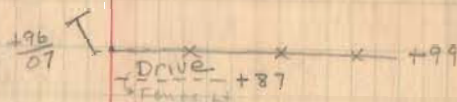

10" stamp  $\frac{+16}{21}$

$\frac{+55}{01}$

12" stamp  $\frac{+37}{22}$

$\frac{+88}{10}$  15" stamp

12" stamp  $\frac{+34}{20}$

15" stamp  $\frac{+31}{11}$

10" stamp  $\frac{+18}{11}$

$\frac{+17}{11}$



29

P.I. + 14.35 Spike  
28



27

26  
P.I. + 86.47  
49.47



25


$25 \pm \frac{32}{14}$      $\frac{+32}{16}$     2-20" stamps  
 $\rightarrow \frac{+04}{11}$

24" stump  $\frac{+36}{18}$  0

8" stump  $\frac{+52}{16}$  0

Culvert very poor.

New str. should be at  
27+45 10° L.F. skew

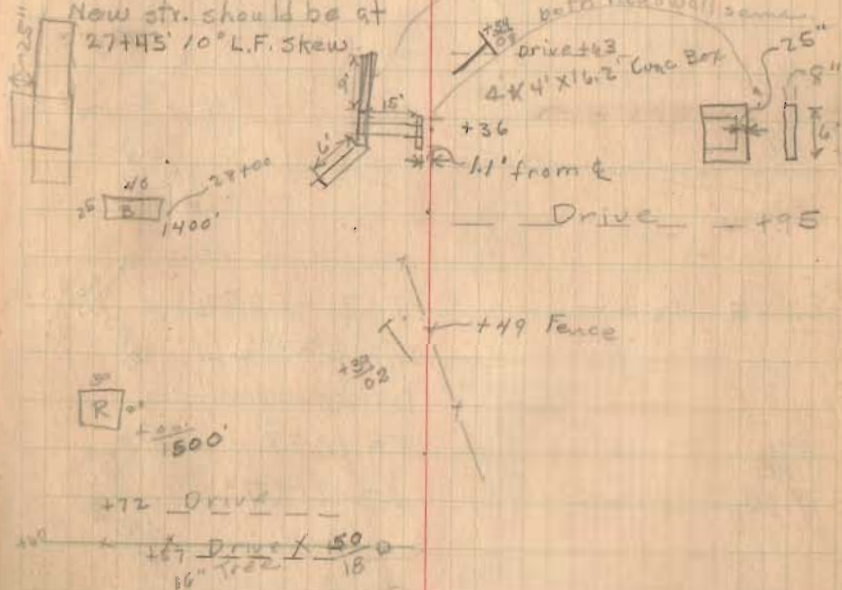

old wall has fallen into ditch  
and is broken up

both Headwall same

Drive +63  
2x4x16 1/2 Conc Box

+36  
11' from

Drive +95

+49 Fence

R  
+0.01  
1500

+72 Drive

+50 Drive  
16" tree

+ 11.10 P.T.  
35

PI  
+29.87 Hub with tank  
34


PI 34+29.87

A = 8°-07' R

D = 5'-00'

T = 81.32


L = 162.55

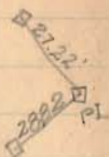

PC  
+48.55 Spike

33

PT  
+13.65 spike  
32

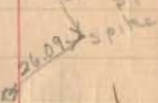

PI  
+52.85 spike

PI - 31+52.85

A = 3°-39' L

D = 2'-00'

T = 60.28

L = 121.67




PI  
PC  
+91.98 spike



80

4-1-30

10" Tree  $\frac{155}{26}$  @  
30" Tree  $\frac{145}{4}$  @

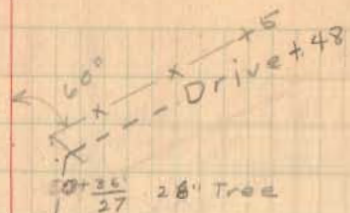


22" Tree  $\frac{58}{19}$  @  
Nail Box  $\frac{38}{07}$  @

18" Walnut  $\frac{30}{19}$  @

26" oak  $\frac{100}{19}$  @

+50  
18

begin Drive + 22

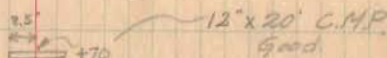

10" stump  $\frac{150}{12}$  @

+53  
18 14" stump

40" oak Tree  $\frac{128}{22}$  @

+09  
13

+92  
19 22" stump

+25 x x x

x x x +31

+09  
16 30" stump

+100  
18 30" stump

20" stump  $\frac{140}{50}$  @

+55  
17 10" Tree

12" Tree  $\frac{31}{15}$  @

+12  
09

PT+36.50 spike

39

PI+79.30 Hub with Tack

PI = 38+79.30

$\Delta = 3^{\circ}-26' R$

$D = 3^{\circ}-00'$

PC+22.06 Hub with Tack

$T = 57.24$

38

$L = 114.44$

PT+39.41 Hub with Tack

37

+59.40 P.I. Tack in Hub

PI 36+59.40

$\Delta = 8^{\circ}-01' L$

$D = 5^{\circ}$

36

$T = 90.32$

PC+79.08 spike

$L = 160.33$

35




28" Tree  $\frac{197}{25} \odot$

12" Tree  $\frac{179}{23} \odot$

8" stump  $\frac{153}{21} \odot$

18" cherry  $\frac{116}{15} \odot$

16" Tree  $\frac{115}{30} \odot$

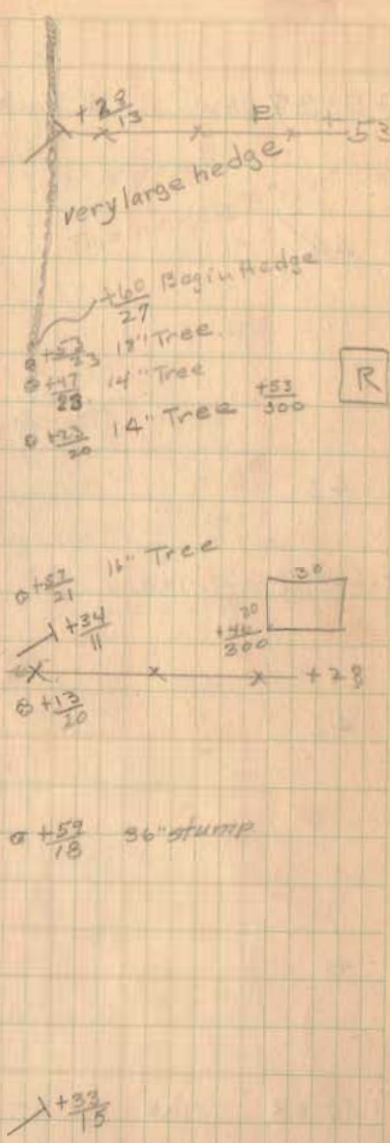

PT 53.37 Hub with Tack



44.

43

PI +75.75 spike

PI 42+75.75

$\Delta = 65^{\circ}-06' L$

(10) D =  $16^{\circ}-00'$

T = 229.32

L = 406.94





42

41

PC +46.43 spike



40

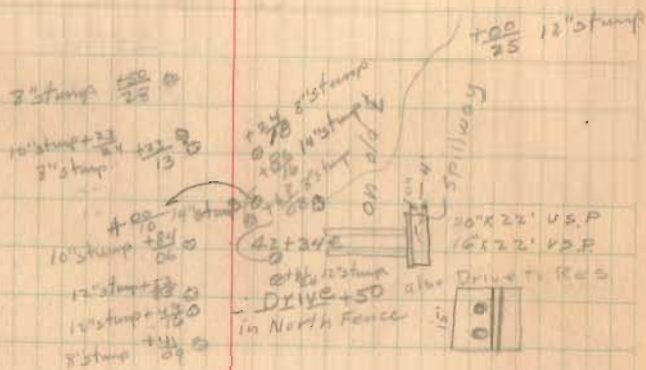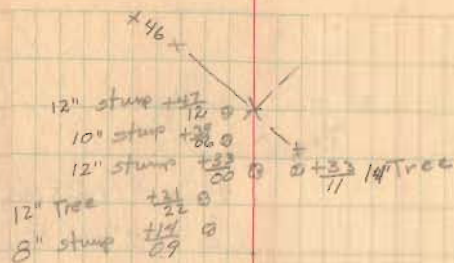

24" Tree  $\frac{+32}{05}$

10" Tree  $\frac{+04}{14}$

22" Tree  $\frac{+55}{13}$

18" Tree  $\frac{+04}{16}$

30" Tree  $\frac{+06}{27}$

+46 End Hedge

+02/17

27

PI.  
+23.20 Amb

49

$$PI = 49 + 23.20$$

$$\Delta = 69^\circ - 16 R$$

$$D = 16^\circ - 00'$$

$$T = 248.15$$

$$L = 432.92$$



(11)

48

47


PC  
+75.05




46

+67.8 point on Tangent

45

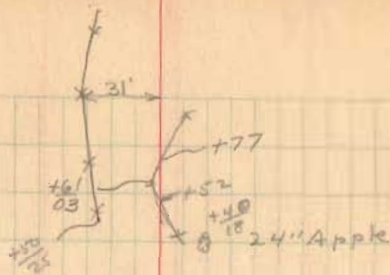

18'' Tree +89  
26 0

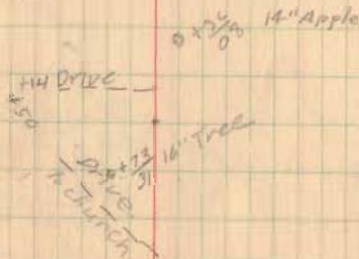

54

53

52

P.T. +07.99

51

50




PL

15'  $\frac{+36}{07}$   $\frac{+45}{05}$  +69 12" x 17" U.S.P.

should be larger size 17

6.3'

Kip Sap  
needed

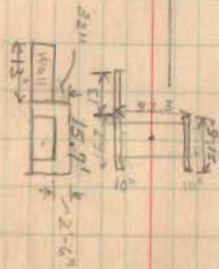

Good.  
Conc Box 10' x 4.5' x 32.3'

+80  $\frac{1}{2}$  Br on Target

59

P.T. 58  
+82.73

PI +38.60

57

PC +94.48

56

55



PI = 57 + 28.60

$\Delta = 4^{\circ}25' R$

(12) D = 52.00'


T = 44.20

L = 88.33

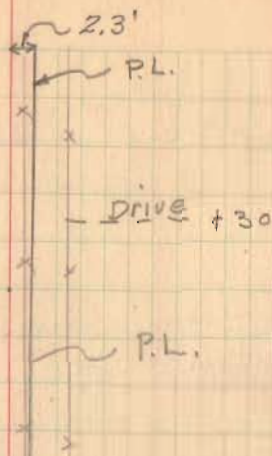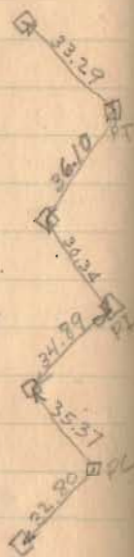

2- 15' trees +22  
18 Tree +16  
13 0

see notes for site plan  
PL at P.T. 14.95'

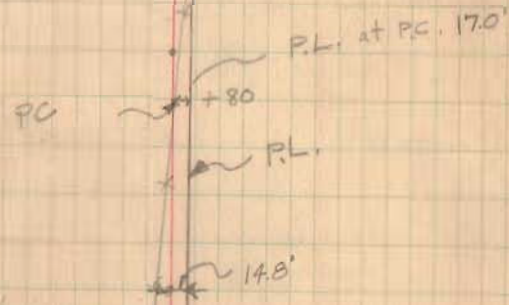

24" Tree +66  
16 0

PT+70.97 spike

64

PI+21.13 spike

63

$$PI = 63 + 21.13$$

$$A = 6^{\circ}00' L$$

$$(13) D = 2^{\circ}00'$$

$$T = 150.16$$

$$L = 300.00'$$



62

PC+70.97 Hub



61

60

PL

9.0' at P.T.

12"

$\frac{100}{12}$

12" cherry  $\frac{189}{10}$

$\frac{150}{10}$  12" Tree walnut

$\frac{100}{10}$  12" Tree Sugar

$\frac{100}{10}$  16" Tree "

Sugar 8" Tree  $\frac{100}{10}$

" 16" Tree  $\frac{100}{10}$

Cherry 14" Tree  $\frac{100}{10}$

Sugar 14" Tree  $\frac{100}{10}$

Drive In Rt Fence +30

$\frac{100}{10}$  8" Tree

PL at P.C. 77'

$\frac{100}{10}$  20" Apple

$\frac{100}{10}$  12" Apple


PL





74


73

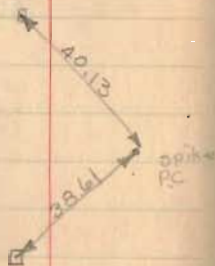P.C.  
+76.30 spike

72

71  
P.T. +93.91 spike

70

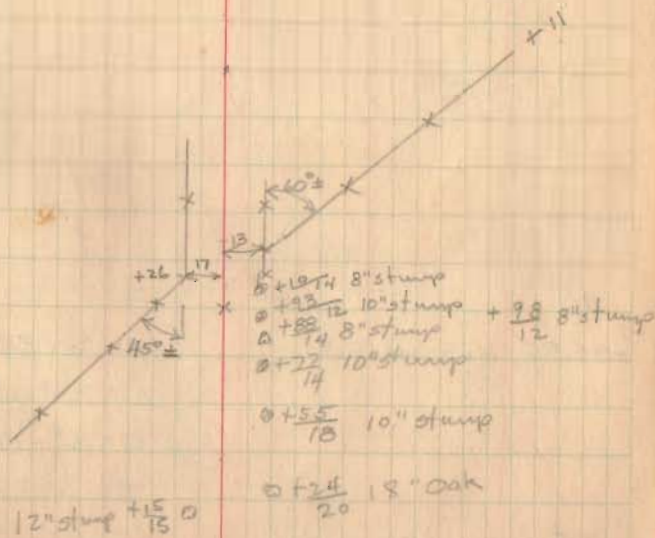91 walnut  $\frac{123}{20}$ 

monroe tarp

$$\begin{array}{r}
 79 + 00.00 \\
 72 + 72.97 \\
 \hline
 +27.03 \\
 20 \\
 \hline
 47.03
 \end{array}$$

79

PT. +72.97 spike

78

77

$$\begin{array}{r}
 115.1 \\
 95.7 \\
 \hline
 19.4
 \end{array}$$

76

PI +64.86 Hub with Tack

PI = 75 + 84.86


$\Delta = 35^{\circ} 48' L$

(15)  $D = 6^{\circ} - 00'$

$T = 308.56$

$L = 596.67$

75

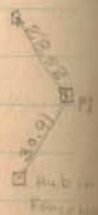

Mail Box  $\frac{57}{10}$

+67 Drive

Oscar Valley

Road 10' Gravel +62

178

+75


+50

+82

+28

+28 Lt fence Tack on E

24" Apple  $\frac{109}{23}$

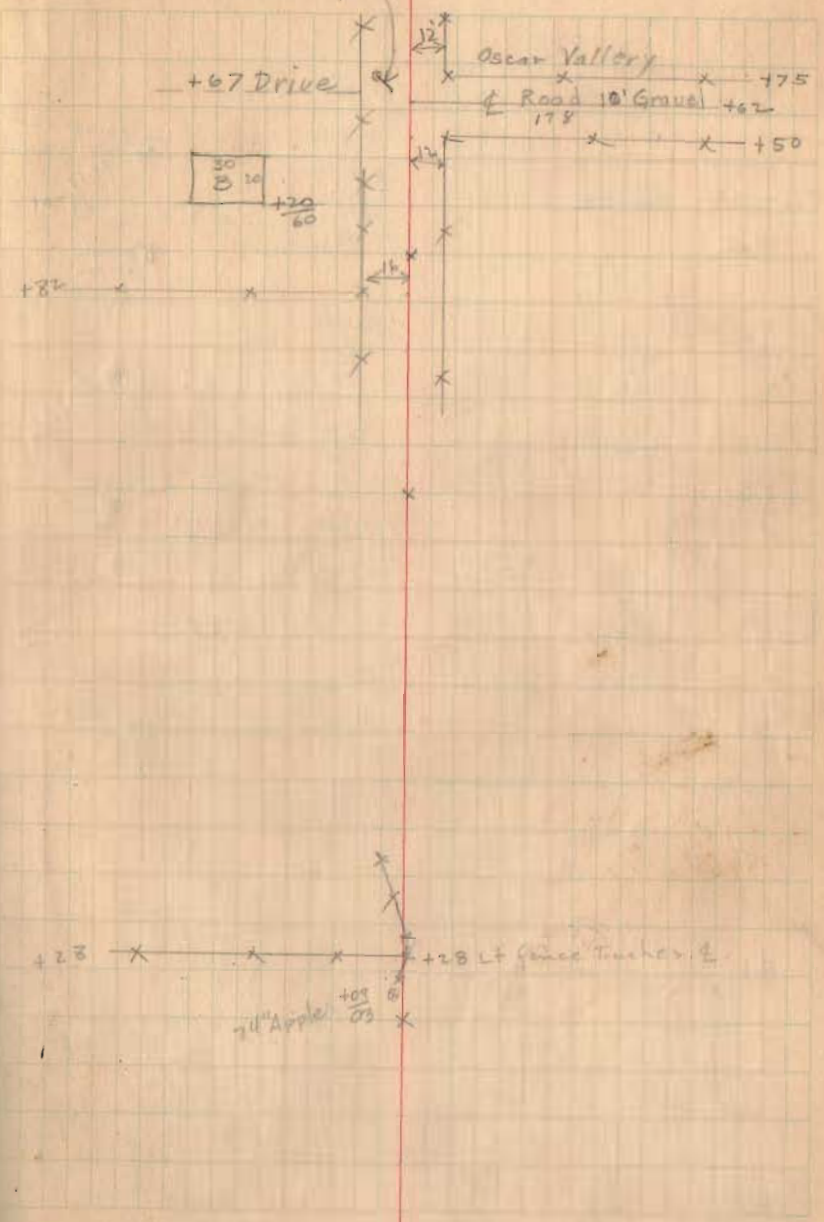



89

88

87

86

85

14" Tree  $\frac{198}{74}$  ○

x

x

108 x

x

x

2.10" x


PC + B/62 spike  
1939



94

93 + 93.4 Bridge Data

skew R.F.

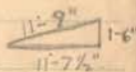

clear span 19'-5"

span along 19'-10"

Roadway between curbs 10'-6 1/2" at

length 22'-0"

Length of Trusses 22'-0"

Batter of Walls 3/8" to feet

Length of Abts - 14'-0"

Cross Abt + Wings

Good Cond. Tin

2-9" lower ends 2-5" top

Steel Beams 4-9" I Beams

South End 6-6" inches 4-2" bottom

S E wing Length inside wing 3'-8" top 1-3" wide

skew wing

N.E. wing High = 6.5  
Length Bottom = 10.5  
width top = 8.0  
width = 8.0

skew



91

N.W. wing

skew





Plank Floor 2 1/2" X 9"

90

cloudy cold  
4-6-36

Fultz  
Gastoun  
Howell  
Young  
Sims  
Shady

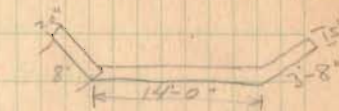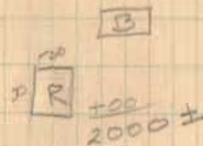


+60 - Drive




Mail Box 101 06

Floor  
6 plank 2 1/4" X 10" X 15'

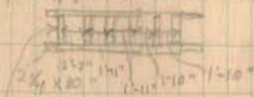

G-stringers 3 1/4" X 8" X 5'-7"

Concrete abtm.

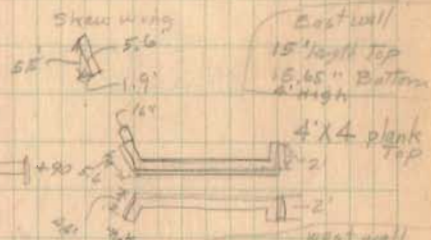

West wall 14.5' length top wall 15.3' length bottom wall 6' high

Note


skew wing should have concrete floor put in as water is washing dirt from under walls  
Walls in Fair Cond.

Batter on walls 2" to 1'

99

P.C.  
+64.10 spike

98

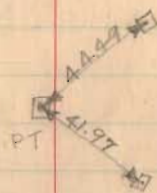P.T. +61.10  
+54.40 #ub with Tack

97

P.T. +26.55  
96 spike

$PI = 96726.55$   
 $\Delta = 36 - 30 = 6'$   
 $D = 13' - 00'$   
 $T = 144.93$  100.75  
 $L = 279.48$

95

8" Tree  $\frac{117}{13}$  010" stump  $\frac{144}{12}$  08" Tree  $\frac{28}{10}$  08" stump  $\frac{125}{13}$  015" Tree  $\frac{11}{12}$  010" Tree  $\frac{12}{11}$  02- 10" stump  $\frac{126}{20}$   $\frac{12}{17}$ 3" stump  $\frac{103}{04}$  024" sugar  $\frac{180}{17}$  0

$\frac{127}{00}$  30" sugar  
 Lt fence crosses  $\frac{119}{04}$  0  
 12" stump  $\frac{118}{04}$  0

$\frac{137}{04}$  20" walnut  
 DIVE 150  
 KIT

Fence crosses  $\frac{197}{04}$  0  
 $\frac{105}{07}$  12" Tree

104

103

102

P.T. + 52.31 Hub with Tack



101

P.I. + 13.73 Hub with Tack  
100



P.I. 100+13.73

$\Delta = 37^\circ - 26' R$

$D = 13^\circ$

$T = 149.63$

$L = 288.21$

15" Stump  $\frac{+70}{26} \circ$

10" Walnut  $\frac{+23}{20} \circ$

18" Walnut  $\frac{+16}{25} \circ$

24" Stump  $\frac{+30}{25} \circ$

+94 20 Walnut  
 $\circ$  22

14" Walnut  $\frac{+20}{19} \circ$

30" Walnut  $\frac{+26}{19} \circ$  12" Stump  
2" Thorn  $\frac{+23}{19} \circ$   
10" Elm  $\frac{+20}{19} \circ$

10" Walnut  $\frac{+27}{19} \circ$

Dave 120

12" Apple  $\frac{+17}{24} \circ$

Oscar F Straight

+47

10' Tree  $\frac{+30}{11} \circ$

Florence Nagle



PT. + 66.70

109

PI + 95.20 spike

PC + 23.85 spike

108

107

106

105



PI = 108 + 95.20



$\Delta = 0^\circ - 40' L$

$D = 0^\circ - 28'$

$T = 71.35$

$L = 142.85$

shute

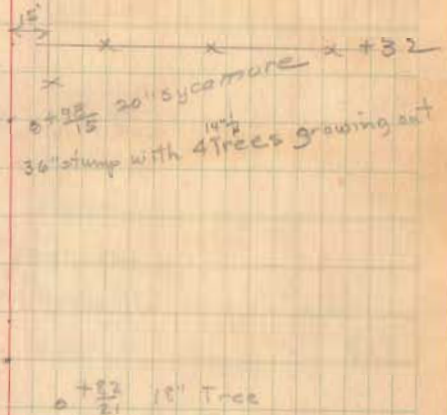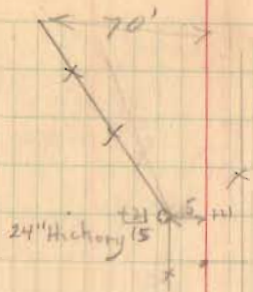

(No Res. in sight) 8+80  
 24  
 Mail Box 7+42  
 06

+16 — — Drive — —



PC+0201

119



118

117

116

115

12" Tree  $\frac{134}{16}$  0  
 12" Tree  $\frac{128}{16}$  0  
 2-10" stumps  $\frac{128}{24}$  0

18" Walnut  $\frac{157}{25}$  0

24" stump  $\frac{129}{23}$  0

12" Hickory  $\frac{31}{21}$  0

8" elm  $\frac{15}{21}$  0

12" Tree  $\frac{127}{25}$  0

24" stump  $\frac{128}{23}$  0

12" Tree  $\frac{210}{20}$  0

12" Tree  $\frac{128}{24}$  0

8" elm  $\frac{138}{24}$  0

10" Hickory  $\frac{111}{24}$  0

30" Birch  $\frac{145}{23}$  0

10" Hickory  $\frac{120}{24}$  0

10" Hickory  $\frac{72}{24}$  0

10" Tree  $\frac{111}{23}$  0

16" Sumac  $\frac{125}{25}$  0

12" tree  $\frac{128}{24}$  0

0  $\frac{127}{14}$  18" stump

0  $\frac{128}{12}$  24" stump

0  $\frac{127}{15}$  24" stump

0  $\frac{128}{21}$  12" stump

124

123

122

PT. + 16.68

spike

121

PL + 09.42

Hub with Tack

120

G spike in Root 14" Tree



spike in Root 15" Elm

PI = 120 + 09.42


$\Delta = 5^\circ - 22' R$

D = 2" - 80'

T = 107.42

L = 214.67

spike in Root 24" Oak

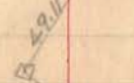

spike in Root 30" Oak

15" Tree  $\frac{49}{24} \circ$

30" Oak  $\frac{478}{19} \circ$

18" stump  $\frac{416}{13} \circ$

123+11 should be placed  
a 12" pipe Culvert



10" Tree  $\frac{420}{24}$

24" x 20" CMB Good

11" x 17" RT Skew

53' 18.5' 20' Skew

10" Tree  $\frac{417}{17}$   
11" Tree  $\frac{417}{17}$   
18" stump  $\frac{416}{13}$   
24" stump  $\frac{416}{13}$

129

PI +96.70 Hub with Tack

PI 128 +96.70

$\Delta = 5^\circ - 50'$

$D = 2^\circ - 30'$

$T = 116.76$

$L = 233.33$

28.23 0 spike in Root 36" Beech  
also B.M.

41.58

Spike in Root  
36" Beech

stone tacked  
1970s

51.85

26.40

128

PC +79.94 spike

127

126

125

14" Elm +97 0  
10" Elm +97 0  
16" Elm +91 17



+76

20" X 18' C.M.P.  
Good

30" Elm +83 17

0 + 59 25 30" Beech



0 + 21 24 12" Pear  
X Ben A Green  
477 Fence crosses  
Osage Valley

NW Mut Life Ins Co  
Osage Straight

x

134


133

132

131

P.T. + B.27 spike

130

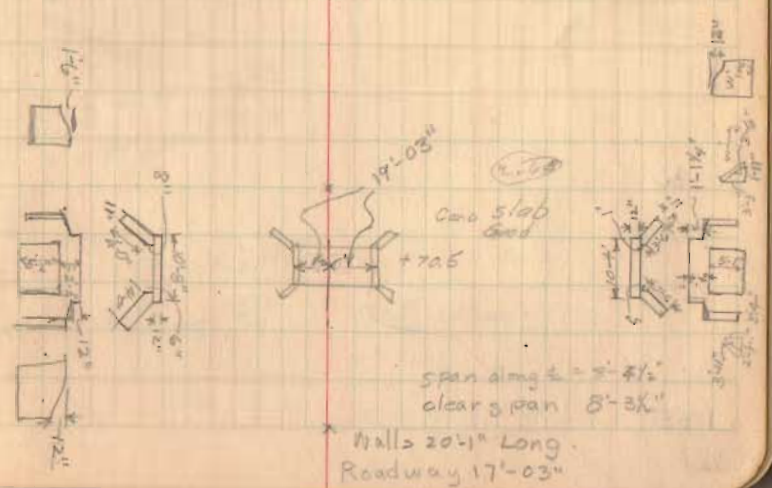

137

138

137

136

135

$B + \frac{95}{15}$  18" Walnut

30" Oak  $\frac{+32}{71}$   $\odot$

24" stump  $\frac{+77}{23}$   $\odot$

24" stump  $\frac{+50}{25}$

$B + \frac{42}{15}$  24" Oak

$B + \frac{02}{5}$  24" Oak

PT + 52.31 spike

144

PI + 98.65 Hub with Tack

PC + 45.08 spike

143

142

141

140




$$PI = 143 + 98.65$$

$$\Delta = 0^\circ - 30' L$$

$$D = 0^\circ - 28'$$

$$T = 53.57$$

$$L = 107.13$$

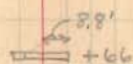

Good (needs Relaying)

4' - 12" C/P on left  
10.5" 12" V.S.P. on RT.

18" Tree  $\frac{37}{25}$   
12" stump  $\frac{13}{21}$

$\frac{19}{21}$  8" Tree  
 $\frac{8}{21} + \frac{13}{21}$  12" Tree  
 $\frac{8}{21} + \frac{13}{21}$  10" Tree  
 $\frac{8}{21} + \frac{13}{21}$  10" Tree  
 $\frac{8}{21}$  10" Tree

30" Beech  $\frac{13}{21}$

18" sugar  $\frac{13}{25}$

$\frac{8}{25}$  36" Oak



149

148

147

146

145



+57.50 End spike in E. Road




153

152

151

150

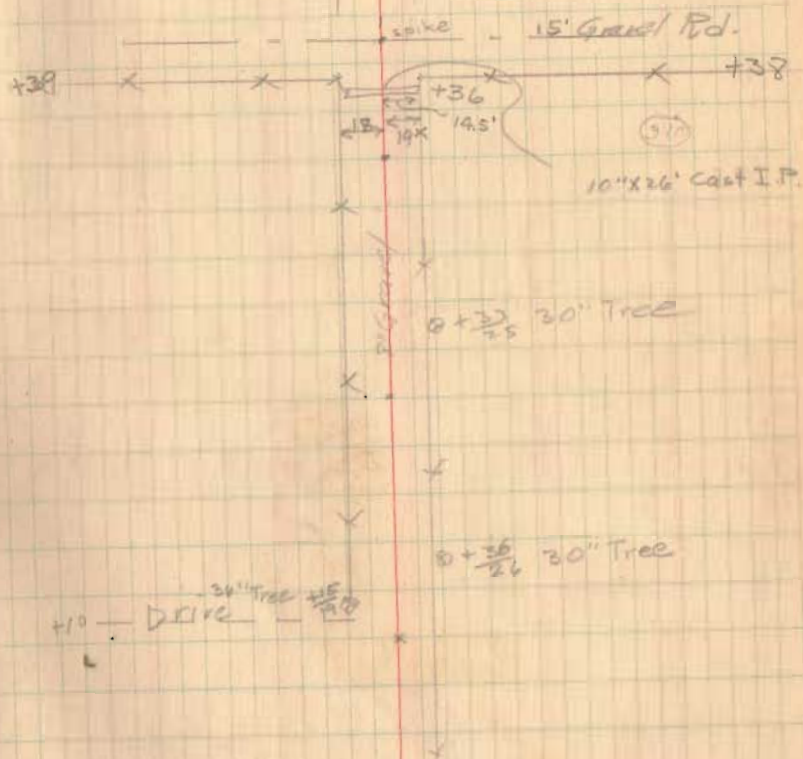

NE Cor. of survey 1009, in the water  
of Madison.

Begin at a in the north line of said  
survey and on the east of the south  
line of Walters Dunning Survey #9878  
a lot of land now owned by W. A. Giles  
thence S 69° W with the side of said  
survey 101 poles to two black oaks  
north west cor. of said survey; thence  
S 21° E 54 poles to a stone. thence  
S 82° E 14 poles and 11 feet to a  
stone NE cor. of granite yard lot.  
thence 38 West, 10 poles to a stone  
thence S 84° E 58 poles to a  
stone in the center of County rd.  
thence N on a straight line to the  
place of Beginning Cont 4 3/4 Acres

Begin at 3 Buckhoes SE Cor. Walter Dunning  
Survey #9878 in the line of Holland  
Nancy Survey 3224 thence  
with said Holland Nancy's line  
S 2° E 95 poles to County Rd  
thence west with said road  
to W. J. Long's SE Cor. at a Bridge  
over ditch crossing said road ~~thence~~  
thence N 30 poles to the South  
line of said Dunning's Survey  
in the center of said line  
to a 50 A tract of land owned  
by W. A. Giles thence N 69° E  
26 poles to the place of Begin.  
Cont. 27 A



(10) start at ston SW cor of Thomas in  
Weaver W line measure N 332' to  
cor part 6's of 1288 of 9.

(20)

$PI = 120 + 09.42$        $P.C. = 119 + 02.00$        $0^{\circ}-00'$   
 $\Delta = 5^{\circ}-22'$  R       $+50$        $0^{\circ}-26'$   
 $D = 2^{\circ}-30'$        $120 + 00$        $1-14$   
 $T = 107.41$        $+50$        $1-51$   
 $L = 214.67$        $121 + 00$        $2-29$   
 $PC = 119 + 02.01$        $+1667$        $2^{\circ}-41'$   
 $PT = 121 + 16.68$

(21)

$PI = 128 + 96.70$        $PC = 127 + 79.94 = 0^{\circ}-00'$   
 $\Delta = 5^{\circ}-50'$  L       $128 + 00$        $0^{\circ}-15'$   
 $D = 2^{\circ}-30'$        $+50$        $0-53$   
 $T = 116.76$        $129 + 00$        $1-30$   
 $L = 233.33$        $+50$        $2^{\circ}-08'$   
 $PC = 127 + 79.94$        $130 + 00$        $2-45$   
 $PT = 130 + 13.27$        $+13.27$        $2-55$

(22)

$PI = 143 + 98.65$   
 $\Delta = 0^{\circ}-30'$  L  
 $D = 0^{\circ}-28'$   
 $T = 53.57$   
 $L = 170.20$   
 $PC = 144 + 45.08$

$53.57$   
 $166.50$   
 $53.57$   
 $107.14$        $26.49$   
 $23.33$   
 $313.6$   
 $15$

(17)

$PI = 96 + 26.55$   
 $\Delta = 36^{\circ}-20'$   
 $D = 13^{\circ}-00'$   
 $T = 144.93$   
 $L = 279.48$   
 $PC = 94 + 31.62$   
 $PT = 93.61$

$6110$   
 $220$   
 $3449$   
 $1250$   
 $2124$

$PC = 94 + 31.62 = 0^{\circ}-00'$   
 $95 + 00 = 1^{\circ}-12'$   
 $+50 = 4-27$   
 $96 = 7-42$   
 $+50 = 10-57$   
 $97 + = 14-12$   
 $+6.10 = 18-10$

(18)

$PI = 100 + 13.73$   
 $\Delta = 37^{\circ}-26'$   
 $D = 13^{\circ}-00'$   
 $T = 149.63$   
 $L = 288.21$   
 $PC = 98 + 64.10$   
 $PT = 101 + 52.31$

$PC = 98 + 64.10 = 0^{\circ}-00'$   
 $99 + 00 = 2^{\circ}-20'$   
 $+50 = 5-35$   
 $100 + = 8-50$   
 $+50 = 12-05$   
 $101 + 00 = 15-20$   
 $+52.31 = 18-44$

(19)

$PI = 108 + 15.10467$   
 $\Delta = 10^{\circ}-40'$   
 $D = 0^{\circ}-28'$   
 $T = 71.35$   
 $L = 142.85$   
 $PC = 109 + 23.85$   
 $PT = 109 + 66.70$

(20)

PI

8

(15) PI = 75+84.86  
 $\Delta = 35^\circ-48' L$   
 $D = 6^\circ-00'$   
 $T = 308.56$   
 $L = 596.67$   
 $PC = 72+76.30$   
 $PT = 78+72.97$

2370  
 180  
 189600  
 237  
 420000  
 2297  
 183760  
 237  
 413460

PI. 83+20.90 (16)  
 $\Delta = 0^\circ-48' L$   
 $D = 0^\circ-28' D$   
 $T = 85.71$   
 $L = 171.20$   
 $PC = 82+35.19$   
 $PT = 84+06.31$

PC 72+76.30 0°-00' ✓  
 73+00 0°-43' ✓  
 +50 2-13 ✓  
 74+00 3-43 ✓  
 +50 5-13 ✓  
 75+00 6-43 ✓  
 +50 8-13 ✓  
 76+00 9-43 ✓  
 +50 11-13 ✓  
 77+00 12-43 ✓  
 +50 14-13 ✓  
 78+00 15-43 ✓  
 +50 17-13 ✓  
 +72.97 17-54 ✓

170.20/667  
 40000  
 37336  
 4267  
 1800000  
 4667  
 33330  
 30669  
 33011  
 33050  
 6610  
 24667  
 4667  
 3810  
 9430  
 4334  
 960

5. 29.03  
 60  
 174180  
 20.97  
 40  
 25820  
 4

(13) PI = 63+21.13  
 $\Delta = 6^\circ-00' L$   
 $D = 2^\circ-00'$   
 $T = 150.16$   
 $L = 300.00$   
 $PC = 61+70.97$   
 $PT = 64+70.97$

PC = 61+70.97 0-00  
 = 62+00 0-17 ✓  
 PC = +50 0-47 ✓  
 63+00 10-17 ✓  
 +50 (10-13) 10-47 ✓  
 64+00 (43) 2-17 ✓  
 +50 (13) 2-47 ✓  
 PT. +70.97 3-00 ✓  
 29.03

(14) PI = 68+32.16  
 $\Delta = 32^\circ-19' R$   
 $D = -6^\circ-00'$   
 $T = 276.86$   
 $L = 538.61$   
 $PC = 65+55.30$   
 $PT = 70+93.91$

226.85  
 611000.00  
 15  
 2  
 5.5  
 126740  
 11660.41  
 276.74  
 40  
 16044  
 24  
 46  
 655.30  
 276.26  
 316  
 6832.10  
 6119

PC = 65+55.30 | - 0°-00' ✓ 10-10  
 66 1°-20 ✓ 14-50  
 +50 2-50 ✓ 12-20  
 67 4-20 ✓ 11-50  
 +50 5-50 10-00 ✓  
 68 7-20 7-50 ✓  
 +50 8-50 7-20 ✓  
 69 10-20 5-50 ✓  
 +50 11-50 4-20 ✓  
 70 13-20 2-50 ✓  
 +50 14-50 1-20 ✓  
 70 + 93.91 16°-10' ✓

53.861  
 6132.3166  
 20  
 23  
 18  
 51  
 98  
 7  
 43.91  
 180  
 351280  
 43.91  
 790330

BS H-T FS Elev

BM

1069.23 - 9'

PI = 49+23.20

$\Delta = 69^\circ - 16'$

D = 16°-00'

T = 248.15

L = 432.92

PC = 46+75.05

PT = 51+07.97

247.34  
613957.5  
22  
78  
117  
113  
59  
43  
70  
247.34  
31  
248.15  
490  
144

49.23.20  
248.15  
4675.05

432.92  
16/69 L 466  
24  
43/44  
22  
144  
240

248.15  
244.85  
3.70

(12)

P.I. 57+38.60

$\Delta = A^\circ - 25' R$

T = 44.20'

L = 88.33'

PC = 56+94.40

P.T. 57+82.73

44.18  
5220.9  
20  
20  
44.18  
93.33  
514.4166  
48  
41

57+38.60  
44.20  
56+94.40  
98.33  
57+82.73

PC 56+94.40

0°-00'

57+00

0°-08'

57+82.73

2°-12' 1/2

150  
56  
9 00  
75  
84 00  
92.73  
150  
4136.54  
32.73  
12409.50

(10)

PI = 42+75.75

$\Delta = 65^\circ - 06'$

T = 229.32

L = 406.94

PC = 40+46.43

PT = 44+53.37

(11)

PI = 49+20.70

$\Delta = 68^\circ - 40' R$

T = 245.35

L = 429.16

PC = 46+75.35

PT = 51+04.51

228.58  
16/3657.2  
22  
45  
32  
187 4  
128  
92  
80  
120

46.63  
228.58  
74  
229.32

244.76  
244.59  
16/3913.4  
32  
21 245.35  
64  
73  
74  
54  
30  
140

47+75.35

PC 0-0

47+00

1°-58'

+50

5-58

48

9-58

+50

13-58

49

17-58

+50

21-58

50

25-58

+50

29-58

51

33-58

+04.51 34-20 0

54  
2405  
430  
197200  
9860  
118200  
60  
24  
20.22 420.16  
16  
257696  
429.16  
11.22  
922  
422  
22  
480  
451  
480  
2400  
1920  
216480



(9) PI = 38+79.30

$\Delta = 3^{\circ}-26'$

$1^{\circ}-10'$  T = 57.24

1-43 L = 114.44

PC = 38+22.06

PT = 39+36.50

5724  
 $\begin{array}{r} 3 \overline{)171.7} \\ \underline{3} \phantom{00} \\ 433 \\ \underline{3} \phantom{00} \\ 20 \\ \underline{20} \\ 0 \end{array}$   
 7  
 $\begin{array}{r} 7 \overline{)114.44} \\ \underline{7} \phantom{00} \\ 44 \\ \underline{44} \\ 0 \end{array}$   
 $\begin{array}{r} 3 \overline{)3433} \\ \underline{3} \phantom{00} \\ 433 \\ \underline{433} \\ 0 \end{array}$   
 $\begin{array}{r} 3 \overline{)36.50} \\ \underline{3} \phantom{00} \\ 650 \\ \underline{650} \\ 0 \end{array}$

(10) PI = 42+75.75

$\Delta = 65^{\circ}-06'$  L

D =  $16^{\circ}-00'$

T = 229.29

L = 406.88

PC = 40+46.46

PT = 44+53.34

$\begin{array}{r} 16 \overline{)28.575} \\ \underline{16} \phantom{00} \\ 12575 \\ \underline{128} \phantom{00} \\ 92 \\ \underline{92} \\ 0 \end{array}$   
 $\begin{array}{r} 2 \overline{)406.88} \\ \underline{2} \phantom{00} \\ 81376 \\ \underline{81376} \\ 0 \end{array}$   
 $\begin{array}{r} 16 \overline{)65.10} \\ \underline{16} \phantom{00} \\ 4910 \\ \underline{48} \phantom{00} \\ 110 \\ \underline{110} \\ 0 \end{array}$

PC 40+46.46 0-00

+75 2-17

41 4°-17'

+50 8°-17'

42 12°-17'

+50 16°-17'

43 20°-17'

+50 24°-17'

44 28°-17' 4-16

+53.34 32-33 0

$\begin{array}{r} 53.54 \\ \underline{53.54} \\ 480 \end{array}$   
 $\begin{array}{r} 42+75.75 \\ \underline{42} \phantom{00} \\ 7575 \\ \underline{72} \phantom{00} \\ 21416 \end{array}$   
 $\begin{array}{r} 2569920 \\ \underline{2569920} \\ 0 \end{array}$   
 $\begin{array}{r} 237 \\ \underline{237} \\ 0 \end{array}$   
 $\begin{array}{r} 53.34 \\ \underline{53.34} \\ 480 \end{array}$   
 $\begin{array}{r} 426720 \\ \underline{426720} \\ 0 \end{array}$   
 $\begin{array}{r} 2560320 \\ \underline{2560320} \\ 0 \end{array}$   
 $\begin{array}{r} 240 \\ \underline{240} \\ 0 \end{array}$

(4)

$\Delta = 13^{\circ}-43'$  L

D =  $5^{\circ}-00'$

T = 137.86

L = 274.33

PC 14+06.63

PT 15+49.49

PT 16+80.96

PC = 0-00'

15 = 2°-26'

16 = 4°-50'

+80.96 6-51

27.81  
 $\begin{array}{r} 5 \overline{)139.1} \\ \underline{5} \phantom{00} \\ 1391 \\ \underline{1391} \\ 0 \end{array}$

(5)  $\Delta = 25^{\circ}-00'$  R

PI = 25+68.47

D =  $5^{\circ}-00'$

T = 254.12

L = 500.00'

E 27.92

PC = 23+14.35

PT = 28+14.35

PC = 0-00

24 =  $2^{\circ}-08'$  ✓

25 =  $4^{\circ}-38'$  ✓

26 =  $7^{\circ}-08'$  X

27 =  $9^{\circ}-38'$  X

28 =  $12^{\circ}-08'$  X

+14.35 = 22

12° 30'

254.04  
 $\begin{array}{r} 5 \overline{)1270.20} \\ \underline{5} \phantom{00} \\ 127020 \\ \underline{127020} \\ 0 \end{array}$   
 254.12  
 00  
 5 125.00

23+14.35  
 254.12  
 2568.47

14.35  
 12.30

19.22  
 1.50  
 717.50  
 1435  
 11.5250

2565  
 1.50  
 4282.50  
 1565  
 12847.50

(3)

D 6° 0'-20'  
 Δ 11° 57' 3'-20'  
 T 99.94 5' 47'  
 P.C. 10+89.15  
 P.I. 11+89.09  
 P.T. 12+88.32  
 L 199.17

P.C. 2° 00'  
 11+ 0' 20'  
 12+ 3' 20'

(8)

25+59.4  
 30 32  
 35+79.08  
 160.33  
 373 9.41  
 79 00  
 79.08  
 209  
 150  
 0 46.00  
 20 32  
 3138 00  
 4 39.41  
 150  
 197 050  
 39 41  
 591 150

PI 26+59.4  
 Δ = 8°-01'  
 T = 80.32  
 L = 160.33  
 P.C. = 35+79.08  
 P.T. = 37+39.41  
 0°-31'  
 3°-01'  
 4°-00'

(6)

PI 31+52.85  
 Δ = 3°-39' L  
 D = 3°-00'  
 T = 60.88  
 L = 121.67  
 P.C. = 30 + 91.98  
 P.T. = 32 + 13.65

0-07  
 1°-37'  
 1°-49'

① PI 24+29.87  
 Δ = 8°-07'  
 T = 81.32  
 L = 162.55  
 P.C. = 33+48.35  
 P.T. = 35+11.10

1°-17'  
 3°-47'  
 4-03 1/2

3182.6  
 126  
 20  
 121.67  
 .65  
 313.45  
 121.67  
 199  
 52.85  
 60.88  
 91.98  
 121.67  
 213.65  
 13.65  
 90  
 122.85  
 7.130

28.37  
 141.6  
 81.32  
 5 160.5  
 22  
 6.07  
 211.67  
 142.55  
 34.29.87  
 81.32  
 38+48.35  
 1 62.55  
 35 11.10  
 11.10  
 150  
 5500  
 550  
 51.45  
 150  
 207.250  
 51.45  
 771.750

Curve #1  
 $D = 5^{\circ}00'$   
 $\Delta = 14^{\circ}42'$   
 $T = 147.87$   
 $PE = 2+75.5$   
 $PI = 4+23.37$   
 $PT = 5+69.5$   
 $L = 294.00'$

547.391  
 147.872  
 7  
 102  
 294.00  
 5714.7  
 1047  
 42  
 20

PC 0+00'  
 9+34 0+32'  
 4+00 3+07'  
 1+00 5+37'  
 24.5 7 21'


(2)

$\Delta = 11^{\circ}28'$  PC 600  
 $D = 6^{\circ}00'$  9 1+30'  
 $T = 95.88'$  10 4+30'  
 $PC = 8+49.6$  406 5+47'  
 $PI = 9+45.98$   
 $PT = 10+40.6$   
 $L = 191.00$

8+49.6  
 1+41  
 10.906  
 50.6  
 45.0  
 730.80

# DIETZGEN'S RAILROAD CURVE AND REDUCTION TABLES

Copyright, 1914, by Eugene Dietzgen Co., New York City

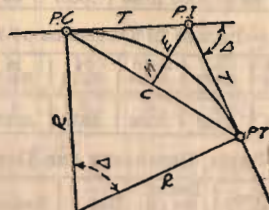

## CURVE FORMULAS

Radius= $R = \frac{50}{\sin \frac{D}{2}}$  (1) Degree of Curve= $D$  and  $\sin \frac{D}{2} = \frac{60}{R}$  (2)

Tangent= $T = R \tan \frac{\Delta}{2}$  (3) Length of Curve= $L = 100 \frac{\Delta}{D}$  (4)

Middle ordinate= $M = R(1 - \cos \frac{\Delta}{2})$  (5)  $= R \text{vers} \frac{\Delta}{2}$  (6)

External= $E = T \tan \frac{\Delta}{4} - R = R \div \cos \frac{\Delta}{2} - R$  (8)  $= R \text{exsec} \frac{\Delta}{2}$  (9)

Long Chord= $C = 2 R \sin \frac{\Delta}{2}$  (10)  $\Delta =$  Central Angle

## EXPLANATION AND USE OF TABLES

**Stations.**—Given P. I.—Sta. 161+60.35 to find Sta. of P. C. and P. T.  $\Delta = 62^{\circ}10'$   $D = 8^{\circ}20'$ . From Table IV for  $1^{\circ}$  curve  $T = 3454.1$  and  $+8\frac{1}{2} = 414.49$  ft. From Table V correction  $= .36$  or  $T = 414.85$  ft. P. C.—Sta. P. I.— $T = 157+45.50$ . Also from (4)  $L = 746.00$  and P. T.—Sta. P. C.  $+L = 164+91.50$ .

**Offsets.**—Tangent offsets vary (approximately) directly with  $D$  and with square of the distance. Thus tangent offset for Sta. 158 on above curve is 2.16 ft. found as follows. From Table III tangent offset for 100 ft.  $= 7.27$  ft. Distance  $= 158 - \text{Sta. P. C.} = 54.50$ , hence offset  $= 7.27 (54.50 \div 100)^2 = 2.16$  ft. Also square of any distance divided by twice the radius equals (approximately) the distance from tangent to curve. Thus  $(54.50)^2 \div (2 \times 688.26) = 2.16$  ft.

**Deflections.**—Deflection angle  $= \frac{1}{2} D$  for 100 ft.,  $\frac{1}{4} D$  for 50 ft., etc. For  $c$  ft.  $= (n \text{ minutes}) .3 \times C \times D^{\circ}$  or  $=$  defl. for 1 ft. from Table III  $\times C$ . For Sta. 158 of above curve  $= .3 \times 54.5 \times 8\frac{1}{2} = 136.2'$  or  $2^{\circ}16.2'$ , or  $= 2.50 \times 54.5 = 136.2'$  from Table III. For Sta. 159 deflection angle  $= 2^{\circ}16.2' + 8^{\circ}20' \div 2 = 6^{\circ}26.2'$ , etc.

**Externals.**—May be found in similar manner to tangents. Thus  $E$  for curve above is 91.37. For from Table IV for  $1^{\circ}$  curve  $E = 960.6$  for  $8^{\circ}20' = 360.6 \div 8\frac{1}{2} = 91.27$  and from Table V correction  $= .10$  or  $E = 91.37$  ft. Or suppose  $\Delta = 32^{\circ}$  and  $E$  is measured and found to be 42 ft. What is  $D$ ? From Table IV  $E = 230.9$  and  $+42 = 5.5$  or  $D = 5^{\circ}30'$ .