

M^o Arthur Burr

Sept 6-86 (Paid for Feb 19-87)

W. E. Powers } ch in survey
Harley Powers }

Collins Powers

100' = 100% line 2' long

Line A

Start at SW \angle Nat. Harrington
in E line Burr.

With Burr line

or $3\frac{1}{2}$ E $\frac{394}{59}$ fut = 5.96 ch

to cut-pike north \angle and Burr line

With W. O. 20' SW or 43 fut = 64 - lbs

Line B.

Start cut-pike SW \angle Burr

S $57\frac{1}{2}$ E with pike $\frac{226}{55}$ fut = 3.42 ch \angle Gro Patten $\frac{1}{2}$ mile SW

700 - 11.60. Aug in pike thence

S $57\frac{1}{2}$ E with cut-pike $\frac{1632\frac{3}{4}}{1627\frac{1}{2}}$ fut = 34.74 ch \angle R. Dickinson

and Atwood Quicke

thence with cut pike line C

S $57\frac{1}{4}$ E

$\frac{4923}{491}$ fut = 7.47 ch

\angle Quicke $\frac{1}{2}$ Harrington ∇

thence Line D

S $57\frac{1}{4}$ E with cut pike

$\frac{270}{269}$ fut = 4.09 = ch

to aug in pike \angle Harrington

cut B. O. 45' or 18 W or $\frac{1}{2}$ = 8.6 $\frac{1}{2}$ lbs

thence with pike Line E

S $52\frac{3}{4}$ E

$\frac{1061\frac{1}{2}}{1057\frac{3}{4}}$ fut = 16.08 ch

SW \angle Harrington ∇ SW \angle Burr ∇

Line F

thence with E line Harrington $\frac{1}{2}$ E line Burr

S 11 W 20 poles to post \angle M. A. Land

Line 8.

Start cent pike Grubbs & Harr.
with E line Grubbs & W line Harr.
S $10\frac{1}{2}$ W 21 poles (see aster)
to Mc A. line

Grubbs House front 16 x 30 ride
Start at W line house with line on side
house S $32\frac{1}{4}$ W $79\frac{3}{4}$ = 1.30 ch
to cent pike

Start at L Dickinson & Grubbs
with W line Grubbs house
S $12\frac{3}{4}$ E $73\frac{11}{16}$ feet = 172 links
thence with line Dick & Grubbs
S $32\frac{1}{4}$ W
S $48\frac{1}{2}$ feet = 986 ch
to Stone S & Dick

N. B. Smith Dur.

Oct 15th 1886.

Oronan S. Parrin ch. snow ^{1 day} off.
 Ira P. Ryan }
 Renford Armstrong } ch. or snow
 6 days }
 6 days }

John E. Southard 1 day

John S. Bridges 2.

David H. Harriman 2. mit snow

Elmer W. Elliott 1.

Shepherd S. Fisher 5.

William W. Fisher 5.

N. B. Smith Oronan 6 days


Elliott Dickinson Flag man, 3 days

Stephen Harriman 2 days mit

Course of pike south line S 85 1/2 E

mit = S 86 1/4 W.

Line A. Start ¹⁸ links or
 of ∇ cut for \angle at S W = Fisher
 N 8 1/2 E Random, or S 7 1/2 E J.C.
 24.46 cent above creek

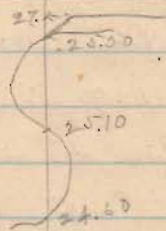

let old stake at 2.5 ch.

at S. S. 80 ch cut road or W = Harriman

2.575 stake at by Lankens for 114 p and
 or W = old line S Bridges tract.

33.22 post at old stone unspaced \angle by John

Southard & John S. Bridges

all 14 links or. of ∇

Line B. start at ∇ N = line A
 called old or W = Bridges 100 a
 S 80 1/4 E

11.07 cent from well road

at 24.00 pass 119 links N of post
in old Orchard called line of old
Orlows tract by Mrs Fisher, Geo E
Southard E of Geo S Orlows

38.28 ch fall 109 links N of
stake 655 in line S. which are

at 24.00 pass 76 = links south of 20 ch +
54 feet = on line S

Line 6, marked stone in S line
Rd SE < David Fisher.

To 2 1/4 E. on old E line duplex

hit stake at 26 ch S of fence 2 1/2 lbs

stone on line at 216.16 ch dup for 22

cut fence at 216.43 ch

cut chain at 216 1/2 ch

25.50 ch set stake on E duplex in pasture

set stake at 217.25 old SE < Mrs Fisher
57.03 pass corner to Smith E of Fisher

" " " 56

Stone NW < N B Smith Bushong 5648

84.72 stone SE < Stephen Gene Holt 2nd

are old Mrs Fisher No 2

113.75 cut pipe for Ex. of N line

course of pipe N 87 W = N 86 1/4 W

hit stake in line at 55.75. line in W

line old Bushong tract.

Line 2 start at above stake in line C

at 55.75

at 86 3/4 W.

6.55 set stake.

Start cut pipe < N B Smith & N B Fisher

283 is at 218.25 at N B Smith, sup. 52

39.66 stake in this line at 6.55 in above

1.50 hit stake for are < old Orlows 1002

D 86 3/4 or

- Start at stake 9.50 thence S 3 W
 93 to ∇ cut for S 2 E land sold by J. P. 180 E
 Southward to Wth W. Fisher
 at 210. ch cut stake in line in place above
 " 33.21 cut road cut stake
 " 37 1/4 ch cross old mill dam
 " 44.84 cut ∇ in or line Fisher tract
 46.12 dug 22' or 24' E 53 3/4 links
 46.12 dug 11' S 85 1/4 E 52 "
 46.12 E. Start at stone in place
 D 87 W < Stephen G. tract
 S 3 1/2 W
 49.00 S 87 E < Stephen G. tract
 48.44 cut road < John S. Wilgus & Dar. Hariman
 56.60 Stone near dug stump call = Scatter
 57.84 Stake 44.84 line S. = Wilgus
 58.00 pit stake dist
 59.22 Stake 218.00 of line a
 87.22 " " " " "
 87.22 true SW = Wilgus. Stone
 116.21 SW < duplex on line

- Line S. Stone S 87 E land duplex in
 S line dist.
 61.12 Elm 34' or 38' 104' links
 also dug 22' or 24' E. 32 "
 Start at Stone
 65 1/4 E. Road or S E c c
 61.12 pass < John Elliott by John Kennedy or W.
 at stake in line at 10. 20. Ed 30
 at 25. 35 stake start line a. pass 1 link 100 ft
 cut 25 cut W 25 links
 61.12 links S of 8 cut by man NE < Elliott
 then area with 100' corner
 65.35 Stake old D 87 < John B. Wilgus

58.30. Stake 58.00 ^{from} stone
at 28.98 pass - 8 - links east of stone
planted ~~at~~ ^{on} ~~the~~ ^{the} Duplex

Line G. Start at old ^{land} stone 13' di
at 26.16 on line G.

OR 61 E on line of old road
^{in cut fence corner}
13.2 ch to ~~the~~ ^{the} ~~stone~~ ^{stone} ~~at~~ ^{at} ~~the~~ ^{the} Duplex

Dug above stone up and found artificial
widener that had been planted

Line H. Start at old stone OR E & hand
Duplex at 26.16 line G

Mil dug 30° S 75° 40' on 13 links
also on the stone 10' stake & mark ~~at~~ ^{at}
Smith & Dup 3.2 OR 61 E ^{132/16}
also pipe ^{from} well SAI/AVR 12.0/2 the
~~at~~ ^{at} ~~the~~ ^{the} Duplex

OR 86 1/2 97

~~at~~ ^{on} ~~the~~ ^{the} Duplex line

657 ch out stake & Smith & Fisher

276 E line grass yard detached lot

72 22 W line label lot old 2 line g. yd.

1571 pass 5' south of SW ^{of} ~~the~~ ^{the} ~~stone~~ ^{stone} base stone

19' x 34' main Jacob Henckhous ch. d.

551 W line g. yd E line from Route.

1703 pass 5.9' just S of barn on Route ^{boundary}
^{of} ~~the~~ ^{the} ~~stone~~ ^{stone} ~~at~~ ^{at} ~~the~~ ^{the} Duplex

1771 Stake cut grass road SW ^{of} ~~the~~ ^{the} ~~stone~~ ^{stone} ~~at~~ ^{at} ~~the~~ ^{the} Duplex

2505 stem planted ~~at~~ ^{on} ~~the~~ ^{the} Duplex at 28.78 ch

from stone SW ^{of} ~~the~~ ^{the} Duplex

out stone ~~at~~ ^{on} ~~the~~ ^{the} Duplex

Dug 2' di S 68° 4' W 7 links

also dug 4' OR 1 1/2 E 7 9 1/2 "

On Blk road 10' S 70° 10' E 2.32 1/2 links

on ~~the~~ ^{the} ~~stone~~ ^{stone} ~~at~~ ^{at} ~~the~~ ^{the} Duplex S. 5 W. 46 "

Line 1. Start at stone SW of Duplex
East with survey line

37.55 cent road.

46.17 stone old S 22° E same Duplex

47.54 cut stake < NB Smith & Duplex

cut Blue Oak 15° N 73 3/4° W 79 1/2 links

also Pigeon Oak 14° N 10 1/4° E 48 1/4

Miscellaneous measures

Government pike at < Smith and Fisher

South 9 links to line Duplex and

stone < Smith & Fisher

Aug in pike at 1366 or from Duplex

with bears S 89 1/2° E of. ST 83 1/2° W

Start at old < gr. yd.

S 2 1/4° W 82 < old school lot

2.07 Duplex line, 2.54 cent pike

Line 2. Start at V SW of Iron Route

cent pike S 21 1/4° E 45 1/2 links

N 21 1/4° W with Route W line

2.00 to - V cent road Route SW <

Line 3. with N line Route, g. yd. ^{school} & ^{school} lot

S 88 1/2° E

5.17 < Route ²⁰⁰ of grave yard

{ S 1 1/4° W on line Route & g. yd }

{ 2.00 Duplex line & 2.50 cent grav. pike }

7.07 old < gr. yd. & ^{school} lot

7.50 post fence made < Smith

8.38 SW < old school lot.

Line 4. Start E end line at 8.08

S 5 1/4° W 52 < old school lot

2.11 old Duplex line

2.53 cent-pike

Line P. Start at 4.75 line N=V

S 7 3/4 W

4.19 \angle at W line Milgus in
Cham creek 3.875 line M.

Line Q. Start at V in road and
Milgus line, with road

S 2 1/4 E 52 links to \times W^o $\frac{1}{2}$ link

Oct 29 - 86

Pressure Surv.

course Milgus to line S 86 1/2 E

at 4, 8A @ S 86 1/2 E from Milgus 2000
run at 3 1/2 E 1.18 to Milgus line 0502

at Sta 200.00 of Milgus line 0501 at 3 1/2 E 90 1/2 links
at Sta in Milgus line 0502

Line R. Start at stake 2000 \leftarrow put down hill
05 3/4 W with line of old mill dam

3.23 pass Milgus line 0501 at from W
2.975 at stake called \times duct to $\frac{1}{2}$ link sides

4.51 stake in Milgus line 0502 at 37.29 line S, which is

Line S. Start at Stone 2000 \times N B beneath

1500 track in Great-line Old Building 3050

200 links N of east line S

at 3.500 on Milgus line 0502


2000 pass 90 1/2 links north of V

in orchard 2000 ft of Milline No 1
 2800 cut state near road fence 2 links
 south of gate in chan E of 2 links or of cut
 of chan at most northerly point
 3373 center Gamwood road.
 3729 ∇ N 7 line R at No 2 of old dam
 4000 post ∇ at 118 or of 2200 on Milline No 1
 4484 State E of line \leftarrow Southward ∇ Milgus

Remarks Milgus line No 1 crosses mill
 dam at center of old tumbler and crosses
 line R at 779 from No 2 old Milgus No 1

Bore a stake in line R at 11 feet north from
 south end.

Hay-cut Road on line No 1

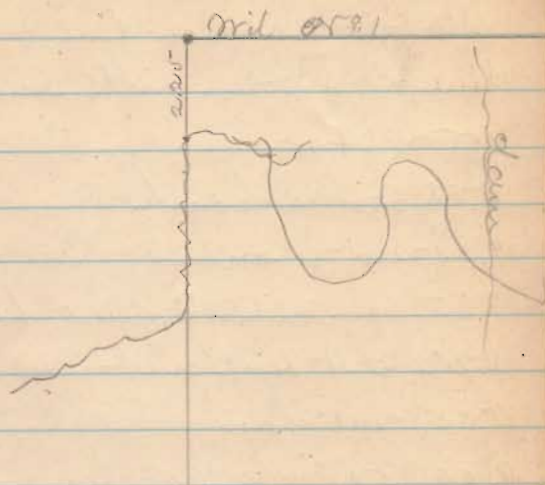

Start at old Milgus \leftarrow No 2 line No 1
 with Milgus on line
 2105 north bank creek
 2225 Chan leaves east
 2325 to 2500 in chan creek
 2500 appearance of old chan pier No 1

Start at 2.000 on Line A - Milgus
line 55¹ 1 then with said line
55 56³/₄ or.

6.38 east bank creek

7.15 cut chan

7.75 pass 73 links S. of cut chan

8.22 east bank creek

8.35 cut chan

9.00 50 links N of chan cut

10.25 N bank creek on

10.25 to 11.25 in chan, same thence to R

Oct 29, course of road south of
Route lot 55 2 1/2 W. change on 2 1/2

Let into the road S 23 E on road to connect
to bearing dead Milgus to Pennides

with first cut as above run line Mill lot

Start at stake set for 55 2 1/2 mill lot
4 P's Milgus.

or 11 or with dam E of line R

1075 stake 38 - links east of 55 2 line R to line 55 2

This for 55 2 - 2.2 Mill lot
thence East

3.56 cut Jammed road &

thence with road

S 23 E

2.75 center Bridge over creek

5.50 cut & S E - Mill lot

thence

S 70³/₄ or.

6.125 S E - Mill lot.

thence

or 150¹/₄ E or line Mill lot

521 to place of 72

~~597~~