


# West Liberty - Howenstein

Plot

May - 11 - 1899

On S. line Columbus St.  
 Measured from east line of lot  
 No 1 - Howenstein & Caldwell S. add.  
 as said lot is fenced -  
 at 30' set pin for west line 24'  
 St.  
 then 240' to west line Alley.  
 Alley 16 1/2'  
 2. west line Mustain Lincoln St -  
 150'

On south side of track N. line  
 Baird St. -  
 Considered High bound fence east  
 line Maxwell corner.  
 Measured 30' for St. - 240' to alley  
 Alley 16 1/2' - east line Smith at  
 132' -

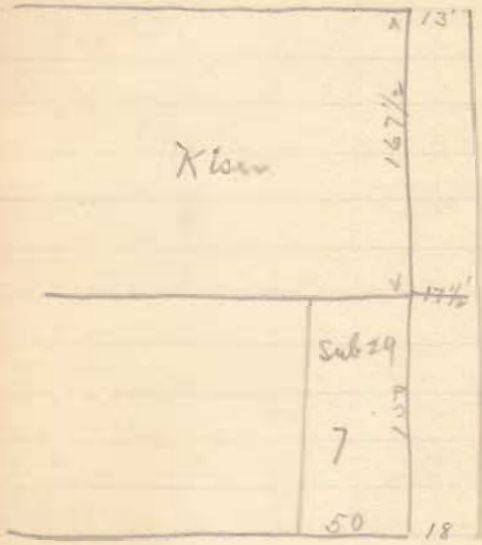

Mustain corner

# Kemper Survey

Line "A" Start from stone  
 SWR Kemper  
 set east 16'  
 N 8 1/2° E  
 27.24 stone NWR Kemper  
 came out 11' ft. south  
 west 5'  
 075. E or N 8 1/2° E

May. 25 - 1899 -

Line "B"  
 North line Kemper from stone  
 to stone 2 Bownbox  
 N 8 1/2° E  
 12.05 1/2 cut ~~horizontal~~ east.  
 13.07 1/2 set stake  
 set stake in line at 14.26 -

$$\begin{array}{r}
 2) 29.9 \\
 \underline{14.5} \\
 27.24 \\
 \hline
 25.69 \times 139 = 39.992
 \end{array}$$

13.94 at right angles to N 8 1/2° E  
 = 14.25 at N 8 1/2° E

→ mid: N. Oak - 30° N 26° E 23.00

Line 'C'

S 3 1/2 N

Line Station east side of section 500

$$29.52 + 21 = 50.03$$

~~At Walnut 14" N 33 1/2 W 145 1/2' the  
set this corner 1 ch. farther east  
on line~~

At 4 walnut saplings from  
one root - S 87 E 76' the

11.74

11.79

Line 'D'

set south 8'

N 86 W

+1.52 to stone began 12.52

came out 6 1/2' south

Kempner Survey -

Ora Kinney }  
W.H. Bradley } ch. or

Line "A"

Start from stone in pond  
in Greenville tract line  
← Wallace & Powersox -  
with Tract line  
set south 5'

S 82 1/2 W

Came out 7' north total  
northing 12

O.K. Cor. S 81 3/4 W

at 15.00 ch ← stone NW 1/2 Kempner

Line "B" with west line Kempner

set east from stone NW 1/2 16

S 4 W O.K. Cor.

at <sup>16.62</sup>~~16.50~~ set stake for line of road

at 27.27 wire fence Kempner S. line

Came out 16' east

set stone in line at 16.62

Mit: Wild Cherry 16" N 44 1/2 W 74 1/2' also

set 12" N 12 1/4 W 83

Blk. hickory

May 24 - 1904 -

Line C. from stake set at 16.62  
in west line N 74 1/2 E

Came out 7' north of stake set  
for C of track at 15.00

O.K. Cor. N 74 1/2 E

Mit: ash 3" S 73 1/2 E 6' also

Maple 30" N 84 W 42"

Line D on east line of road  
from stake set to stone  
origin. N 6 3/4 E 14.81

# Bowersook Survey

Henry Austin }  
Walter Small }

## Line "A"

Start from stone in Small's  
Tract - Line, < to Overton  
Oden & Jos. Wallan.  
15 1/2 ft set stake at 12.35  
and 180

$$\begin{array}{r} 72 \\ 22.6 \\ \hline \end{array}$$

$$49.4$$

set stake 49.4'

$$\begin{array}{r} 4 \ 49.4 \\ \hline 12.35 \end{array}$$

Moved this < 36' wide  
worked into line at road from  
< stone SW corner to stake set for  
ATR tract sold by Bennett to  
Wallan  
Nth: to < stone in N. side road  
Walnut 3' 1598 36 like  
Wild cherry 4' 574 1/2 W 17 1/2 Dec.

# June 15 - 1899

## Line "B"

Measured from stone to  
Shuck - 200 poles 18 1/2 ft  
+ 20.5

7.20  
set stake at extreme 700  
and 180 from Oden & TR

Made < 4' 4" west of line as run  
from south -

$$\begin{array}{r} 12.35 \times 52'' \\ \hline 180 \quad 1 \end{array} \quad \begin{array}{r} 4' 4'' \\ 12 \\ 48 \\ \hline 52 \end{array}$$

$$\begin{array}{r} 12.35 \\ 52 \\ \hline 2470 \\ 6175 \\ \hline 642.20 \end{array} \quad \begin{array}{r} 18 \ ) \\ 54 \\ \hline 102 \\ 108 \\ \hline \end{array} \quad \begin{array}{r} 36'' \end{array}$$

July 22 - 1899

Surveyed for J. M. Williamson  
on East Columbus ave -

North end of lot 59.8' wide  
between fences -

Make line between Williamson  
& Marker at north line of  
lot ave at line as occupied  
and shown by their sidewalk  
being by agreement between  
Williamson & Marker,  
in presence of George Woodcock  
Mill Chandler, George Short  
and Enoch Ferrill -

This line is not by the  
description in deed as  
there is a discrepancy of  $\frac{27}{100}$   
of a rod  $3.63'$  which would  
be 11 inches west of this line  
or 2.9' east according to which  
line is used -

Measurements at

Peoria

Aug 8 - 1899

47

From Center of Marysville  
Pike to center T & O. C. Tr.  
at Depot by way of new  
gravel road 1710'

at 1753 + Eric T & O. C. Ry.

at 1710 + 828' = 2538'  
switch where S & T intersect  
T & O. C.

$$\begin{array}{r} 2538' \\ \underline{1753} \\ 785' \end{array}$$

W.E. Harris Survey Aug


1899-

John  
W.E. Harris M/R  
Line A. set stake in west side of  
fence grade in line of fence  
supposed to be south line of  
M/R of M/R Sec. 5-

Line B.  
set east 18' from stake  
set stake at 10°  
N 86° E  
at 20.32 sic. < ran 43' east.  
at sic corner M/R Sec 5-  
found old N.O. stump with  
3 notches in bark set stake  
for < at N 85 1/4° E 21 lbs dist.

set 15' north of stake -  
measured from center of fence -  
N 86 1/4° W  
at 20.11 1/2 set stake

25.52  
20.32  
-----  
5.20

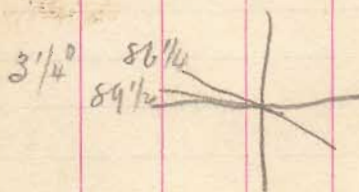

S 82° W  
S 85 1/4° W

at 25.52 Elm Tree 1' west of  
corner Harris location -  
came out S-S East

391.257, 25.52, 20.32



Line C.  
with north line 50a -  
set north from Elm tree 6'  
S 86 1/2° E

at 20.15 center of fence  
came out 2 1/8' north of  
line of fence

Line D.  
with fence -  
S 47 1/2° W  
at 25.50 stake set for starting  
fence.

On pipe from stake set  
 in Henderson's line  
 at 9.93 set stake in west  
 side of pipe for N&K 20 acres

Thence with north line 20 acres  
 N 86 $\frac{1}{4}$  W  
 20.75 ch set stake.

12 $\frac{1}{2}$ ' west from fence.

Pat Trhans Addition

Iron bar + Main St &  
 border Alley -  
 End of Straight carb west side  
 Main Street 20'  
 Long dist telephone stat N.W. 59.3

Iron bar Border Alley &  
 Hamilton St  
 Lamp post N.E. 20'  
 Hyd. W. 40.4'

Border Alley 16 1/2

Sept 23 - 1899 -

South lot on Main 55.3  
 " " 170' east of Main 55.8

Lots - area

|             |
|-------------|
| 58          |
| 45          |
| 12          |
| 45          |
| 45          |
| 12          |
| 45          |
| 45          |
| 12          |
| 45          |
| 55.3 x 55.8 |