

J-15

J-15

Field Notes.

A wooden stake driven at each point marked \circ

An Iron bar is " " " " N.

Angles bac = $20^{\circ}45'$ cad = $5^{\circ}57'$ def = $22^{\circ}26'$

Lots 5 to 13 inclusive, extend from Otties Lane to shoreline

The north line of Lot 26 is on the Survey Line

Harding Road is 40 feet wide. Other roads are of various widths as shown on plat

All dimensions given in feet to nearest $\frac{1}{2}$ foot

Central Angle $27^{\circ}37'$ Radii as shown on plat

From end of regular arc, in S. line of Lot 4

to the S.E. corner Lot 2. is an irregular curve, not located by transit.

Lots in Survey 13393 contain $\frac{9}{10}$ of an Acre

" " 9968 " $2\frac{89}{100}$ acres

Parks, Lanes & Roads are not estimated in acres shown above

Lanes & Road intersections

are marked by a wooden hub $1\frac{1}{2}$ x $1\frac{1}{2}$ x 16 driven down to ground level.

Other lot corners

are marked by a

$\frac{1}{8}$ x 2 x 24 " wooden

stake driven $12"$

into the ground.

Witnesses to iron bar 30 " long

top $1\frac{1}{4}$ " with thread at the

N.W. corner of Lot 32,

Sugar 18" di N 37 E W

33.2' Red Elm 10"



Plot
of survey of
THE MARYSVILLE ALLOTMENT
Richland Township
Logan County
Ohio.


6217

INDEXED ON MAP

X-13

J-13

Surveyed and Platted - J.A. Buchanan
Traced - D.E.S.

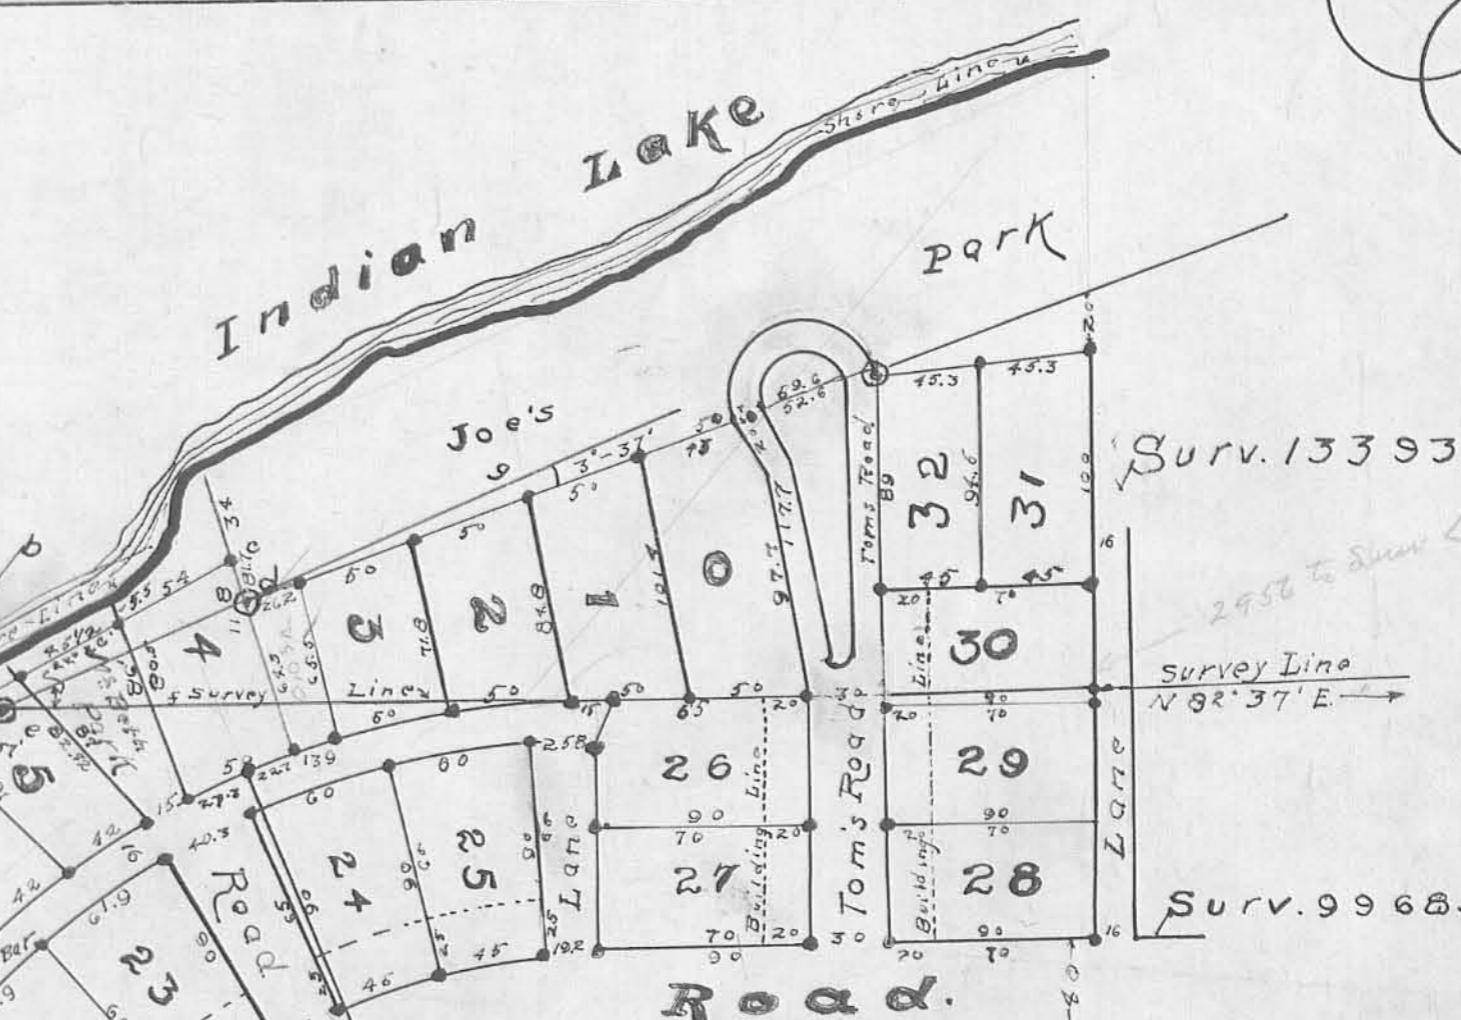

Di. 10" N 12 E 7.7" and Coffee at 7" di S. 87 E 9.2"

The "iron bars" at S.E. corner Lot 8, and N.W. corner Lot 6 and on survey line Lot 5, and on E. line Lot 4, are $1\frac{1}{2}$ " x 33" long

Iron bar at S.E. corner Lot 11 old iron gun barrel $1\frac{1}{2}$ " x 40" long.

The Survey Line, between Surveys 13393 and 9968, intersects the E. line of Lot 30, at 2.966 feet west of the east corner of said Survey.