
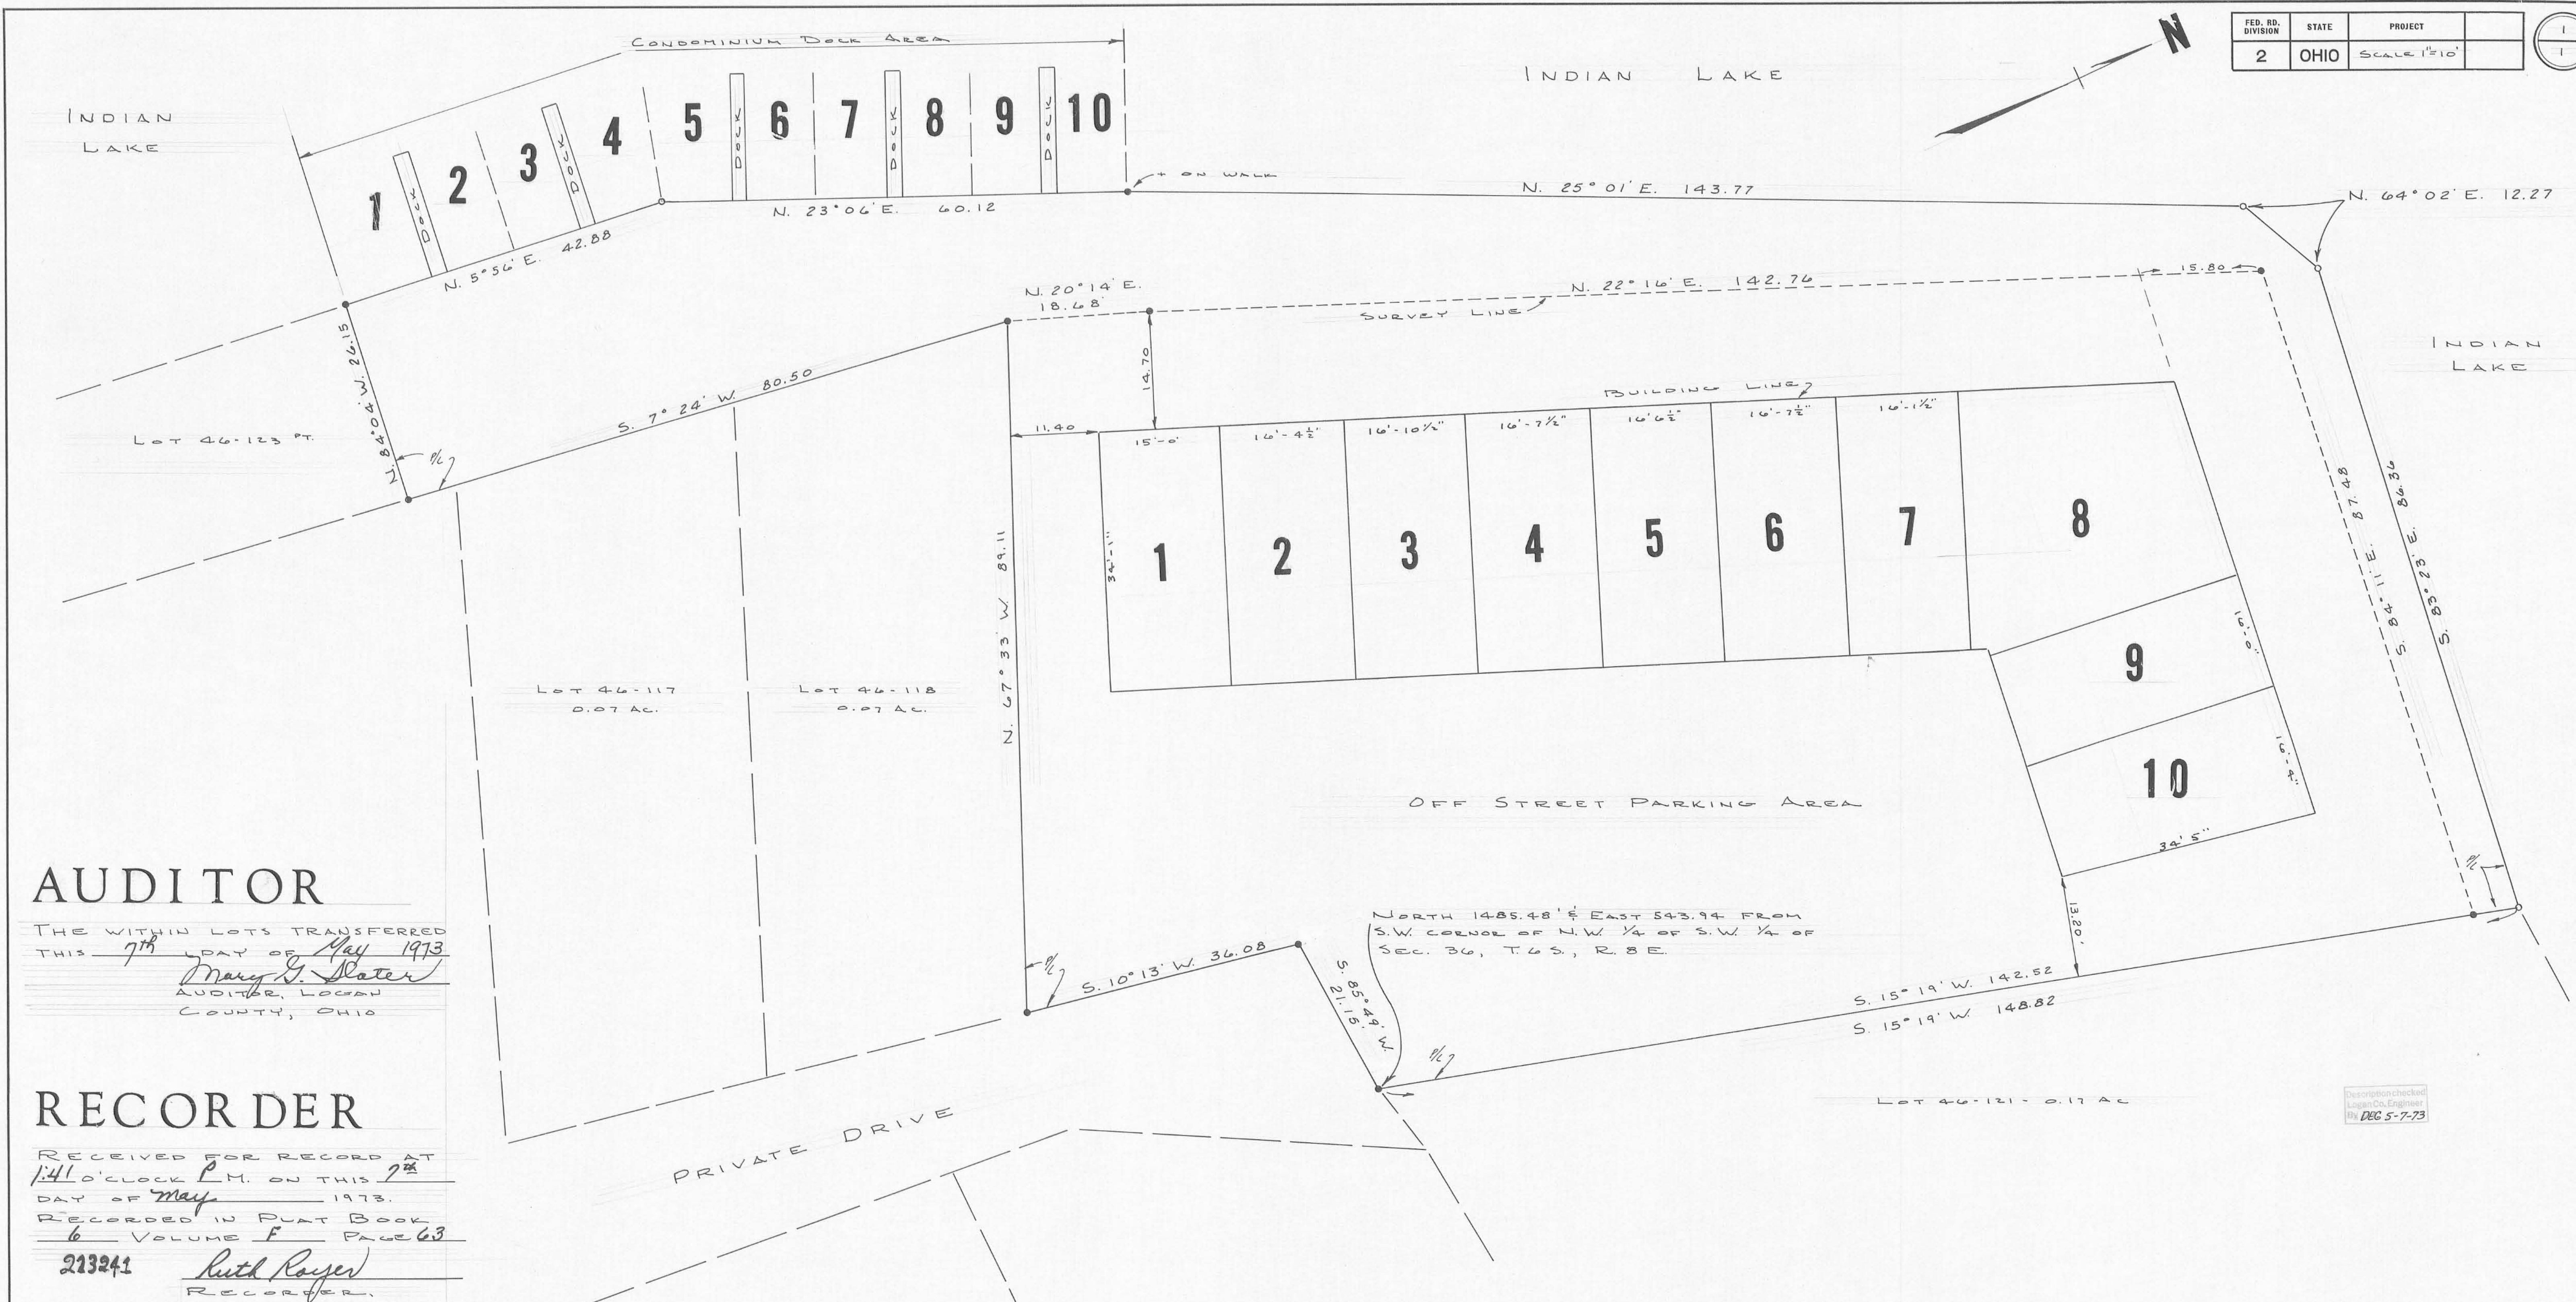


FED. RD. DIVISION	STATE	PROJECT
2	OHIO	SCALE 1"=10'

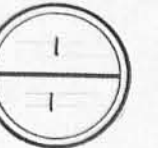

### AUDITOR

THE WITHIN LOTS TRANSFERRED  
 THIS 7<sup>th</sup> DAY OF May 1973  
*Mary G. Slater*  
 AUDITOR, LOGAN  
 COUNTY, OHIO

### RECORDER

RECEIVED FOR RECORD AT  
 1:41 O'CLOCK P.M. ON THIS 7<sup>th</sup>  
 DAY OF May 1973.  
 RECORDED IN PLAT BOOK  
6 VOLUME F PAGE 63  
213241 *Ruth Royer*  
 RECORDER,  
 LOGAN COUNTY, OHIO

### SURVEYOR

THE ACCOMPANYING PLAT REPRESENTS A SURVEY OF LOTS  
 No. 46-120, 46-119 AND PART OF LOT 46-123 IN THE WEST HALF OF  
 SECTION 36, TOWN 6 SOUTH, RANGE 8 EAST, INDIAN LAKE  
 RESERVOIR LANDS, WASHINGTON TOWNSHIP, VILLAGE OF  
 RUSSELLS POINT, OHIO.  
 \* INDICATES IRON MARKER UNLESS OTHERWISE INDICATED.  
 THE TRACT CONTAINS AN AREA OF 0.47 ACRES.  
 I HEREBY CERTIFY THAT THIS PLAT IS A CORRECT REPRESENTATION  
 OF A SURVEY MADE BY ME ON FEBRUARY 25, 1973.

*Larry E. Blosser*  
 LARRY E. BLOSSER SIT 1199  
 Cecil E. Mengervink, P.S. # 3151  
 CHECKED BY

## BAYSIDE CONDOMINIUM RUSSELLS POINT, OHIO

THE UNDERSIGNED CERTIFY THAT THIS DRAWING ACCURATELY  
 SHOWS THE BUILDING AS CONSTRUCTED. MAY 6, 1973.

*Larry E. Blosser* SIT #1199  
*Cecil E. Mengervink* P.S. #3151

Description checked  
 Logan Co. Engineer  
 REC 5-7-73