


# SANDERS ADDITION

(106)

TO  
LAKEVIEW  
LOGAN COUNTY OHIO

SCALE 1 INCH = 80 FT.

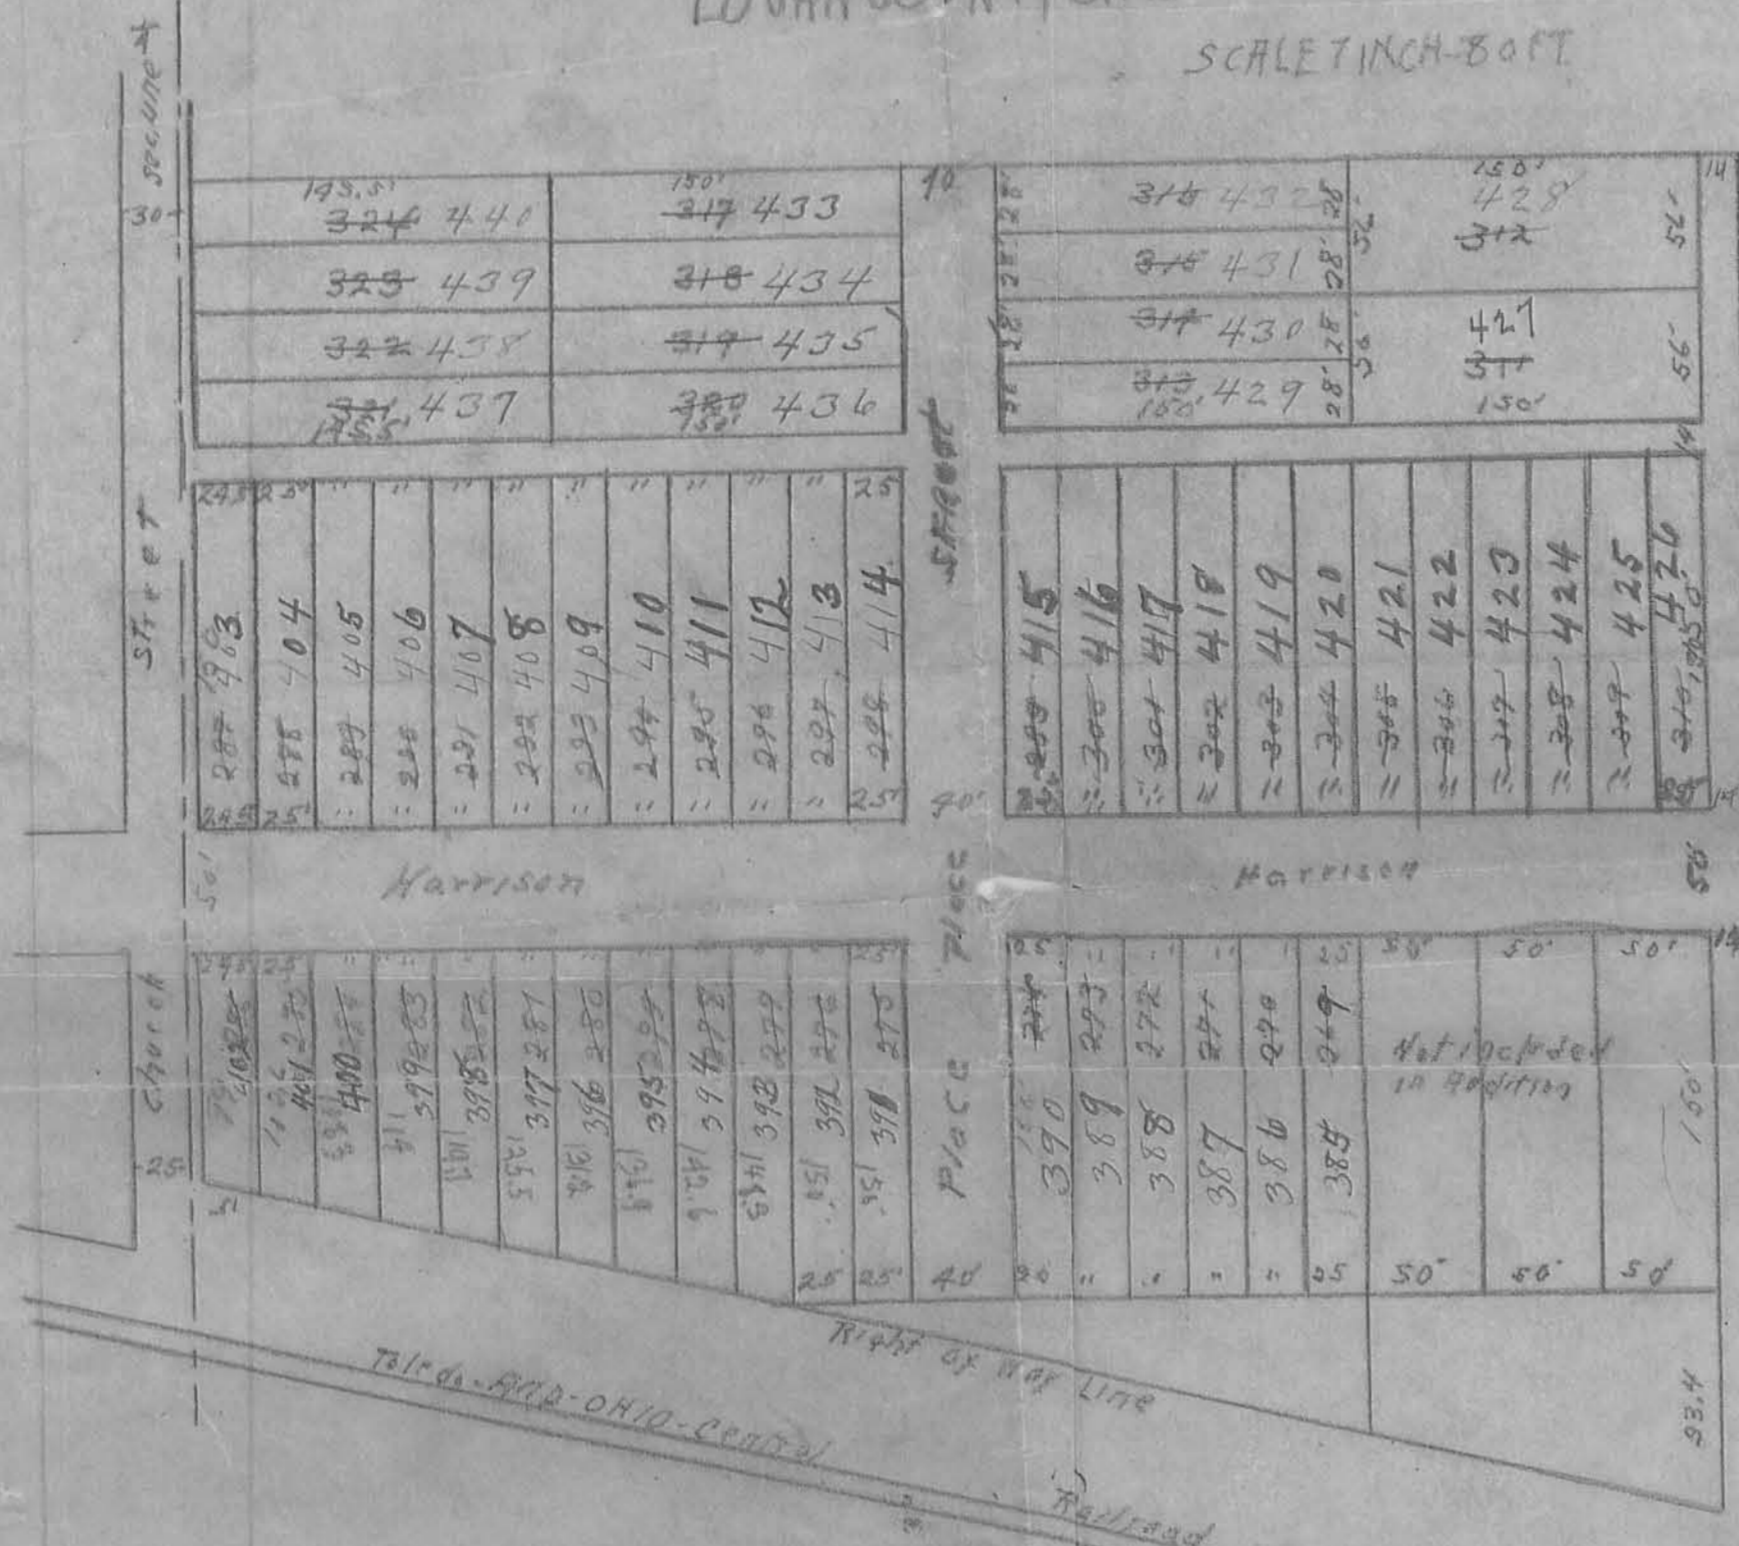

E. L. Vautson, Mayor  
Harry Talgore - Clerk

I hereby certify that the lots of this plat have been renumbered on the Auditor's Duplicate according to new numbers which appear in red on this plat

W. W. Corbet  
County Auditor  
Per W. W. Corbet, Deputy

accepted by Council this day of June 1919  
James A. Mauer Mayor  
Attest Guya Boyer Clerk  
Logan County Ohio

W. B. Brunner  
Trustworthy Councilman  
T. L. Hoover  
H. L. Hoffman  
H. H. Hoyer  
J. S. [unclear]  
1-4-1915  
Logan County Auditor  
In error.

41152