

PIRATE'S COVE AT INDIAN LAKE CONDOMINIUM

PHASE IV

EXHIBIT B TO DECLARATION AND BYLAWS OF

16.752 ACRE TRACT, OFFICIAL RECORD 795, PAGE 858
 0.115 ACRE TRACT, OFFICIAL RECORD 796, PAGE 255
 VIRGINIA MILITARY SURVEYS 10121, 9946 AND 9925
 WASHINGTON TOWNSHIP, LOGAN COUNTY, OHIO



SURVEYOR'S CERTIFICATION:

THE DRAWINGS ACCURATELY REFLECT THE LOCATION OF IMPROVEMENTS AND RECORDED EASEMENTS.

WILLIAM F. TINSLEY, JR.
 VOL. 351, PG. 217
 (2,855 ACRES REMAIN)

WILLIAM K. BRUCE
 PROFESSIONAL SURVEYOR 7457
 NOVEMBER 3, 2008



COPYRIGHT 2008 BY:
 LEE SURVEYING & MAPPING CO., I.N.C.
 117 N. MAIN AVE., SUITE 101
 WASHINGTON, OHIO 45781
 (637) 983-7335

ARCHITECT'S CERTIFICATION:

THE DRAWINGS ACCURATELY SHOW EACH BUILDING AS-BUILT OR CONSTRUCTED.

ALEXANDER LUDLO
 PROFESSIONAL ARCHITECT OHIO 5082
 NOVEMBER 3, 2008

3 WORKING DAYS
BEFORE YOU DIG
 CALL TOLL FREE 800-362-2764
 AND OBTAIN THE NEAREST SERVICE.

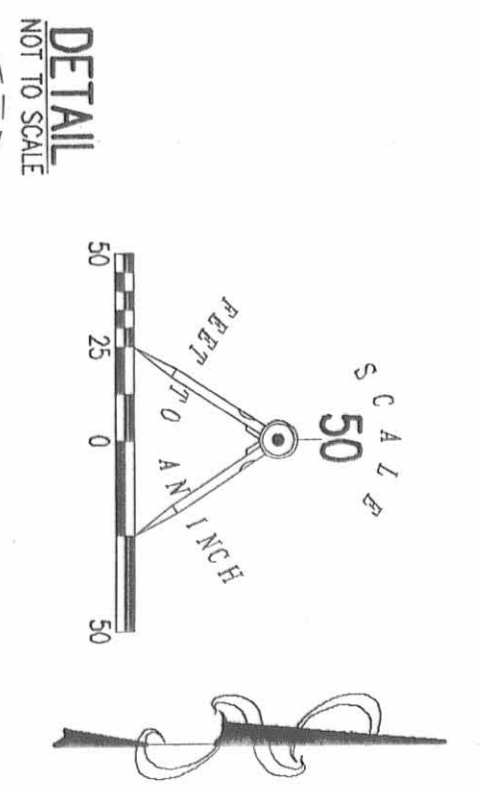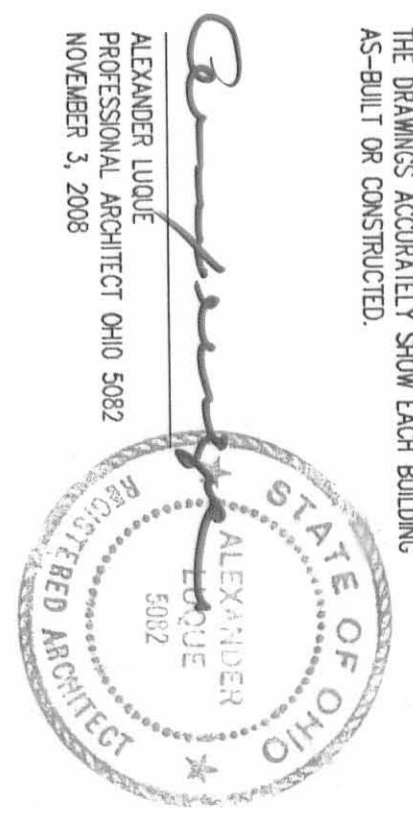


- NOTES:**
1. EASEMENTS IF SHOWN ARE AS PROVIDED BY DEVELOPER. THE SURVEYOR DID NOT SEARCH FOR ADDITIONAL EASEMENTS.
 2. THE WORD "CERTIFY" IS INTENDED TO BE AS DEFINED IN OHIO ADMINISTRATIVE CODE 4733-35-04(C).
 3. BUILDING HEIGHT FROM PEAK OF ROOF TO GROUND. BUILDING 17 IS 30'S.

PRE-APPROVAL *Jan 11* 12-23-08
 PLAT CHECKED *Jan 11* 12-23-08
 TRANSFERRED THIS 23rd DAY OF December, 2008
Michael S. Hyatt
 AUDITOR, LOGAN COUNTY, OHIO


RECORDED IN PLAT CABINET B, SLIDE 118A-118B
 RECEIVED FOR RECORD AT 10:34 A.M. 07:00:00
 THIS 23rd DAY OF December, 2008
Janice S. Hanson
 RECORDER, LOGAN COUNTY, OHIO

200800822

CABINET B SLIDE 118A

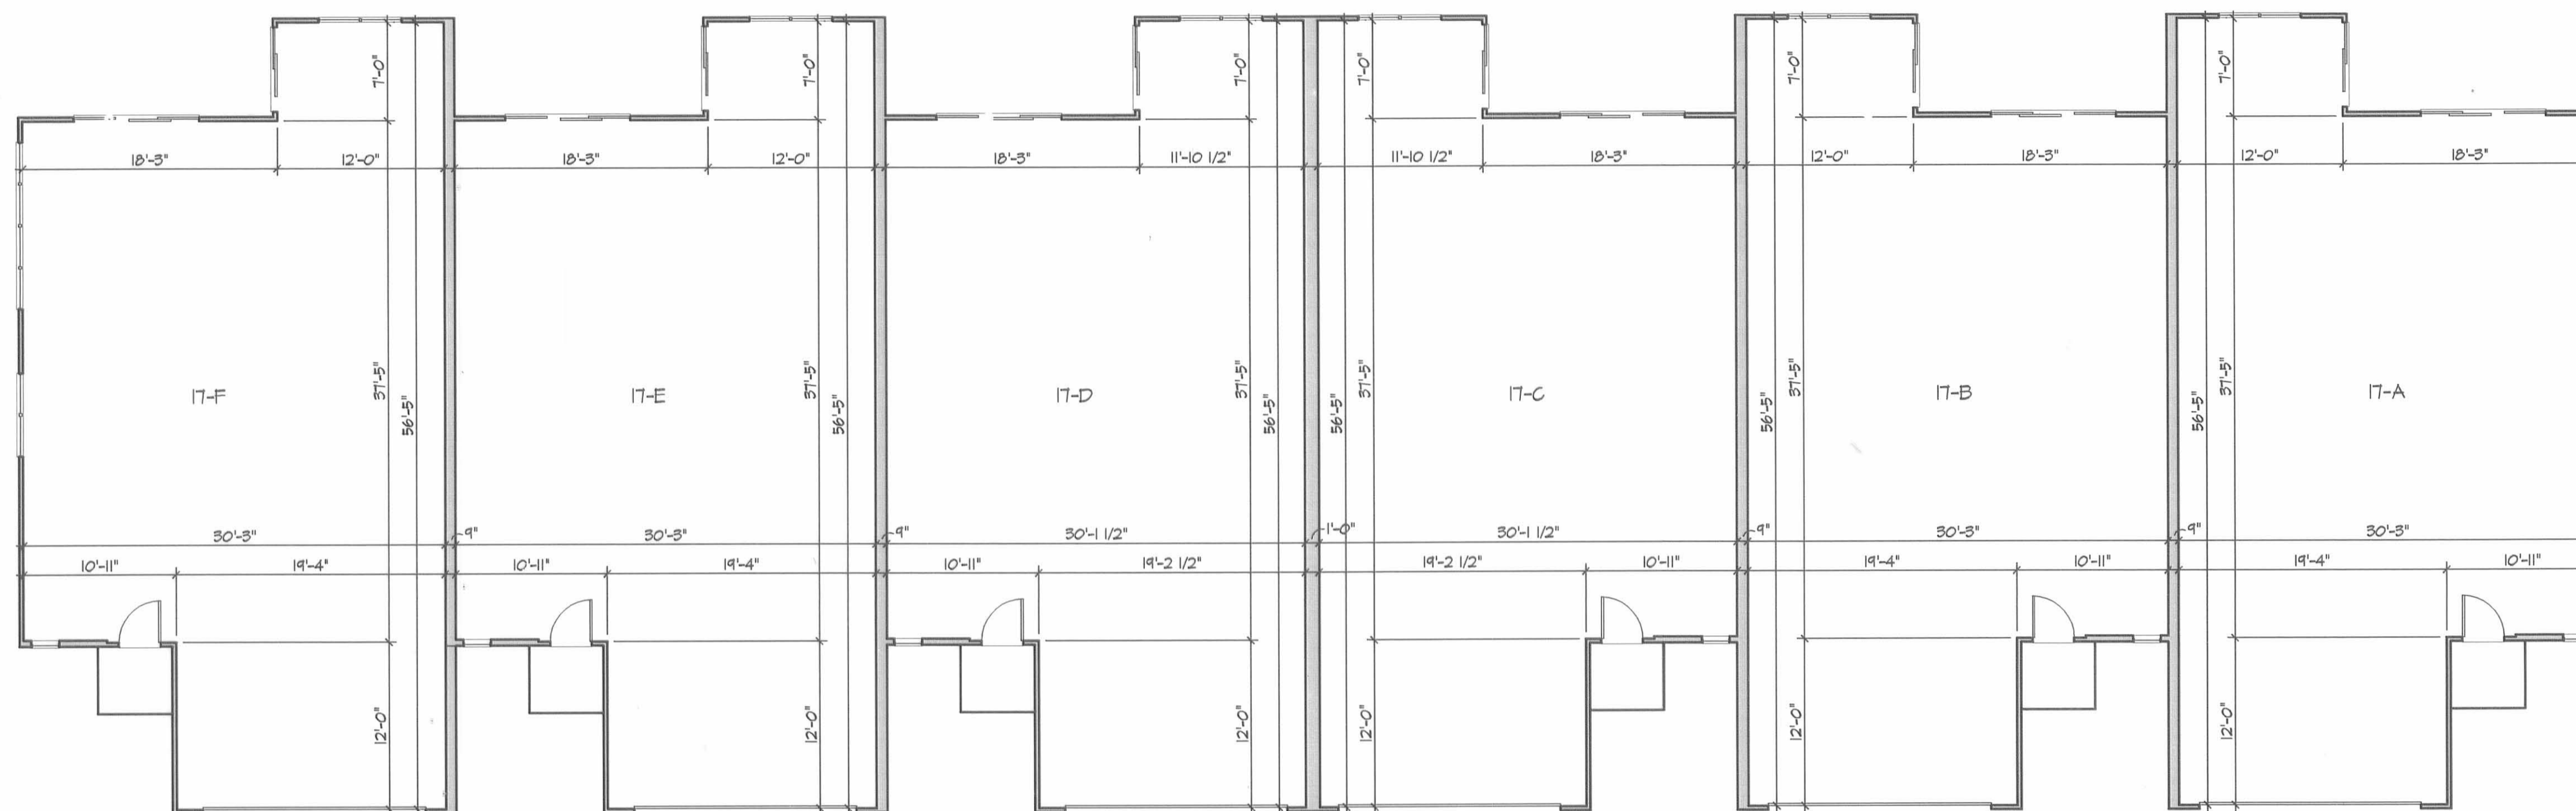

UPPER LEVEL BUILDING PLAN (6 UNIT BLDG.) BUILDING 17
GRAPHIC SCALE: 0 4'-0" 8'-0" 16'-0"

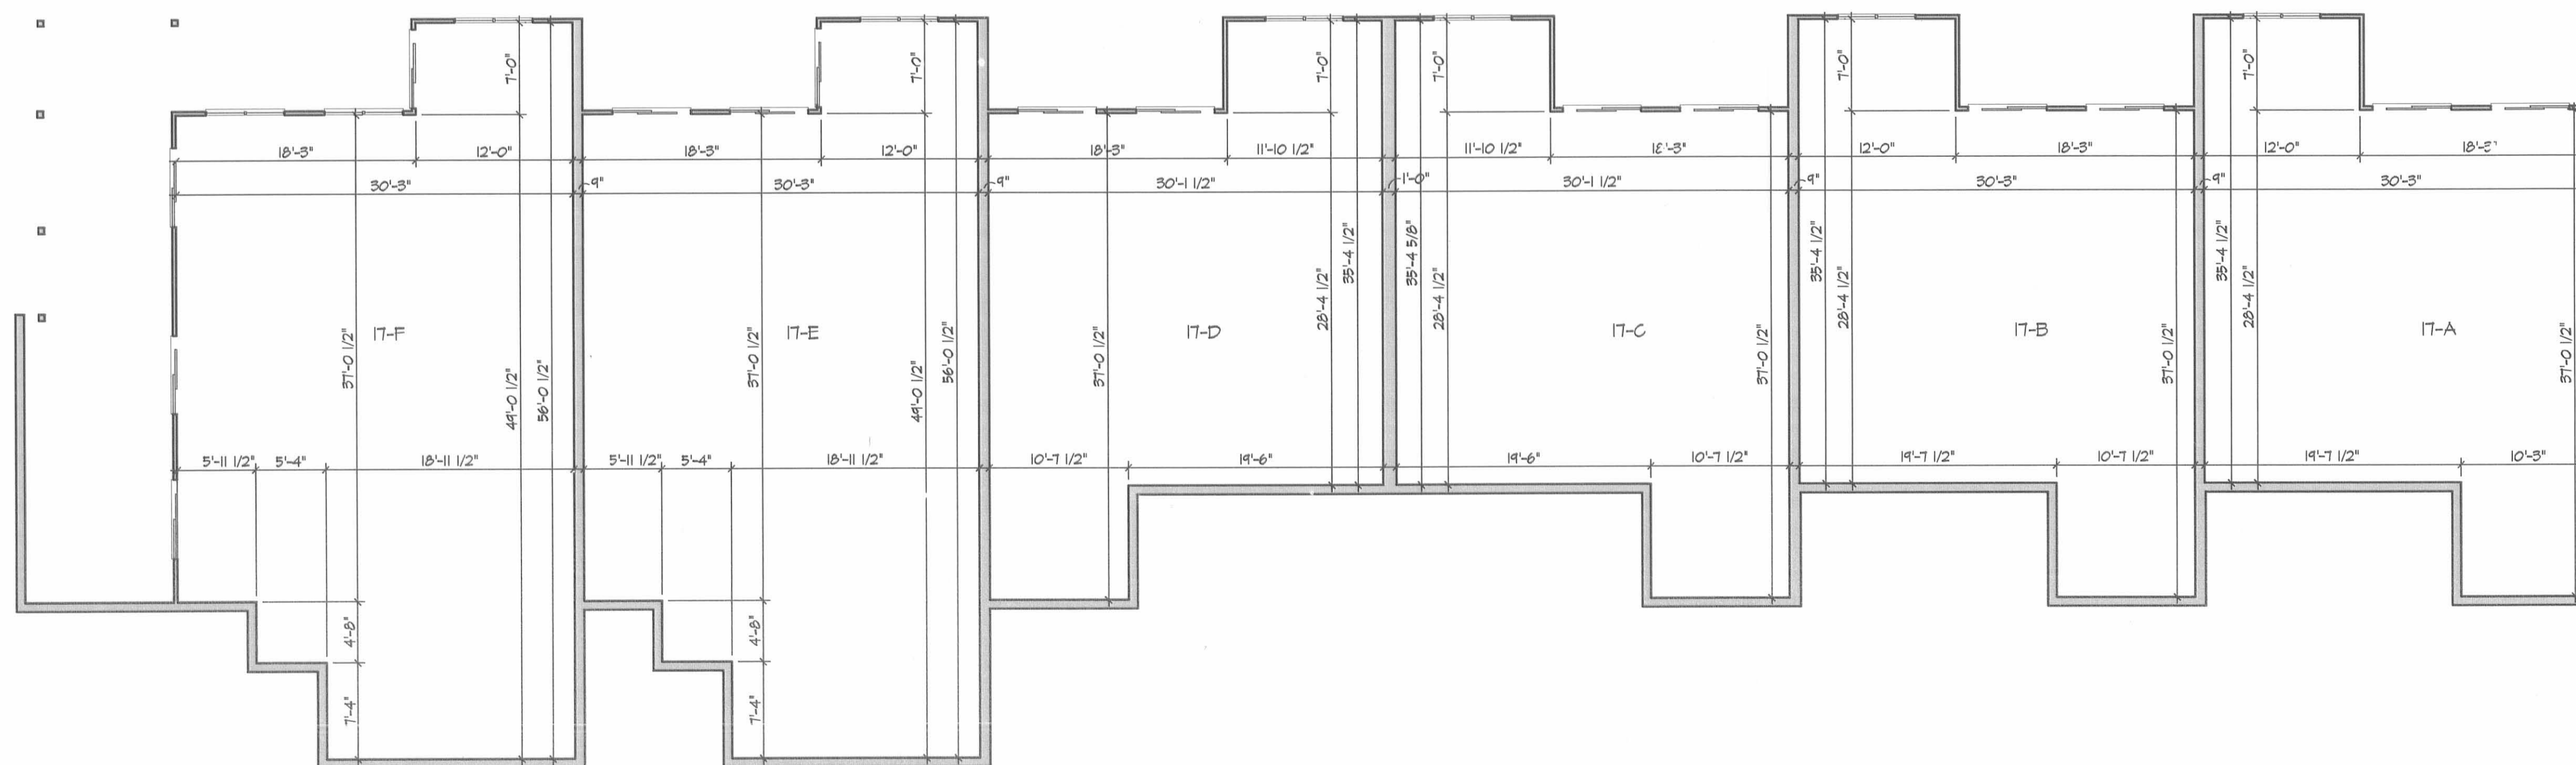

LOWER LEVEL BUILDING PLAN (6 UNIT BLDG.) BUILDING 17
GRAPHIC SCALE: 0 4'-0" 8'-0" 16'-0"


ARCHITECT'S CERTIFICATION

THE UNDERSIGNED CERTIFIES THAT THE DRAWINGS ACCURATELY SHOWS EACH BUILDING AS BUILT OR CONSTRUCTED

Alexander Luque
ALEXANDER LUQUE
REGISTERED ARCHITECT OHIO 5082

Nov. 24, 2008



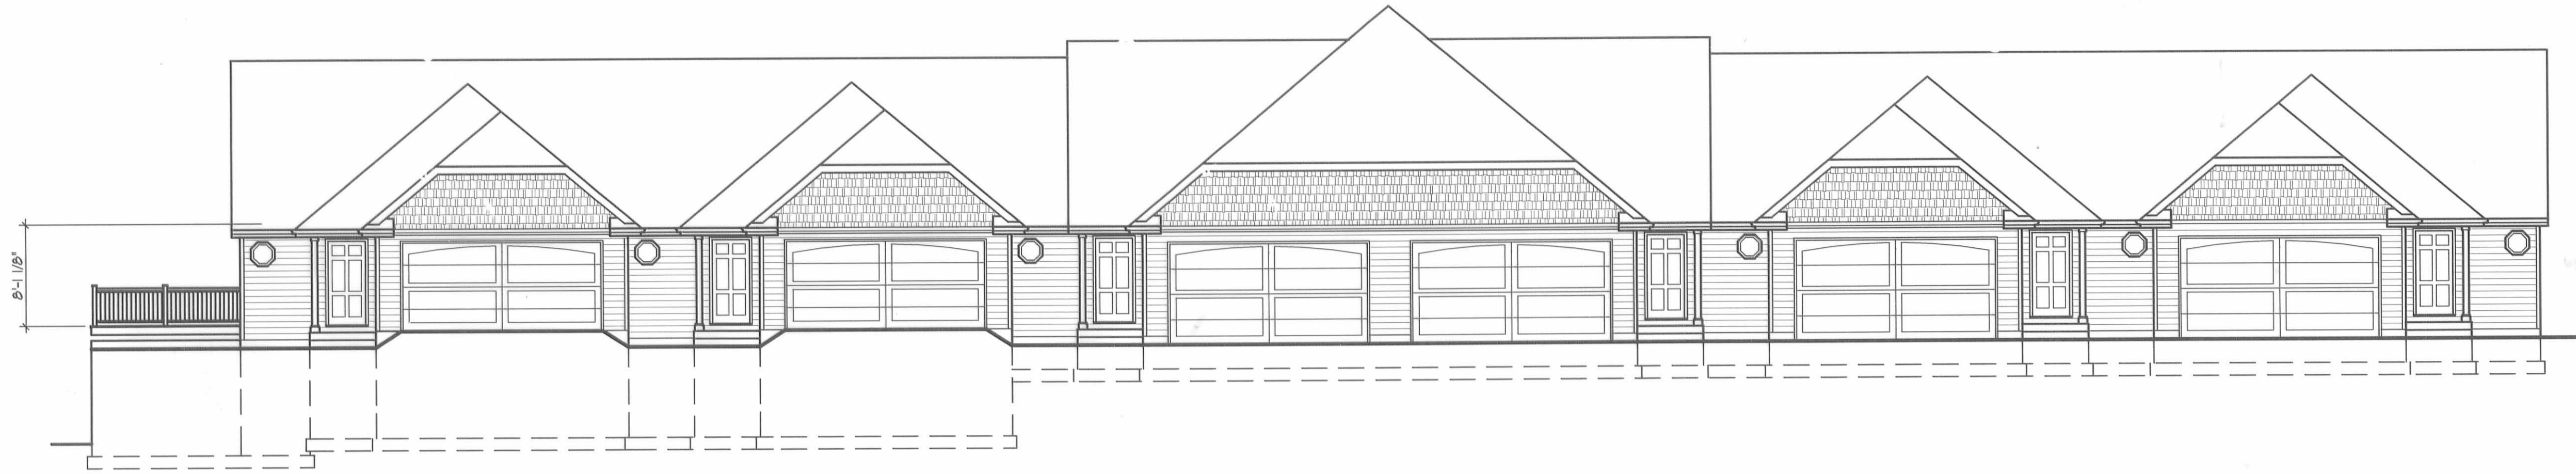

FRONT ELEVATION (6 UNIT BLDG.) BUILDING 17
GRAPHIC SCALE: 0 4'-0\"/>



LEFT SIDE ELEVATION (6 UNIT BLDG.) BUILDING 17
GRAPHIC SCALE: 0 4'-0\"/>



RIGHT SIDE ELEVATION (6 UNIT BLDG.) BUILDING 17
GRAPHIC SCALE: 0 4'-0\"/>



REAR ELEVATION (6 UNIT BLDG.) BUILDING 17
GRAPHIC SCALE: 0 4'-0\"/>

ARCHITECT'S CERTIFICATION

THE UNDERSIGNED CERTIFIES THAT THE DRAWINGS ACCURATELY SHOWS EACH BUILDING AS BUILT OR CONSTRUCTED

Alexander Luque
ALEXANDER LUQUE
REGISTERED ARCHITECT OHIO 5082



NOV. 24, 2008

J-321