


CABINET B SLIDE 124A

EXHIBIT B TO DECLARATION AND BYLAWS OF

# PIRATE'S COVE AT INDIAN LAKE CONDOMINIUM PHASE II-AMENDED

16.752 ACRE TRACT, OFFICIAL RECORD 795, PAGE 858 AND 0.115 ACRE TRACT, OFFICIAL RECORD 796, PAGE 255,  
VIRGINIA MILITARY SURVEYS 10121, 9946 AND 9925  
WASHINGTON TOWNSHIP, LOGAN COUNTY, OHIO

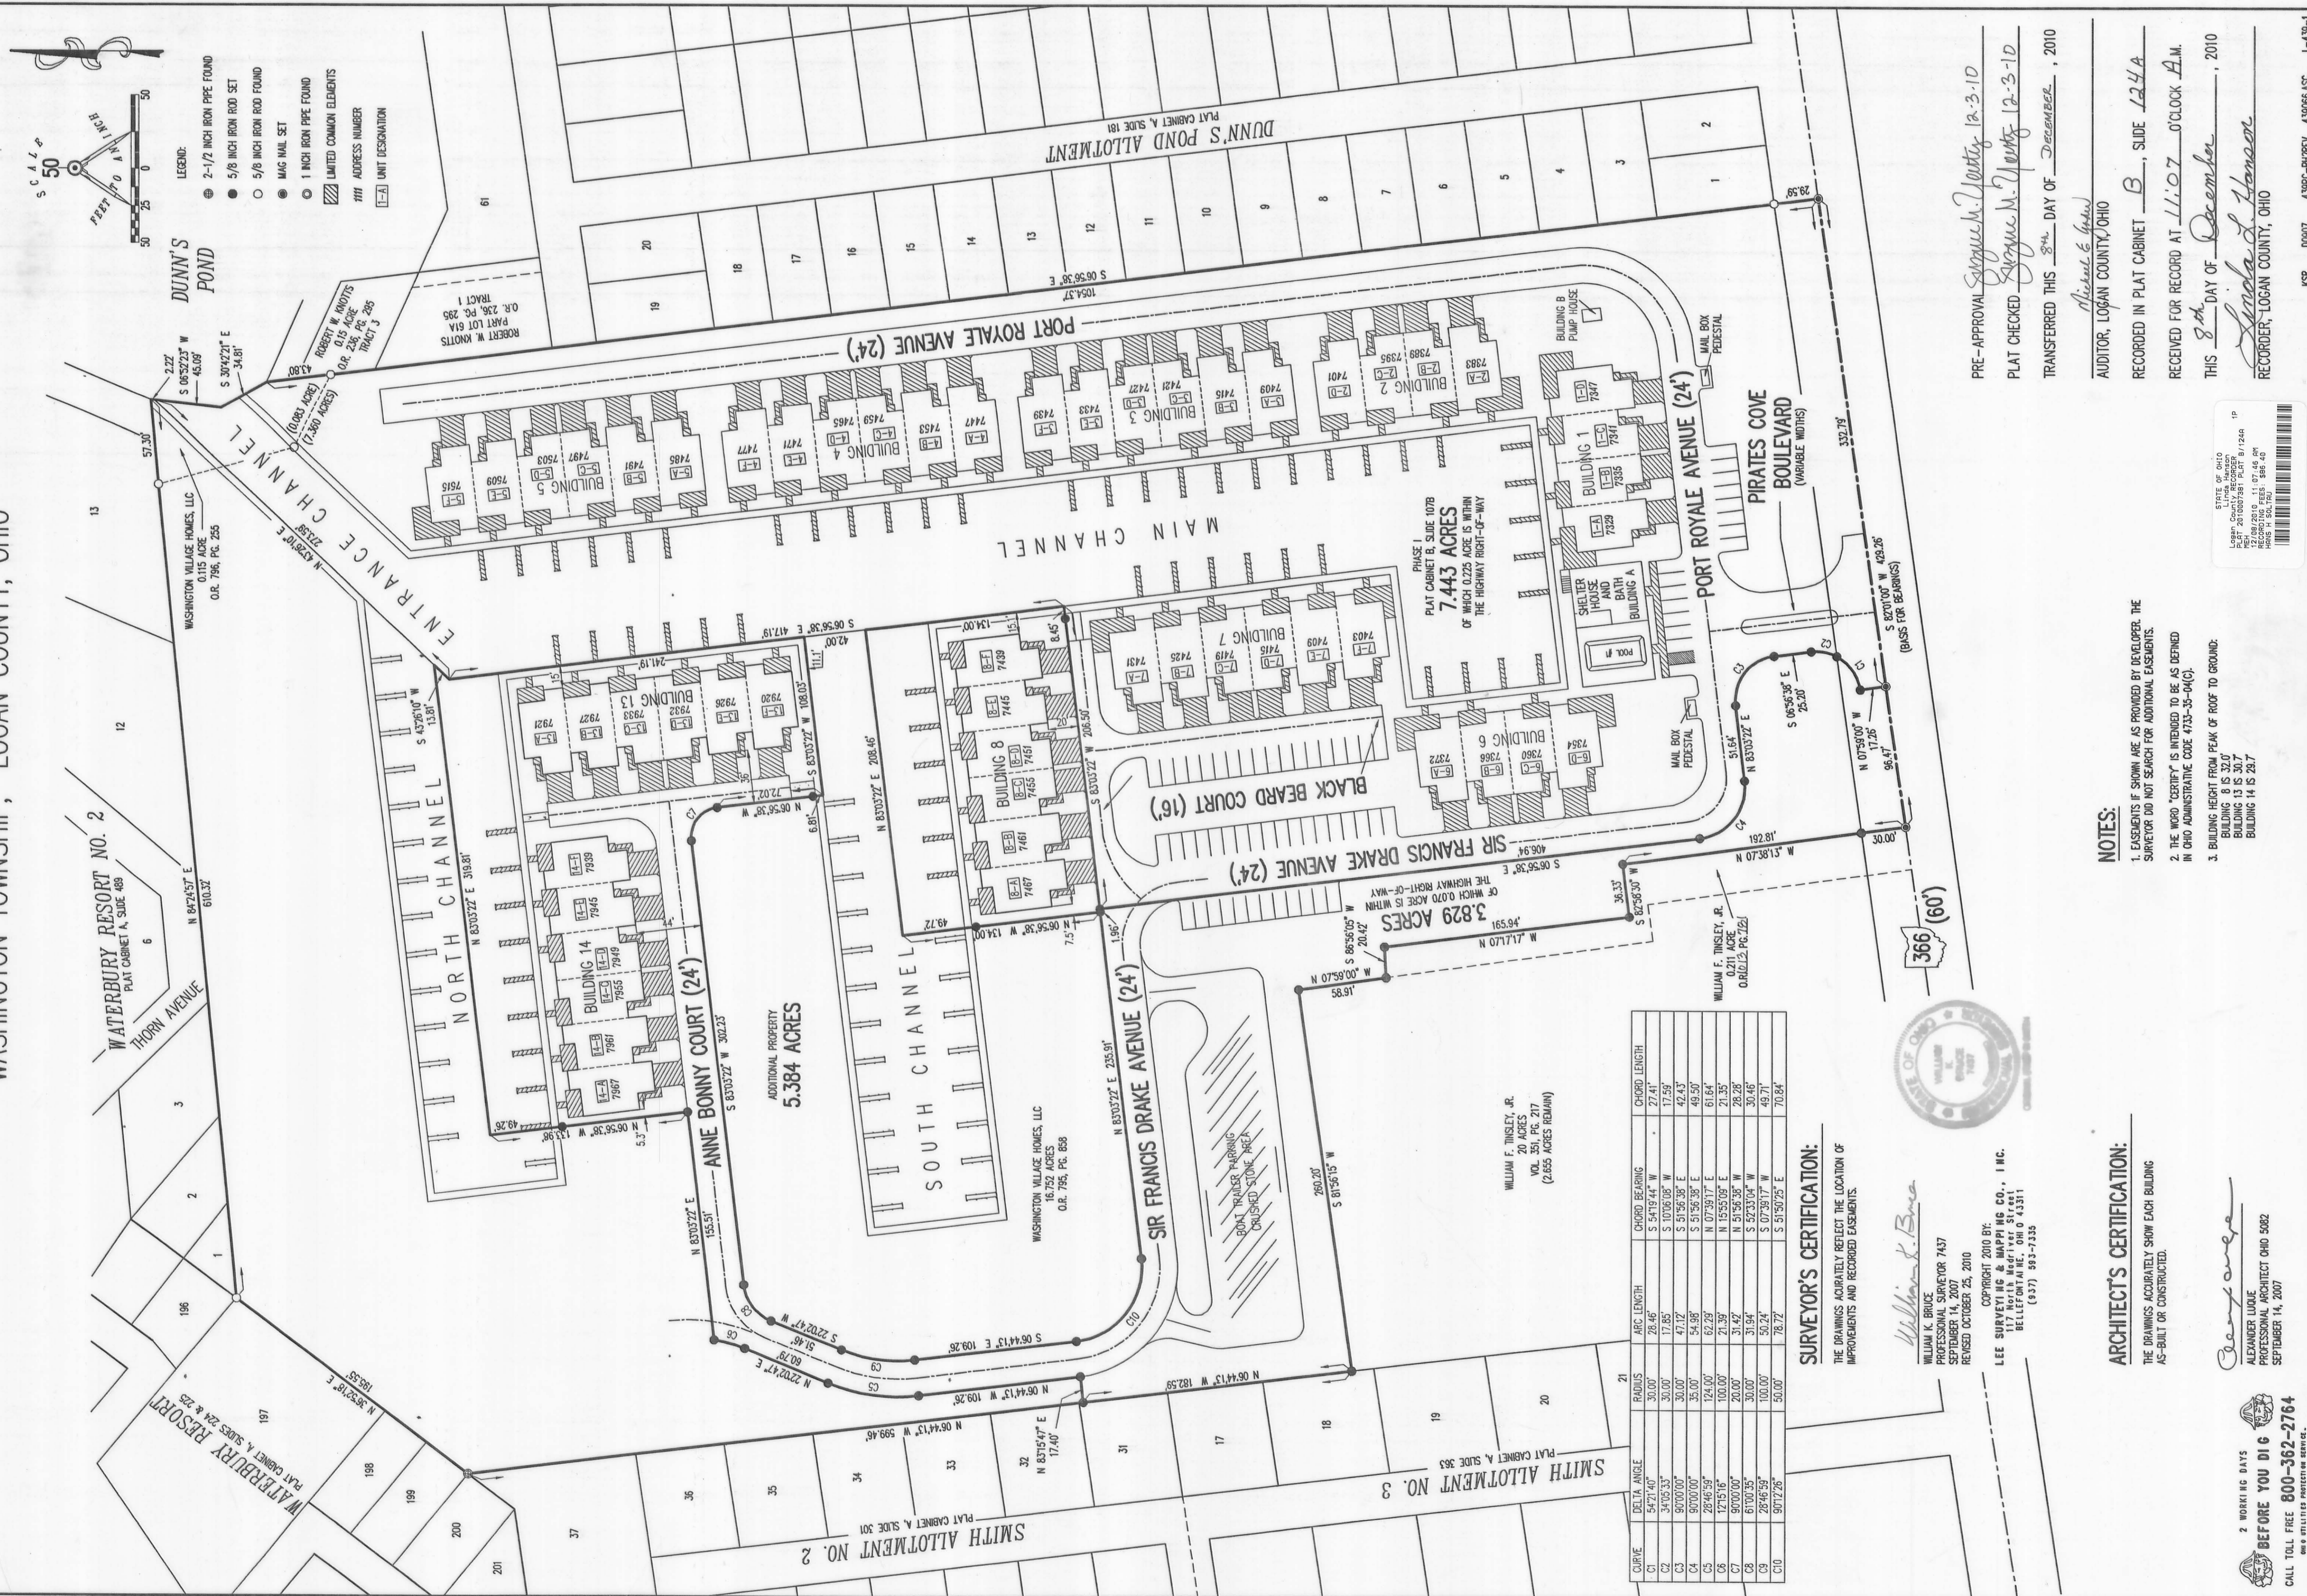

CURVE	DELTA ANGLE	RADIUS	ARC LENGTH	CHORD BEARING	CHORD LENGTH
C1	54°21'40"	30.00'	28.46'	S 54°18'44" W	27.41'
C2	34°05'33"	30.00'	17.85'	S 10°06'08" E	17.59'
C3	9°00'00"	30.00'	47.12'	S 51°56'38" E	42.43'
C4	9°00'00"	35.00'	54.98'	S 51°56'38" E	49.50'
C5	28°46'59"	124.00'	62.29'	N 07°39'17" E	61.64'
C6	1°15'16"	100.00'	21.39'	N 55°55'09" E	21.35'
C7	9°00'00"	20.00'	31.42'	N 51°56'38" E	28.28'
C8	6°00'35"	30.00'	31.94'	S 52°33'04" W	30.46'
C9	28°46'59"	100.00'	50.24'	S 07°39'17" W	49.71'
C10	9°01'26"	50.00'	78.72'	S 51°50'29" E	70.94'

**SURVEYOR'S CERTIFICATION:**  
THE DRAWINGS ACCURATELY REFLECT THE LOCATION OF IMPROVEMENTS AND RECORDED EASEMENTS.

*William K. Bruce*  
WILLIAM K. BRUCE  
PROFESSIONAL SURVEYOR 7437  
SEPTEMBER 14, 2007  
RENEWED OCTOBER 23, 2010

COPYRIGHT 2010 BY:  
LEE SURVEYING & MAPPING CO., INC.  
100 S. BELLEVUE AVE., SUITE 111  
BELLEFONTAINE, OHIO 43111  
(617) 953-7335

**ARCHITECT'S CERTIFICATION:**  
THE DRAWINGS ACCURATELY SHOW EACH BUILDING AS-BUILT OR CONSTRUCTED.


*Cheryl Anne*  
ALEXANDER LUDE  
PROFESSIONAL ARCHITECT OHIO 5082  
SEPTEMBER 14, 2007



- NOTES:**
- EASEMENTS IF SHOWN ARE PROVIDED BY DEVELOPER. THE SURVEYOR DID NOT SEARCH FOR ADDITIONAL EASEMENTS.
  - THE WORD "CERTIFY" IS INTENDED TO BE AS DEFINED IN OHIO ADMINISTRATIVE CODE 4733-35-04(C).
  - BUILDING HEIGHT FROM PEAK OF ROOF TO GROUND:  
BUILDING 8 IS 32.0'  
BUILDING 13 IS 30.7'  
BUILDING 14 IS 28.7'

PRE-APPROVAL *Stephen M. Dwyer* 12-3-10  
PLAT CHECKED *Stephen M. Dwyer* 12-3-10  
TRANSFERRED THIS 8th DAY OF December, 2010

*Michael E. Gahan*  
AUDITOR, LOGAN COUNTY, OHIO  
RECORDED IN PLAT CABINET B, SLIDE 124A  
RECEIVED FOR RECORD AT 11:07 O'CLOCK A.M.  
THIS 8th DAY OF December, 2010  
*Stephanie L. Hansen*  
RECORDER, LOGAN COUNTY, OHIO

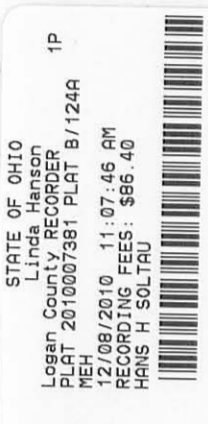

2 WORKING DAYS  
BEFORE YOU DIG  
CALL TOLL FREE 800-362-2764  
AND A PUBLIC ENGINEER SERVICE.