


FHWA REGION	STATE	PROJECT
5	OHIO	

1
2

LOGAN COUNTY
LOG-235-239

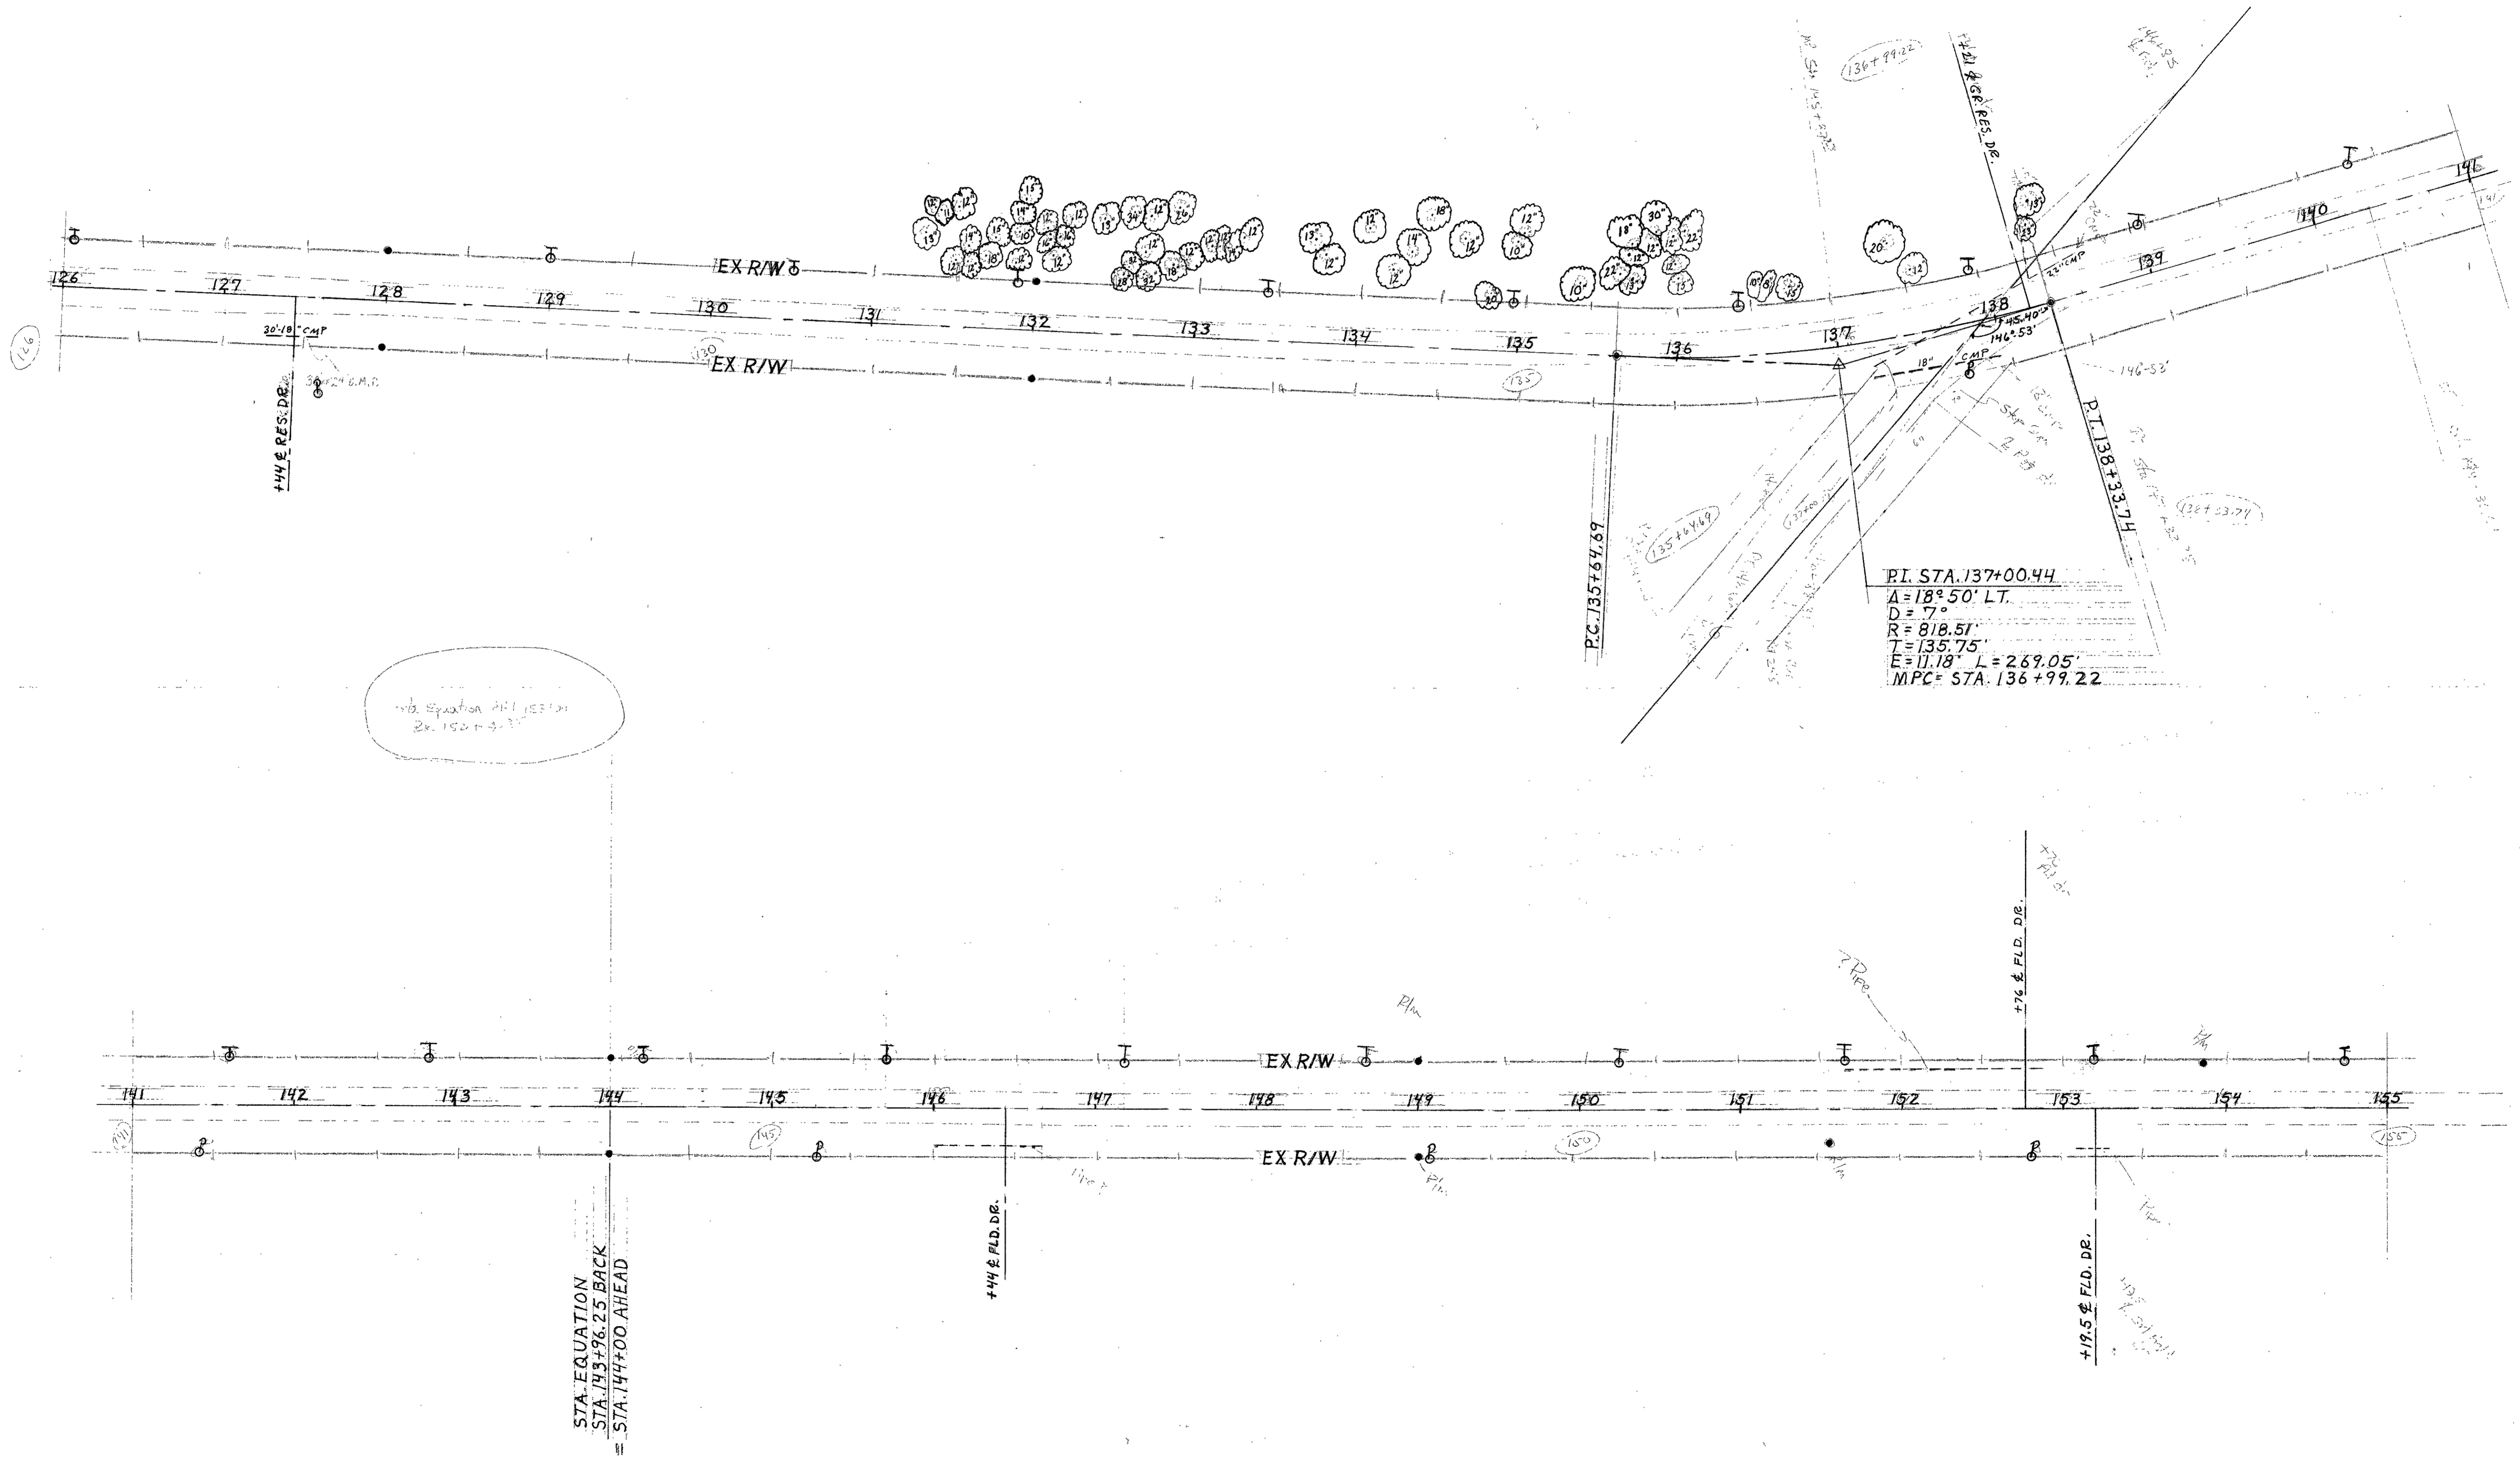

Mid Equation PI Station
Sta. 152+5.37

STA. EQUATION
STA. 143+96.25 BACK
= STA. 144+00 AHEAD

PI STA. 137+00.44
Δ = 18° 50' LT.
D = 7°
R = 818.51'
T = 135.75'
E = 11.18' L = 269.05'
MPC = STA. 136+99.22

126-155

FHWA REGION	STATE	PROJECT
5	OHIO	

2
2

LOGAN COUNTY 235
LOG-235-2.39

