
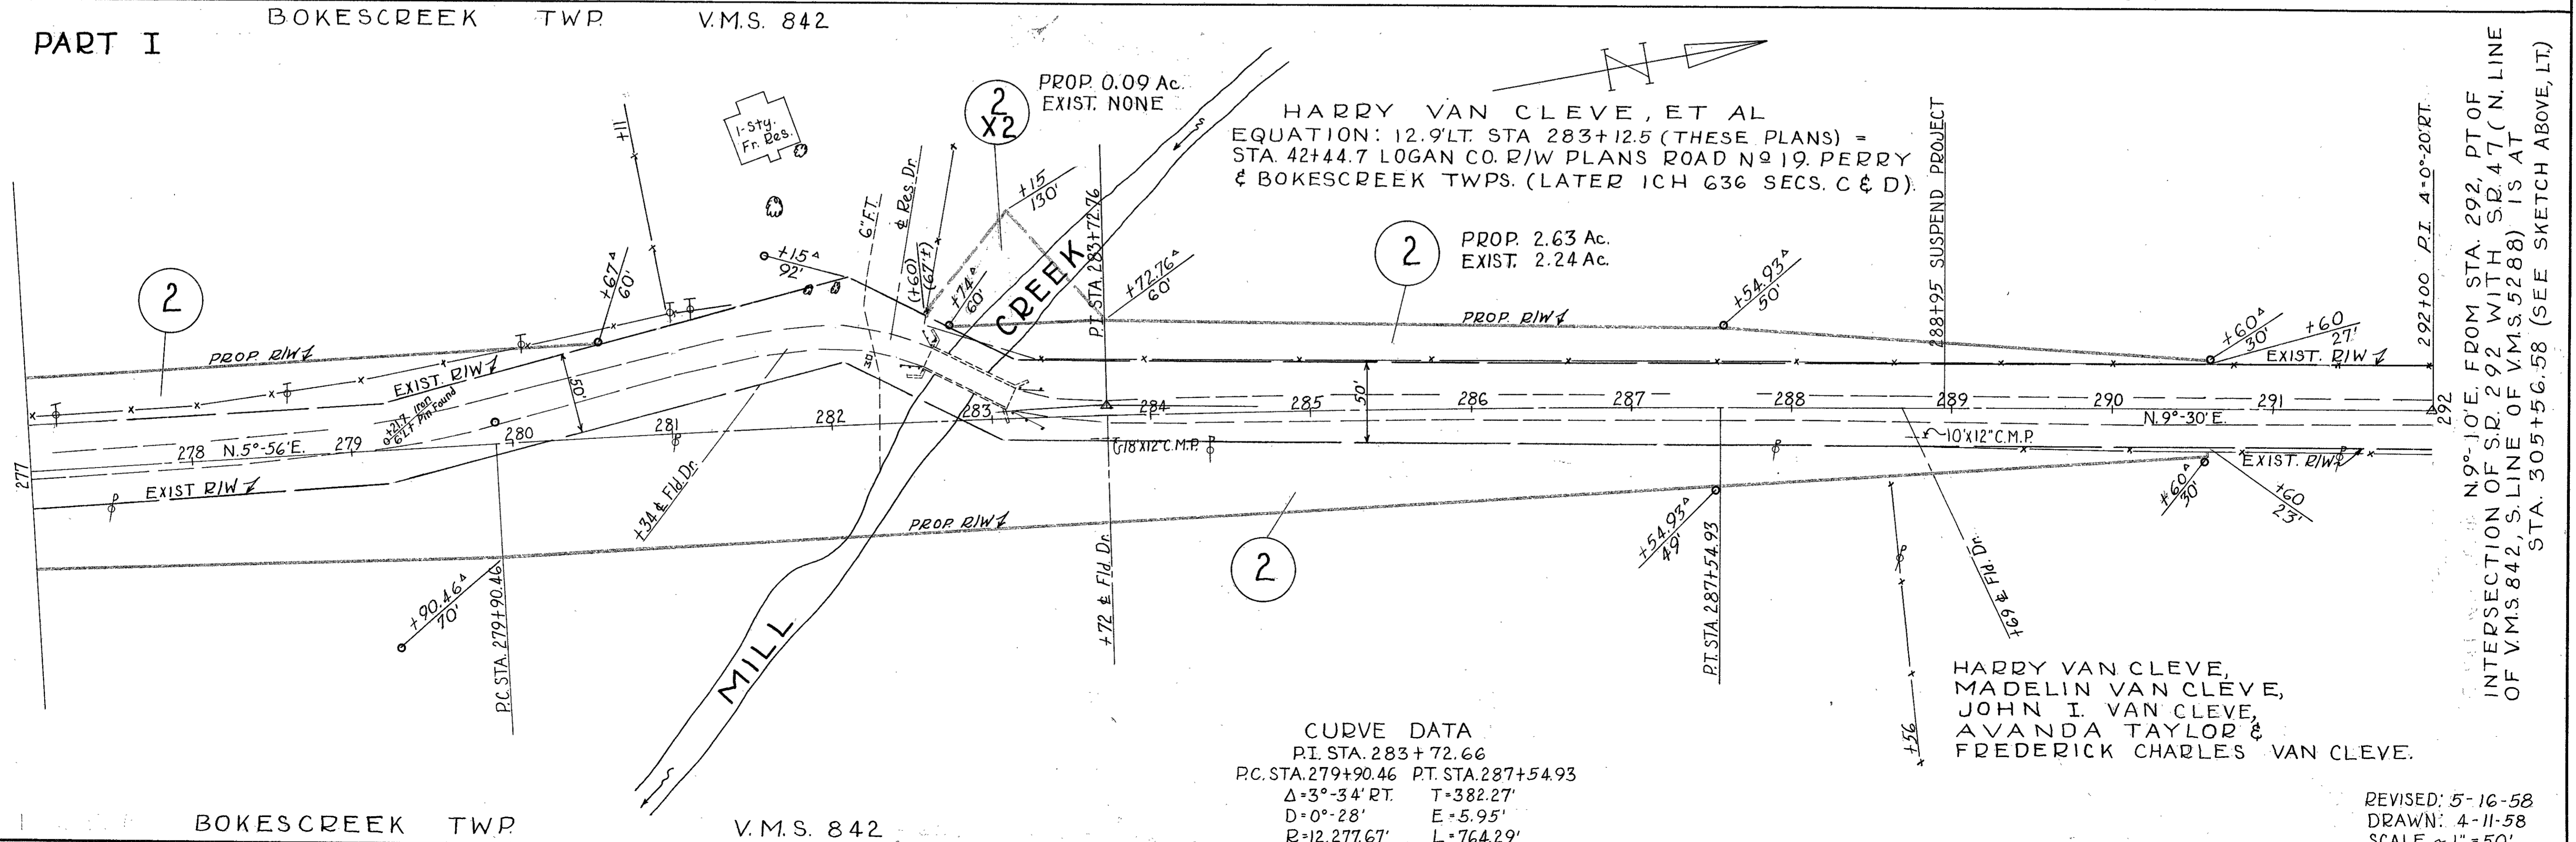


LOCATION & R/W PLAN

INDEX OF PARCELS

PAR. NO.	OWNER	AREA ACRES	EXISTING STRUCTURES	SHEET No.'S	REMARKS	RECORDING DATA VOL. PG. DATE
1	WILLIAM L. SMITH, ET AL	0.07		1		252 445-47 8-1-58
2	HARRY VAN CLEVE, ET AL	2.63		1		252 454-59 8-1-58
2X1	" " " "	0.07		1		
2X2	" " " "	0.09		1		
3	HATTIE C. ELLIOTT	0.49		2		252 417-19 8-1-58
4	MORETA BELL DIXON	0.52		2		252 430-34 8-1-58
4X	" " " "	0.20		2		
5	NOVABELL SHORT	0.54		2		252 420-24 8-1-58
5X	" " " "	0.50		2		
6	EDWARD E. PATTERSON, ET AL	0.38		3		252 448-53 8-1-58
6X1	" " " "	0.35		3		
6X2	" " " "	0.35		3		
7	ROSA FORD	0.06		3		252 414-16 8-1-58
8	RALPH ROESCH	0.21		3		253 94-96 8-15-58
8X1	" " " "	0.03		3		5(Band) 193-4 8-15-58
8X2	" " " "	0.10		3		
9	MININIE M. WILLIAMS	0.11		3		252 425-29 8-1-58
9X	" " " "	0.18		3		

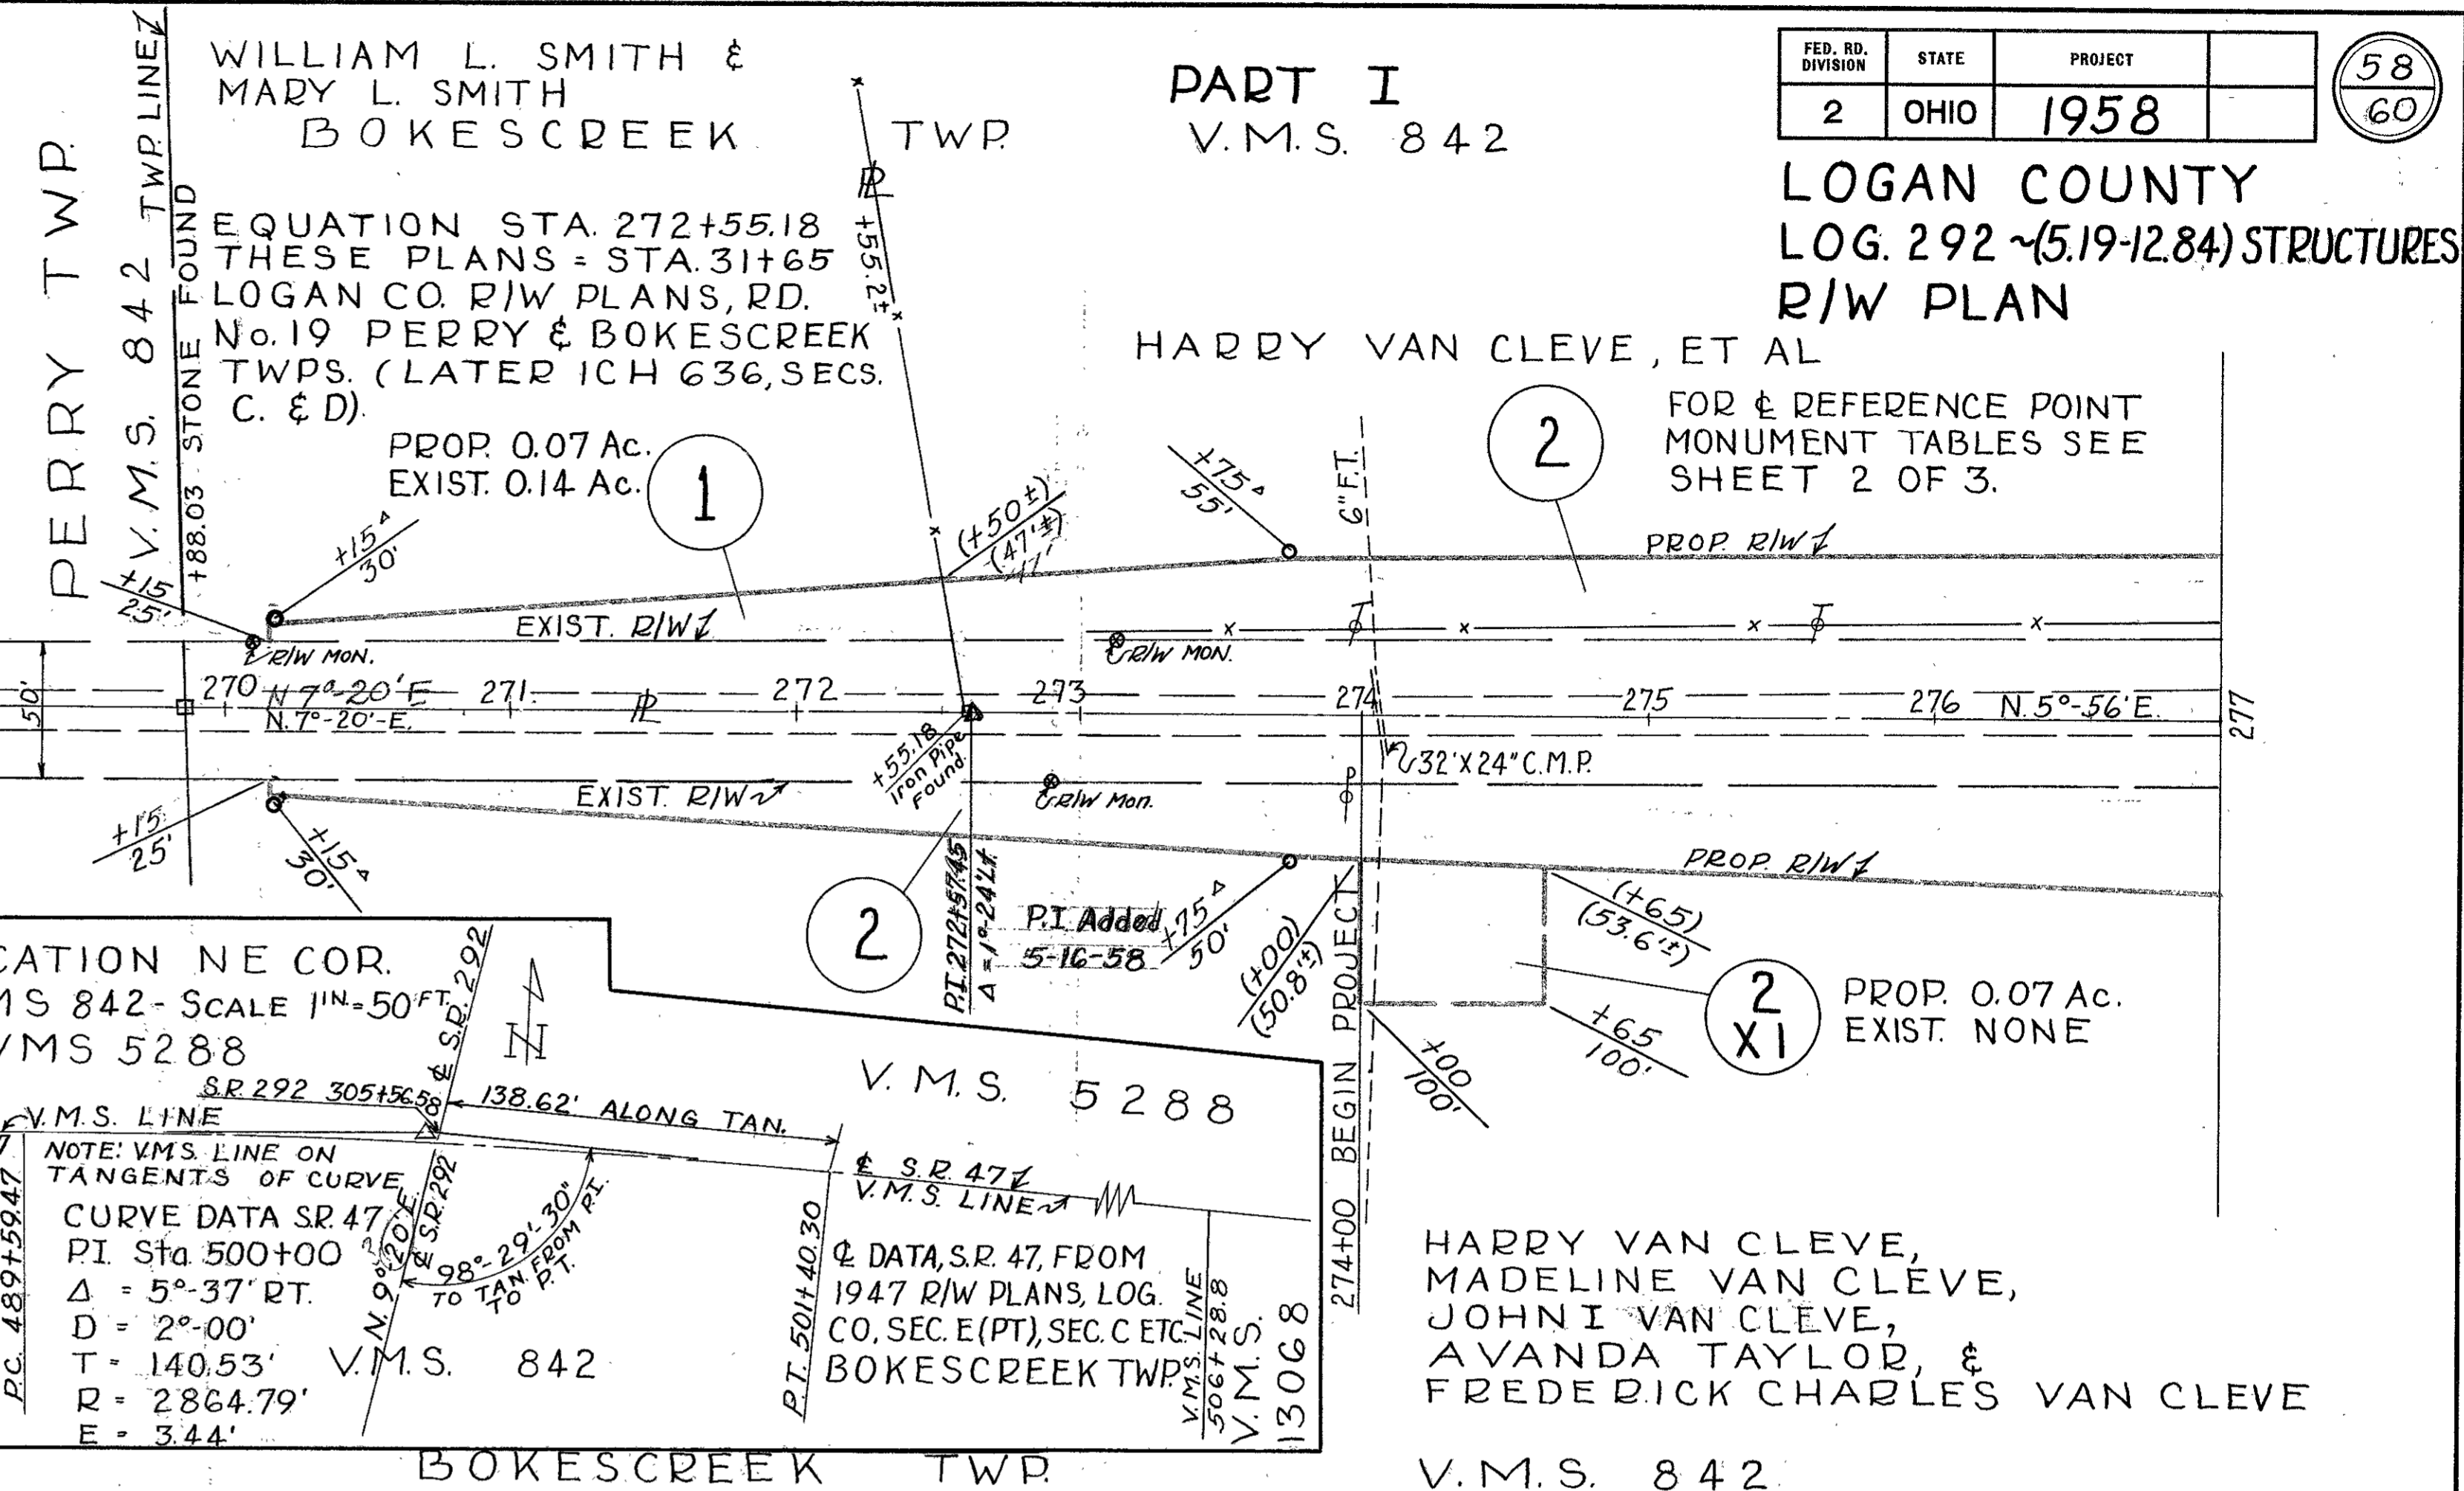

PART II

BOKESCREEK TWP

V.M.S. 5288

LOCATION & R/W PLAN

BOKESCREEK TWP V.M.S. 9890
 MORETA BELL DIXON, MARRIED
 FORMERLY MORETA BELL


FED. RD. DIVISION	STATE	PROJECT
2	OHIO	1958

59
60

LOGAN COUNTY
 LOG. 292 ~ (5.19-12.84) STRUCTURES
 R/W PLAN

HATTIE C. ELLIOTT
 EQUATION: STA. 376+97.1, THESE PLANS = STA.
 136+26.7 LOGAN CO. R/W PLANS, RD. NO. 19
 PERRY & BOKESCREEK TWPS. (LATER ICH
 C36 SECS. C & D.)

SHEET
 375
 BEGIN

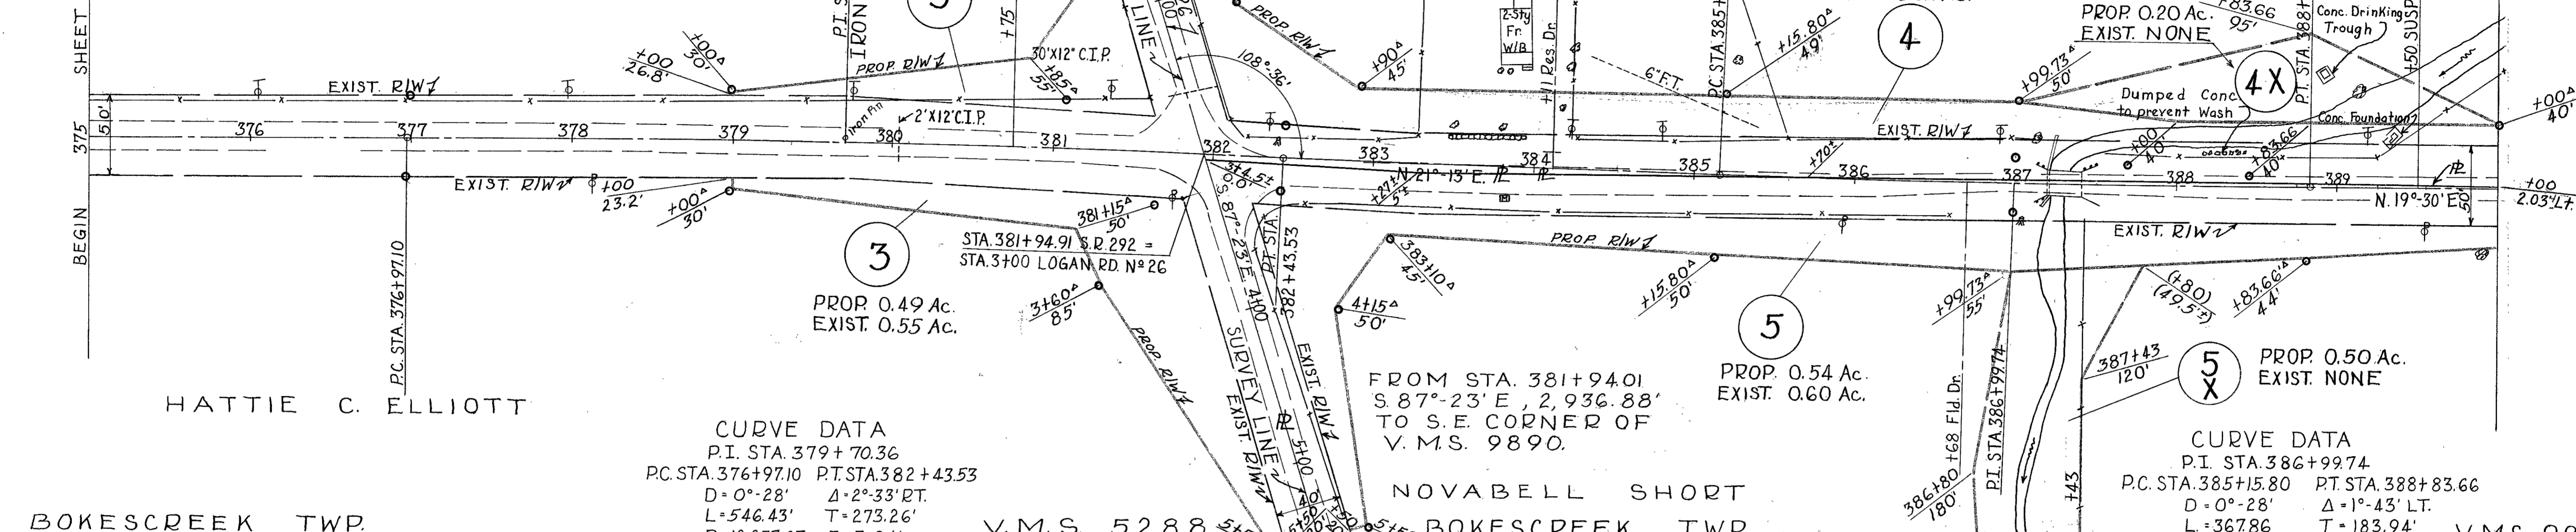

HATTIE C. ELLIOTT

BOKESCREEK TWP


CURVE DATA
 P.I. STA. 379+70.36
 PC. STA. 376+97.10 P.T. STA. 382+43.53
 D=0°-28' Δ=2°-33' RT.
 L=546.43' T=273.26'
 R=12,277.67' E=3.04'

V.M.S. 5288

NOVABELL SHORT
 BOKESCREEK TWP

V.M.S. 9890

BOKESCREEK TWP
 MORETA BELL DIXON, MARRIED
 FORMERLY MORETA BELL

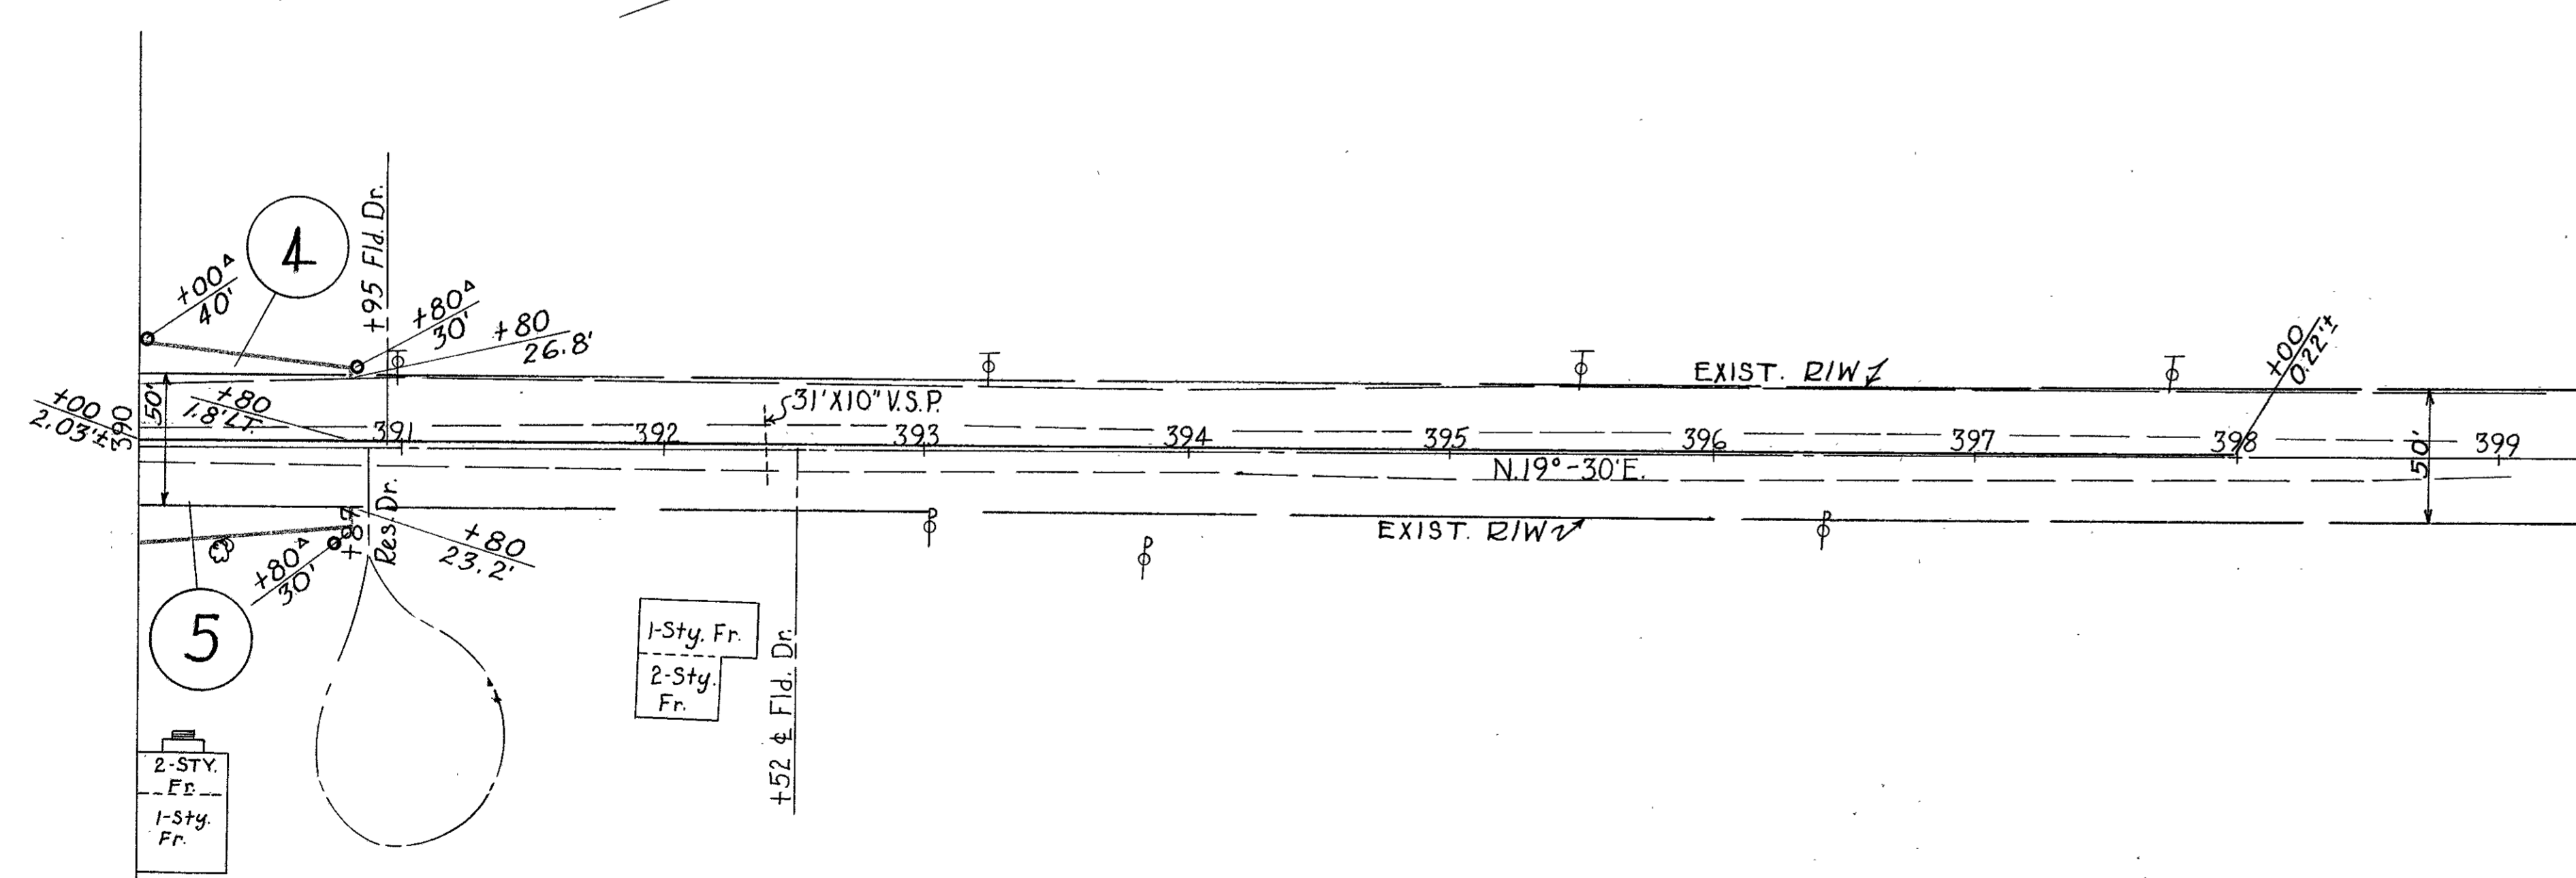


NOVABELL SHORT

BOKESCREEK TWP

V.M.S. 9890

REFERENCE POINT MONUMENTS TO BE SET AFTER CONSTRUCTION					
STATION	DISTANCE FROM &		STATION	DISTANCE FROM &	
	LT.	RT.		LT.	RT.
PART I			PT. 388+83.66	40	44
270+15	30	30	390+80	30	30
273+75	55	50	PART III		
PC. 279+90.46	14	70	465+30	40	30
MP. 283+72.60	SEE DETAIL A		467+50	40	55
PT. 287+54.93	50	49	470+05	30	30
290+60	30	30	PART IV		
PART II			677+00	30	30
PC. 376+97.10	25	25	682+35	30	30
379+00	30	30	CO. ROAD N° 26		
PT. 382+43.53	20	20	0+30	30	30
PC. 385+15.80	49	50	5+50	30	30
MP. 386+99.73	15	17	MON. SET 1958		

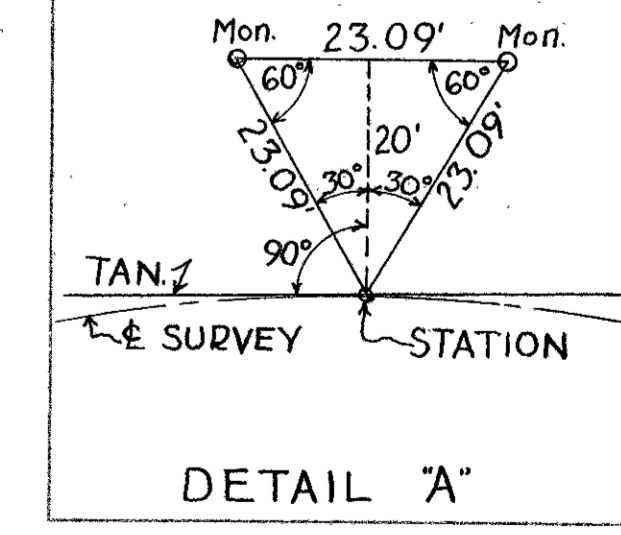

TYPICAL DETAIL FOR SETTING & LOCATION MONUMENTS

DETAIL 'A'

For Sta. & Dist. See Table Above

RECORDED DATE 5-6 1958
 VOL. 1
 PAGE 16-17-18

APPROVED DATE 26 May 19 58
 REGISTERED SURVEYOR - DIV. N° 7
 REGISTERED ENGINEER N° 3128

REVISED DRAWN: 4-11-58
 SCALE ~ 1" = 50'

