



L-22

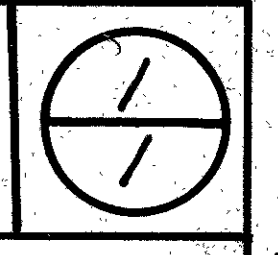


● Indicates R/W Monuments

15

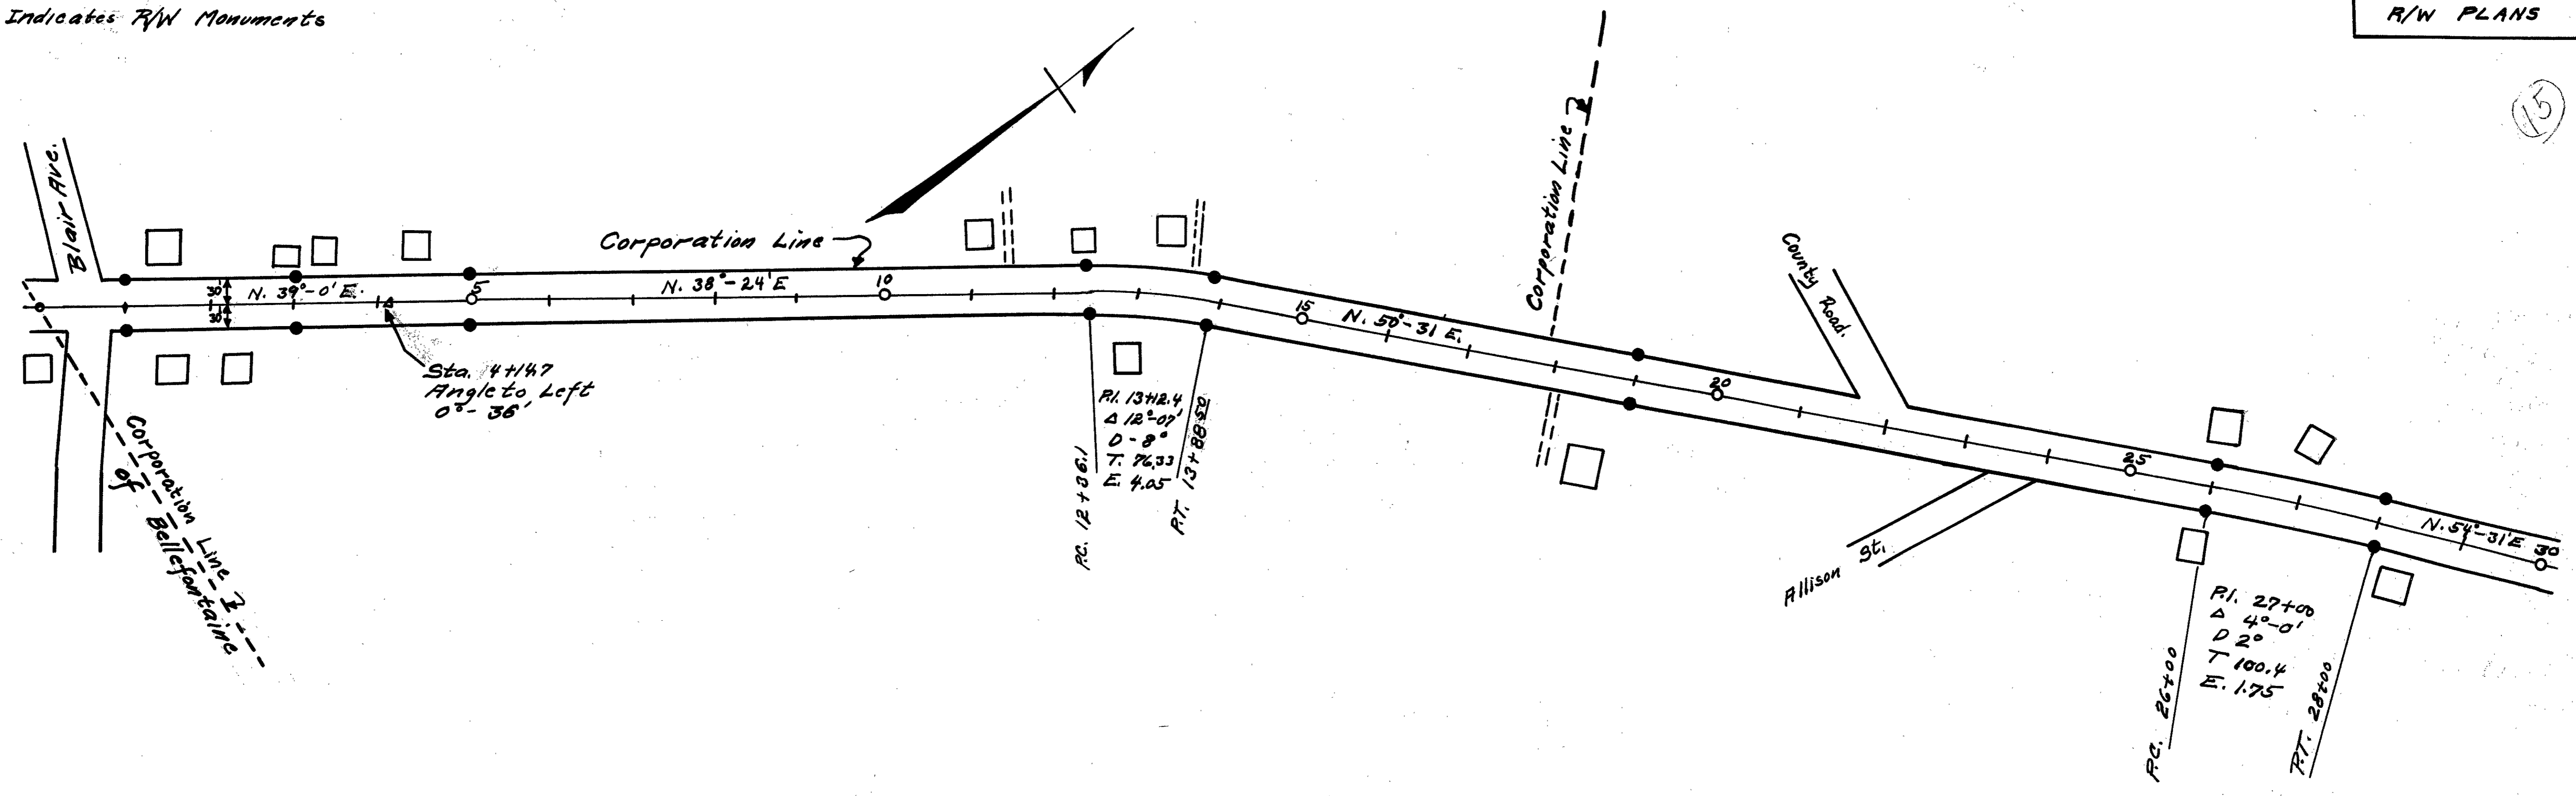

Field Notes in Logan  
County Surveyors Book  
No. 388  
Construction Plots L-5

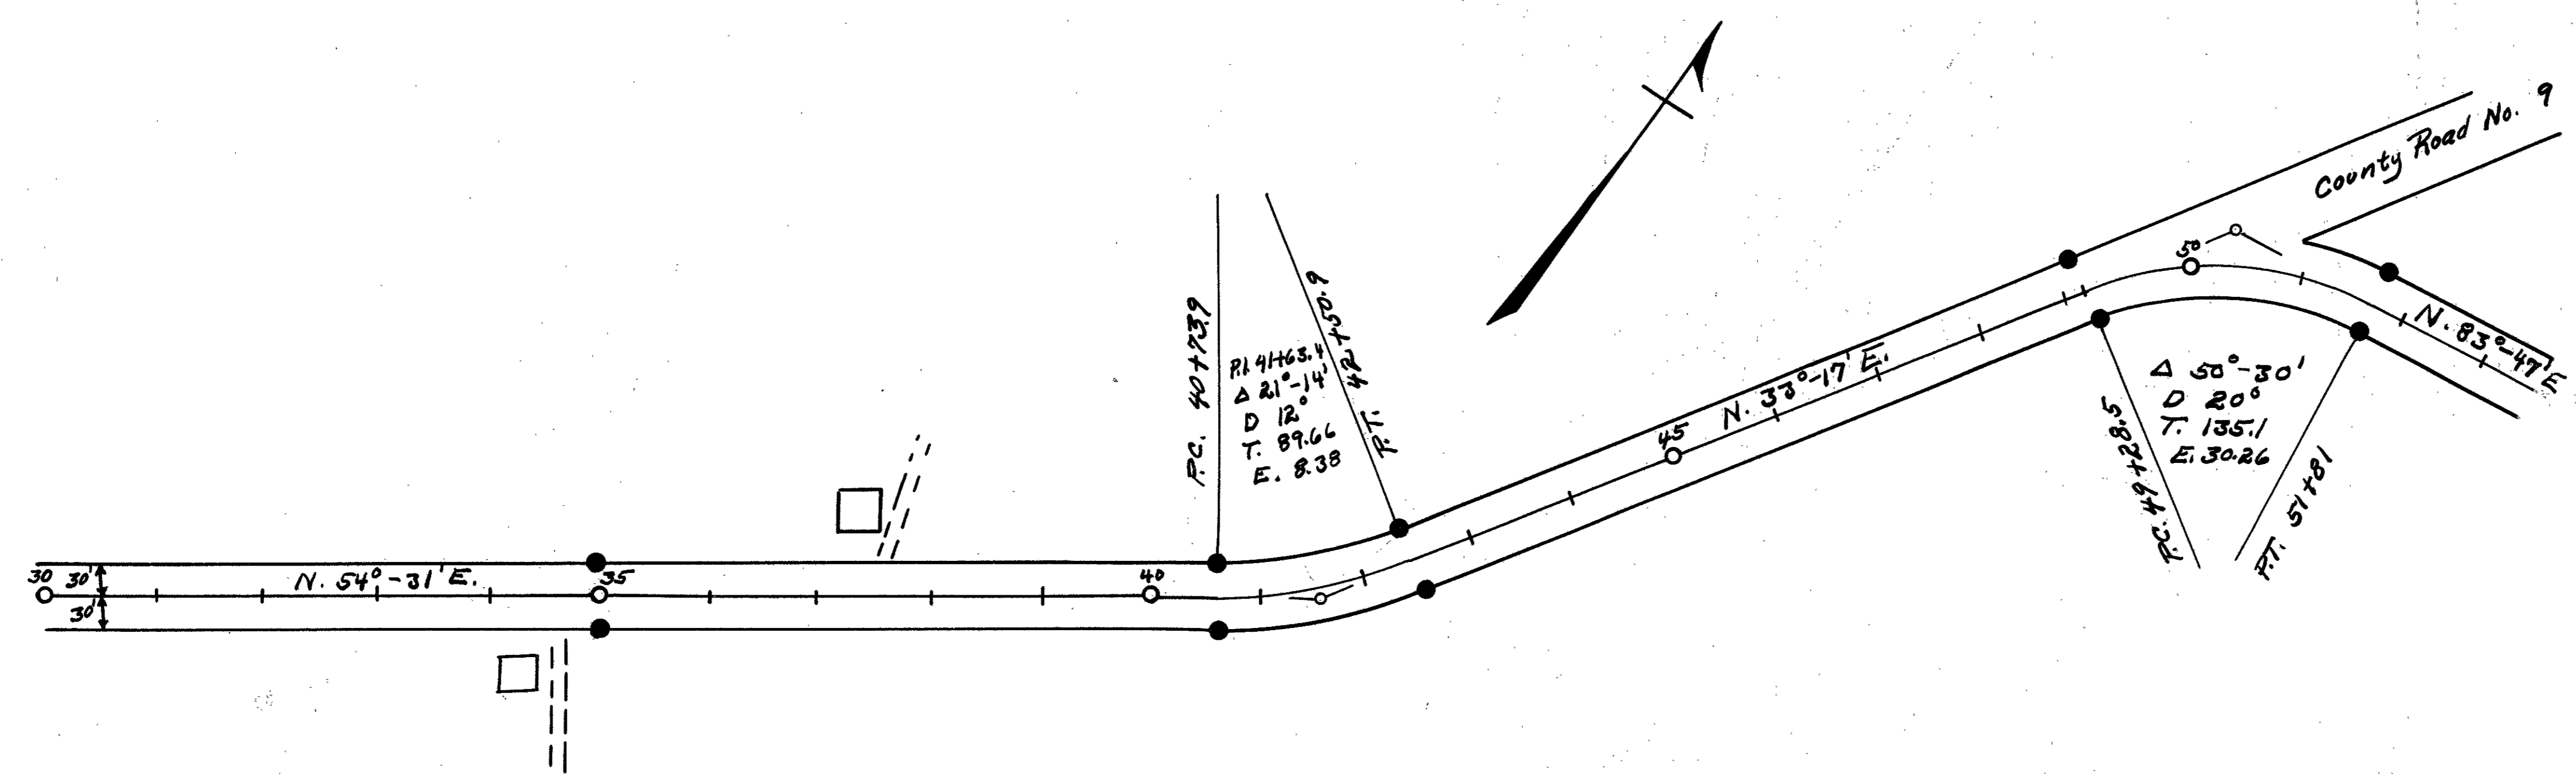

Note:-  
This is only Part of Sec. A.  
Remainder of Sec. A Not Monumented.  
April - 1931

L-22