
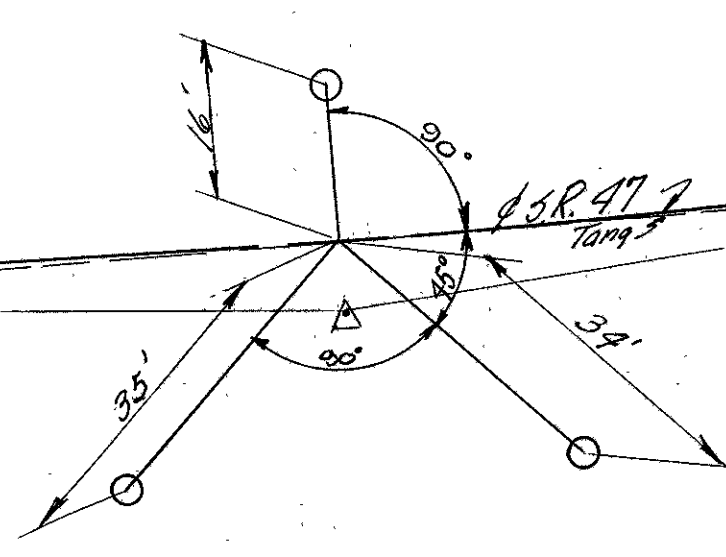


FED. RD. DIVISION	STATE	PROJECT	TYPE FUNDS
2	OHIO	S-1047(B) S-1047(E)	1 1

**LOGAN COUNTY
LOG. 47 (3.56) (7.83)
LOCATION PLAN**

Recorded State Highway Plat
Vol. 1 Page 4
11-26-51

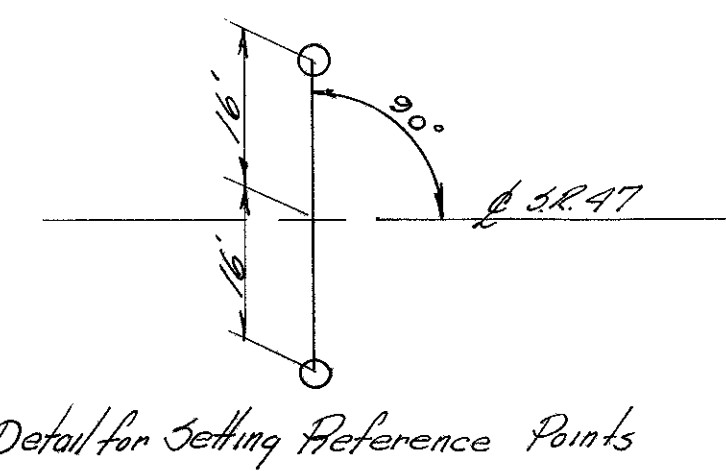

REFERENCE POINTS TO BE SET AFTER CONSTRUCTION

Station	Distance from &	
	Lt.	Rt.
185+00	16'	16'
189+03.27	16'	16'
191+59.65	See Special Detail	
194+16.04	16'	16'
197+94.00	16'	16'
199+94.80	16'	16'
201+94.80	16'	16'
205+00	16'	16'

Set as per plan 1953


Curve Data
 P.I. Sta. 191+60.07
 $\Delta = 9^{\circ}23'44''$
 $D_c = 3^{\circ}00'$
 $T_s = 256.0'$
 $E_s = 7.33'$
 $O_s = 3^{\circ}00'$
 $\Delta_c = 3^{\circ}23'$
 $L_c = 112.77'$
 $x_c = 199.95'$
 $y_c = 3.49'$
 $L_s = 200.0'$
 Mid Pt. Sta. 191+59.65

Curve Data
 P.I. Sta. 199+94.80
 $\Delta = 0^{\circ}24'44''$
 $D = 0^{\circ}06'$
 $L = 400'$
 $T = 200'$
 $E = 0.35'$
 Mid Pt. Sta. 199+94.80

**LOCATION PLAN
STATE ROUTE 47
LOG. 47(3.56) LOGAN COUNTY
PLEASANT TOWNSHIP**

1951
SCALE: 1"=100'

APPROVED 11-8-51
 DW [Signature] DIV. LOCATION & DESIGN ENGINEER
 REG. PROFESSIONAL ENGINEER NO. 1336

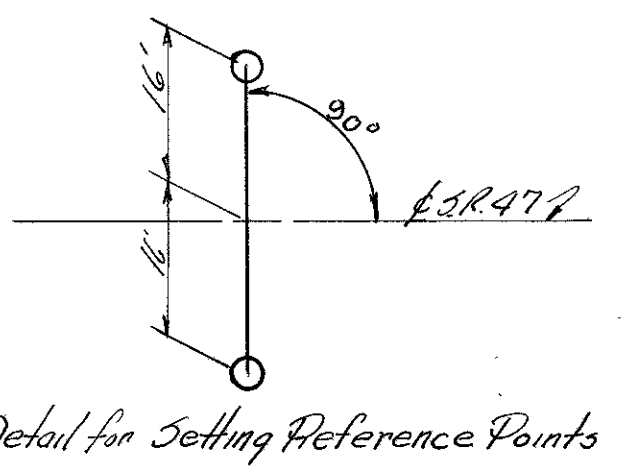

REFERENCE POINTS TO BE SET AFTER CONSTRUCTION

Station	Distance from &	
	Lt.	Rt.
415+00	16'	16' ✓
418+44.32	16'	16' ✓
424+42.01	16'	16' ✓
430+39.70	16'	16' ✓
435+00	16'	16' ✓
440+00	16'	16' ✓
41		

* Not set
Set as noted.

Curve Data
 P.I. Sta. 424+53.72
 $\Delta = 33^{\circ}48'54''$
 $D_c = 4^{\circ}00'$
 $L_s = 350.0'$
 $O_s = 7^{\circ}00'$
 $\Delta_c = 19^{\circ}48'54''$
 $L_c = 495.30'$
 $T_s = 611.40'$
 $p = 3.56'$
 $k = 174.91'$
 $x_c = 349.48'$
 $y_c = 14.24'$
 $L_T = 233.52'$
 $S.T. = 116.83'$
 $L_c = 349.71'$
 Mid Pt. Sta. 424+42.01

**LOCATION PLAN
STATE ROUTE 47
LOG. 47 (7.86) LOGAN COUNTY
HARRISON TOWNSHIP**


1951
SCALE: 1"=100'

APPROVED 11-8-51
 DW [Signature] DIV. LOCATION & DESIGN ENGINEER
 REG. PROFESSIONAL ENGINEER NO. 1336

FED. RD. DIVISION	STATE	PROJECT	TYPE FUNDS
	OHIO	S-1047(3)	

1
2


LOGAN COUNTY
LOG. 47 (7.56)(7.86)
R/W PLAN

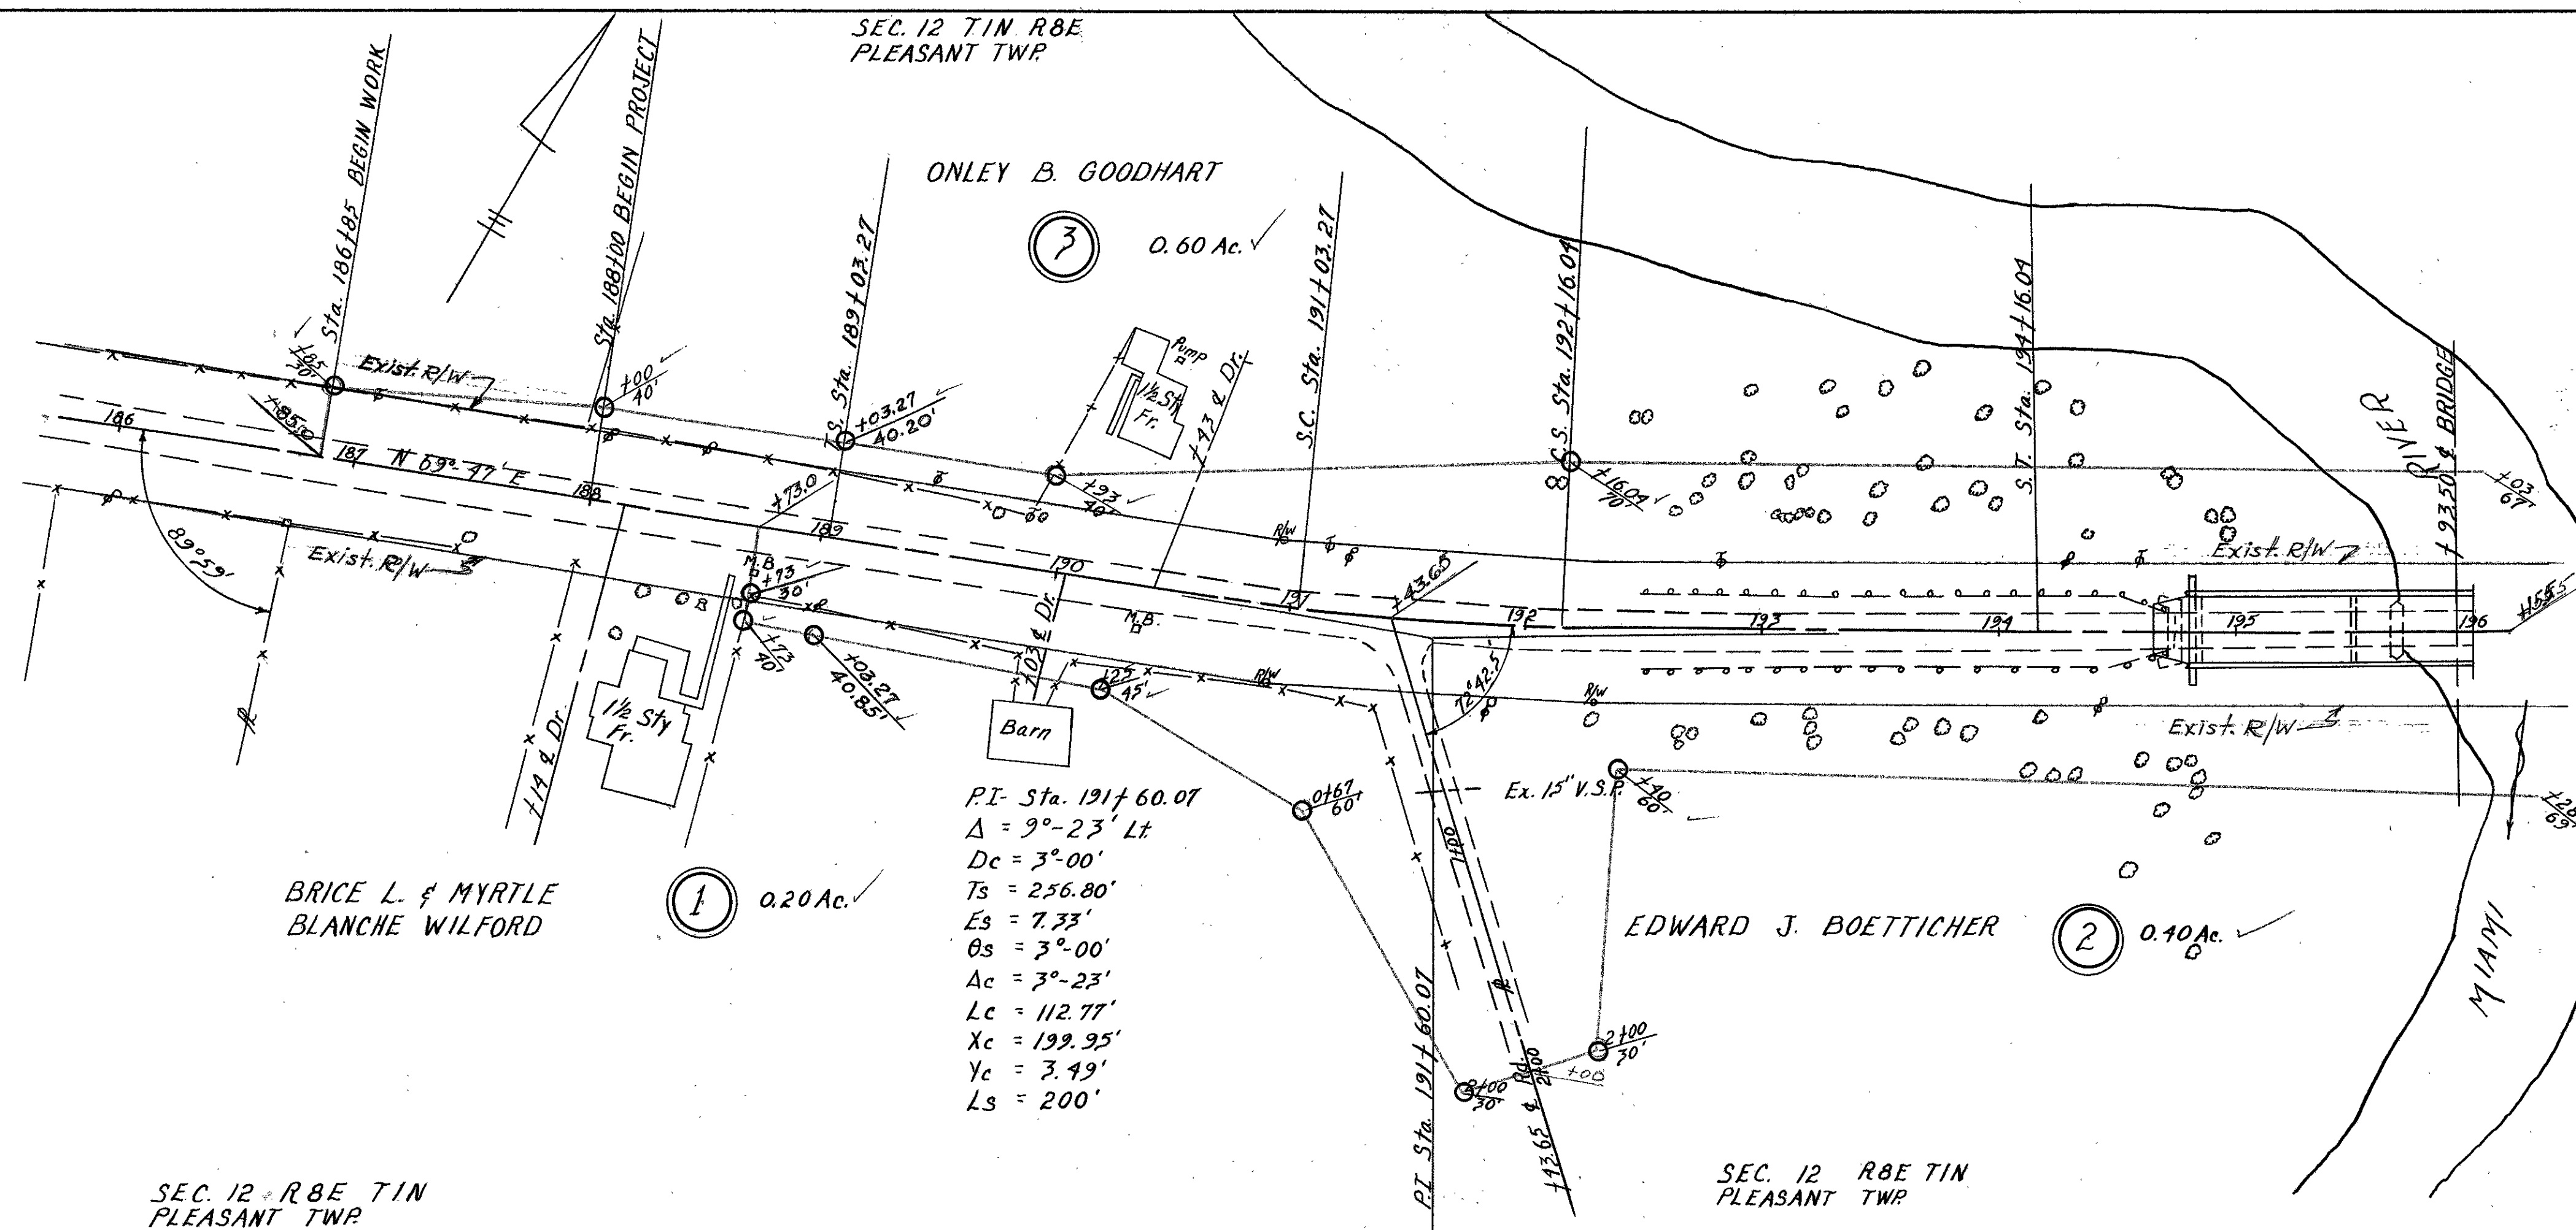

SEC. 12 R8E T1N
PLEASANT TWP

SEC. 12 R8E T1N
PLEASANT TWP

Scale 1"=50'

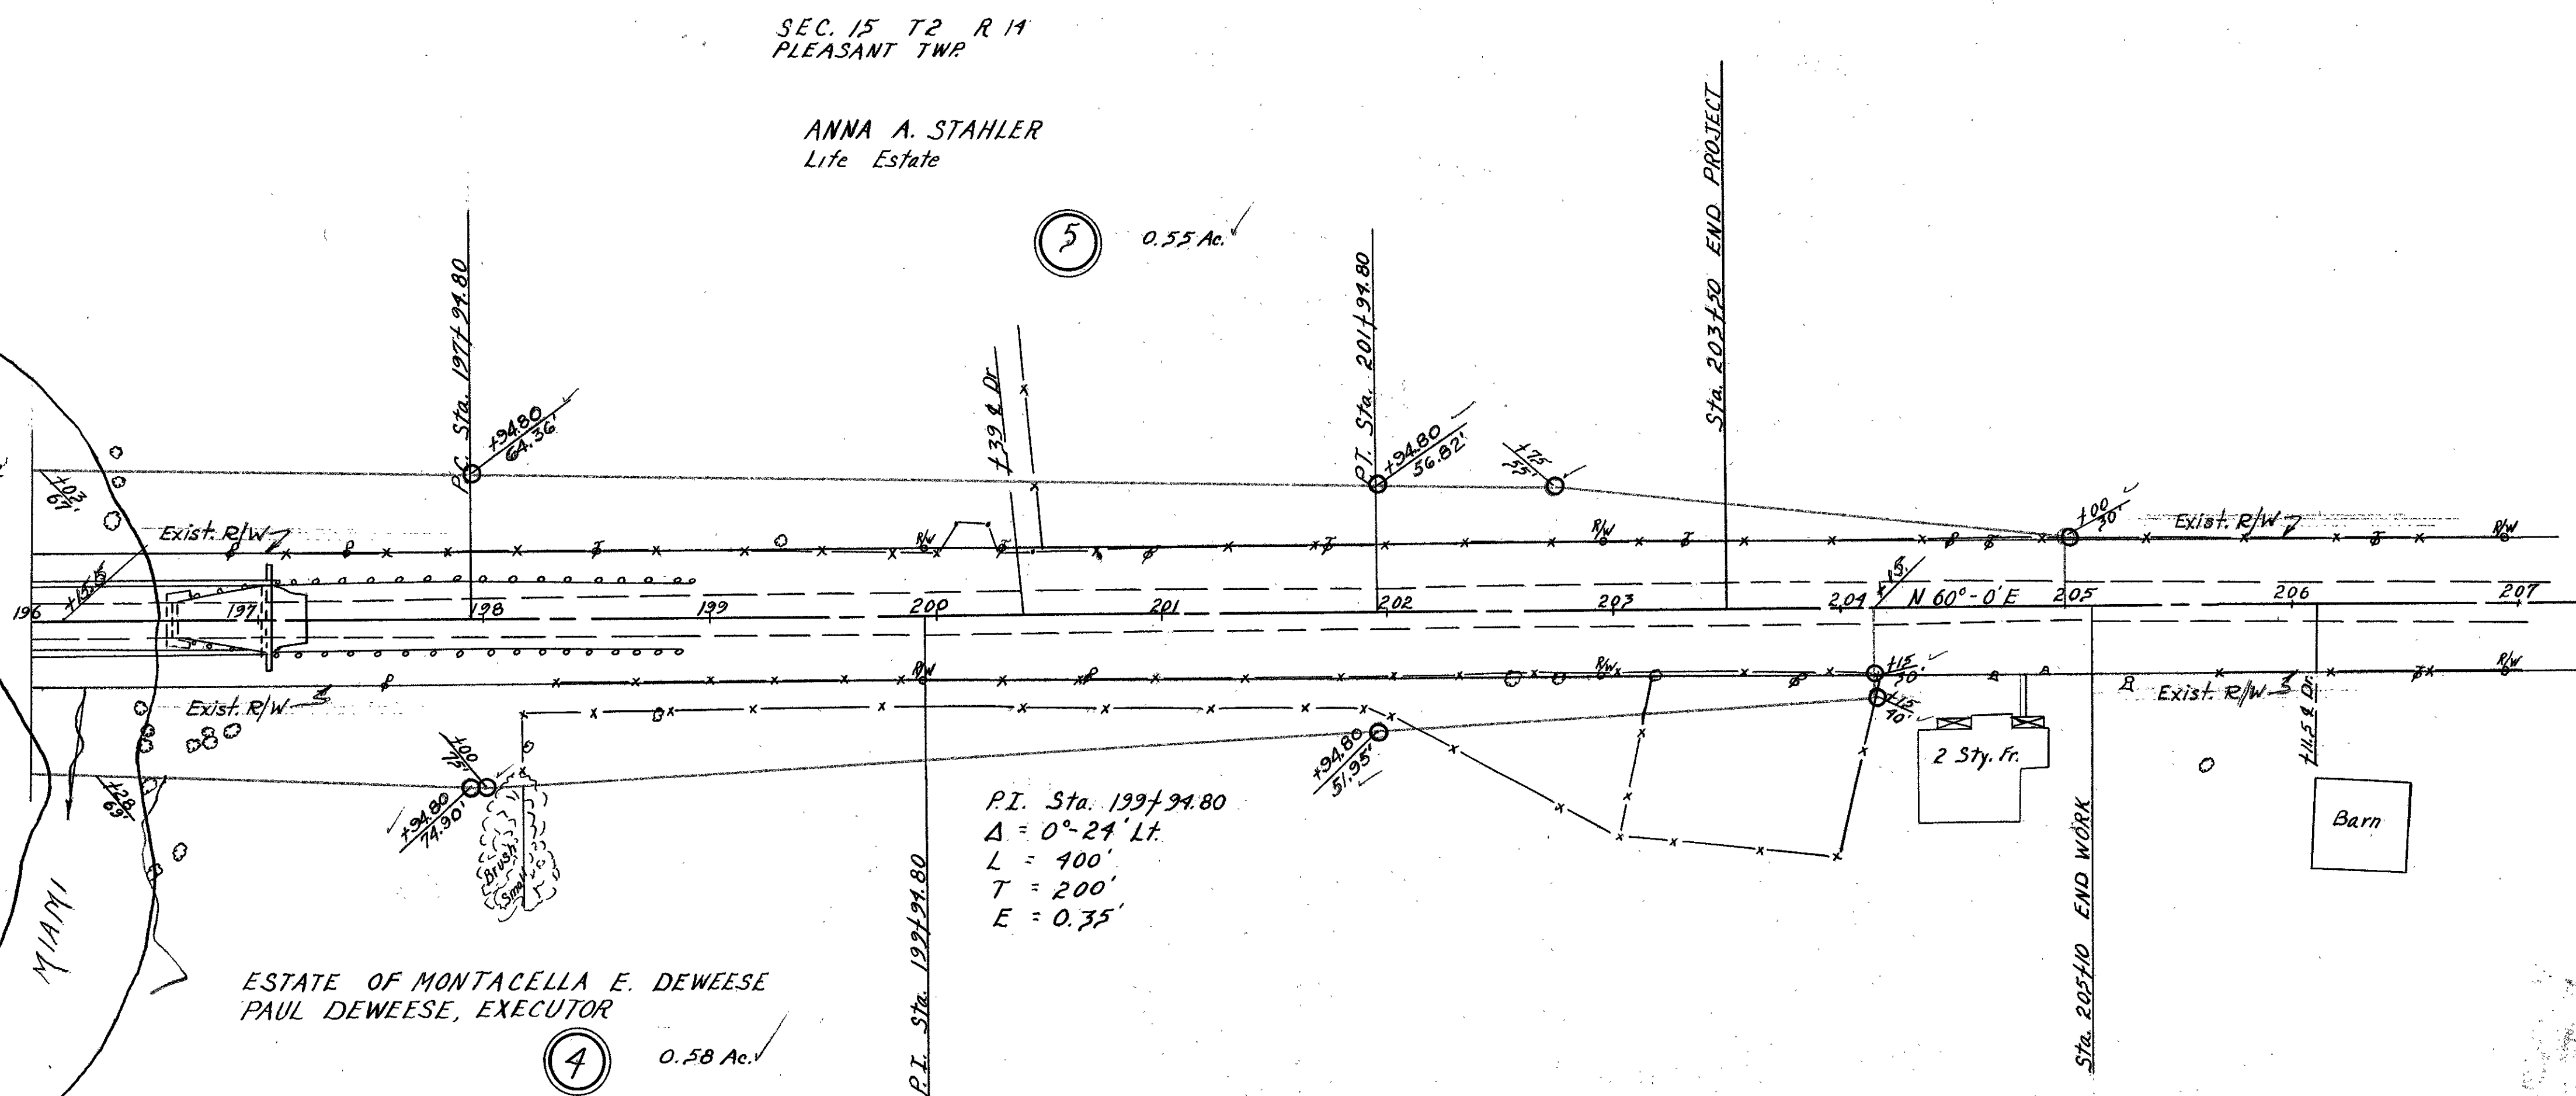

SEC. 15 T2 R14
PLEASANT TWP

SEC. 15 T2 R14
PLEASANT TWP

Scale 1"=50'

*Checked with Easement Description
Easement Report 2-17-53
JSS*

DATE	BY