

No. 9912	1000, acres

Surveyed for Nicholas Faltafello  
1000 acres of land on part of  
a Military Warrant No. 854  
on the waters of Bokes Creek  
Beginning at a sugar tree and  
two beeches south east corner of  
John Aldridge and others Survey  
No. 9911; thence N. 78° E 400 poles  
to three beeches Northeast corner  
of Luke Cannon and others sur-  
vey No. 9890; thence N. 12° W. 400  
poles to a buckeye, bur oak, ash  
and hornbeam on the bank of

Bokes Creek, Northwest corner of John Swan and others survey No  
9913; thence S. 78° W. 400 poles crossing a branch at 131 poles to  
thru beeches; thence S. 12° E 400 poles to the beginning.

Walter Jones

O. P. Hendrick D.S.

Peter Titus 366

October 2<sup>nd</sup> 1830

Jacob Fustermaker M.h.s.

October 29<sup>th</sup> 1830

~~Surveyed for Thomas Perkins and Littlebury Al-~~  
~~dridge also 100 acres of land on part of two Mil-~~  
~~itary Warrants, Perkins 50 acres on No. 6205 and 100 acres~~  
~~Aldridge 50 acres on No. 6206 on the waters of Ma-~~  
~~riar and Mill Creek: Beginning at two poplars and~~  
~~a hickory westerly corner to the representatives of Lewelling~~  
~~Jones Survey No. 4655 running S. 52° W. 180 poles to three ashes~~  
~~and a buckeye in the line of Thomas Thwaites Survey No. 4661~~  
~~thence with said Thwaites line and course thereof S. 75° E. 204~~  
~~poles passing his North easterly corner to three beeches in the~~  
~~line of William Agius Survey No. 4682; thence with said~~  
~~line N. 25° E. 39 poles to two beeches and a poplar corner to~~  
~~his survey; thence N. 52° 8 poles to a sugar tree, red oak and~~  
~~poplar, corner to said Agius Survey in the line of said Jones~~  
~~Survey; thence with his line N. 38° W. 150 poles crossing a branch~~  
~~to the beginning.~~

Edmund Marmon

James Galloway Jr. D.S.

David Marmon 366

November 7<sup>th</sup> 1817

William Townsley M.h.s.

May 22<sup>nd</sup> 1818

No. 9371412174

200 acres

Surveyed for Thomas Perkins, Littleberry Flanidge  
and Walter Dunn ab<sup>t</sup> 200 acres of land on part of  
thine Military Warrant; Perkins 80 acres on No.  
6205, Flanidge 50 acres on No. 6206 and Dunn  
100 acres on No. 6207 on the water of Head river  
and Hare creek. Beginning at three blue stones and  
a buckeye in the line of Thomas Throace Survey. No.

46661 southerly corner to Walter Dunn's survey. No. 10426; 10427 & 1041  
thence N. 52° E. 234 rods passing the southerly corner of said Perkins  
survey. No. 6205 at 38 rods crooking a branch at 48 poles to a hickory  
and two poplars easterly corner to said Survey and westerly corner to the  
representatives of Ewing Jones Survey. No. 4655; thence with Jones  
line S. 38° E. 194 rods crooking Otter Creek at 137 poles to a sugar tree  
red oak and poplar in said line most northerly corner to William Agins  
Survey. No. 4682; thence with Agins line S. 62° W. 8 poles to two beeches  
and a poplar corner to said Survey; thence with another of his lines S.  
25 W. 66 poles to three in said line; thence N. 73° W. 280 poles passing  
the northeasterly corner of Throate said Survey and with his line crook-  
ing a branch to the beginning.

John Lingard  $\frac{3}{3}$   
Joshua Hammon  $\frac{3}{3}$  C. C.  
Aaron Hunt M. M. C.

Walter Dunn D. S.  
January 23<sup>rd</sup> 1823  
May 28<sup>th</sup> 1823

Surveyed for the Representatives of Holland Madison 400  
acres of land on part of a Military Warrant No. 5789 on  
the water of Rush Creek. Beginning at a buckeye, bur  
oak, ash and hornbeam south east corner to Morrow  
and Taylor's Survey No. 9937 and North east corner to  
Nicholas Galiaferro's Survey No. 9912; thence with  
the north line of Survey No. 9913 N. 79° E. 160 poles to a  
stake, thence N. 12° W. 400 poles to a stake, thence  
S. 78° W. 160 poles crooking the outlet of a large Beaver  
dam at 60 poles to a buckeye, lynn and two crooked  
woods North east corner to Morrow and Taylor's  
said Survey; thence with their line S. 12° E. 400 poles  
to the beginning.

Levi D. Fairp  $\frac{3}{3}$   
Nikiah Rosebrag  $\frac{3}{3}$  C. C.  
Wilson Thompson M. M. C.

No. 9938

400 acres

Samuel Torre D. S.  
January 21<sup>st</sup> 1820  
December 7<sup>th</sup> 1820

No. 9938

600, acres

Surveyed for the representatives of Howland Marion  
on 600 acres of land on part of a Military  
Warrant No. 578; on Rush Creek: Beginning  
at a buckeye and two ashes on the west side  
of a small pond northeast corner to Blood  
and others Survey No. 9913 and north west  
corner to Daniel Taylor's Survey No. 9914; thence  
S. 12 W. 400 poles cropping Rush creek  
at 298 poles to a sugar tree and two beeches  
thence S. 78 W. 240 poles cropping the creek  
at 111 poles to a stake northeast corner  
to said Maddox Survey No. 9938 for 400  
acres; thence with a line S. 12 E. 400 poles  
to a stake in a line of said Survey No. 9913; thence with said  
line S. 78 E. 240 poles to the beginning.

Levi D. Harp  
Hilkah Rosebag 3 C. C.  
Nel'm L. Thompson M. C.

Samuel Force O. S.  
January 21<sup>st</sup> 1820  
December 7<sup>th</sup> 1820

Surveyed for Daniel Taylor  
of 983 acres of land on part  
a Military warrant No. 5440  
on the waters of Rush Creek  
and Bokes Creek; beginning at  
an ash, cherry tree and box elder  
south east corner to Swan and others  
Survey No. 9913 and North west  
corner to Daniel Taylor's Survey No.  
9892; thence with a line of said  
Survey S. 78 E. 400 poles crossing  
Bokes Creek to a beech and two  
sugar trees northeast corner to  
said Survey No. 9892; thence N. 12 W. 383 poles to a sugar tree and  
two beeches; thence S. 78 W. 400 poles cropping a branch of Rush Creek  
at 200 and one at 300 poles to a buckeye and two ashes on the west bank  
of a small pond northeast corner to survey No. 9913; thence S. 12 E. 383 poles  
cropping Bokes Creek at 299 poles to the beginning.

Levi D. Harp  
Hilkah Rosebag 3 C. C.  
Nel'm L. Thompson M. C.

Samuel Force O. S.  
January 18<sup>th</sup> 1820  
March 9<sup>th</sup> 1820


Survey for Walter Dun 135 acres of land  
on part of three Military Warrants, 50 acres on No  
6240, 14 acres on No. 6241 and 71 acres on No. 6098  
on the waters of Mad River: Beginning at a stake and  
three large white oaks westerly corner to said Dun's Survey  
No. 9692, 9618 & 10075; thence with the line of Anthony Singletary's  
Survey No 4943, S. 24 W. 164 poles crossing a large branch at 162  
poles to a stake, two small burr oak and a black oak westerly corner to  
Singletary's said Survey in the line of Samuel Finley's Survey No. 4493 and  
4525; thence with said line S. 70 W. 97 poles to two hickories and a white oak  
corner to Finley's said Survey; thence another of his lines S. 20 E. 82 poles  
to a white oak and black oak corner to said Survey; thence with another  
of his lines S. 70 W. 75 poles to a stake in said line easterly corner to  
said Dun's Survey No. 9793; thence with Dun's line N. 20 W. 162 poles  
to a black oak Dun's northeasterly corner in the south line of Thomas  
Mc Bayly's Survey No. 5864; thence with said line East 103 poles to three  
black oaks southeasterly corner to said Survey; thence with another of  
his lines North 48 poles to three white oaks in said line southerly cor-  
ner to said Dun's Survey No. 8303 and 8485; thence with the line of said  
Survey N. 60 E. 174 poles crossing the branch at 57 poles to the beginning.  
Nathaniel Pope  
Richard Shockley 3 106  
Aaron L. Hunt Mkr.

Walter Dun Q.S.

November 19. 1821

January 29. 1822

Surveyed for Abraham J. Williams abt 278 acres  
of land on part of a Military Warrant No. 5749 on  
Cherokee-mans run a branch of the big Holami:  
Beginning at two red oaks and a large white  
oak southwesterly corner to Mark Hardin's survey  
No 9883 in the Granville Treaty line; thence  
with said line S. 78 W. 256 poles to three white oaks in a swamp, thence  
N. 12. W. 174 poles crossing the spring fork at 64 poles, crossing a spring  
and bend of the middle fork at 134 poles and the fork at 164 poles  
to a large bur oak and buckeye; thence N. 78 E. 256 poles crossing  
the middle fork at 3 poles to a white oak and two sugar trees in Har-  
din's line; thence with said line S. 12 E. 174 poles crossing a drain  
at 110 poles to the beginning.

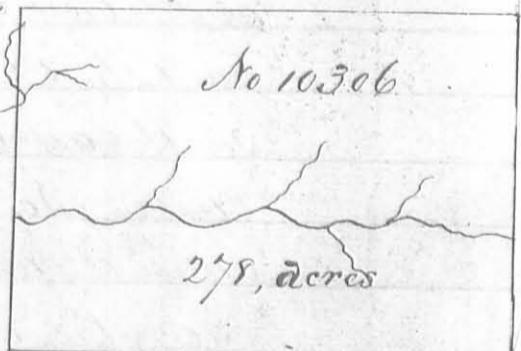

George Henry 3  
James Henry 3 C. G.  
Noah Devault Mkr.

Thomas J. McArthur Q.S.  
January 9. 1821  
March 26. 1821

Surveyed for Robert Means and Duncan McArthur  
opposite 678 acres of land on part of five Military Warrants  
Means 600 acres; 400 acres on No. 5367, 200 acres on  
No. 5231 and McArthur 78 acres on No. 5070. 13  
acres on No. 5551 and five acres on No. 5104 on Sciota river: Beginning at a large honey locust tree  
corner on the river of said Means entry No. 678, acres  
10019 made the 20<sup>th</sup> March 1820; thence  
down the river with the meanders thereof  
and binding thereon N. 50° W. 34. N. 13° E. 50  
N. 47° W. 18. S. 70° W. 10. S. 44° W. 24. N. 20° W. 34. N. 17  
E. 28. N. 60° E. 66. A. 28. E. 26. N. 40° W. 52. A. 18° E. 32  
A. 45° W. 30. A. 10° E. 22. A. 34° E. 24. A. 11° W. 54  
A. 8° E. 6 poles to a stake in a prairie; thence  
S. 78° E. 190 poles crossing a branch at 42 and  
out at 181 poles to three beeches two of them  
down, thence S. 12° E. 392 poles crossing a small branch at 12 one  
at 226 and a large branch at 250 poles to a red oak sugar tree  
black walnut and small blue ash; thence S. 78° W. 17 poles to a  
stake; thence S. 12° E. 134 poles to a stake in the north line of the  
representatives of John Green's entry No. 10010; thence with said  
line S. 78° W. 240 poles to a lynn and reach at the Northwest cor-  
ner of said entry; thence N. 12° W. 125 poles to a forked honey lo-  
cust on the bank of the river; thence N. 23° E. 13 poles crossing  
a bend of the river to the beginning.

David Colvin  $\frac{3}{4}$

James Henry  $\frac{3}{4}$  C.C.

Peter McArthur M.k.r.

Thomas J. McArthur D.S.

January 26<sup>th</sup> 1821

March 29. 1821

No. 10951

100 acres

Surveyed for Walter Dun after 100 acres of land on a  
Military warrant No. 6482 on the waters of Big Miami  
beginning at two hickories and a large white --  
in Robert's line Southwesterly corner to the said Dun's  
survey No. 9925. 9946 & 10121; thence with said line S. 24° 30' E. 80 poles  
to two red oaks, a small bur oak and small hickory in said line  
thence N. 78° E. 211 poles to a bur oak, hickory, ash and small  
red elm; thence N. 18° W. 78 poles to a hickory, red oak and cherry  
tree Southeast corner to said Dun's said survey; thence with his line  
S. 78° W. 227 poles to the beginning.

William Staffield  $\frac{3}{4}$


Samuel Fingo  $\frac{3}{4}$  C.C.

Joel Smith M.k.r.

Thomas J. McArthur D.S.

October 25<sup>th</sup> 1822.

February 25<sup>th</sup> 1823.

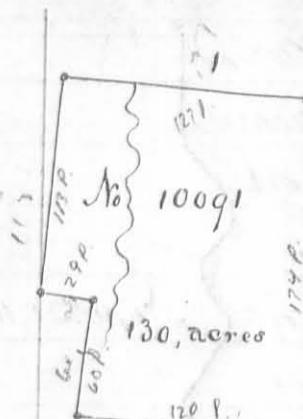

Surveyed for Cadwallader Wallace ap<sup>e</sup> 130 acres of land on part of a Military Warrant No. 5872 on the waters of Moad River. Beginning at three hickories southeasterly corner to Walter Dun's survey No. 9878 in the line of Holland Haneys survey No. 3224; thence with Haneys line S. 24° E. 174 poles to two white oaks in said line corner to James Galloway's survey No. 6487; thence with his line S. 70° W. 120 poles to two white oaks northeasterly corner to Galloway's said Survey in the line of Thomas Worthington's Survey No. 4479; thence with his line N. 20° W. 60 poles crossing a branch to two white oaks an Elm and Hickory, northeasterly corner to Worthington's said Survey; thence with his line S. 70° W. 29 poles to a stake; thence N. 21° W. 113 poles to a black oak southwesterly corner to Dun's said Survey; thence with his line N. 69° E. 157 poles crossing the branch to the beginning.

Henry A. Hancee 3

Israel Hancee 3 6.6

Matthew Bowmer M.h.r.

Walter Dun D.S.  
January 15. 1820  
March 14. 1820

Surveyed for Joseph and Benjamin W. Ladd and Thomas Hancee ap<sup>e</sup> 88 acres of land on part of a Military Warrant No. 5870 on the waters of Stony Creek. Beginning at a black walnut and two dogwoods southeast corner to Alexander S. Daundge Survey No. 4478; thence with his line North 160 poles crossing a branch at 78 poles to a sugar tree and lim in the line of said Survey; thence S. 80° W. 119 poles crossing a branch to a stake in Ladd's line; thence with said line S. 20° E. 148 poles to two black oaks corner to Cadwallader Wallace Survey No. 9478; thence East with his line 69 poles to the beginning.

Martin Drift 3

Jacob Foster 3 6.6

Matthew Bowmer M.h.r.



Walter Dun D.S.  
February 1<sup>o</sup> 1820  
March 14<sup>o</sup> 1820

Surveyed for Walter Dun and  
William Bayles off  $109\frac{1}{3}$  acres  
of land on part of Nine Mileary  
Warrant; Dun 827 acres, 300  
acres on No. 5870, 124 acres on  
No. 6218, 90 acres on No. 6202, 132  
acres on No. 6217, 19 acres on No. 6124  
81 acres on No. 6126, 50 acres on No. 61  
47, 110 acres on No. 5749 and Bayles  
 $26\frac{2}{3}$  acres on No. 3167 on the waters  
of Big Miami; beginning at three  
white oaks, one post at the southeast  
corner of the Shawnee Reserve at Seven Mile  
where Roberts line crosses the Greenville Treaty line; thence with said line  
N. 78. E. 400 poles crossing a small branch at 146 poles to two red oaks and  
two white oaks; thence N. 12 W. 400 poles crossing a prairie from 240 to 370  
poles to a branch in the prairie at 350 poles to a bur oak and small elm;  
thence S. 78. W. 488 poles to two white oaks and a hickory in Roberts line; thence  
with said line S. 24. E. 407 poles crossing two branches to the beginning.

George Henry  $\frac{3}{4}$

James Henry  $\frac{3}{4}$  C. C.

Benjamin McCulloch M. K. S.

No. 10122, 10248, and 10249

$109\frac{1}{3}$ , acres

Thomas J. McArthur Q. S.

January 8<sup>th</sup> 1821

March 27<sup>th</sup> 1821

Surveyed for David Stephenson 166 acres of land on part of a  
Molday warrant No. 347 on the water of Big Miami; No. 10434  
beginning at an ash in a swamp southwest corner to  
Nathan Reeves survey No. 9927 in the line of the Rep.  
successors of Michael Rudolph's survey No. 9924  
thence with their line S. 78 W. 194 poles to two ashes and two hickories north  
west corner to their said survey; and south east corner to Isaac Gard  
ner's survey No. 12052; thence N. 78 W. 89 poles to a bur oak, hickory  
ash and small red elm north east corner to Gardner's said survey  
thence N. 49 E. 219 poles to a small black walnut in the line of  
Reeves said survey; thence with said line S. 12 E. 190 poles  
to the beginning.

George Henry  $\frac{3}{4}$

James Henry  $\frac{3}{4}$  C. C.

Joe Smith M. K. S.


166, acres

194

Thos J. McArthur Q. S.

December 25<sup>th</sup> 1822

July 7<sup>th</sup> 1823

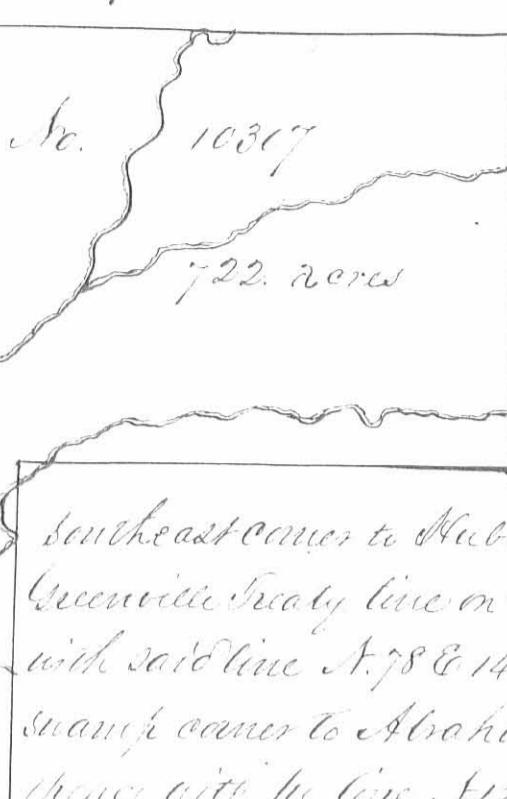

Surveyed for Duncan McArthur  
wife and Joseph Hale 722 acres of  
land on part of their Military War-  
rant, McArthur 558 acres, Hale 163 a-  
cres on No. 5308, 163 acres on No. 5557  
and Hale 164 acres in No. 5805 on  
Cherokee maw run: Beginning at

two white oaks and a black oak

southeast corner to Hubbard Myatt's survey No. 9881 in the  
Greenville Treaty line on the west side of Hull's road, thence  
with said line N. 78° E. 144 poles to three white oaks in a  
swamp corner to Abraham Williams Survey No. 10306  
thence with his line S. 12° W. 174 poles crossing the Spring  
fork at 64, a spring and bend of the middle fork of Cherokee maw run at  
34 and at 164 poles to a large black and buckeye northwest corner to  
Williams said survey, thence with another line S. 78° E. 236 poles  
crossing the said fork at 3 poles to a white oak and two sugar trees north  
east corner to said survey in the line of Clark Hardin Survey No. 9983  
thence with said line S. 12° W. 226 poles crossing the fork at 30 and a  
branch at 188 poles to six beeches, thence S. 78° W. 400 poles crossing the  
North fork of Cherokee maw run at 156 or 162 and at 170 poles crossing  
Hull's road at 276 poles to three hickories northeast corner to Myatt's  
said survey; thence with his line S. 12° E. 400 poles crossing a small branch  
at 48 and Cherokee maw run at 326 poles to the beginning.

George Henry 3

Thomas J. McArthur Q.S.


James Henry 3 00

January 9<sup>th</sup> 1821

Noah Dealt Mkr.

March 29<sup>th</sup> 1821

Surveyed for Isaac Gardner apx 100 acres of land on  
part of a Military warrant No. 6476 on the waters of the Big Miami; beginning at two ashes and two hickories North  
west corner to the representatives of Michael Rudolph's survey No. 9902,  
thence N. 7W. 85 poles to a bur oak, hickory, small ash and mashed  
elm southeast corner to Walter Sun's survey No. 10951 thence with his line  
S. 78° W. 211 poles to two red oaks a small bur oak and a small hickory  
in Robert's line southwest corner to Lewis' No. 6 Survey; thence with Robert's  
line S. 24° 30' E. 88 poles to a white oak and ash in said line; thence N. 78° E.  
181 poles to the beginning.

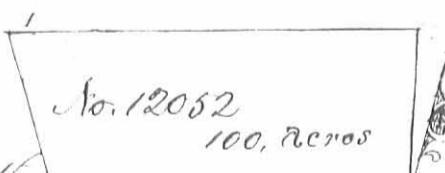

Samuel Trigo 3


Thomas J. McArthur Q.S.

William Stanfield 3 00.

December 16<sup>th</sup> 1822

Jacob Smith Mkr.

February 21<sup>st</sup> 1823

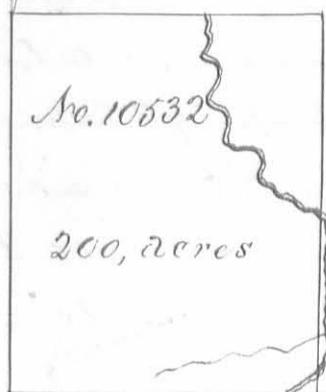

Surveyed for John Slaughter and John Jones 200 acres of land on two military warrants; Slaughter 100 acres on No 8305 and Jones 100 acres on No 5353 on the south fork of Nea Cat, beginning at a white and two lynes a southerly corner to Philip Stewart survey No 9957; thence with his line N. 78° E 160 poles crooping a drain at 3 and the fork at 98 poles to three beeches in said line; thence S 12° E 200 poles crooping the fork at 118 a small branch at 174 and the fork at 188 poles to a fork'd white oak and two hickories saplings; thence S. 78.W 160 poles crooping the fork at 14 poles to a red oak and lynn; thence N. 12.W 200 poles passing a southerly corner of Stewart said survey at 75 poles and with his line to the beginning.

Hiram Perkins

Samuel Force D. S.


Theodore McDowell 3 C.G.

June 8<sup>th</sup> 1822

Alonzo Chapman Mkr.

July 20<sup>th</sup> 1822

Surveyed for Duncan McArthur, Robert Means Jr., Joseph Hite, Abraham Bowman, George Handy and George Ryan 887 1/3 acres of land on part of nine military warrants McArthur 290 acres, 260 on No 581, 30 acres on No. 1451; Means 297 1/3 acres, 207 1/3 acres on No. 5344, 75 acres on No 5769, 15 acres on No 5470; Hite 106 acres on No 5809; Bowman 96 acres on No 5869; Handy 68 acres on No 5536 and Ryan 30 acres on No. 607 on Rush Creek; beginning at two sugar tree and a large white elm, southeas-

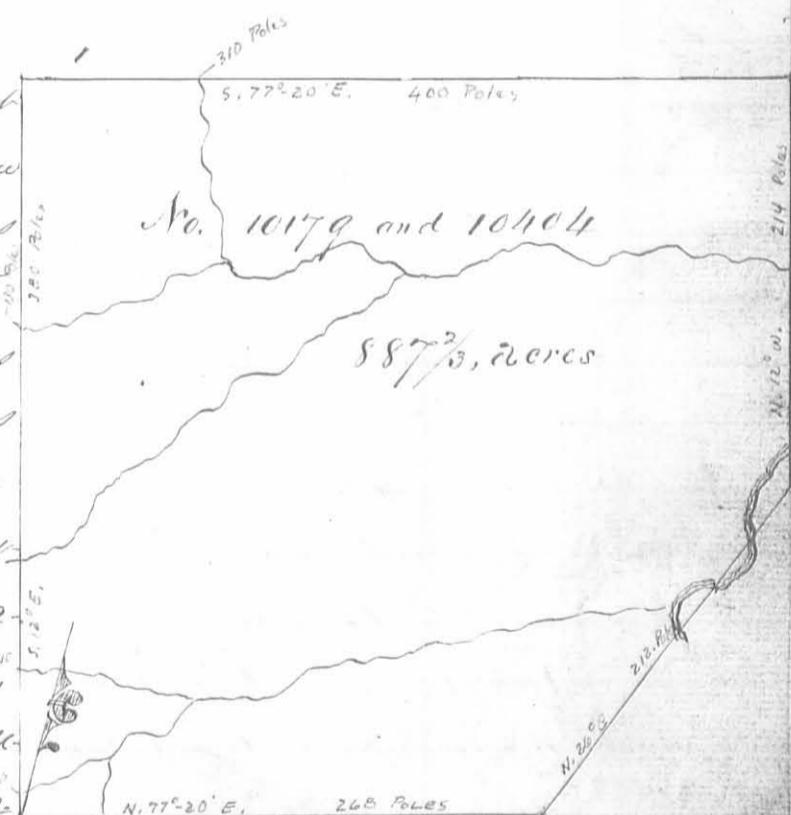

terly corner to Walter Davis survey No. 9885 in the Greenville Treaty line; thence with said line N. 77° 20' E. 268 poles crooping a fork'd spring and several small branches to two elms east of Sutherland's fence; thence N. 26.E. 212 poles crooping Rush Creek three times to a stake in the westline of Jamison and others survey No. 9887; thence N. 12.W 214 poles crooping the creek and a large branch to a blue ash beech and sugar tree; thence S. 77° 20' W. 400 poles crooping a drain at 310 poles to three live oaks and a beech on the north side of a swamp; thence S. 12.E. 380 poles crooping a branch at 130 one at 310 and a drain at 365 poles to the beginning.

George McCulloch 3


Thomas P. McArthur D. S.

George Henry 3 C.G.

January 1<sup>st</sup> 1821

Simon Hager Mkr.

March 28<sup>th</sup> 1821

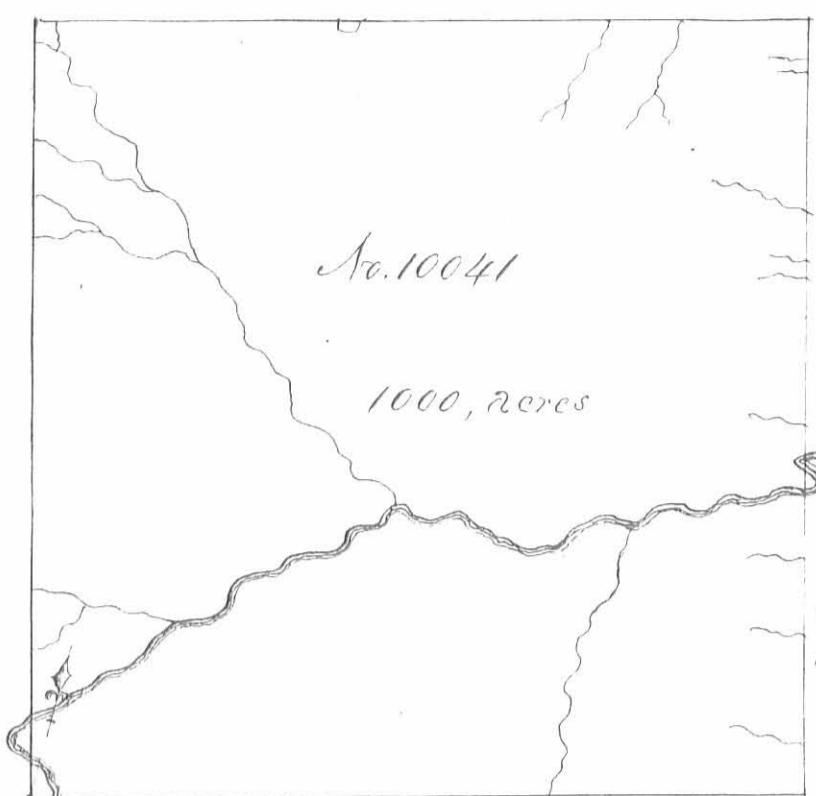

Surveyed for Richard Steeman  
1000 acres of land on two Military  
warrants No. 4962 and 4963 on  
Rush Creek; beginning at a small  
blackeye, small sugar tree and white  
walnut on the east bank of the Creek  
southeast corner to the present ar-  
ticle of Land Wallace and others  
entry No. 9934, thence N. 12 E 400  
poles crooking the Creek at 30 and  
at 34 poles and several small branches  
to three beeches; thence S. 78 E 400  
poles crooking a small branch at  
30 or 300 and the Sandusky road at 372 poles to three beeches; thence  
S. 12 E. 400 poles crooking several drains and Rush Creek from 230 to  
250, 106, and a branch at 378 poles to three beeches; thence S. 78 W  
400 poles crooking a branch at 104, 106 the road at 290, the Creek  
at 504 poles to the beginning.

George H. Colcock

George Henry

Simon Hager M.R.

Surveyed for Richard Steeman  
1000 acres of land on two Military  
warrants No. 4962 and 4963 on  
Rush Creek; beginning at a small  
blackeye, small sugar tree and white  
walnut on the east bank of the Creek  
southeast corner to the present ar-  
ticle of Land Wallace and others  
entry No. 9934, thence N. 12 E 400  
poles crooking the Creek at 30 and  
at 34 poles and several small branches  
to three beeches; thence S. 78 E 400  
poles crooking a small branch at  
30 or 300 and the Sandusky road at 372 poles to three beeches; thence  
S. 12 E. 400 poles crooking several drains and Rush Creek from 230 to  
250, 106, and a branch at 378 poles to three beeches; thence S. 78 W  
400 poles crooking a branch at 104, 106 the road at 290, the Creek  
at 504 poles to the beginning.

Thomas J. McArthur Q.S.

January 25<sup>th</sup> 1821

March 28<sup>th</sup> 1821


Surveyed for James Taylor and  
William S. Pierce 888 $\frac{1}{3}$  acres on the follow-  
ing Military warrants; Taylor 535 $\frac{1}{3}$  acres  
on No. 5465 and Pierce 55 $\frac{1}{3}$  acres on No.  
5888 on Rush Creek; Beginning at a  
blackeye and two ashes on the side of  
a sand North west corner to James  
Taylor's Survey No. 9914; thence with  
said line S. 78 E 350 poles crooking a  
branch at 200 poles to a hickory and  
two beeches; thence S. 12 W 400 poles  
crooking said branch at 140 poles to an  
ash and two hickories in the line of

Alexander Parker's Survey No. 9958, thence with said line S. 78 N. 300 poles crook-  
ing the Creek at 70, at 88 and at 90 poles to a maple and two beeches Northeast corner to Row-  
land Wallace's Survey No. 9938, thence with said line S. 12 E 400 poles crooking the Creek  
at 102 poles to the beginning.

Sam'l Stark

Nicolaus Rodding

Wilson Thompson M.R.

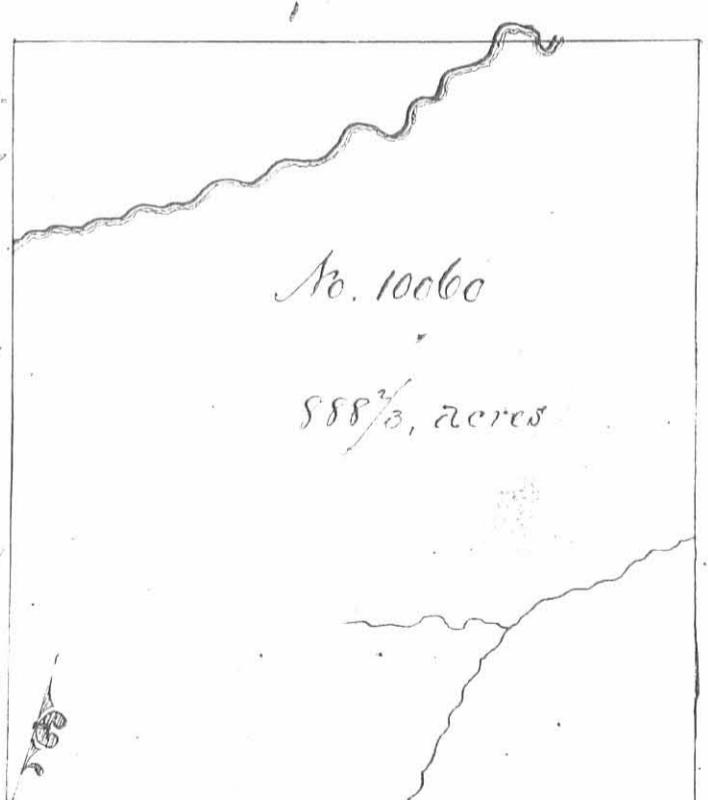

Sam'l Foster Q.S.

January 22, 1820

July 24, 1820