


Bellecenter Cremery.


607

INDEXED ON MAP

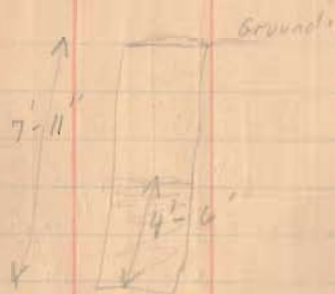

June 17-1926

Clear

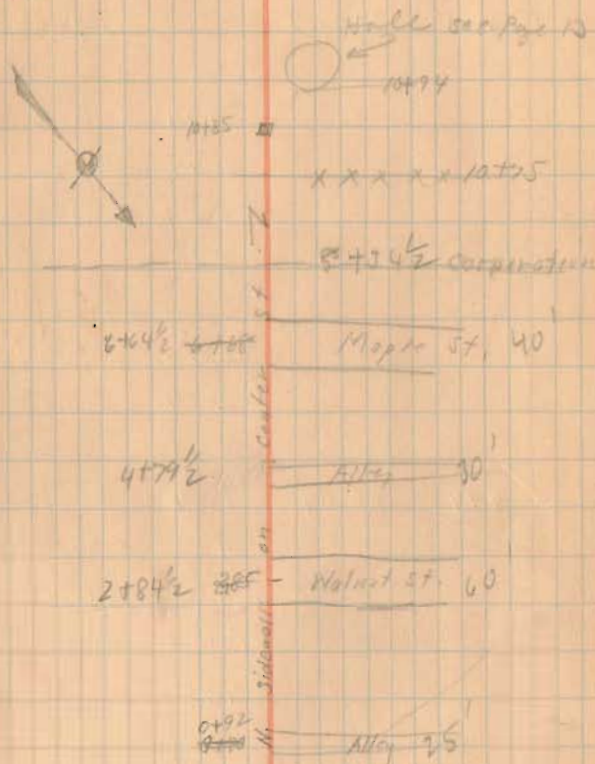

Bellecenter Cremery

	TS.	H.L.	-S.	Elev	Flow Line	Cont.
0.00	5.45	1030.07		1044.62		
			4.94	45.10		
			8.75	41.02		
				40.90		
0+00			5.21	49.86	1040.90	3.76
0+11 (Sidewalk)			5.82	44.25	40.87	3.38
1+00			6.05	44.02	40.65	3.37
			6.70	43.37		
2+00			6.04	44.03	40.40	3.63
			7.40	42.67		
T.P.	4.14	1048.17	6.04	1044.03		
± St. (2+40)			4.63	43.54		
3+00			4.56	43.61	40.15	3.46
			12.60	35.57		
4+00			4.95	43.22	39.90	3.32
5+00			5.28	42.89	39.65	3.24
			5.75	42.42		
6+00			5.80	42.37	39.40	2.97
T.P.	4.40	1046.27	5.80	1042.37		
± St. (6+40)			4.90	41.27		
7+00			5.05	41.72	39.15	2.57
			12.10	34.67		

June 11 1926  
Clear

B.M. Pavement & Railroad near 7 Main St

See Book 929 Page 38

Pavement Center <sup>of</sup> Main

Top of 4" tile at 0+00

Flow line 4" tile at 0+00

Flow line Williams Ditch 3+24


Flow line Williams Ditch 7+05

Bellevue Cremery

T.S.	H.L.	T.S.	Elev.	Flow	Dist
	1046.77				
8+00		5.10	41.61	38.90	2.7'
		5.62	41.15		
9+00		4.98	41.79	38.65	3.14'
10+00		4.40	42.37	38.40	3.9'
10+25		5.25	41.52	38.18	3.34'
T.P.	4.42	1045.99	5.25	1041.52	
			11.49	39.30	1038.10
			4.82	41.17	
T.P.	4.40	1043.73	6.66	1039.33	
			0.50	1043.23	}
				1043.11	

Dist	Lat	Sum	Dist	C. 1/2
0	3.96			
1	3.37	7.33	100	29.0
2	3.03	7.00	"	25.9
3	3.46	7.09	"	26.3
4	3.32	6.78	"	25.2
5	3.24	6.54	"	24.4
6	2.97	6.31	"	23.0
7	2.57	5.54	"	22.4
8	2.71	5.22	"	19.6
9	3.19	5.85	"	21.5
10	3.97	7.11	"	26.3
10+74	3.74	7.31	99	23.8
				26.5

Cistern as dug.

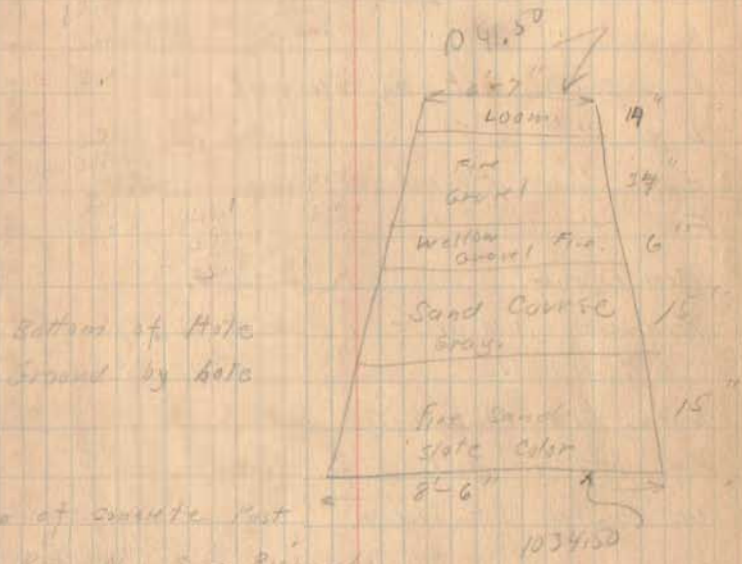

Top of concrete part  
 by R. W. S., Richards  
 Field, see Book 403, Page 44

1034.50