



REC'D 8-17-07 SWM OK

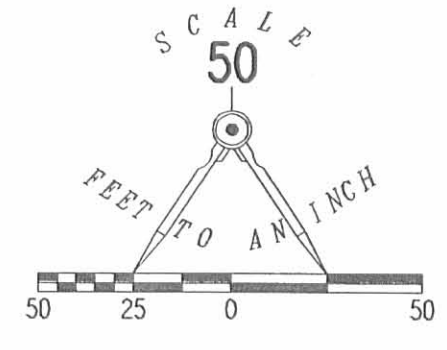

RETRACEMENT SURVEY OF THE  
 GREG LEONARD  
 LOTS 212 AND 213  
 H.J. MACKS ADDITION  
 PLAT CABINET A, SLIDE 111  
 OFFICIAL RECORD 831, PAGE 948  
 VILLAGE OF BELLE CENTER  
 RICHLAND TOWNSHIP  
 LOGAN COUNTY, OHIO

SURVEYED BY:

*William K. Bruce*  
 WILLIAM K. BRUCE  
 PROFESSIONAL SURVEYOR 7437  
 AUGUST 15, 2007

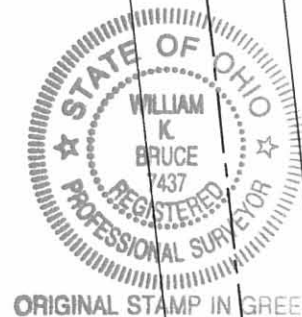

COPYRIGHT 2007 BY:  
 LEE SURVEYING & MAPPING CO., INC.  
 117 North Madriver Street  
 BELLEFONTAINE, OHIO 43311  
 (937) 593-7335  
 surveys@lsmcinc.us  
 KSS D0807 4494087 L-4494-3

- LEGEND:
- ⊕ 3/4 INCH PINCHED IRON PIPE FOUND
  - ⊙ 3/4 INCH IRON PIPE FOUND
  - 5/8 INCH IRON ROD SET
  - 1/2 INCH SQUARE BAR FOUND
  - 5/8 INCH IRON ROD FOUND IN CONCRETE

2 WORKING DAYS  
**BEFORE YOU DIG**  
 CALL TOLL FREE **800-362-2764**  
 OHIO UTILITIES PROTECTION SERVICE.

INDEXED ON MAP  
 6434 IP

