

Chester Braden Survey
April 21-1923.

R. P. STUDLEY & Co., Manufacturing

STATION.	ALIGNMENT.	DEFLECTION.	REMARKS.
----------	------------	-------------	----------

meas SWing Lendell & Auburn = 109° 37'
compute dist on Lendell front & Aub S. to E Alley

(1) Start at E Novell & Auburn E on E Aub - 439.
at 494' E Lendell ^{line} produced N.
502.0 - Lendell St & Auburn

(2) Start E Aub on Lendell line. Son Lend Lenn
at 206.5' = E of 16½ Alley set nail

(3) Start at E Aub & Novell S on E Novell
at 213.3 set nail - E Alley

(4) Start at 213.3 of 3. E on E Alley
at 439 set spike opp 5 W. Braden
Aug Left - NE Aug 89° 40'

(5) Start at 439 of 4 Aug Left 89° 40'
at 3.3 set T = SW corner Braden

" 60.1 set T = NW " "

Check N from 439 of 4 to cut aub ave = 213.3

meas SW corner Braden = 78.6'

" 5 " " 971

" 10 52.1" 20 89° 40' 97.1


419.0 439. " 16.8" 10 72.5

57.8 25.2 2.2

Chester Braden Survey
Pt Trot 474 April 21-1923

TOPOGRAPHY.

96° 4'

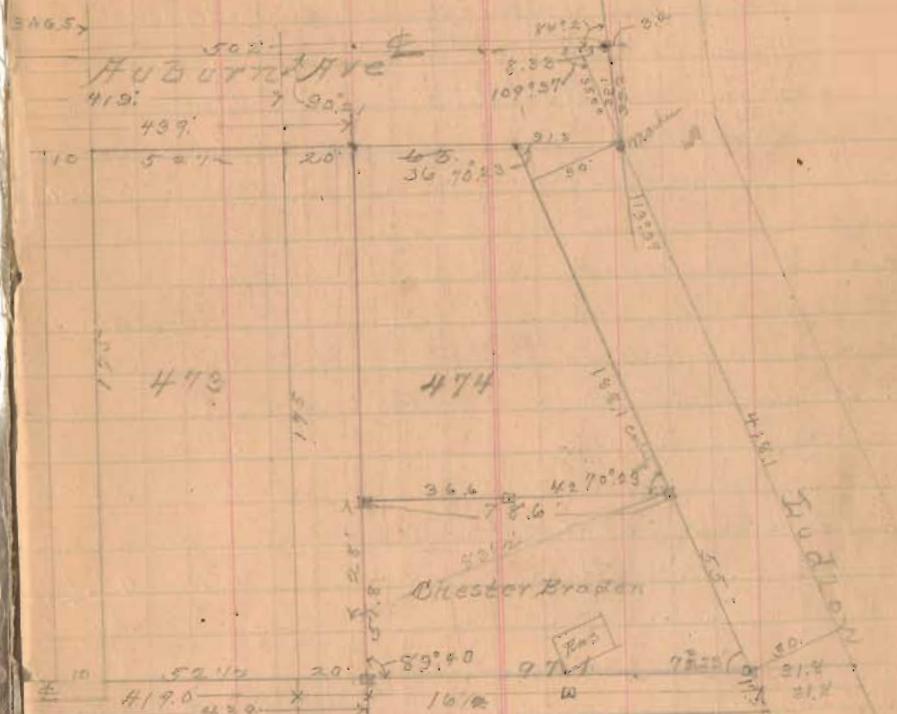

(49)
INDEXED ON MAP