



Survey For Lillie White Oil Co.

See Book 403 Page 49 For Survey
of Property line.


11/9/23 Enderline 10
Clear-Cool Wright.

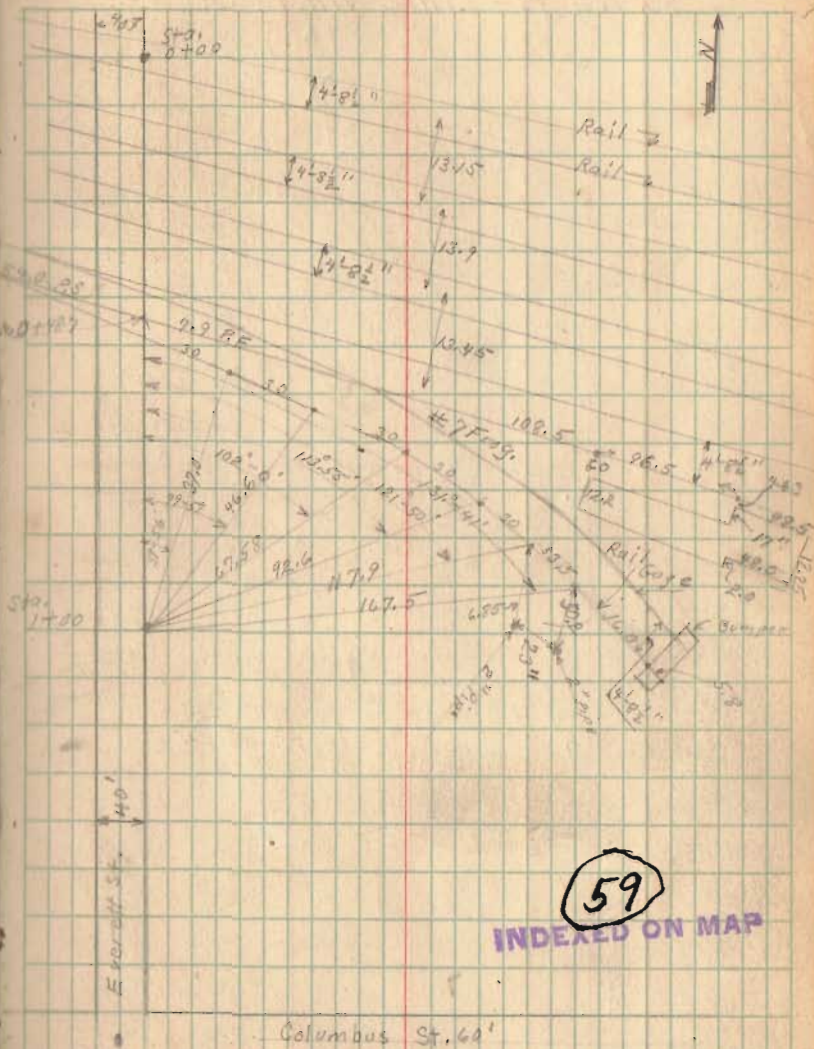

Survey for Lillie White Oil Co.

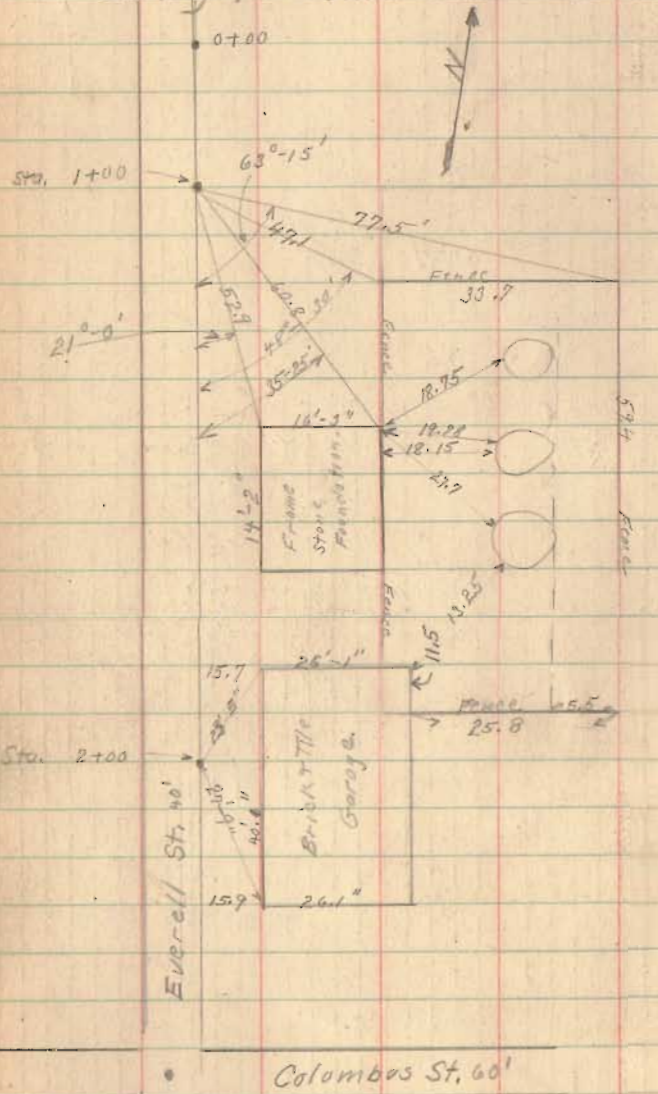

11/9/23

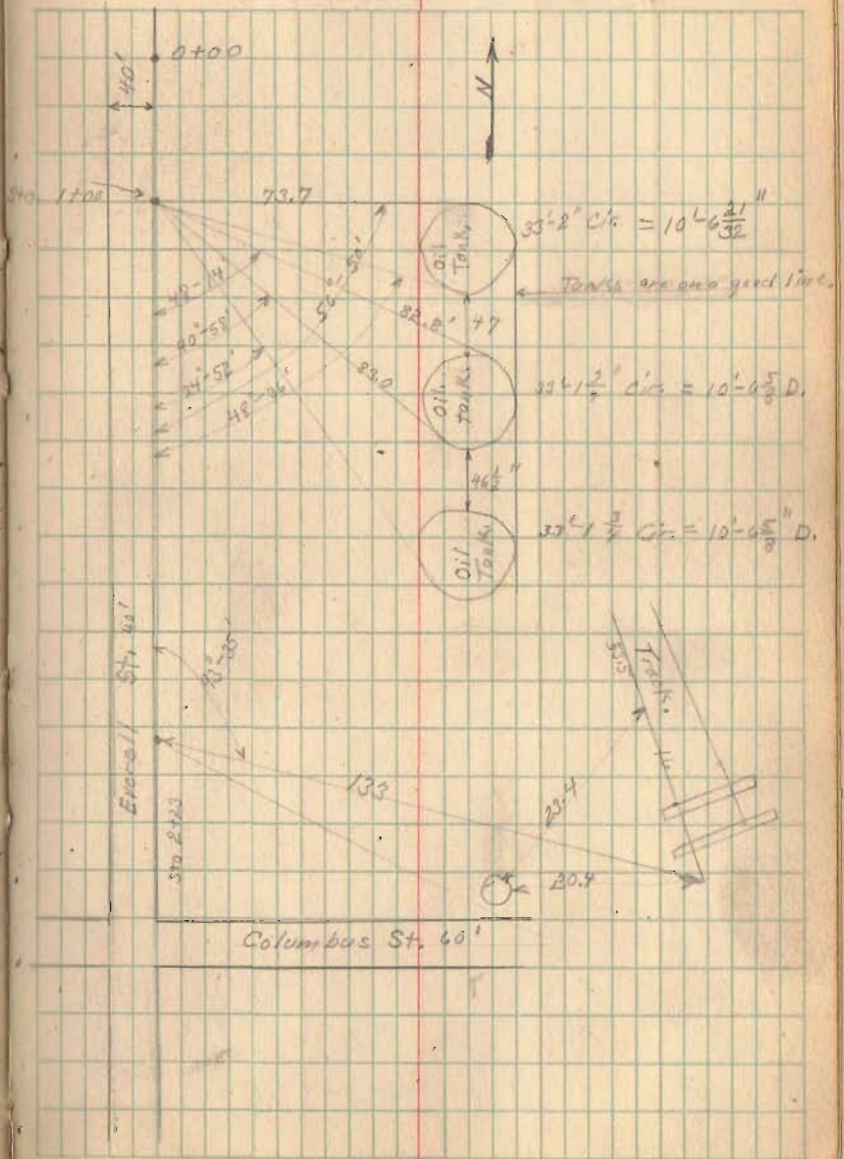

Survey for Lillie White Oil Co.


Vanger to Lillie White Oil Co.

Sec. - 35 Town 4 Range 14E.M.R.S.

Vol. 126 Page 301.

11/10/23

12

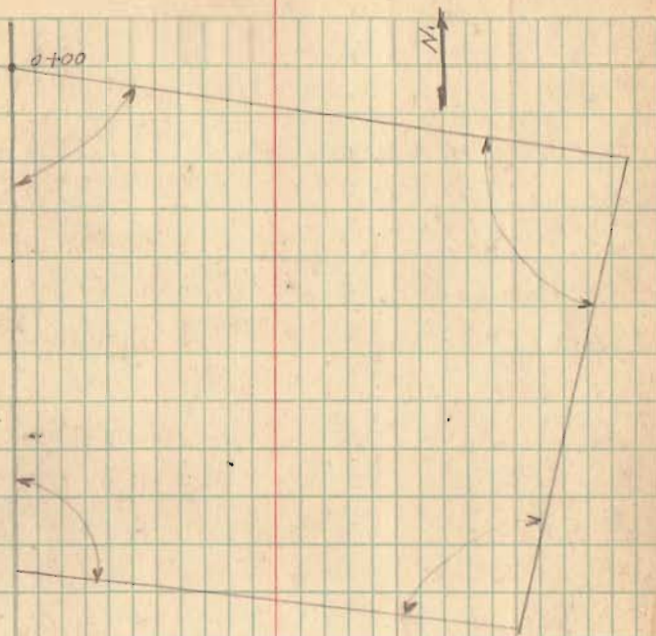


Everett St. 40'

Columbus St. 60'

Survey for Lillie White Oil Co.

11/10/23

13

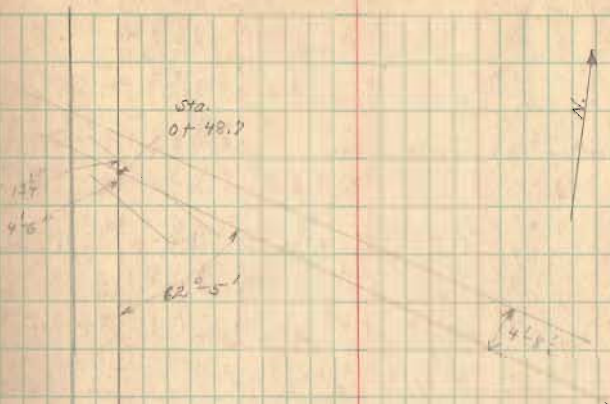

Front St. 90'