

100.00 ASSUMED ELEVATION OF TOP STEP AT N.W. ENTRANCE TO CHURCH. ELEVATIONS ARE SHOWN THUS 100.0
TREES SHOWN ☉ ARE 10" SUGARS.

CATHOLIC SCHOOL

BELLEFONTAINE OHIO

SCALE ONE INCH = 10 FEET

DATE JAN 1924

67 IP
INDEXED ON MAP



Catholic School Survey.



Church
 About
 36'-7"


1/12/24

Trees shown are 10' high.

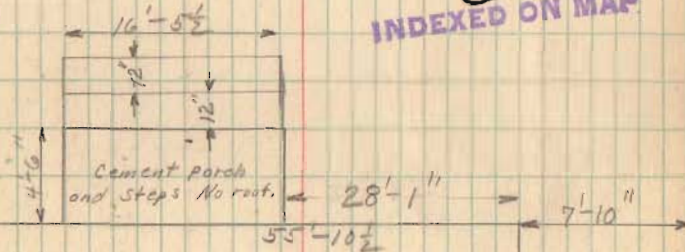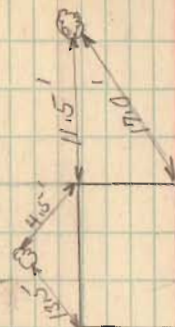

(67)
 INDEXED ON MAP

2 story Brick (School.)

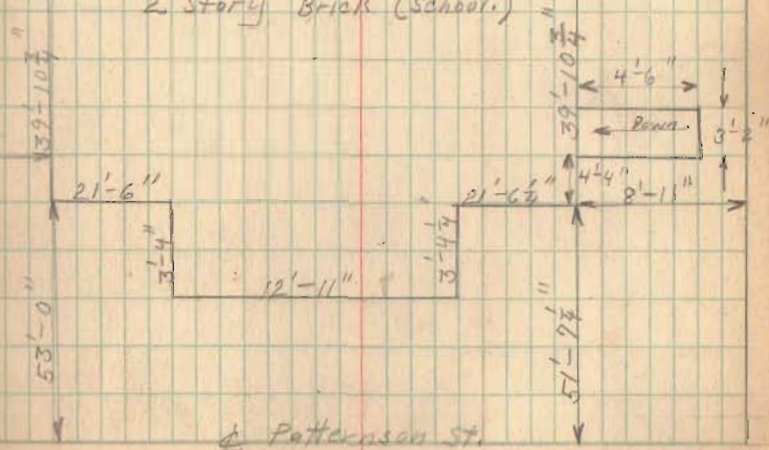


East side of 163' Alley.

Patterson St.

Catholic School Survey.

1/12/24
1/19/24


All trees shown are 10" Sigsars

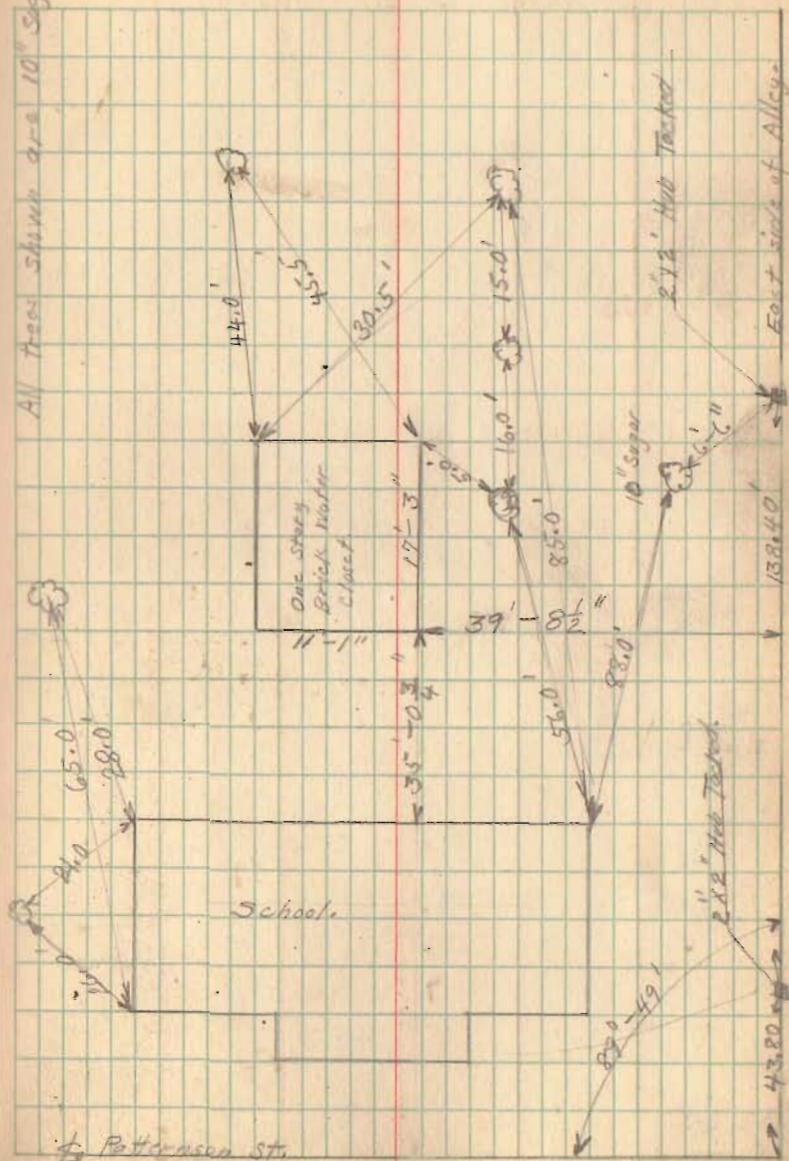

Catholic School Survey.

1/19/24 Smucker,
Wright.

Trees shown are 10" sugar.

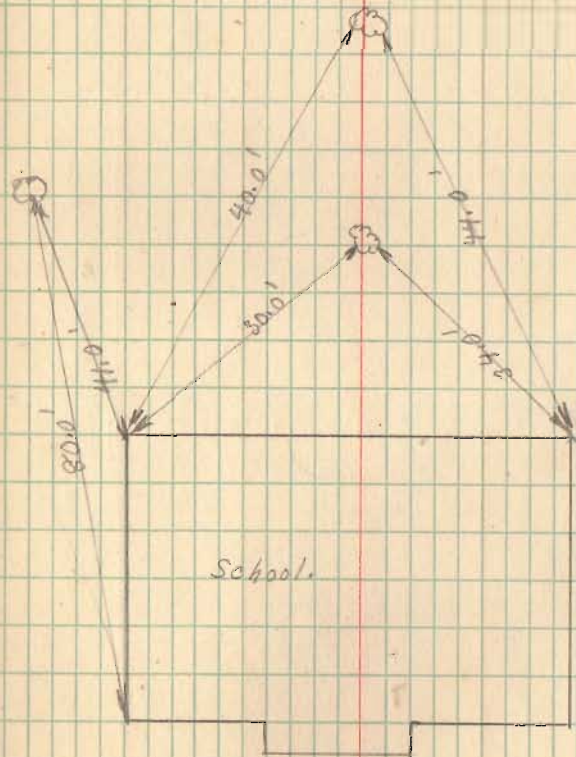

School.

Alley.

street

Catholic School Survey.

B.M. Assumed. Elev. 100.00 Top Step of church.



1-19-24.

21

