


Jewell Survey E. Columbus Ave. Bellefontaine

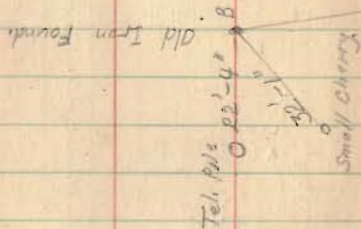

See Book 51 for a survey made by Richey for Maxwell. This should be of help in finding old irons.

102
INDEXED ON MAP

June 28 - 1924
Rainy.

F. Wright
Ed. Carr.

58

