

Messenger Survey. (S. Detroit)


This sketch shows original lots.
(See Page 28 for survey.)

- A - Monement with cover
- B - " " "
- C - " " "
- D - " " "

	By Wright	Plot Books	Excess
AB	525.5	525.0	0.5
BC	435.7	435.3	0.4
CD	525.9	525.5	0.4
DA	436.0	435.3	0.7

Note there is no shortage and the excess for this lot would be small being near the corner of the lots. See Page 28 for lot as staked.

Sept - 8 - 1926
clear
Wright
Ed. Cure

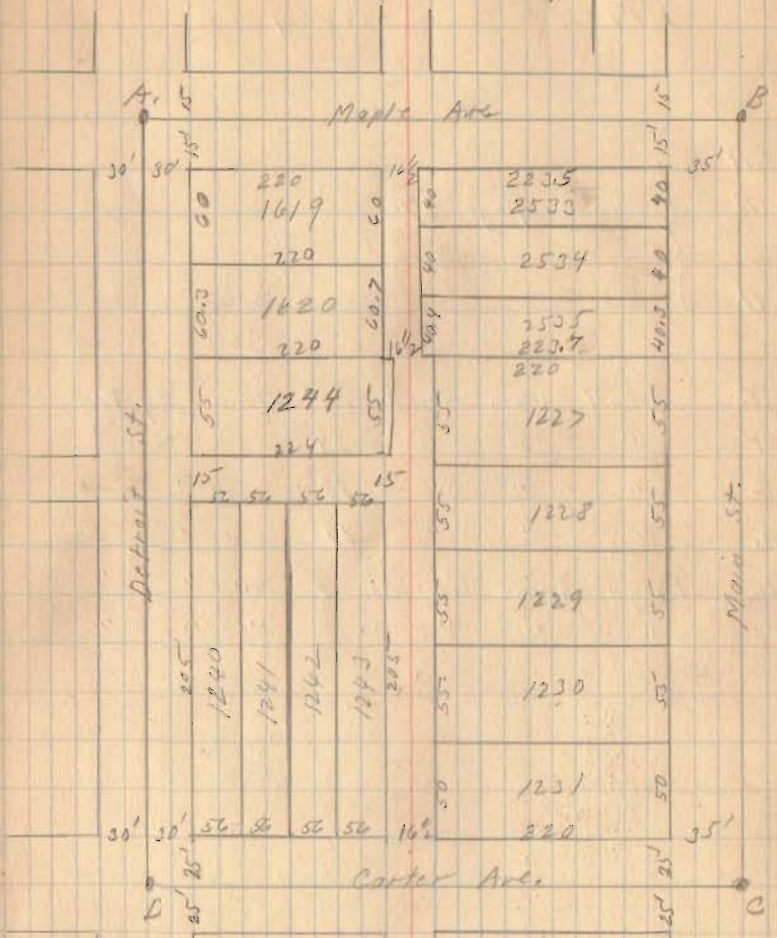

(615)

INDEXED ON MAP

Messenger Survey

A }
 B } see Page 27
 C }
 D }

E Small iron About 24" Placed By Weight
 F " " " 24" " " "
 G " " " 18" " " "
 H " " " 24" " " "
 I Large Spike in Street " " "
 J " " " " " "

9-8-26

18

