

May - 16 - 1927
 Cold - Cloudy
 Wm. H. Wright,
 Surveyor

M^e Laughlin Survey
 S. Detroit Lot. 1616

From Plat Book Original
 Lot. 1615 = 55' wide
 1616 = 55' "
 1617 = 55' "
 1618 = 54' "


A. Monument with cover
 B " " "

Distances on page 5 from
 Plat book and Deeds.

See Drawer R

INDEXED ON MAP

630

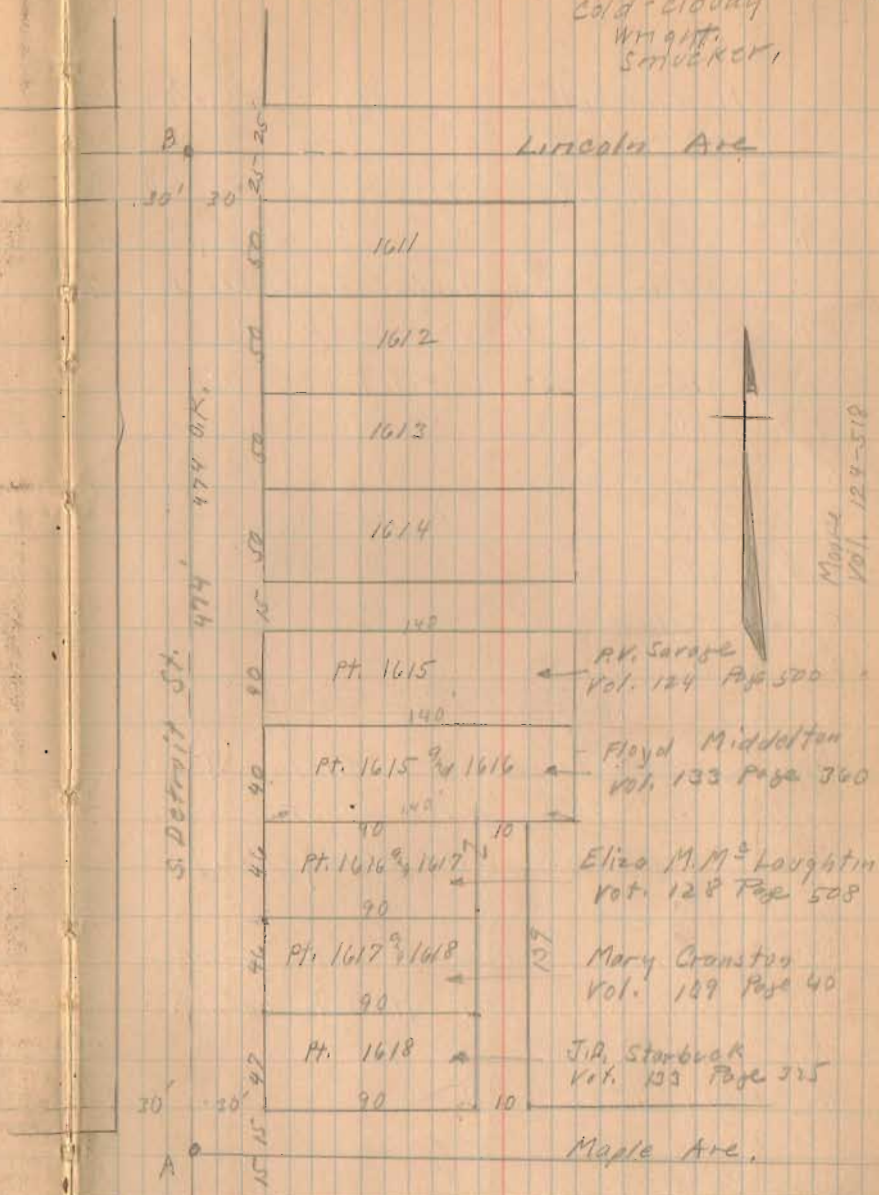

See Book 418 Page 27
 Massmer Survey.

5-16-27

C

M^e Loughlin Survey (Continued from Page 5)

- A. Monument with corner
 B " " " & Lincoln Ave
 C Spike & of Maple Book 418 Page 27
 D " " " " " " "
 E Stake placed at lot corner
 F " " " "
 G " " " "
 H Iron " At lot Corner
 I " " " " "
 J Stake " " " "
 K " " " " "

Measured as shown. Stake J
 O.K. with old corner post.
 Line J.G. O.K. with old fence.

- L Iron placed at lot corner
 M Small clothes post at lot corner
 N Stake Placed at Lot Corner
 O. Old Iron Found " " "

(See Book D Page 66)

