


Lot 2906 by 2907

Corners same as on Page 53

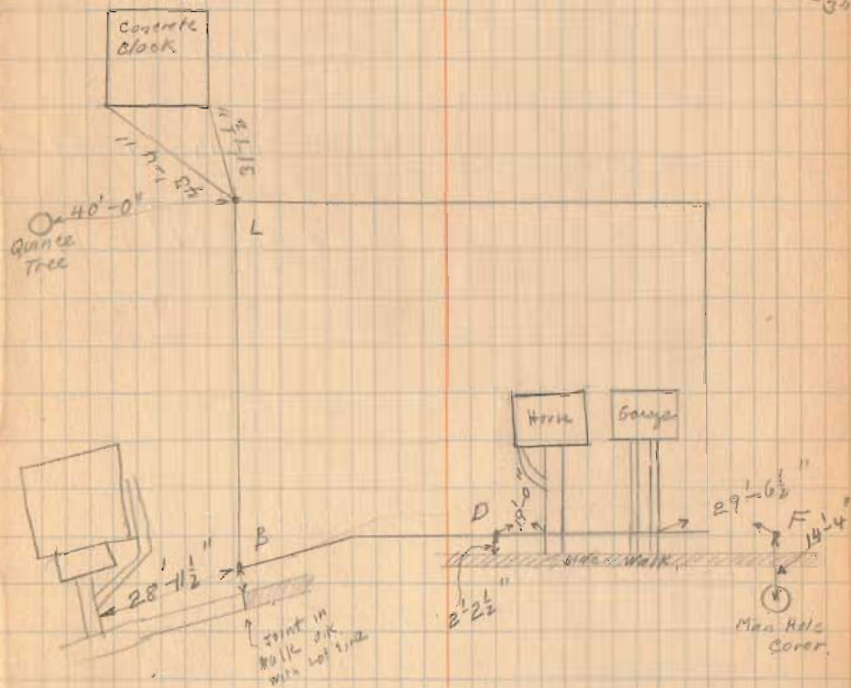

9-21-28.
F.E. Wright.
Bill Wright.

54

Lot.	2906	9 th	2907				
ts.	H.I.	-S.	Elev.	Floor of Bldg	Fill		
3.74	103.74		100.00			On walk	S.W. Cor of Lot.
		4.11	99.63	100.67	1.04	Stake	S.W. cor Bldg.
		5.24	98.50	100.67	2.17	"	S.E. " "
		6.60	97.14	100.67	3.53	"	N.E. " "
		3.07	100.67	100.67	0.0	"	N.W. " "