


1911 Survey for Iron City
Special School District

Williams ch.

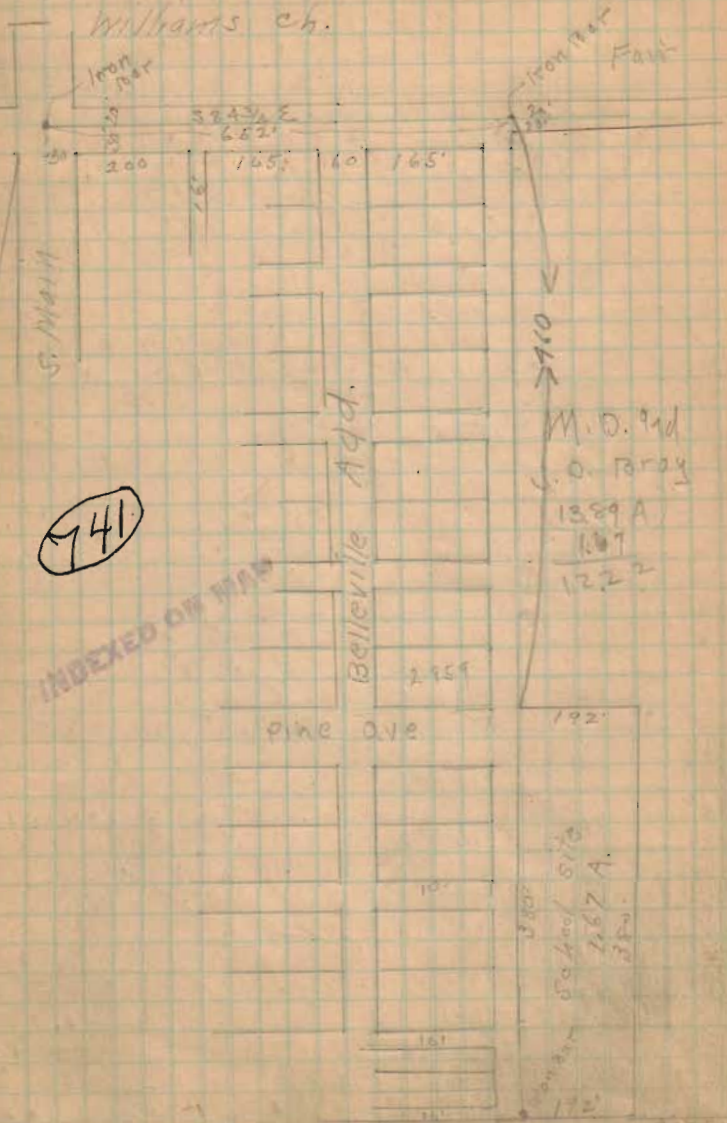

741

INDEXED ON MAP

Gravels Street

840.7'

Mich Kelly