


883 1P

INDEXED ON MAP

Howenstein survey
Bellfontaine
Lawrence St

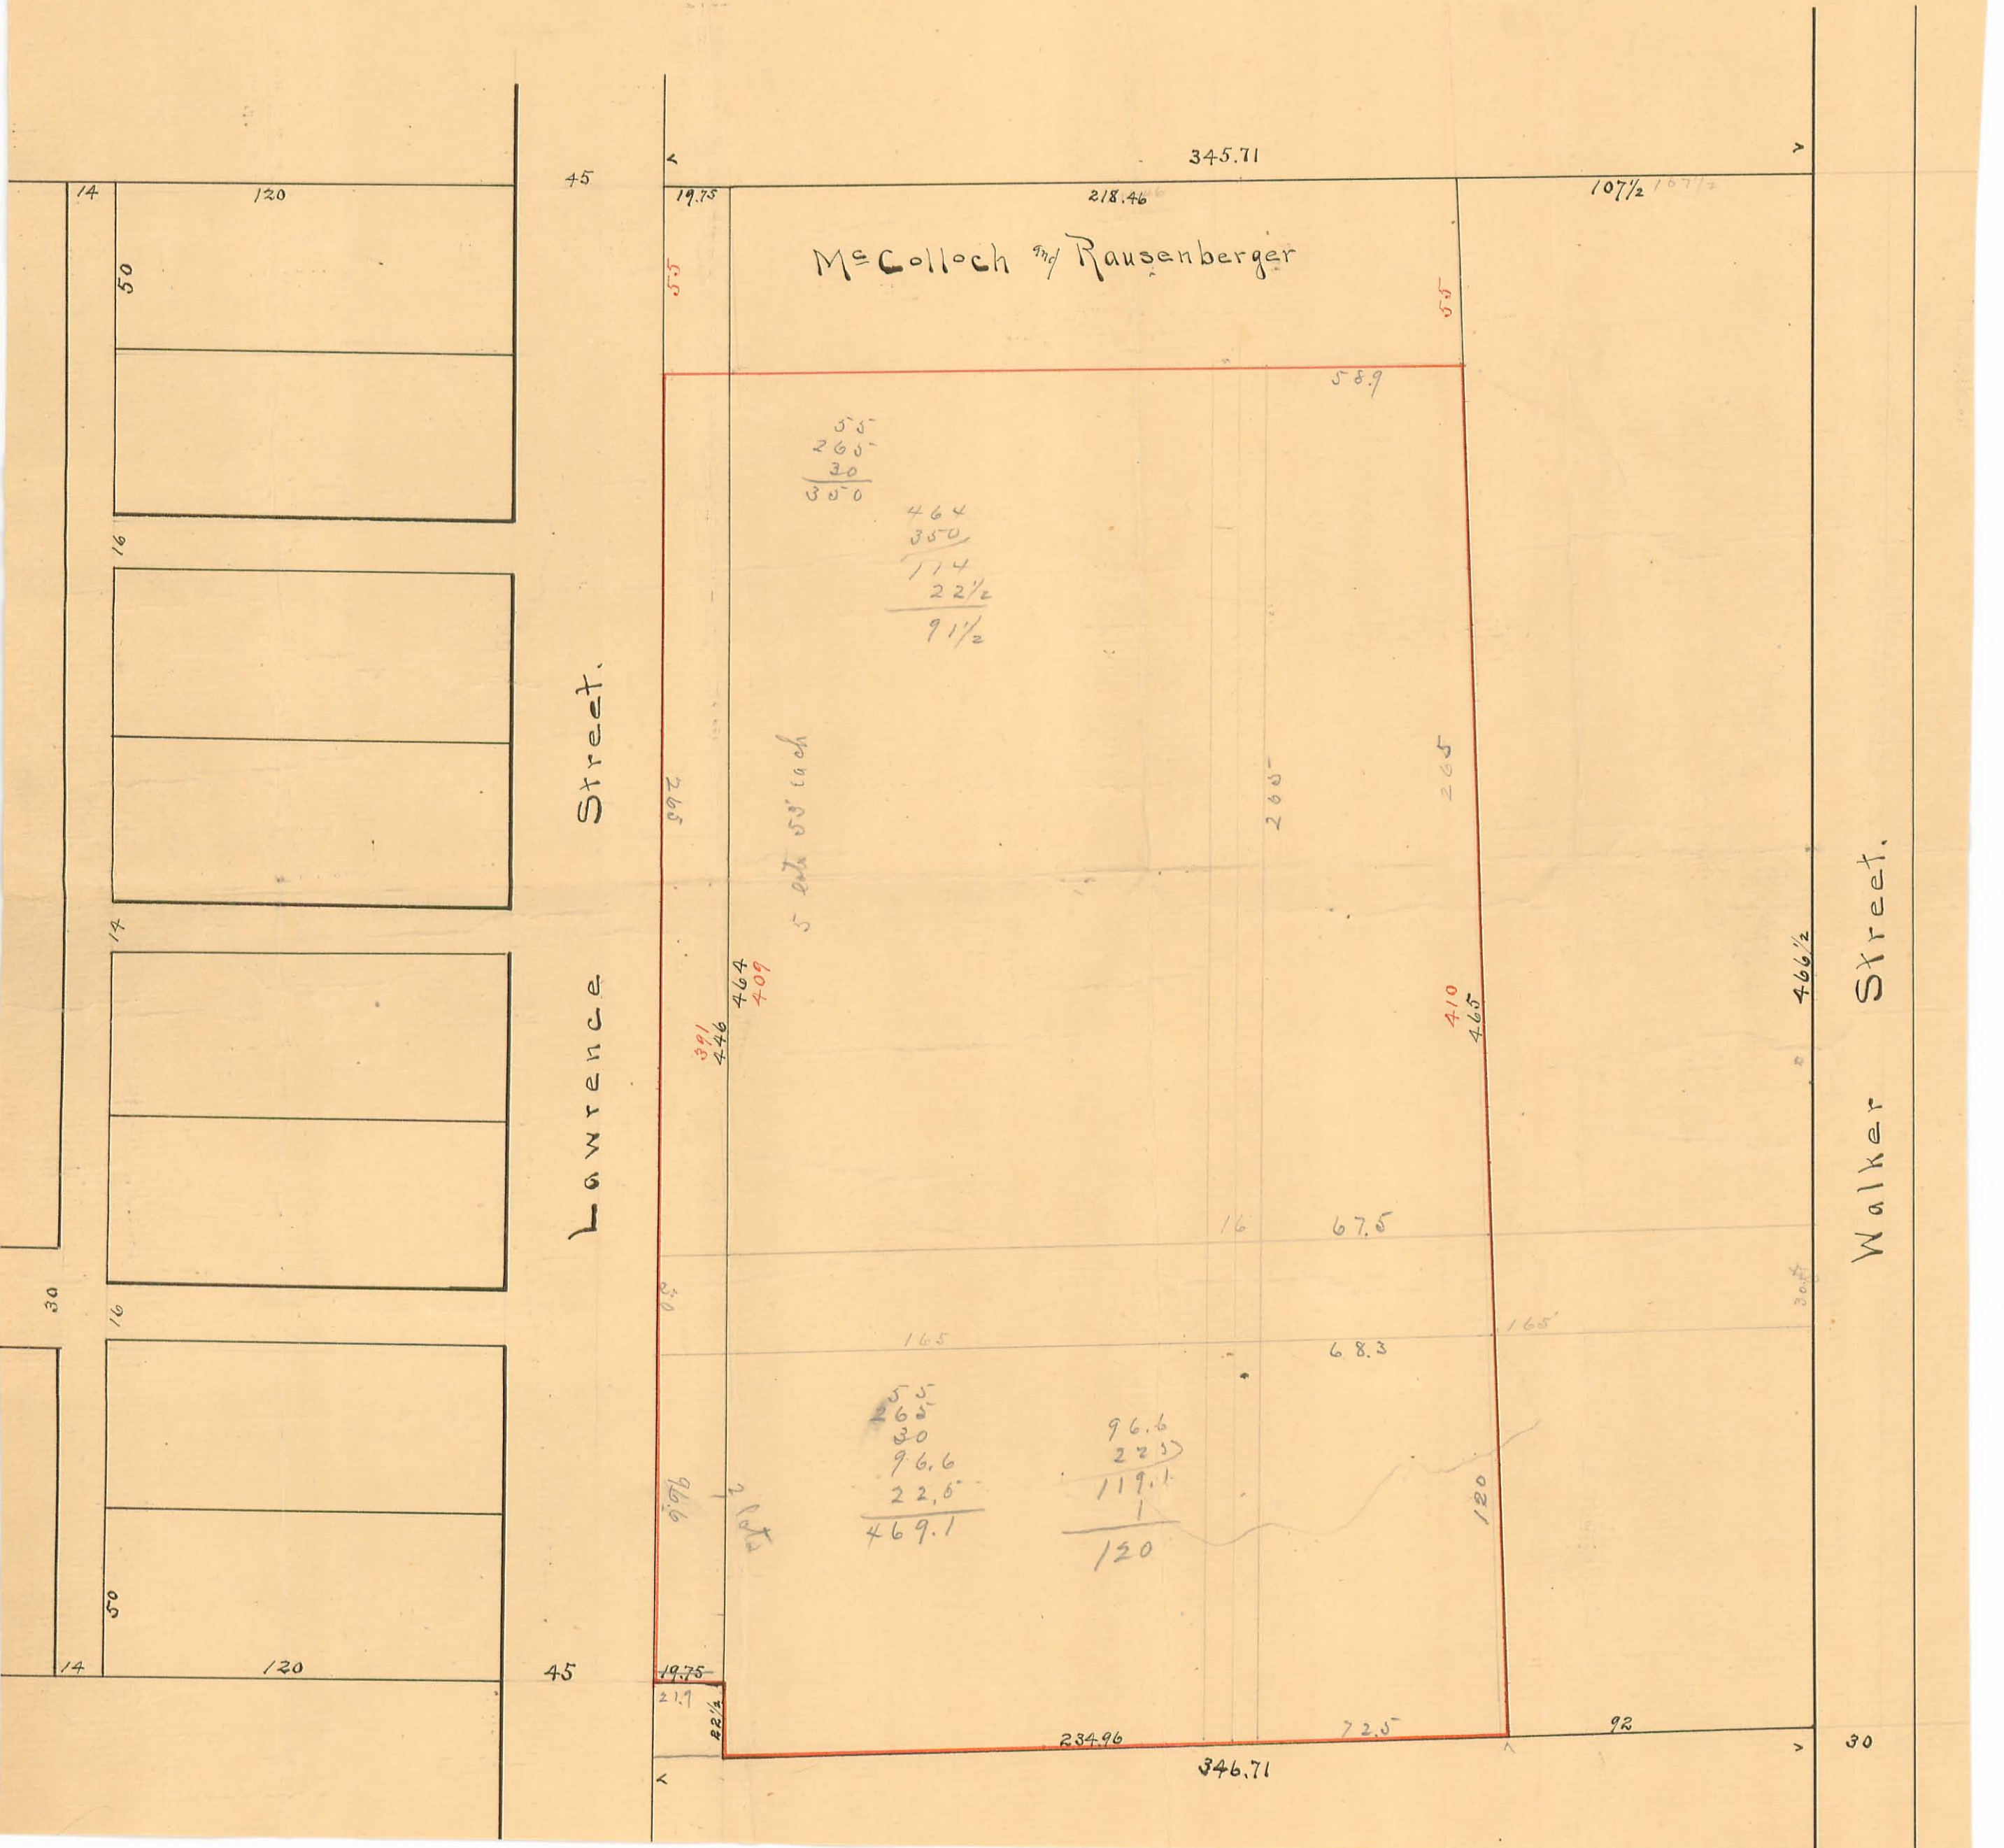

345.71

107 1/2

McCulloch & Rausenberger

$$\begin{array}{r} 55 \\ 260 \\ \hline 30 \\ \hline 350 \end{array}$$

$$\begin{array}{r} 464 \\ 350 \\ \hline 114 \\ 22 \frac{1}{2} \\ \hline 91 \frac{1}{2} \end{array}$$

5 lots 55' each

Lawrence Street.

Walker Street.

19.75

218.46

55

55

58.9

265

265

265

391
446

464

409

410

465

466 1/2

16

67.5

25

165

68.3

165

$$\begin{array}{r} 255 \\ 265 \\ 30 \\ \hline 96.6 \\ 22.6 \\ \hline 469.1 \end{array}$$

$$\begin{array}{r} 96.6 \\ 22.5 \\ \hline 119.1 \\ 1 \\ \hline 120 \end{array}$$

120

996

19.75

234.96

72.5

92

346.71

30

14

120

50

16

14

16

50

14

120

45

21.7

22 1/2

30