

885 IP-1 School Lot survey for W<sup>m</sup> Hrous Kop

INDEXED ON MAP Lake Twp

Surv. No. 4478.

See Book C Pg 186

B. 58 1/2 E - 175

School Lot  
1/2 acre

N 9 1/2 W 3 1/2 A

S 3 1/2 W 510

Bellegardine

A Stone N 7 1/2 W 182

D. Stone  
Zanesfield Pike

A. Blk. wal - 18" N 26 1/2 E 83 lks -

S.E. < 2 story frame house N 38 1/2 W 135 lks

Stone - limestone 5" x 5" x 18" center of gravel  
on pike S. 4 lks from corner.

B. Stake fence post to be put where this stake


C. " " " " " " " " " " " "

D. Stone 5' x 5" x 18" in center of gravel on  
pike. Stone box culvert S 7 1/2 E 25 lks.

June 11, 1887

S. A. Buchanan

|       |
|-------|
| 260   |
| 310   |
| 570   |
| 285   |
| 175   |
| 1995  |
| 285   |
| 49875 |

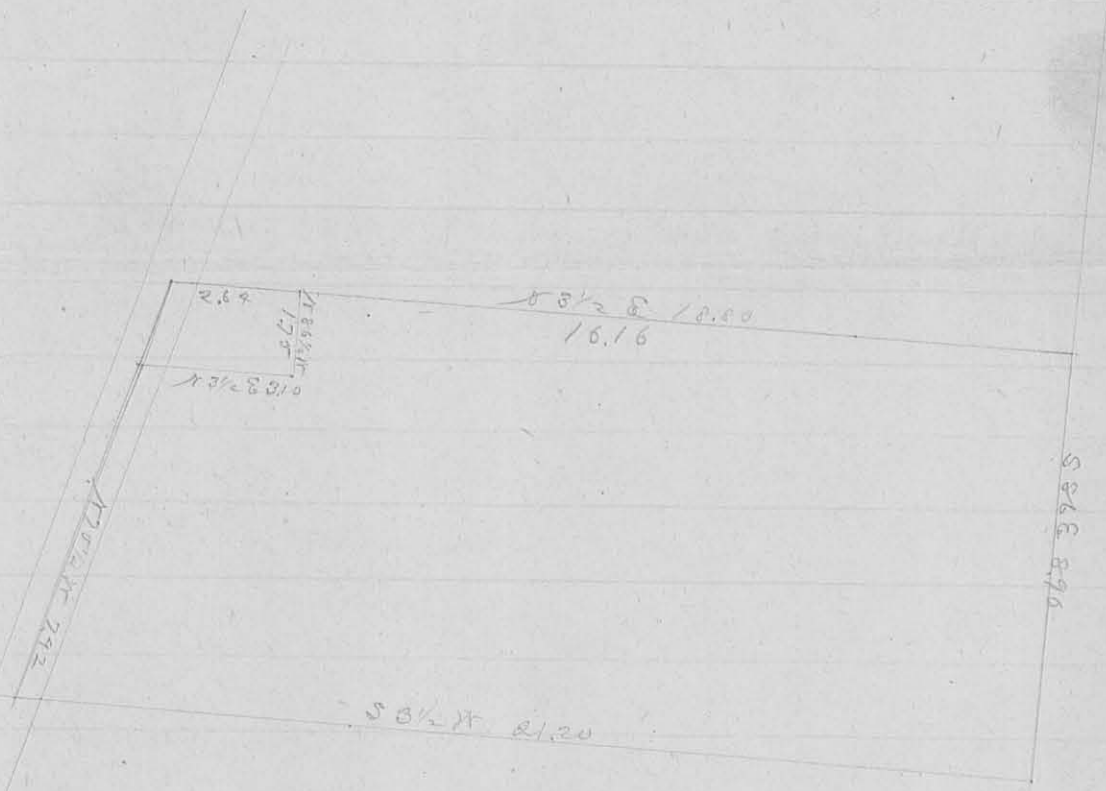

INDEXED ON MAP  
285 IP-2

4478

Blaine west side of rd  
N 1/2 sec 10 T10N R10E


Joseph Kronsopf  
1891 stone

300' woods from road  
beam & 2x4 wood

Small Blk. Red. Grub.

2 small Red. Horned W. 2

2 small Red. Horned W. 2  
2 small Red. Horned W. 2

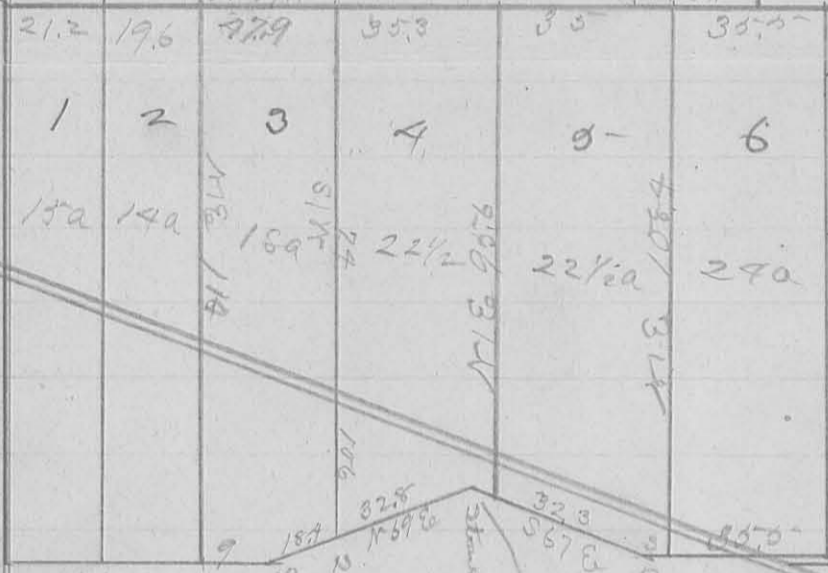

10

9 25.2

8 24.2

7 25.2

Thick wood line

1891

1891  
2 x 20 x Red O.  
Bogwood & Hick.

Stems wood "G. K."

32.8  
567.8  
567.8  
10.7 thick

28.2  
35.1  
35.3  
47.9

141.2  
19.6  
21.2  
182.2  
109.2  
28.2

INDEXED ON MAP  
885 1P-3