


Dist	Plot.	Meas.
Columbus - Main to Mad R.	526.5	525.57
Main - Cols to Sand.	526.5	525.13
Sandusky - Main to Mad R.	526.5	527.8
Mad R. - Cols to Sandusky.	526.5	525.0



(888) IP Crawford survey  
 Bellefontaine  
 Lot 136

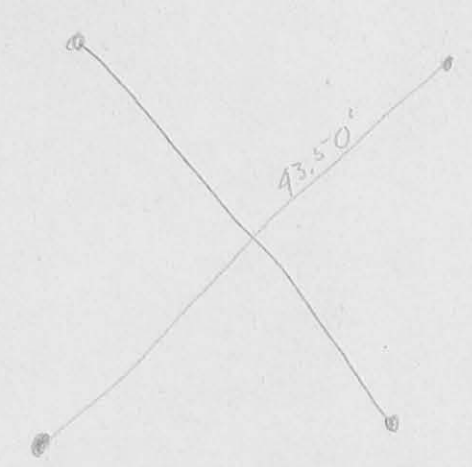