



103-38

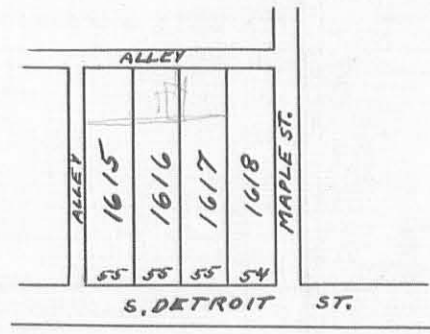


ORIGINAL LOTS

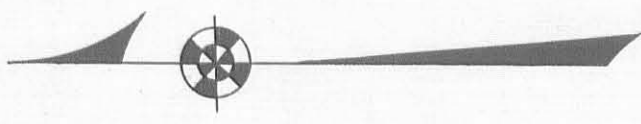

FIELD NOTES IN SURVEYOR'S BOOK 419 PAGE 5  
 A MONUMENT WITH COVER  
 B STAKE PLACED  
 C IRON "  
 D " "  
 E STAKE "  
 F STAKE AND COR. FENCE POST  
 G IRON PLACED  
 H CLOTHES LINE POST ON LOT CORNER  
 I IRON FOUND  
 J STAKE PLACED  
 SURVEYED MAY 16, 1927  
 J. H. Knight C.E.

See Book 492 Page 13  
 See Book D Page 66

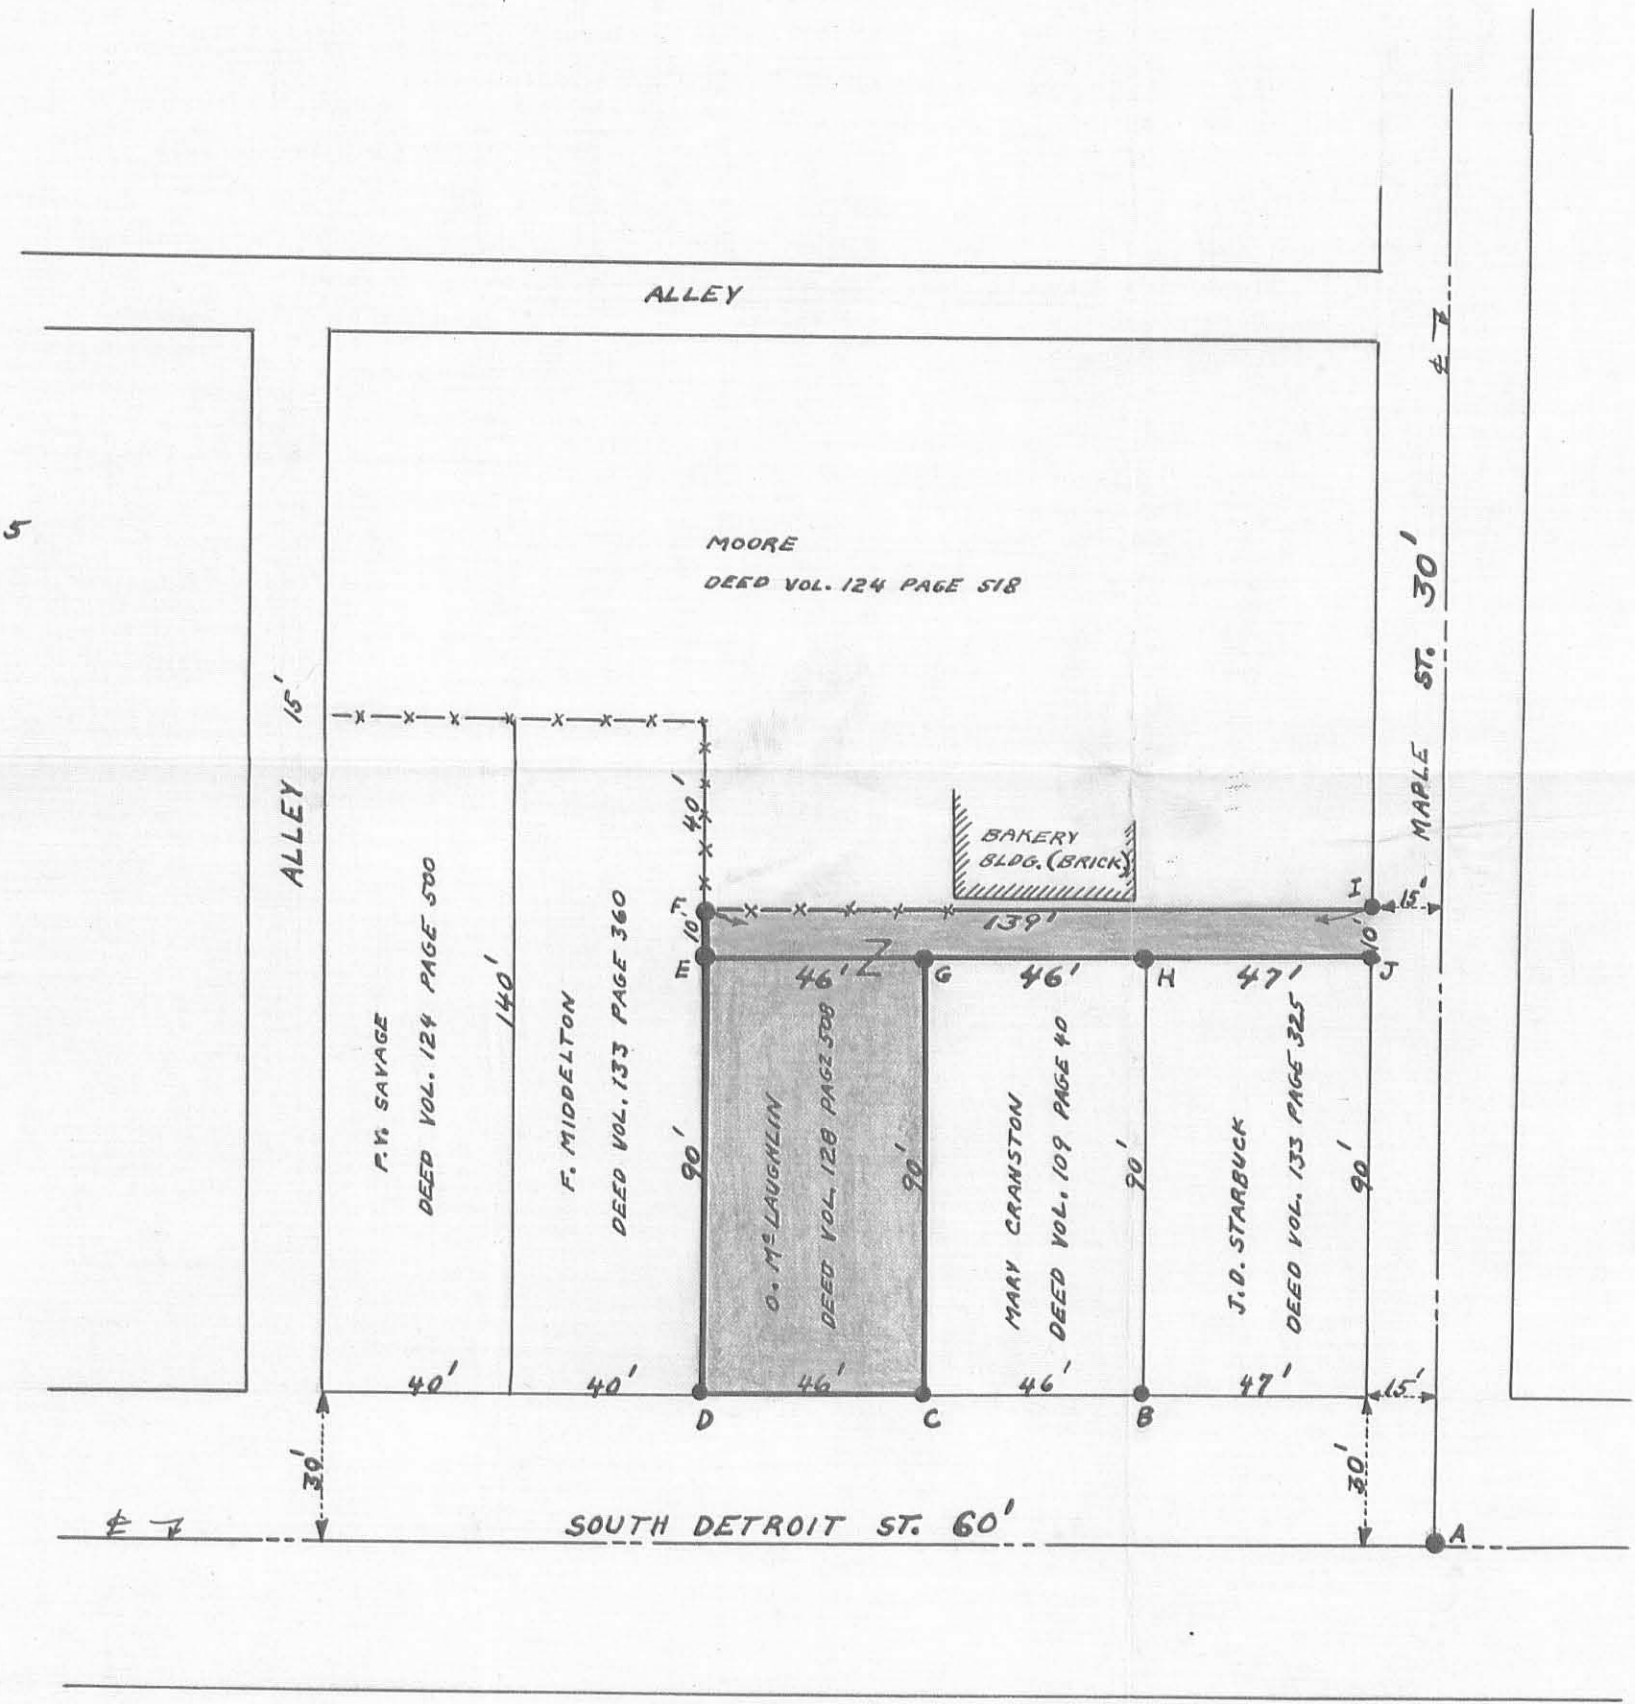

922 IP

INDEXED ON MAP

# Mc LAUGHLIN SURVEY

## BELLEONTAINE

Maple Ave & Detroit St

1927