

Shawmut Surrey
Lot 943 Eastern Ave.

A-B-C-D-E-F-G.

H-E-J Sam as M^c Claim
Surrey Page 13 All found
April 5-1930

U Hub Placed.

V " "

W. 1" Square Iron 30" Long

X Hub Placed

y " "

Z $\frac{3}{4}$ " Round Iron Placed

Lots on plat Book 171-6" X 50'

Alleys 10'

Set on C. sighted on I.
measured 10' set D then 50' set
V then 50' set W.

Set on D sighted on G.
Measured 10' set X then 50' set y
then 50' set Z

Apple tree and wild cherry on
lot 943 Line yz 1'-9" south of
south side of wild cherry
zw measured 171'-6" O.K.


April-5-1930
clear
Wright
Bill Wright.

56



1187

INDEXED ON MAP

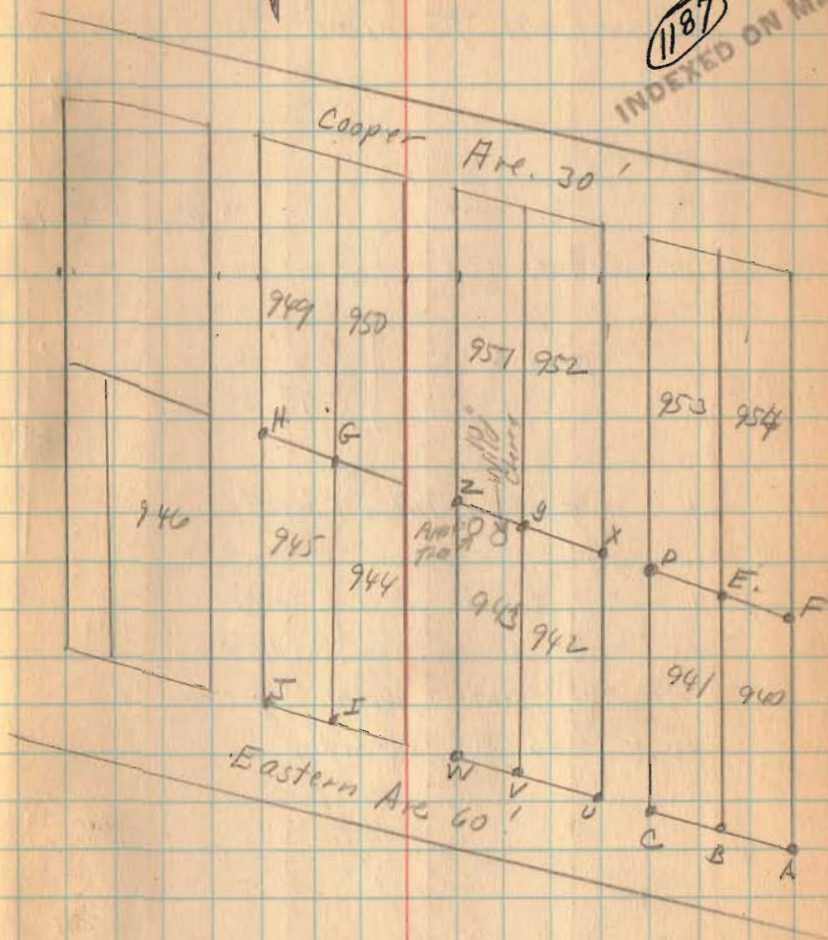

W TO I = 60' O.K.


(See Page 13 This Book)

Shannon, Surrey
Lot 943 Eastern Ave.

A-B-C-D-E-F-G.
H-I-J same as M^c Claim
Surrey Page 13 All found
April 5-1930

U Hub Placed.
V " "
W. 1" Square Iron 30" Long
X Hub Placed
y " "
Z 3/4" Round Iron Placed

Lots on flat Bore 171'-6" X 50'
Alleys 10'
Set on C. sighted on I.
measured 10' set O then 50' set
V then 50' set W.
Set on P sighted on G.
Measured 10' set X then 50' set y
then 50' set Z
Apple tree and wild cherry on
lot 943 Line yz 1'-9" south of
south side of wild cherry
zw measured 171'-6" o.k.

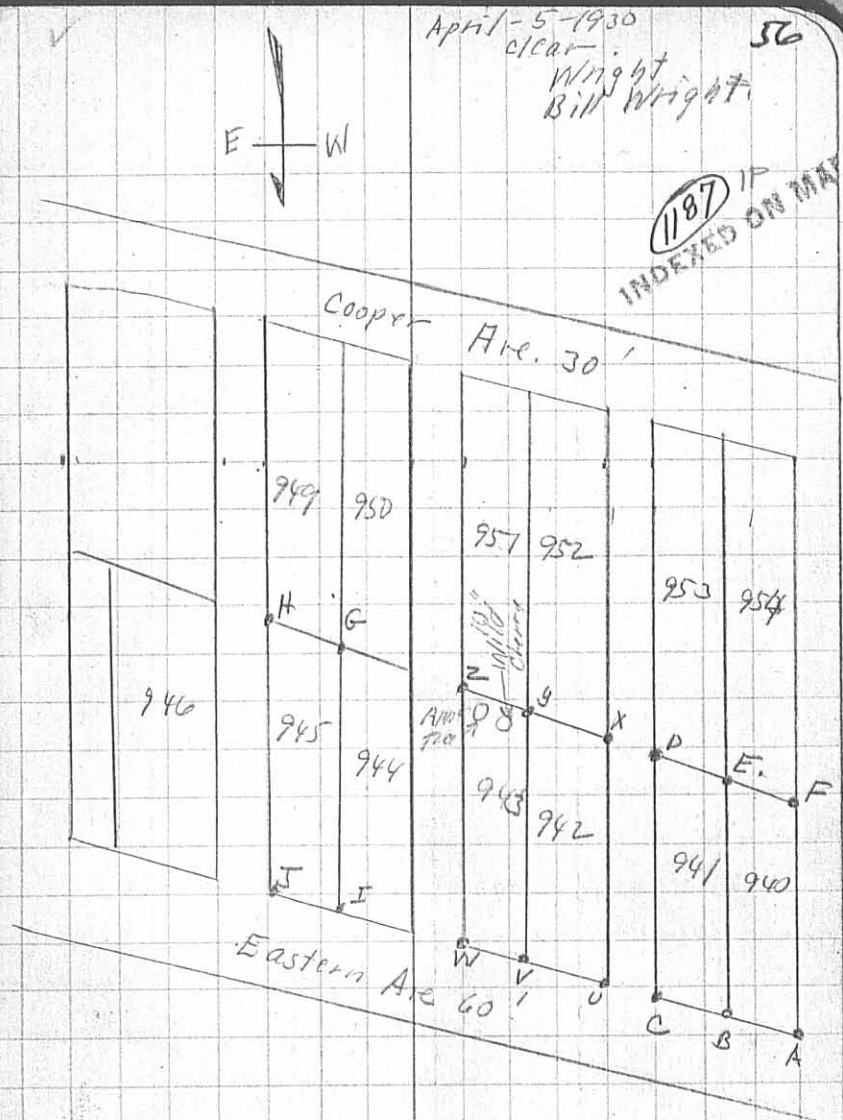

W to I = 60' O.K.

(See Page 13, This Book)