

Lot 476 Bellefontaine
Bradfield Surrey

52 1/2' off of West side } Deed Vol. 147
except 61 feet off of } Page 254
N end

Lots 55 x 175
Alleys 16 1/2'

B - Monument

Top Hyd. S.E. 32.3

W. end C.I. Inlet N.E. 32.7

S.E. C.I. Inlet N.W. 32.3


⊙ M.H. Top. 3.2

Block 403


page 52

F - Mon. with corr

D. " " "

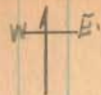

April - 14 - 1932
Cliff Wing
Bill Wright

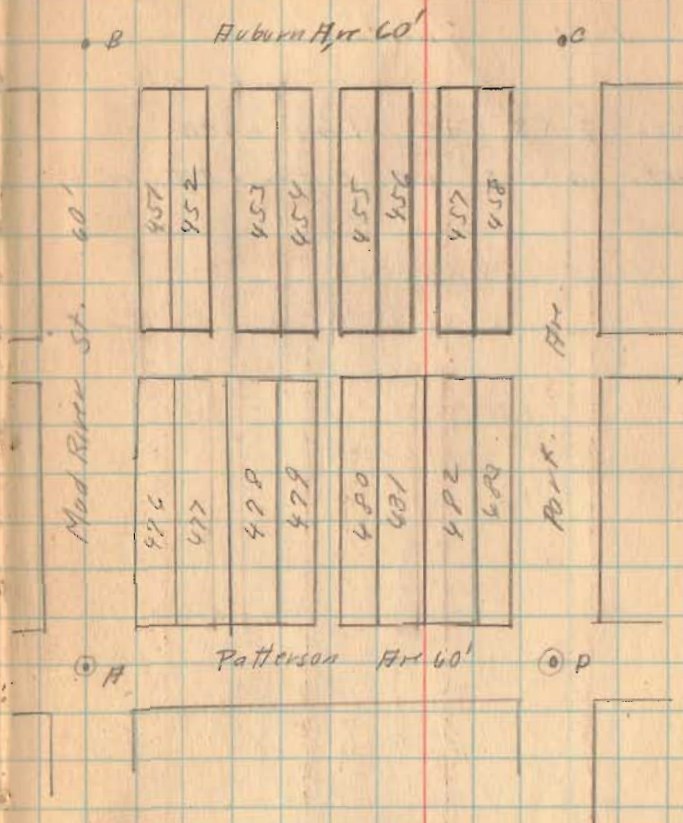

1363
INDEXED ON MAP


(over)

Lot. 476 (Continued)

Placed 2x2 oak Hubs with
tacks as shown, E, F, G, H, I, J.

Lot Stated 114 X 52 1/2

1363
INDEXED ON MAP

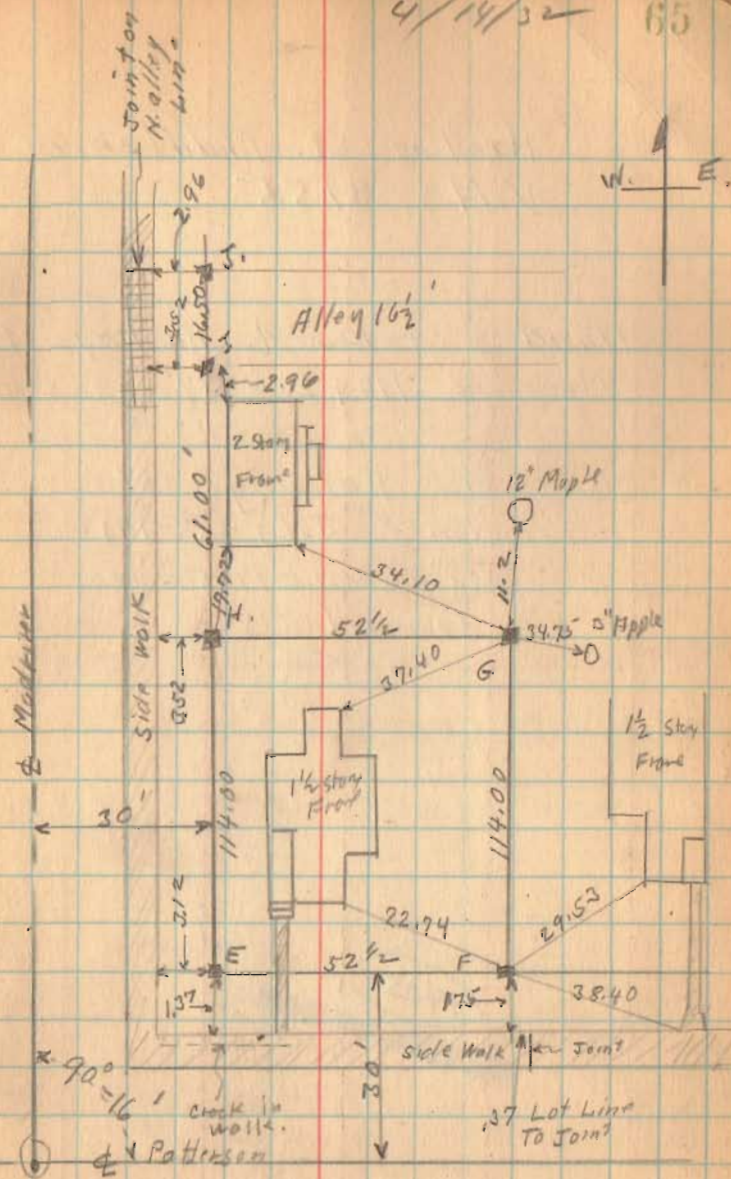

Lot 476 Bellefontaine
Bradfield Surrey

52 1/2' off of West side } Deed Vol. 147
except 61 feet off of } Page 254
N. end

Lots 55 x 175
Alleys 16 1/2'

B - Monument

Top Hyd. S.E. 37.3

W. end C.T. Inlet N.E. 32.7

S.E. C.T. Inlet N.W. 32.3

⊙ M.H. Top. 3.2

H - Mon. with cover

D " " "

Book 403


Page 52

W E

Apr 14 1932
C. W. Wright
Bill Wright

Huborn Apr 60'

Mad River St. 60'

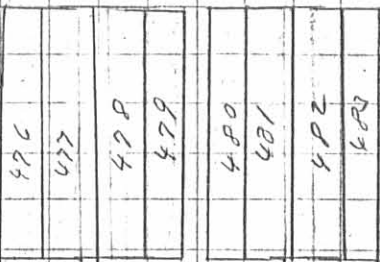

Patterson Apr 60'


1363 IP-1
INDEXED ON MAP

(over)

Lot. 476 (continued)

Placed 2x2 Oak Hubs with
tacks as shown E, F, G, H, I, J.

Lot Stated 114 X 52 1/2

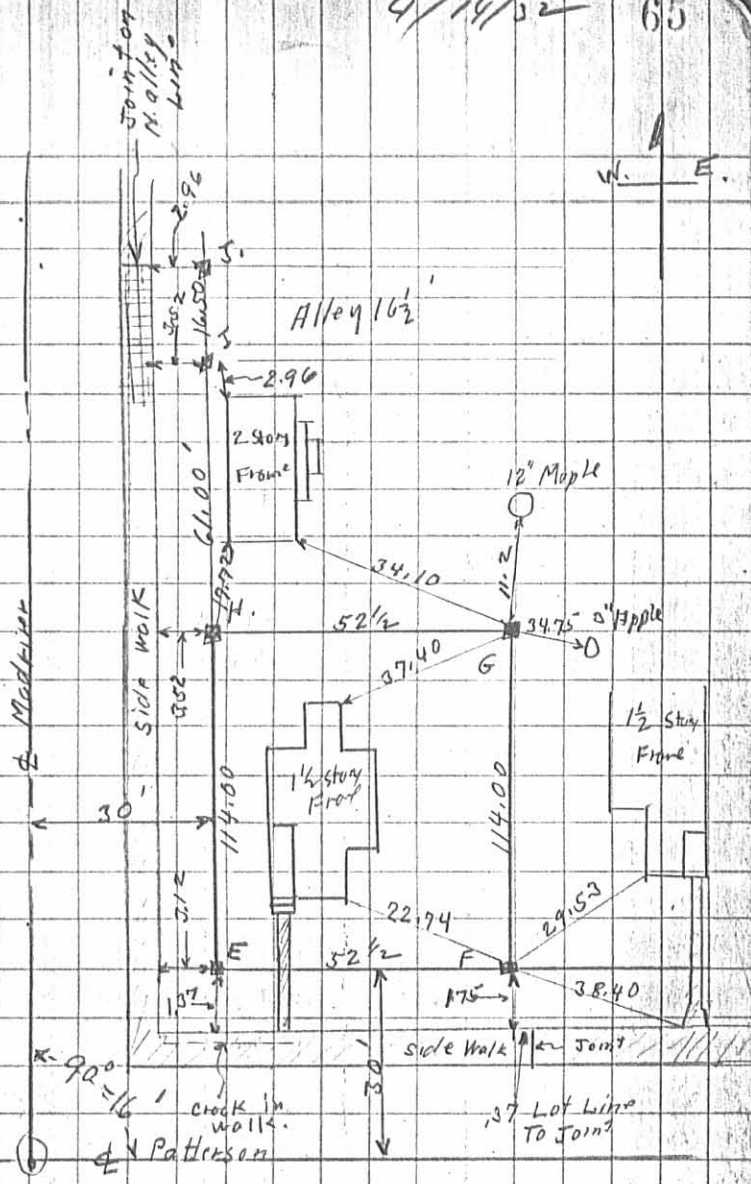

1363 IP-2
INDEXED ON MAP