


Street Centers Bellefontaine Ohio

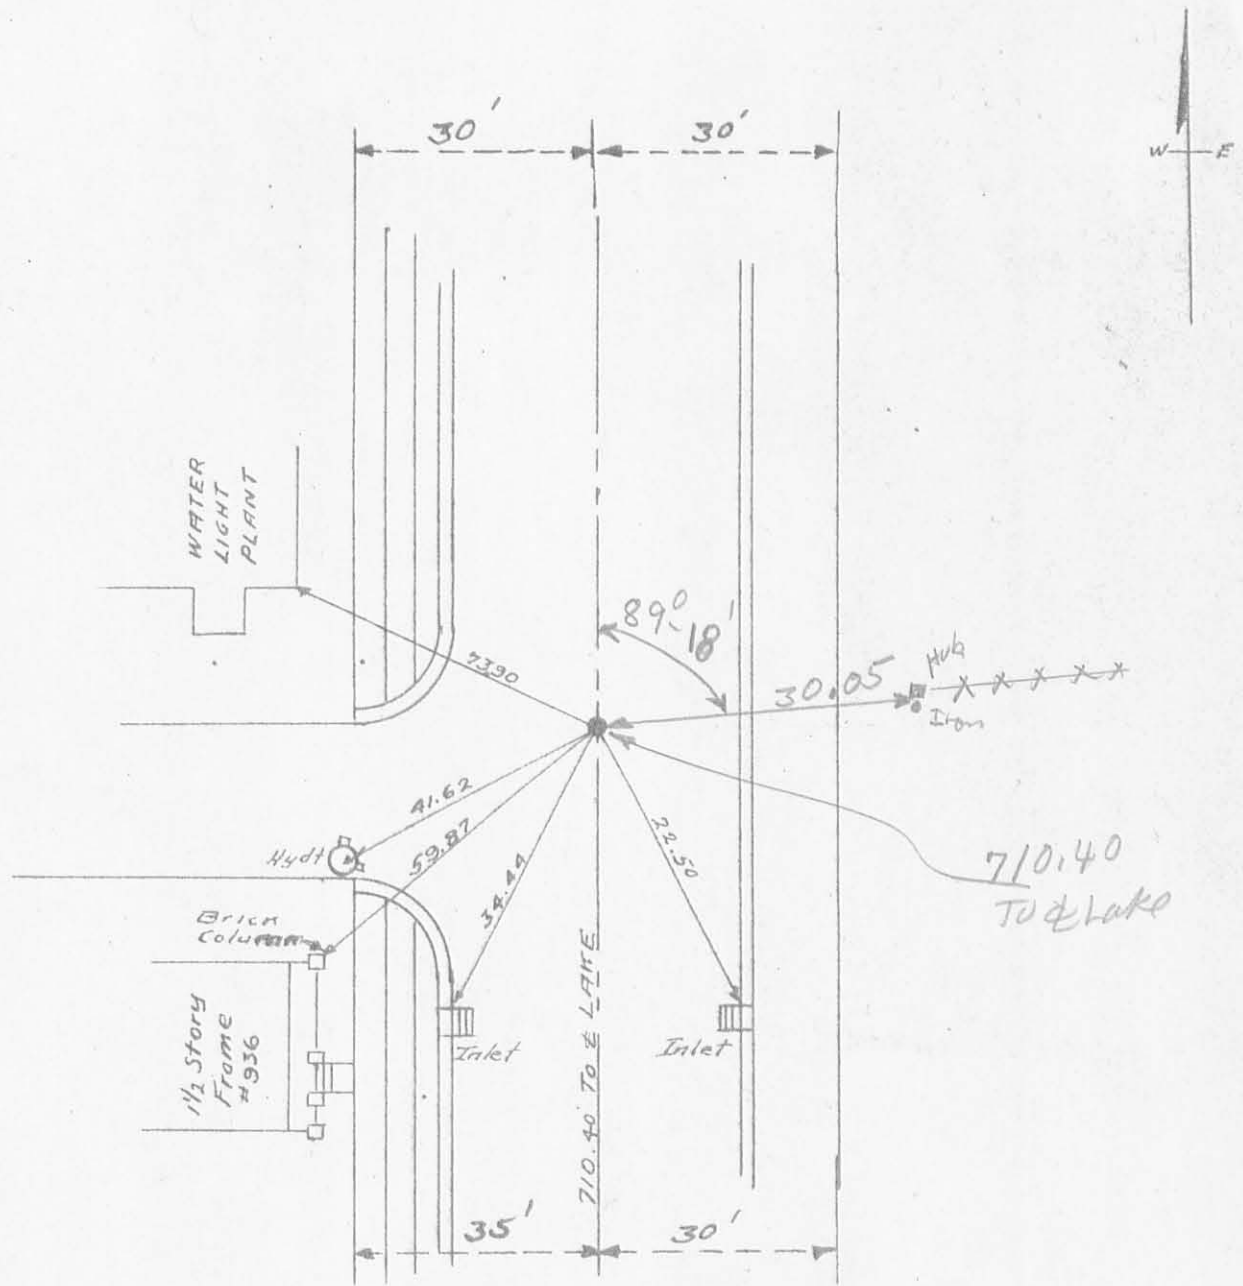

Date Witnessed. *May 22-1940*.....

Material.... *Copper in Lead*.....

Scale..... *None*.....

Monument Cover. *None*.....

Book..... Page.....

.....

**MAIN**  
.....  
At  
**WATER LIGHT PLANT**  
.....

1875-1P

INDEXED ON MAP