

Reference:
Karus Allotment - Slide 289.

● - 3/4" Iron Pipes Fd.

2047 MAP IP

Daniel E. Gilbert

DANIEL E. GILBERT, P.S.
REG. SUR. NO. 5402
400 N. PARK ST.
BELLEFONTAINE, OHIO 43311
TELEPHONE: 1 (513) 593-1428




Fahle Survey
Lot No. 3628
City of Bellefontaine
Lake Township
Logan County, Ohio

March 16, 1992

092-008



W. E.

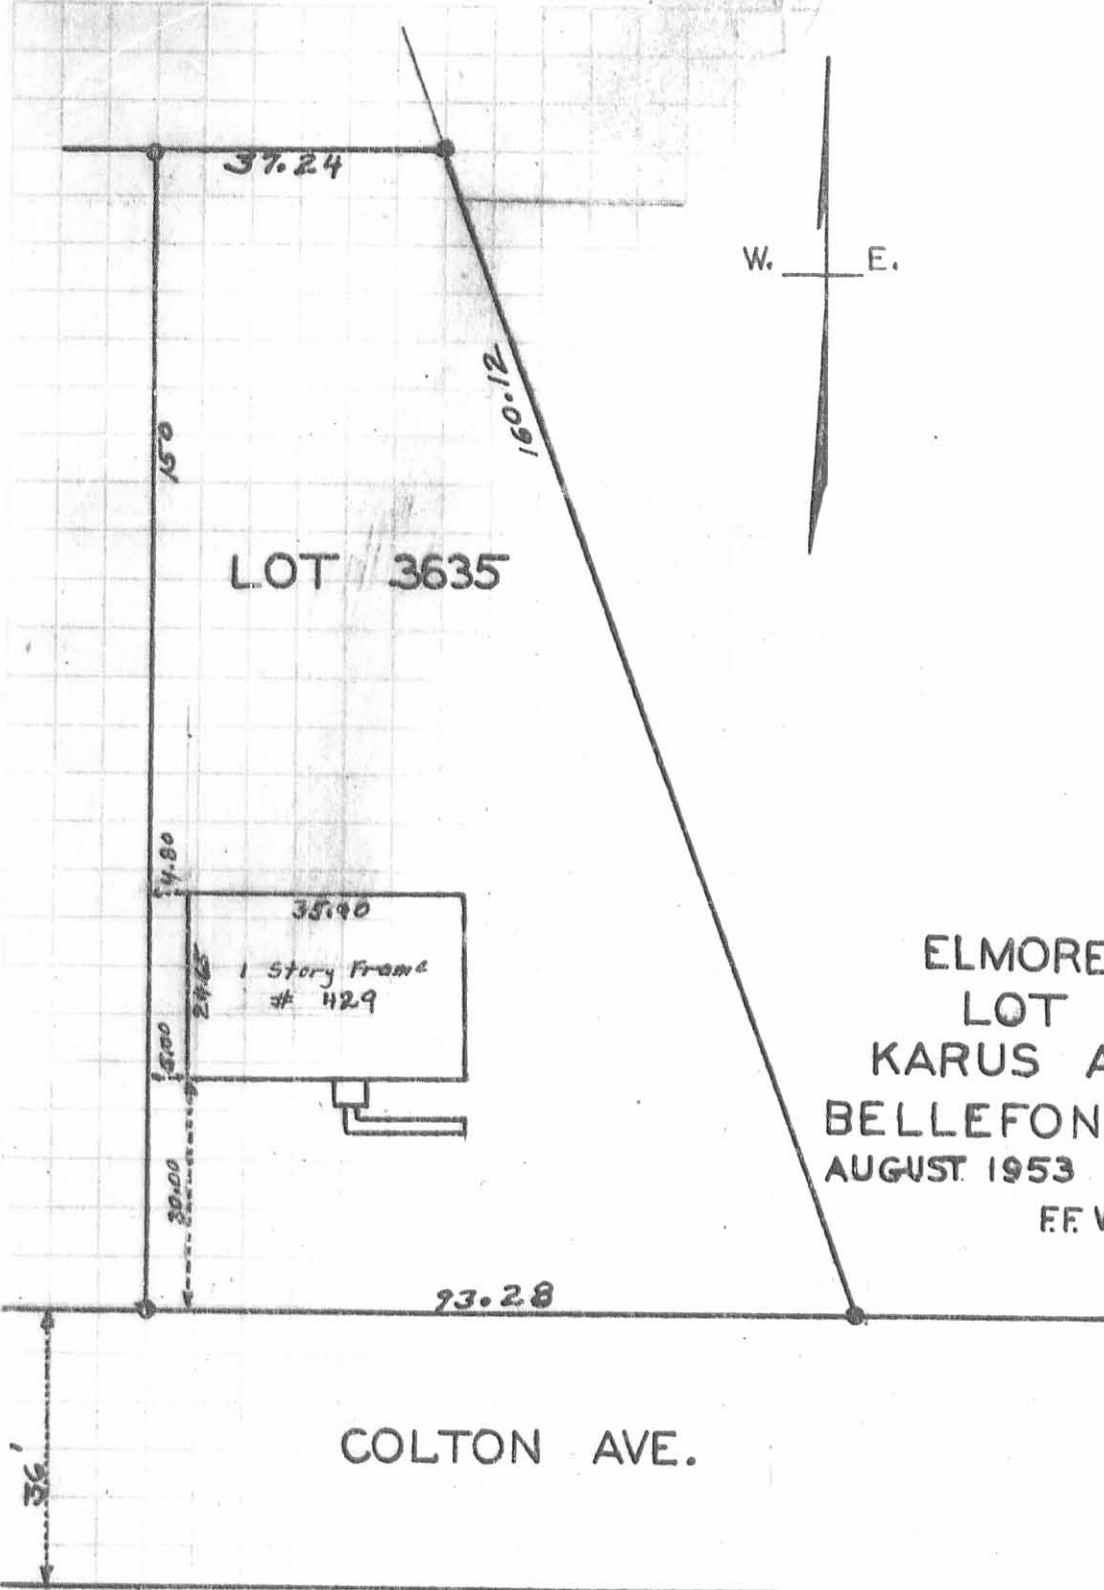


ELMORE SURVEY
LOT 3635
KARUS ALLOTMENT
BELLEFONTAINE OHIO
AUGUST 1953
F.F. WRIGHT
1"=25'

● Irons

I find no encroachments
on Lot 3635
August 8, 1953
Foster F. Wright

INDEXED ON MAP
2047 2P

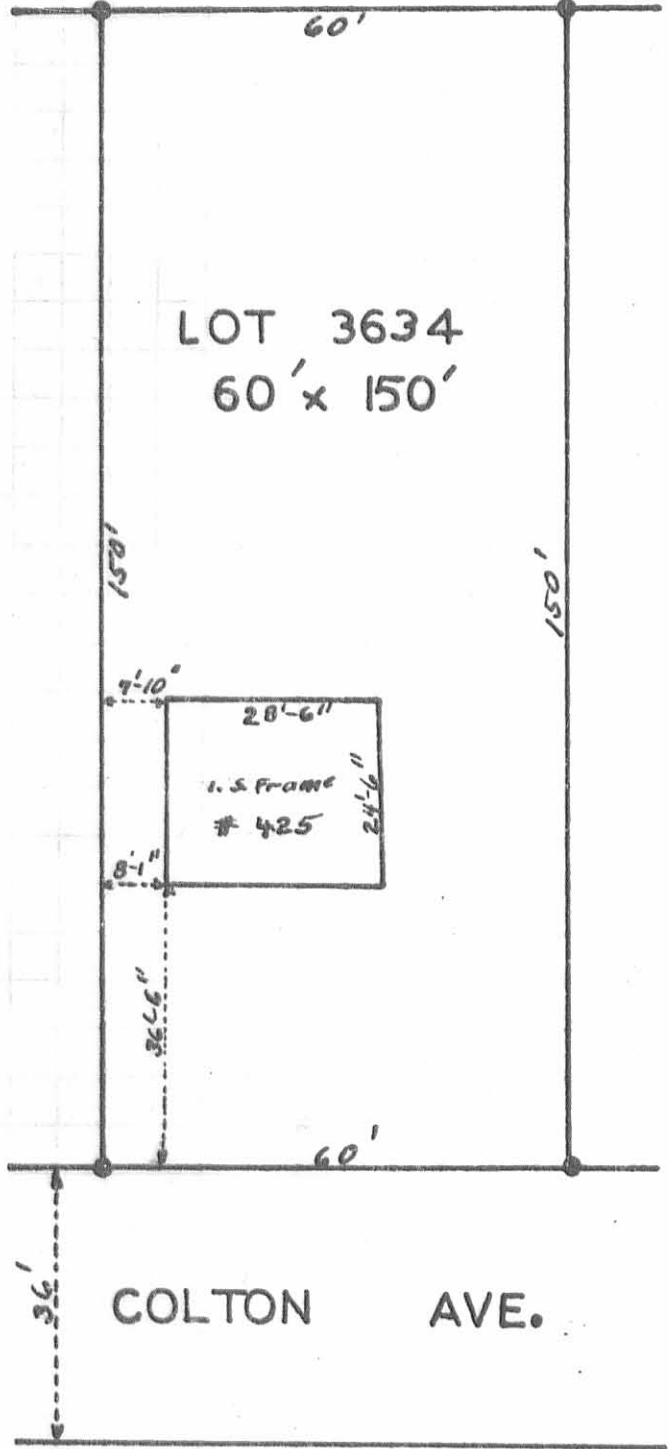

LOT 3634
60' x 150'

LOT 3634
KARUS ALLOTMENT

ELMORE SURVEY
BELLEFONTAINE OHIO
OCT. 1952 1" = 25'
F.F. WRIGHT

COLTON AVE.

● IRONS

*I find no encroachments
on lot 3634
May 25, 1953
Foster F. Wright*

INDEXED ON MAP
2047 3P