
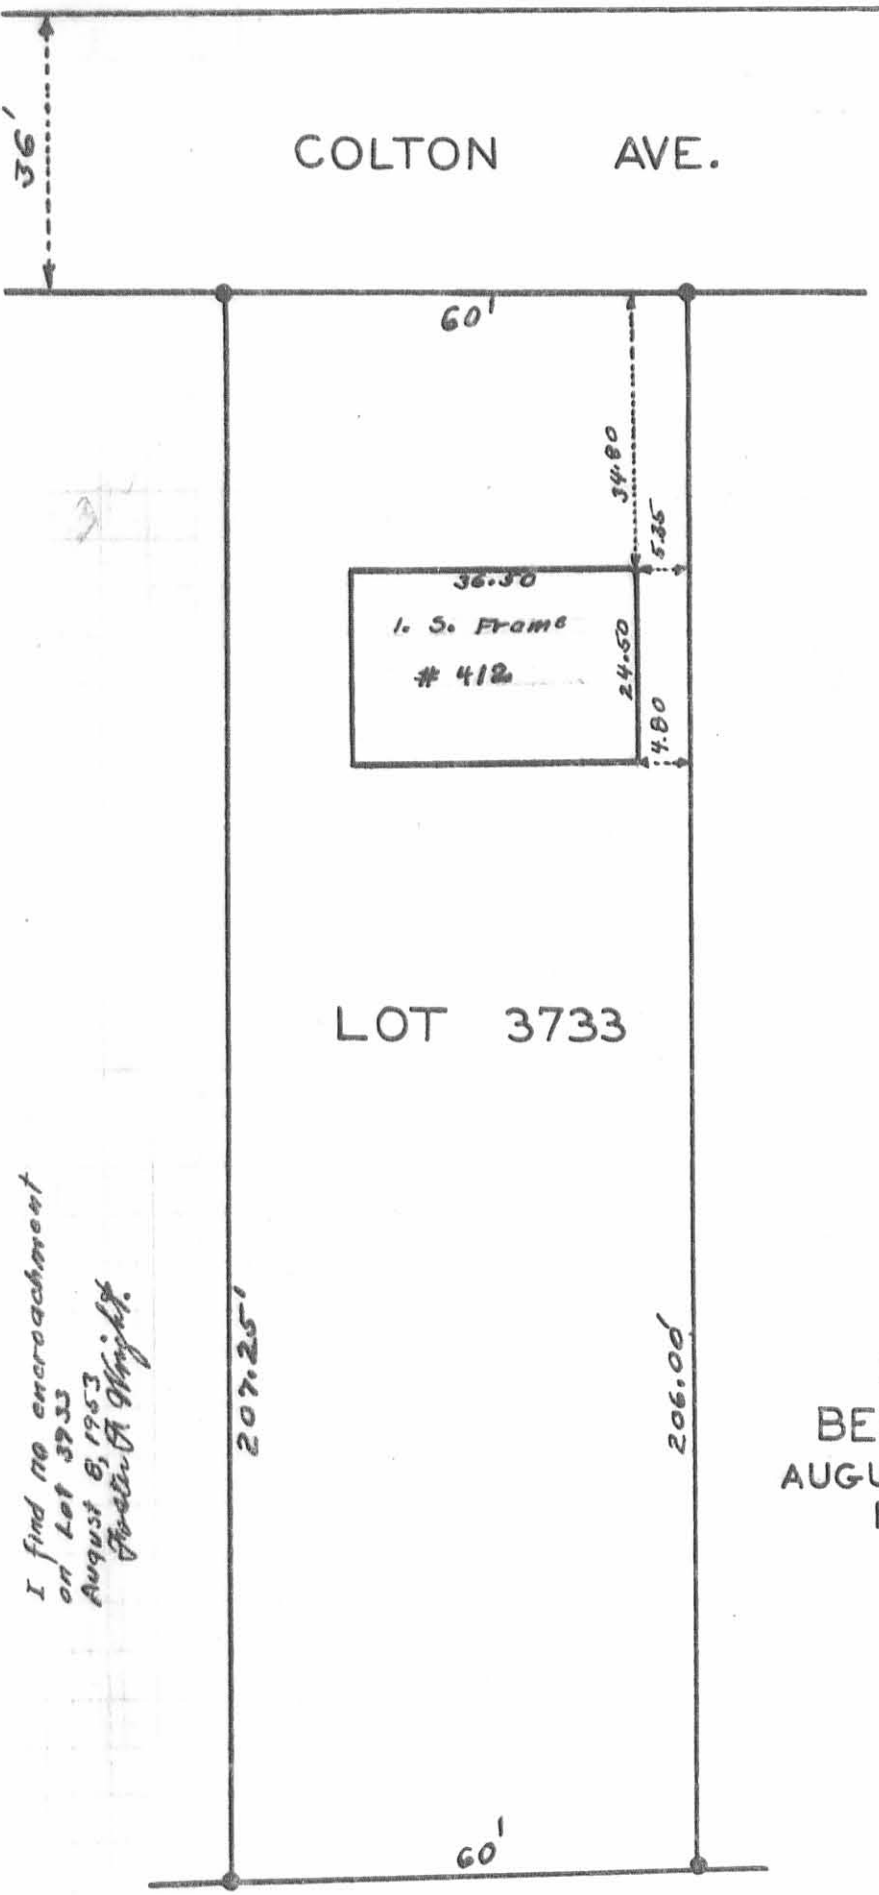


Book 274
Page 61

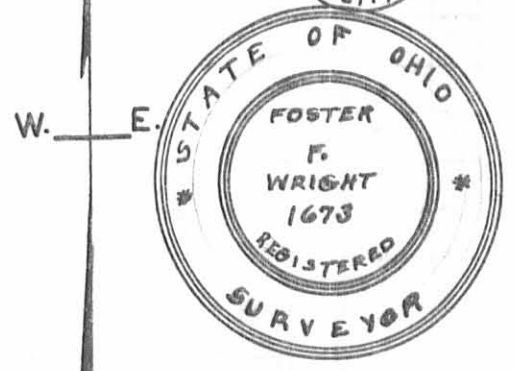

COLTON AVE.

LOT 3733


ELMORE SURVEY
LOT 3733
SHIELDS ALLOTMENT
BELLEFONTAINE OHIO
AUGUST 1953 1"=25'
FOSTER F. WRIGHT

*I find no encroachment
on Lot 3733
August 8, 1953
Foster F. Wright.*

● Irons

INDEXED ON MAP
2085 IP

INDEXED ON MAP
2085 2P

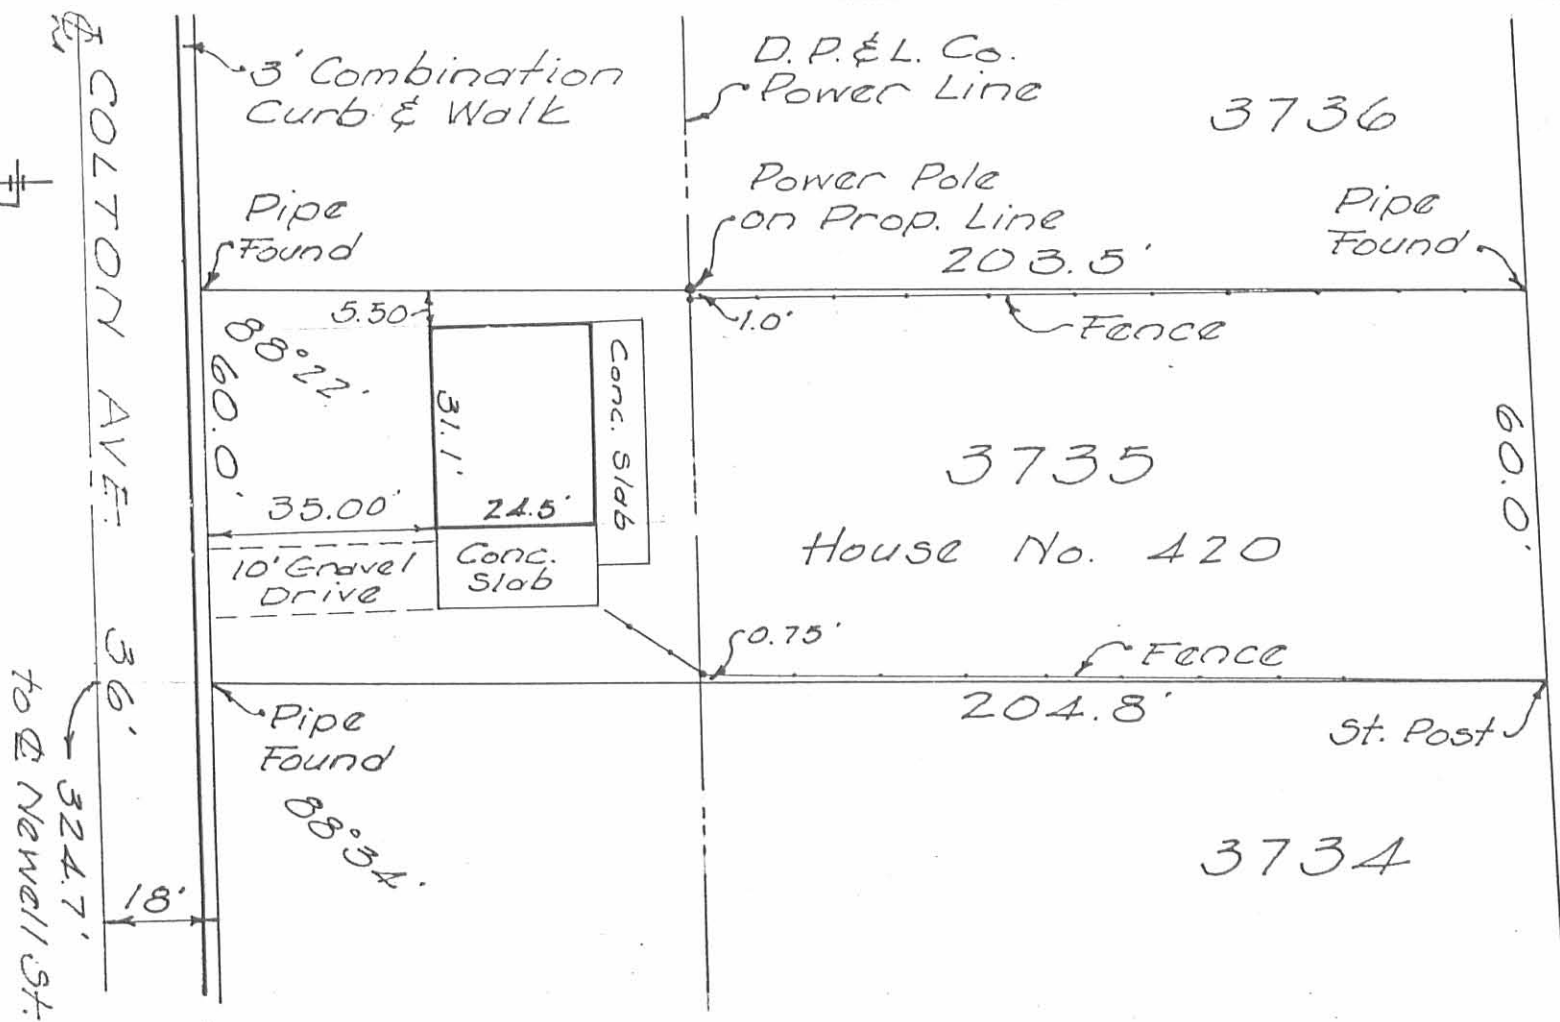

SURVEY OF LOT 3735
BELLEFONTAINE
LAKE TOWNSHIP
LOGAN COUNTY, OHIO
FEBRUARY 1, 1969
SCALE 1"=30'

I hereby certify that this plat is a correct representation of a survey made by me and that the same shows the improvements as located on the premises. The improvements are entirely within the property lines and there are no encroachments on the premises by improvements on the adjoining premises.


REFERENCE:
City Eng. F.B.
274/56

Dan L. Dodson
Dan L. Dodson
Reg. Surveyor 4270
Bellefontaine, Ohio

Book 274
Page 73



W. E.

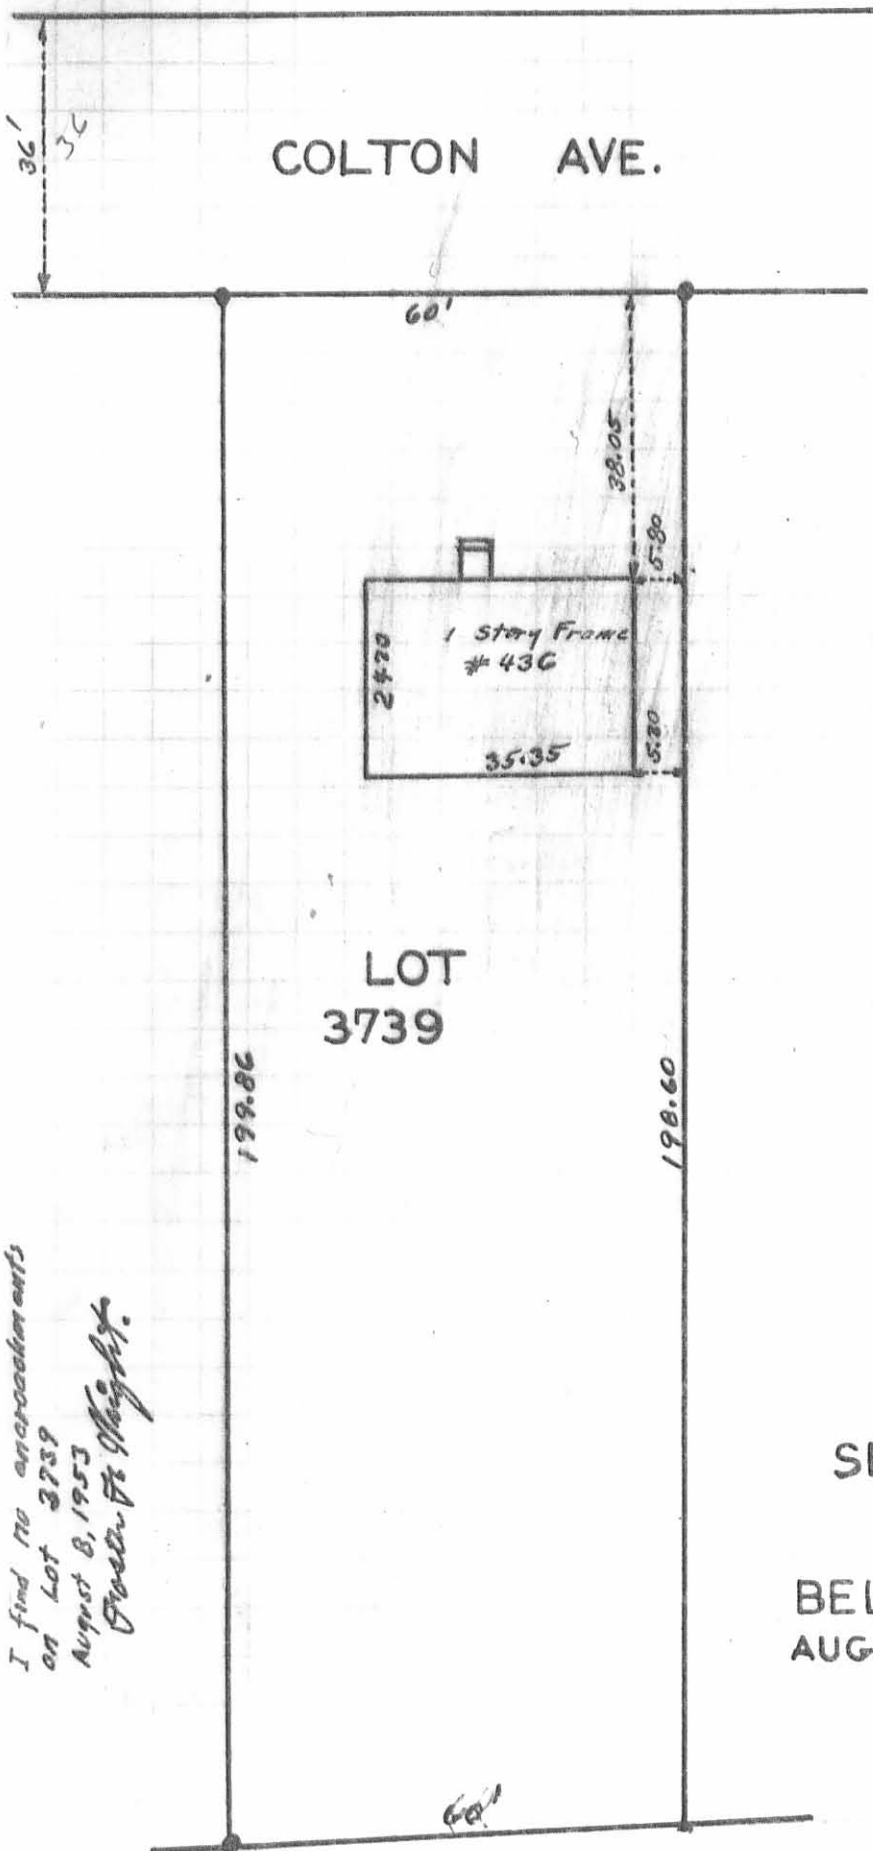

COLTON AVE.

LOT
3739

24.20
1 story frame
43G
35.35

199.86

198.60


ELMORE SURVEY

LOT 3739
SHIELDS ALLOTMENT

BELLEFONTAINE OHIO
AUGUST 1953 1" = 25'
FOSTER F. WRIGHT

*I find no encroachments
on Lot 3739
August 8, 1953
Foster F. Wright.*

INDEXED ON MAP
2085 3P

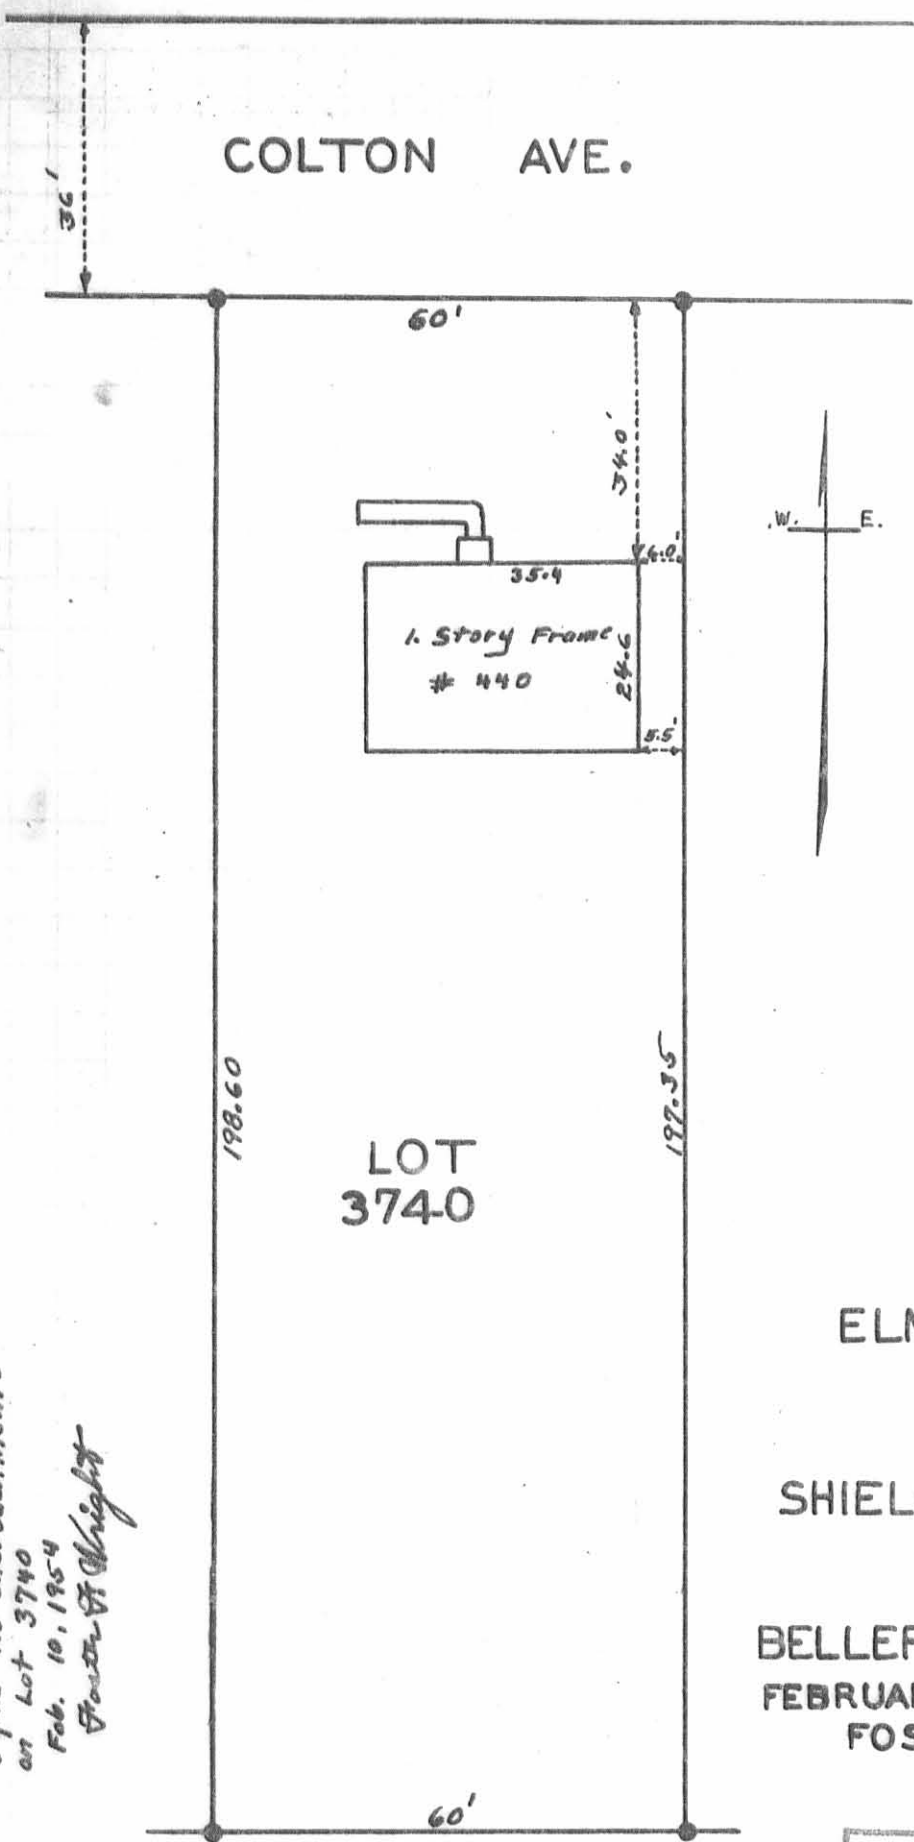

COLTON AVE.



W. E.

LOT 3740

ELMORE SURVEY

LOT 3740
SHIELDS ALLOTMENT

BELLEFONTAINE OHIO
FEBRUARY 1954 1"=25'
FOSTER F. WRIGHT

*I find no encroachments
on Lot 3740
Feb. 10, 1954
Foster F. Wright*


● IRONS

INDEXED ON MAP
2085 4P

Book 274
Page 73



COLTON AVE.

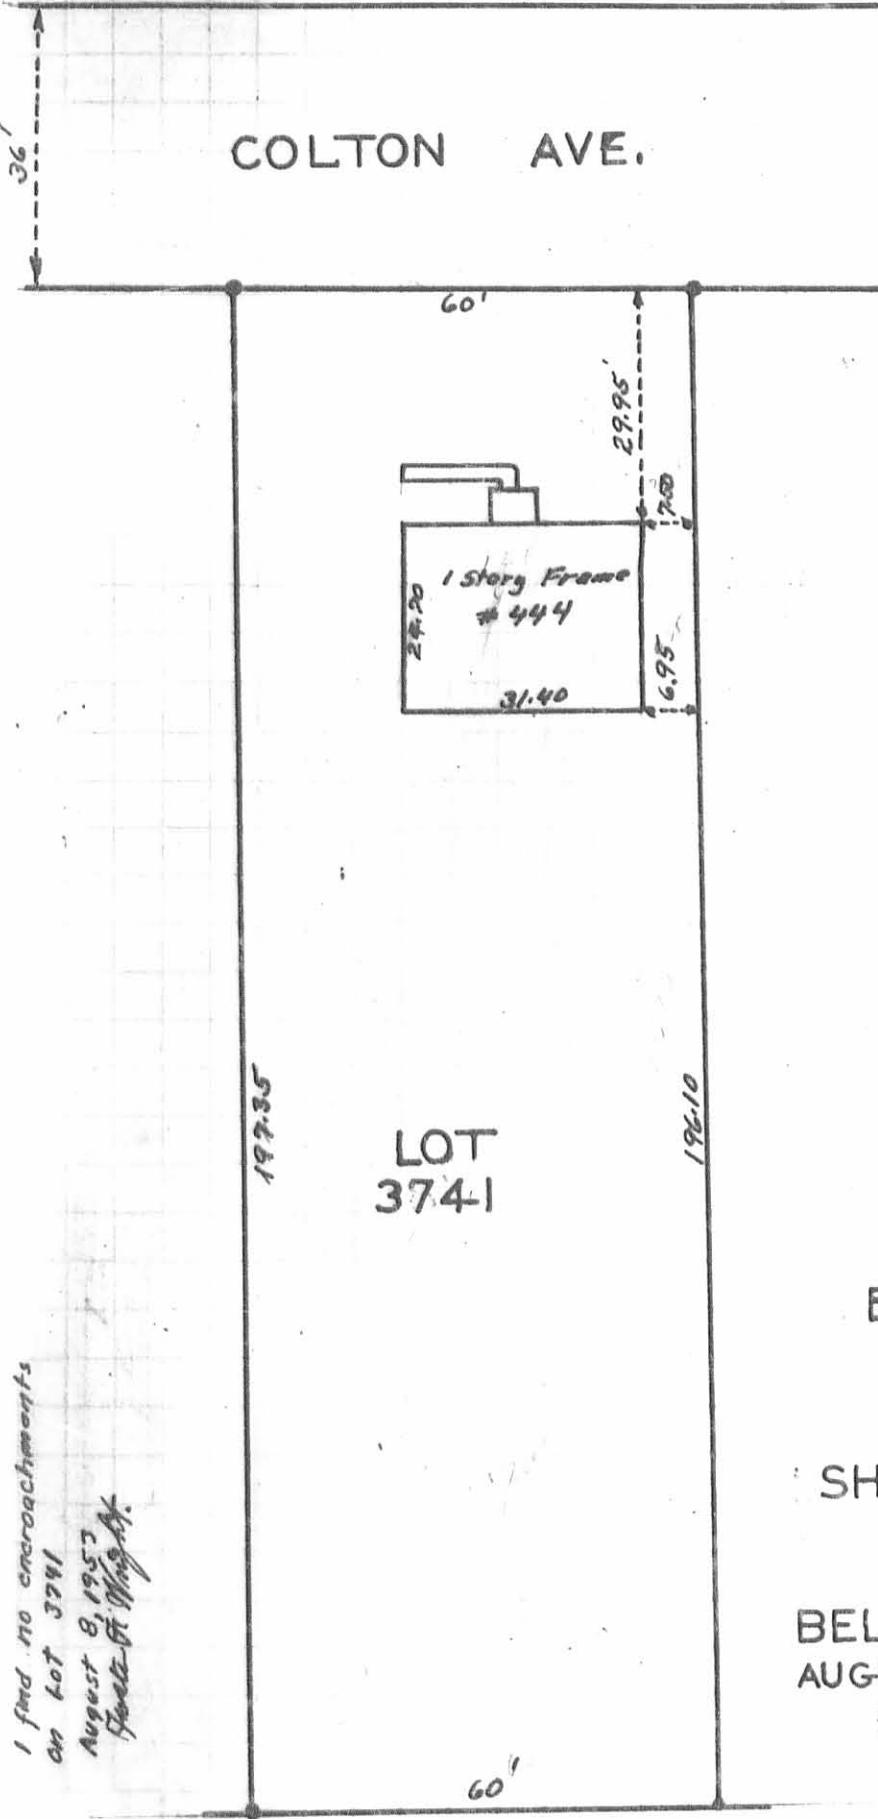

LOT
3741

ELMORE SURVEY

LOT 3741
SHIELDS ALLOTMENT

BELLEFONTAINE OHIO
AUGUST 1953 1" = 25'
FOSTER F. WRIGHT

*I find no encroachments
on lot 3741
August 8, 1953
Foster F. Wright*

INDEXED ON MAP
2085 5P

COLTON AVE.

Book 294
Page 61



W. E.




36'

60'

29.65

9.10

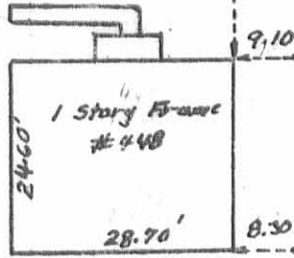

LOT 3742

196.10

196.10

194.85

ELMORE SURVEY

LOT 3742
SHIELDS ALLOTMENT

BELLEFONTAINE OHIO
AUGUST 1953 1" = 25'
FOSTER F. WRIGHT

I find no encroachments
on Lot 3742
August 8, 1953
Foster F. Wright

• Irons

INDEXED ON MAP
2005 LP

Book 274
Page 73



COLTON AVE.

W. E.



36'

60'

39.85'

6.00'

24.50'

5.60'

I. S. Frame
482

35.35'

201.05'

LOT
3738

199.80'

60'

ELMORE SURVEY

LOT 3738
SHIELDS ALLOTMENT

BELLEFONTAINE OHIO
NOVEMBER 1953 1" = 25'
FOSTER F. WRIGHT


*I find no encroachments
on Lot 3738
November 2, 1957
Foster F. Wright.*

INDEXED ON MAP
2085 7P

Book 274
Page 61





W. E.

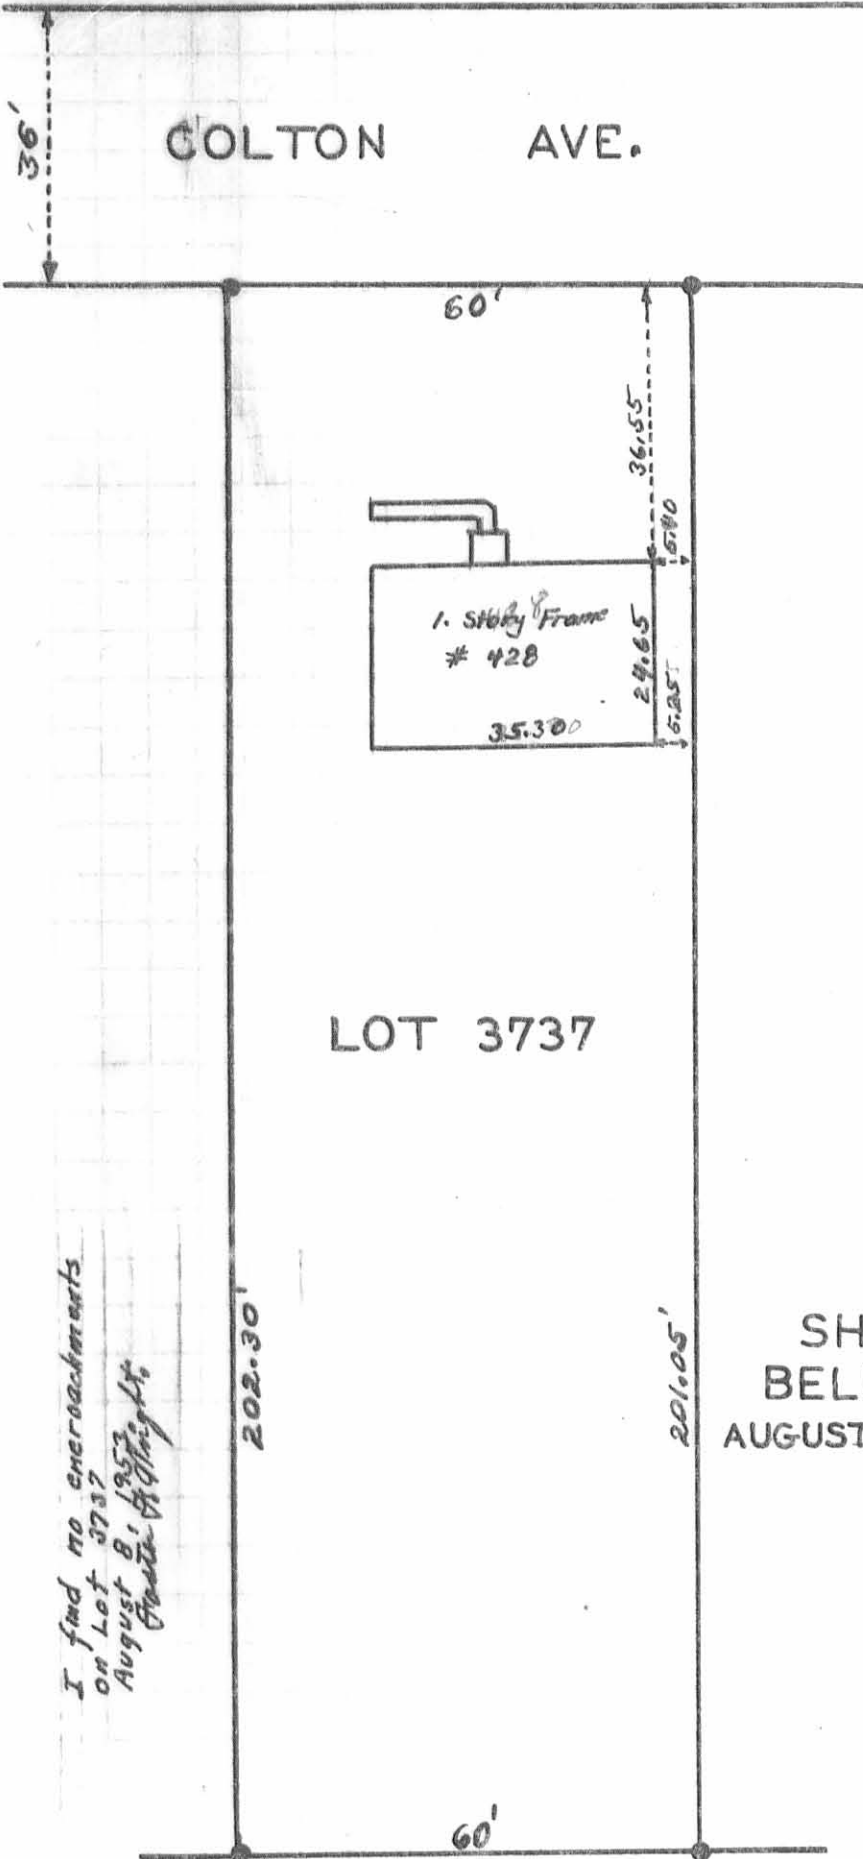

ELMORE SURVEY
 LOT 3737
 SHIELDS ALLOTMENT
 BELLEFONTAINE OHIO
 AUGUST 1953
 F.F. WRIGHT
 1" = 25'

INDEXED ON MAP
 2086 BP

Book 274
Page 61

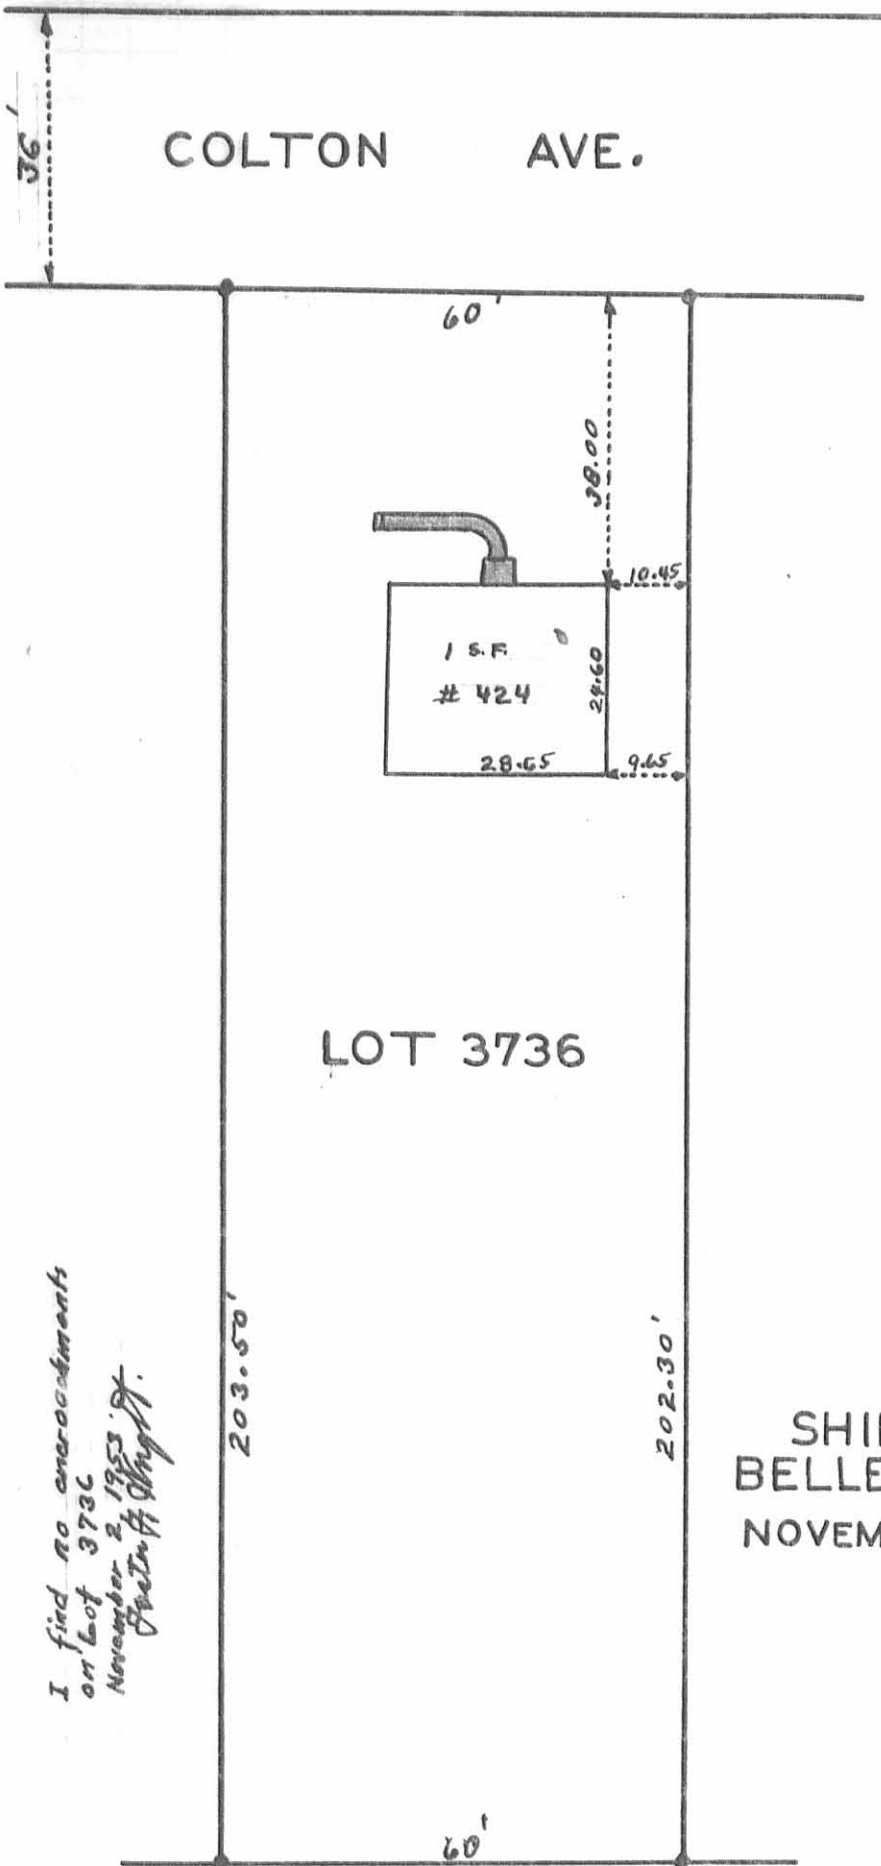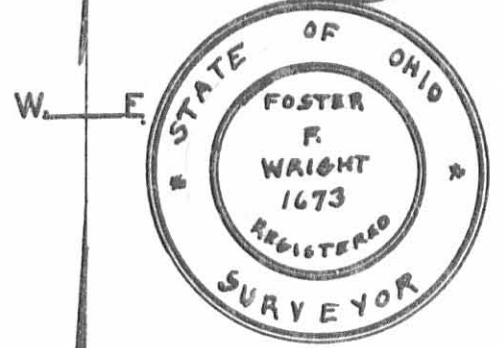

LOT 3736

ELMORE SURVEY


LOT 3736
SHIELDS ALLOTMENT
BELLEFONTAINE OHIO
NOVEMBER 1953
FOSTER F. WRIGHT

1" = 25'

*I find no encroachments
on lot 3736
November 2, 1953
Foster F. Wright*

● IRONS

INDEXED ON MAP
2085 9P

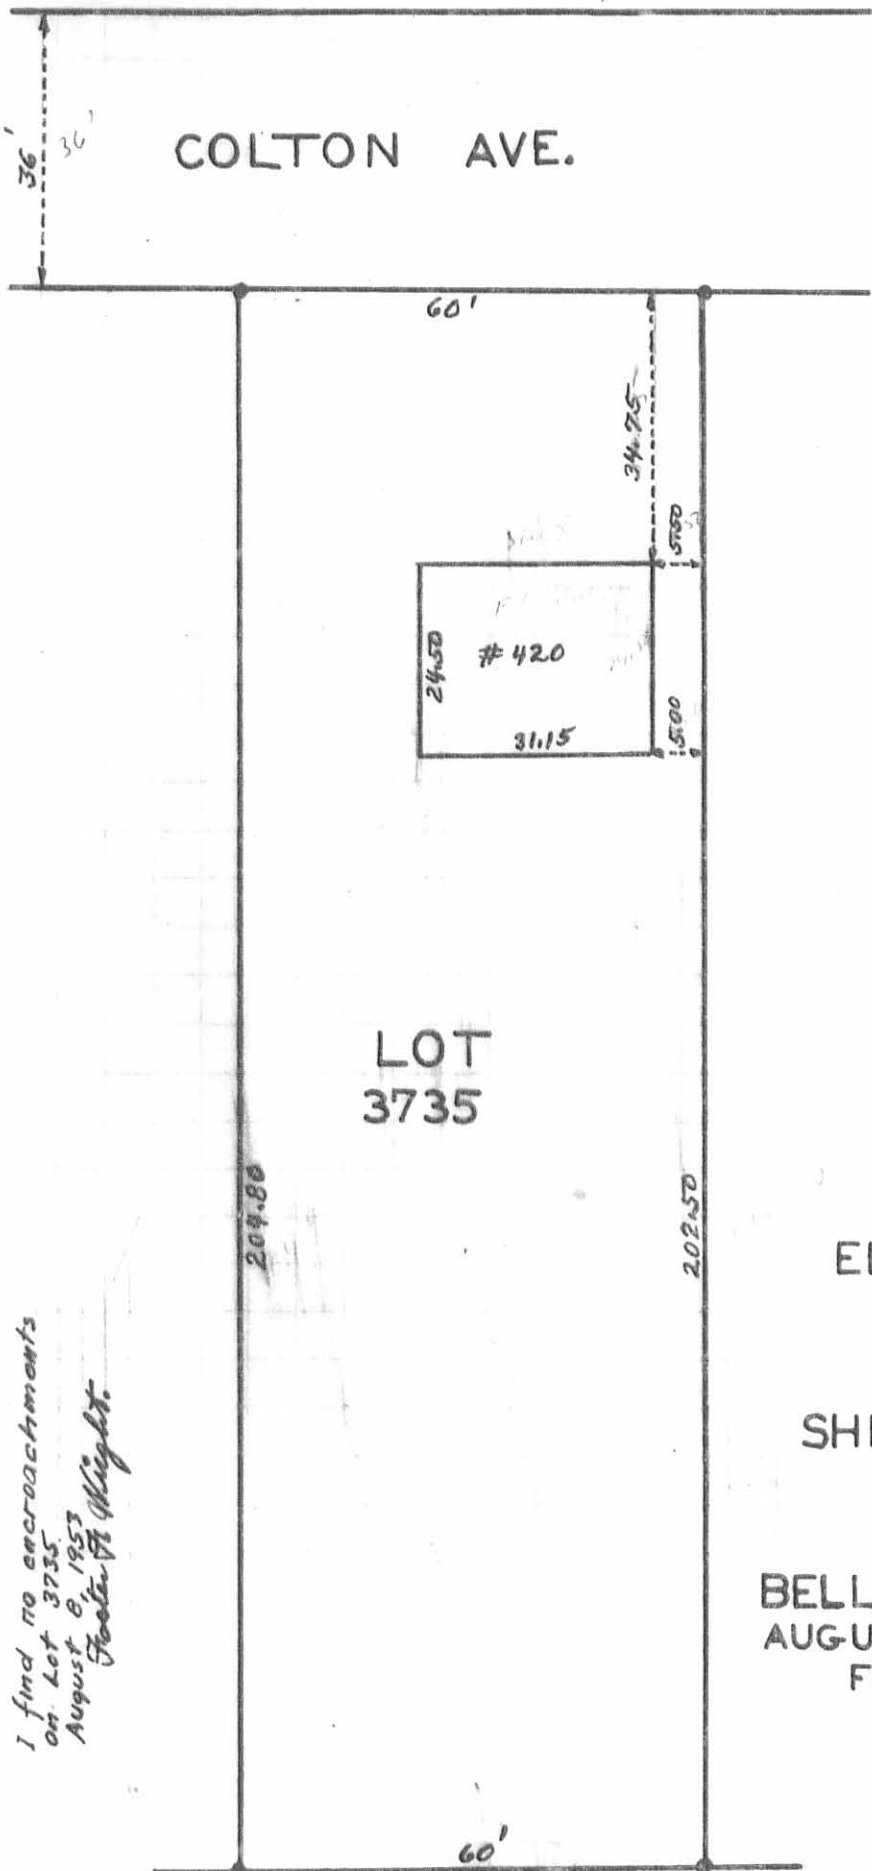

*I find no encroachments
on Lot 3735
August 8, 1953
Foster F. Wright.*

INDEXED
SS
881
CITY

Book 274
Page 61

W. E




LOT
3735

ELMORE SURVEY

LOT 3735
SHIELDS ALLOTMENT

BELLEFONTAINE OHIO
AUGUST 1953 1" = 25'
FOSTER F. WRIGHT


INDEXED ON MAP
208510P

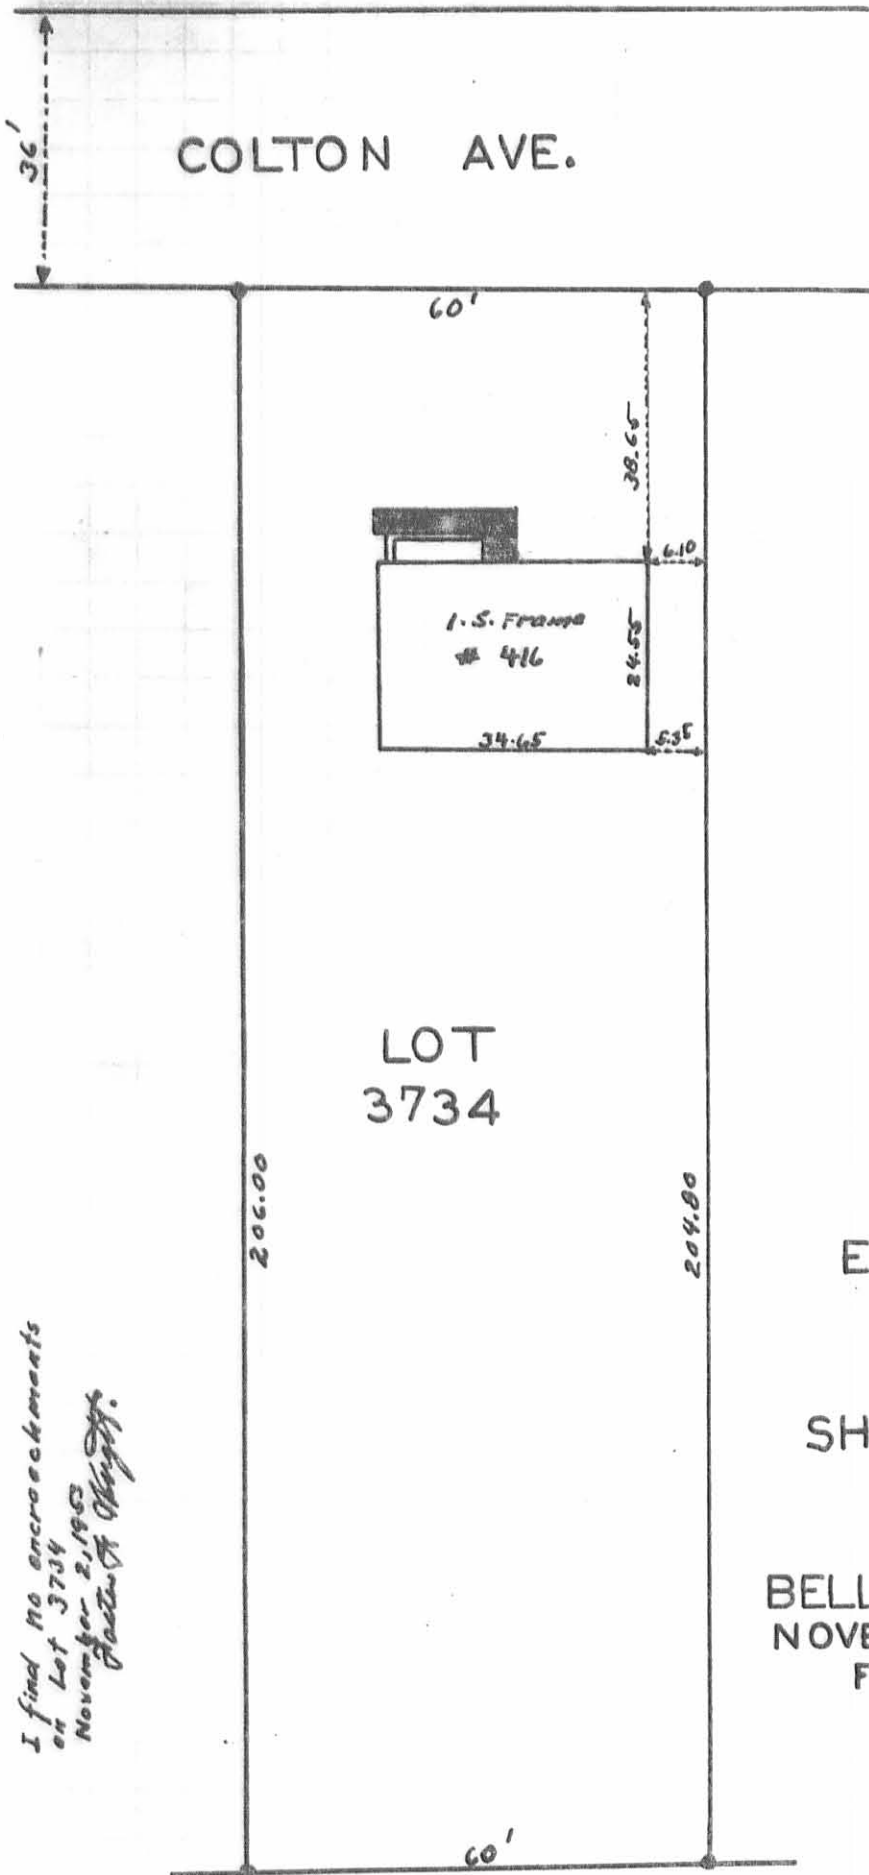

*I find no encroachments
on Lot 3734
November 2, 1953
Foster F. Wright.*

INDEXED
SS
881
C114

Book 274
Page 61

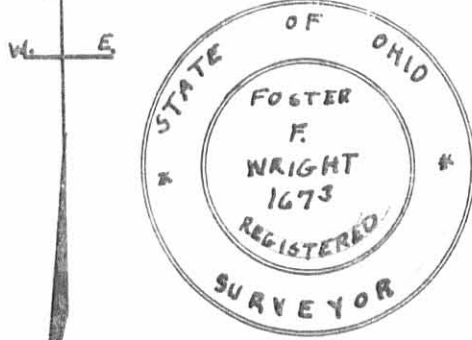


ELMORE SURVEY

LOT 3734
SHIELDS ALLOTMENT

BELLEFONTAINE OHIO
NOVEMBER 1953 1" = 25'
FOSTER F. WRIGHT

INDEXED ON MAP
2005 IIP

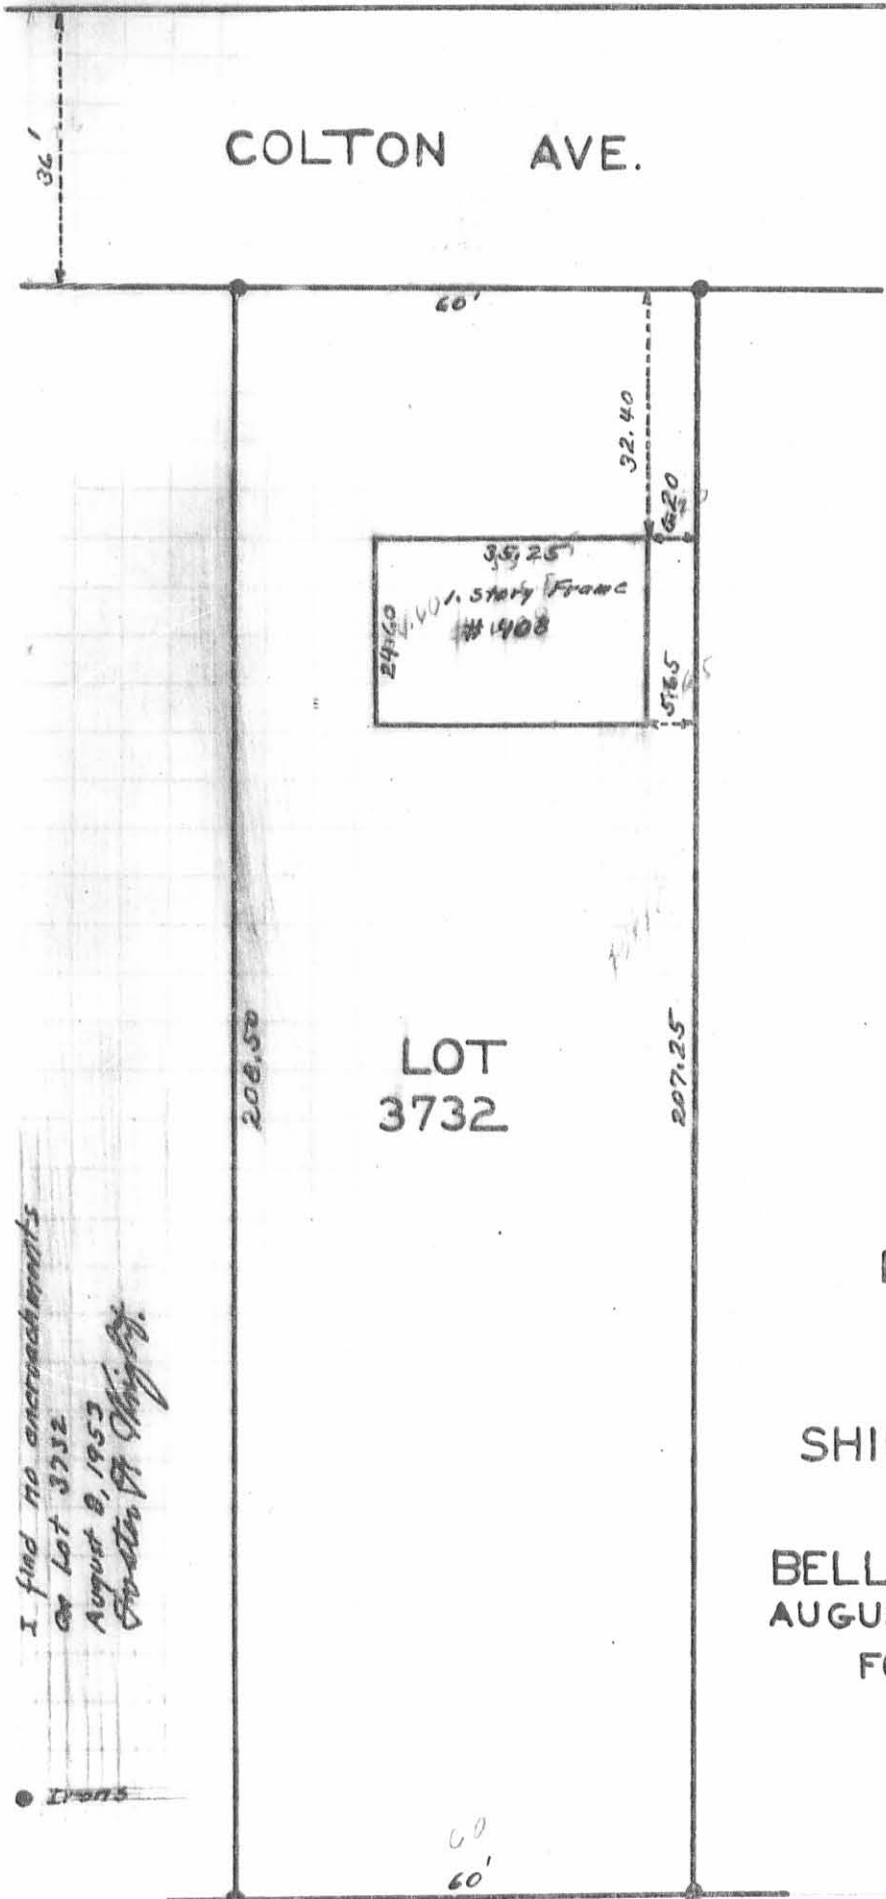

COLTON AVE.

LOT
3732

35.25'
24.60'
1.5 story frame
#1408

208.50

207.25

60'
60'

*I find no encroachments
on Lot 3732
August 8, 1953
Foster F. Wright*

Book 274
Page 61



ELMORE SURVEY

LOT 3732
SHIELDS ALLOTMENT

BELLEFONTAINE OHIO
AUGUST 1953 1¹/₂ 25'

FOSTER F. WRIGHT

INDEXED ON MAP
2085 12P