

REFERENCE:
 SPARKS ALLOTMENT NO. TWO.
 Plat Cab. A, Slide 310(8-23-1954).

INDEXED ON MAP
 2120 1P



Russell Survey-Lot No. 3763, Sparks Allotment No. Two,
 City of Bellefontaine, Lake Township,
 Logan County, Ohio.

SCALE: 1" = 20'	APPROVED BY:	DRAWN BY DEG
DATE: 7-26-2001		REVISED

Daniel E. Gilbert
 Daniel E. Gilbert, P.S.
 Reg. Sur. No. 5401

DRAWING NUMBER
 2001 - 019

Survey of Lot # 3760
 Sparks Allotment # 2
 Bellefontaine, Ohio

A = $\frac{3}{4}$ " pipe found - Wit. N.E. cor. garage N.W. 50.20'
 Conc. Drive North 18.23' - N.E. cor Brick &
 Stone House S.W. 52.60

B = $\frac{3}{4}$ " pipe Set - Wit. S.E. cor. Bok. house N.W. 52.77'
 N.E. cor. Bok. house S.W. 57.35'

C = $\frac{3}{4}$ " pipe Set - Wit. S.E. cor. Bok. house, N.W. 52.65'
 N.E. cor. porch, frame house, S.W. 62.25'

D = $\frac{3}{4}$ " pipe found - Dist meas. A to D =
 469.70' - ok

E = $\frac{3}{4}$ " pipe found

F = $\frac{1}{2}$ " pipe found, 12" deep, set $\frac{3}{4}$ " pipe flush
 Wit. S.W. cor bok house N.E. 52.90,
 N.W. cor frame garage S.E. 36.05'

G = $\frac{3}{4}$ " pipe found - elec. pole 1 $\frac{1}{2}$ ft. on line

H = $\frac{3}{4}$ " pipe Set

J = $\frac{1}{2}$ " pipe Set

K = pipe found

L = pipe found


INDEXED ON MAP
 2120

Dodson
 Gilbert

Sept. 14, 1957

Reservoir Rd. 30'

23

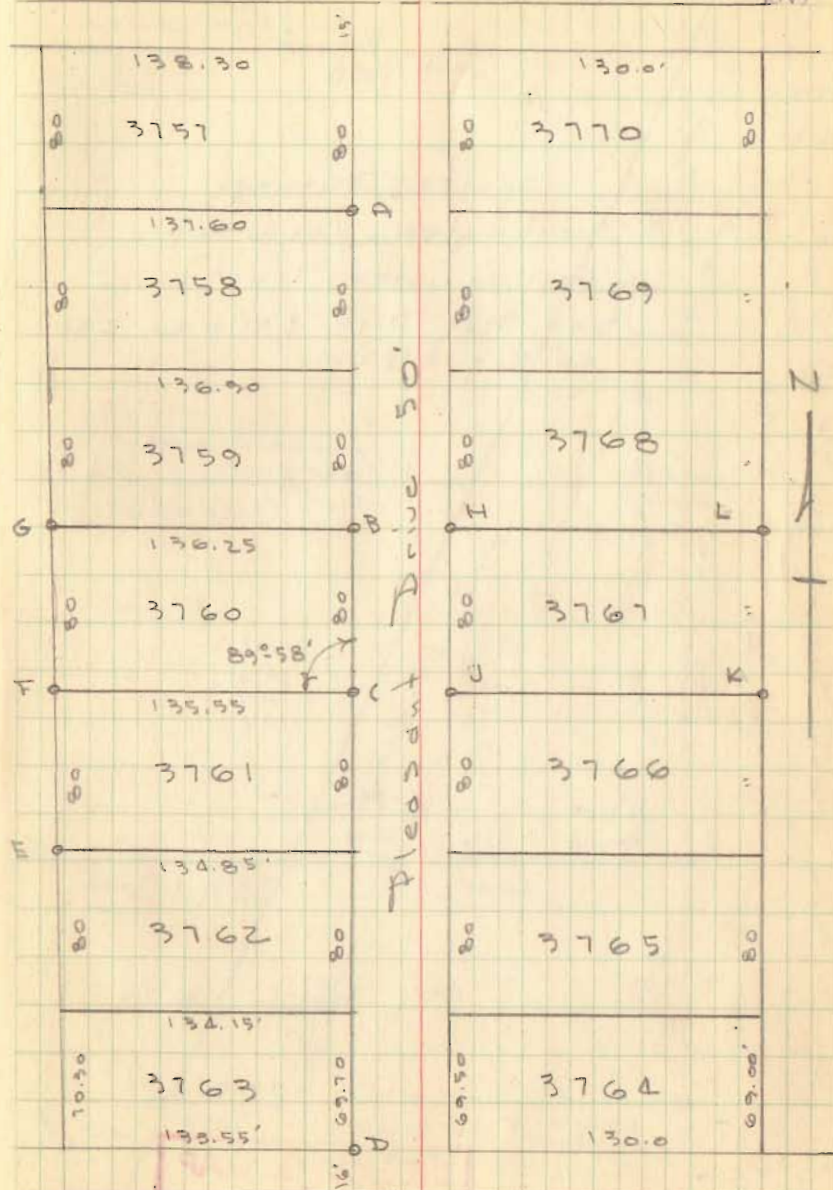

Welmer Ave. 26'

W
E

SURVEYORS CERTIFICATE

This Plat correctly shows SPARKS ALLOTMENT NUMBER TWO in V.M.S. 4478 in Bellefontaine, Lake Township, Logan County, Ohio. All measurements are in feet and tenths. Street widths are shown. Survey made June 1954. Area in the fourteen lots 3.37 Acres. Area in Pleasant Drive 0.63 Acre. Total Acres 4.00

Foster F. Wright
Registered Surveyor No. 1673

DEDICATION

Know all men by these presents that Ruric C. Sparks proprietor of the land indicated on the accompanying plat has authorized the laying out of the same. The Streets are hereby dedicated to the public use forever.

Foster F. Wright
Witness

R.C. Sparks

James W. Wilgus
Witness

STATE OF OHIO COUNTY OF LOGAN SS:

Be it remembered that on the 3rd day of August in the year One Thousand Nine Hundred and Fifty Four before me a Notary Public in and for said County came R.C. Sparks grantor in the foregoing dedication and acknowledged the signing to be his voluntary act.

Thelma J. Davidson
Notary Public
Logan County Ohio
My Commission Expires
October 5, 1956

The annexed plat was adopted by Ordinance as an Addition to the City of Bellefontaine, State of Ohio by the Council at a regular meeting on the 9th day of August 1954 Ordinance Number 2269

James B. West
Clerk of Council
R. Robert Hill
President of Council

AUDITORS OFFICE LOGAN COUNTY OHIO


The lots shown were transferred the 23rd day of August 1954 A.D.

Thomas Longbrake
Auditor of Logan County

RECORDERS OFFICE LOGAN COUNTY OHIO

Received for record at 3:44 O'clock the 23rd day of Aug. 1954
Recorded _____ 1954 in Vol. C Book 3 Page 92

Rouven L. Strayer
Recorder of Logan County Ohio.

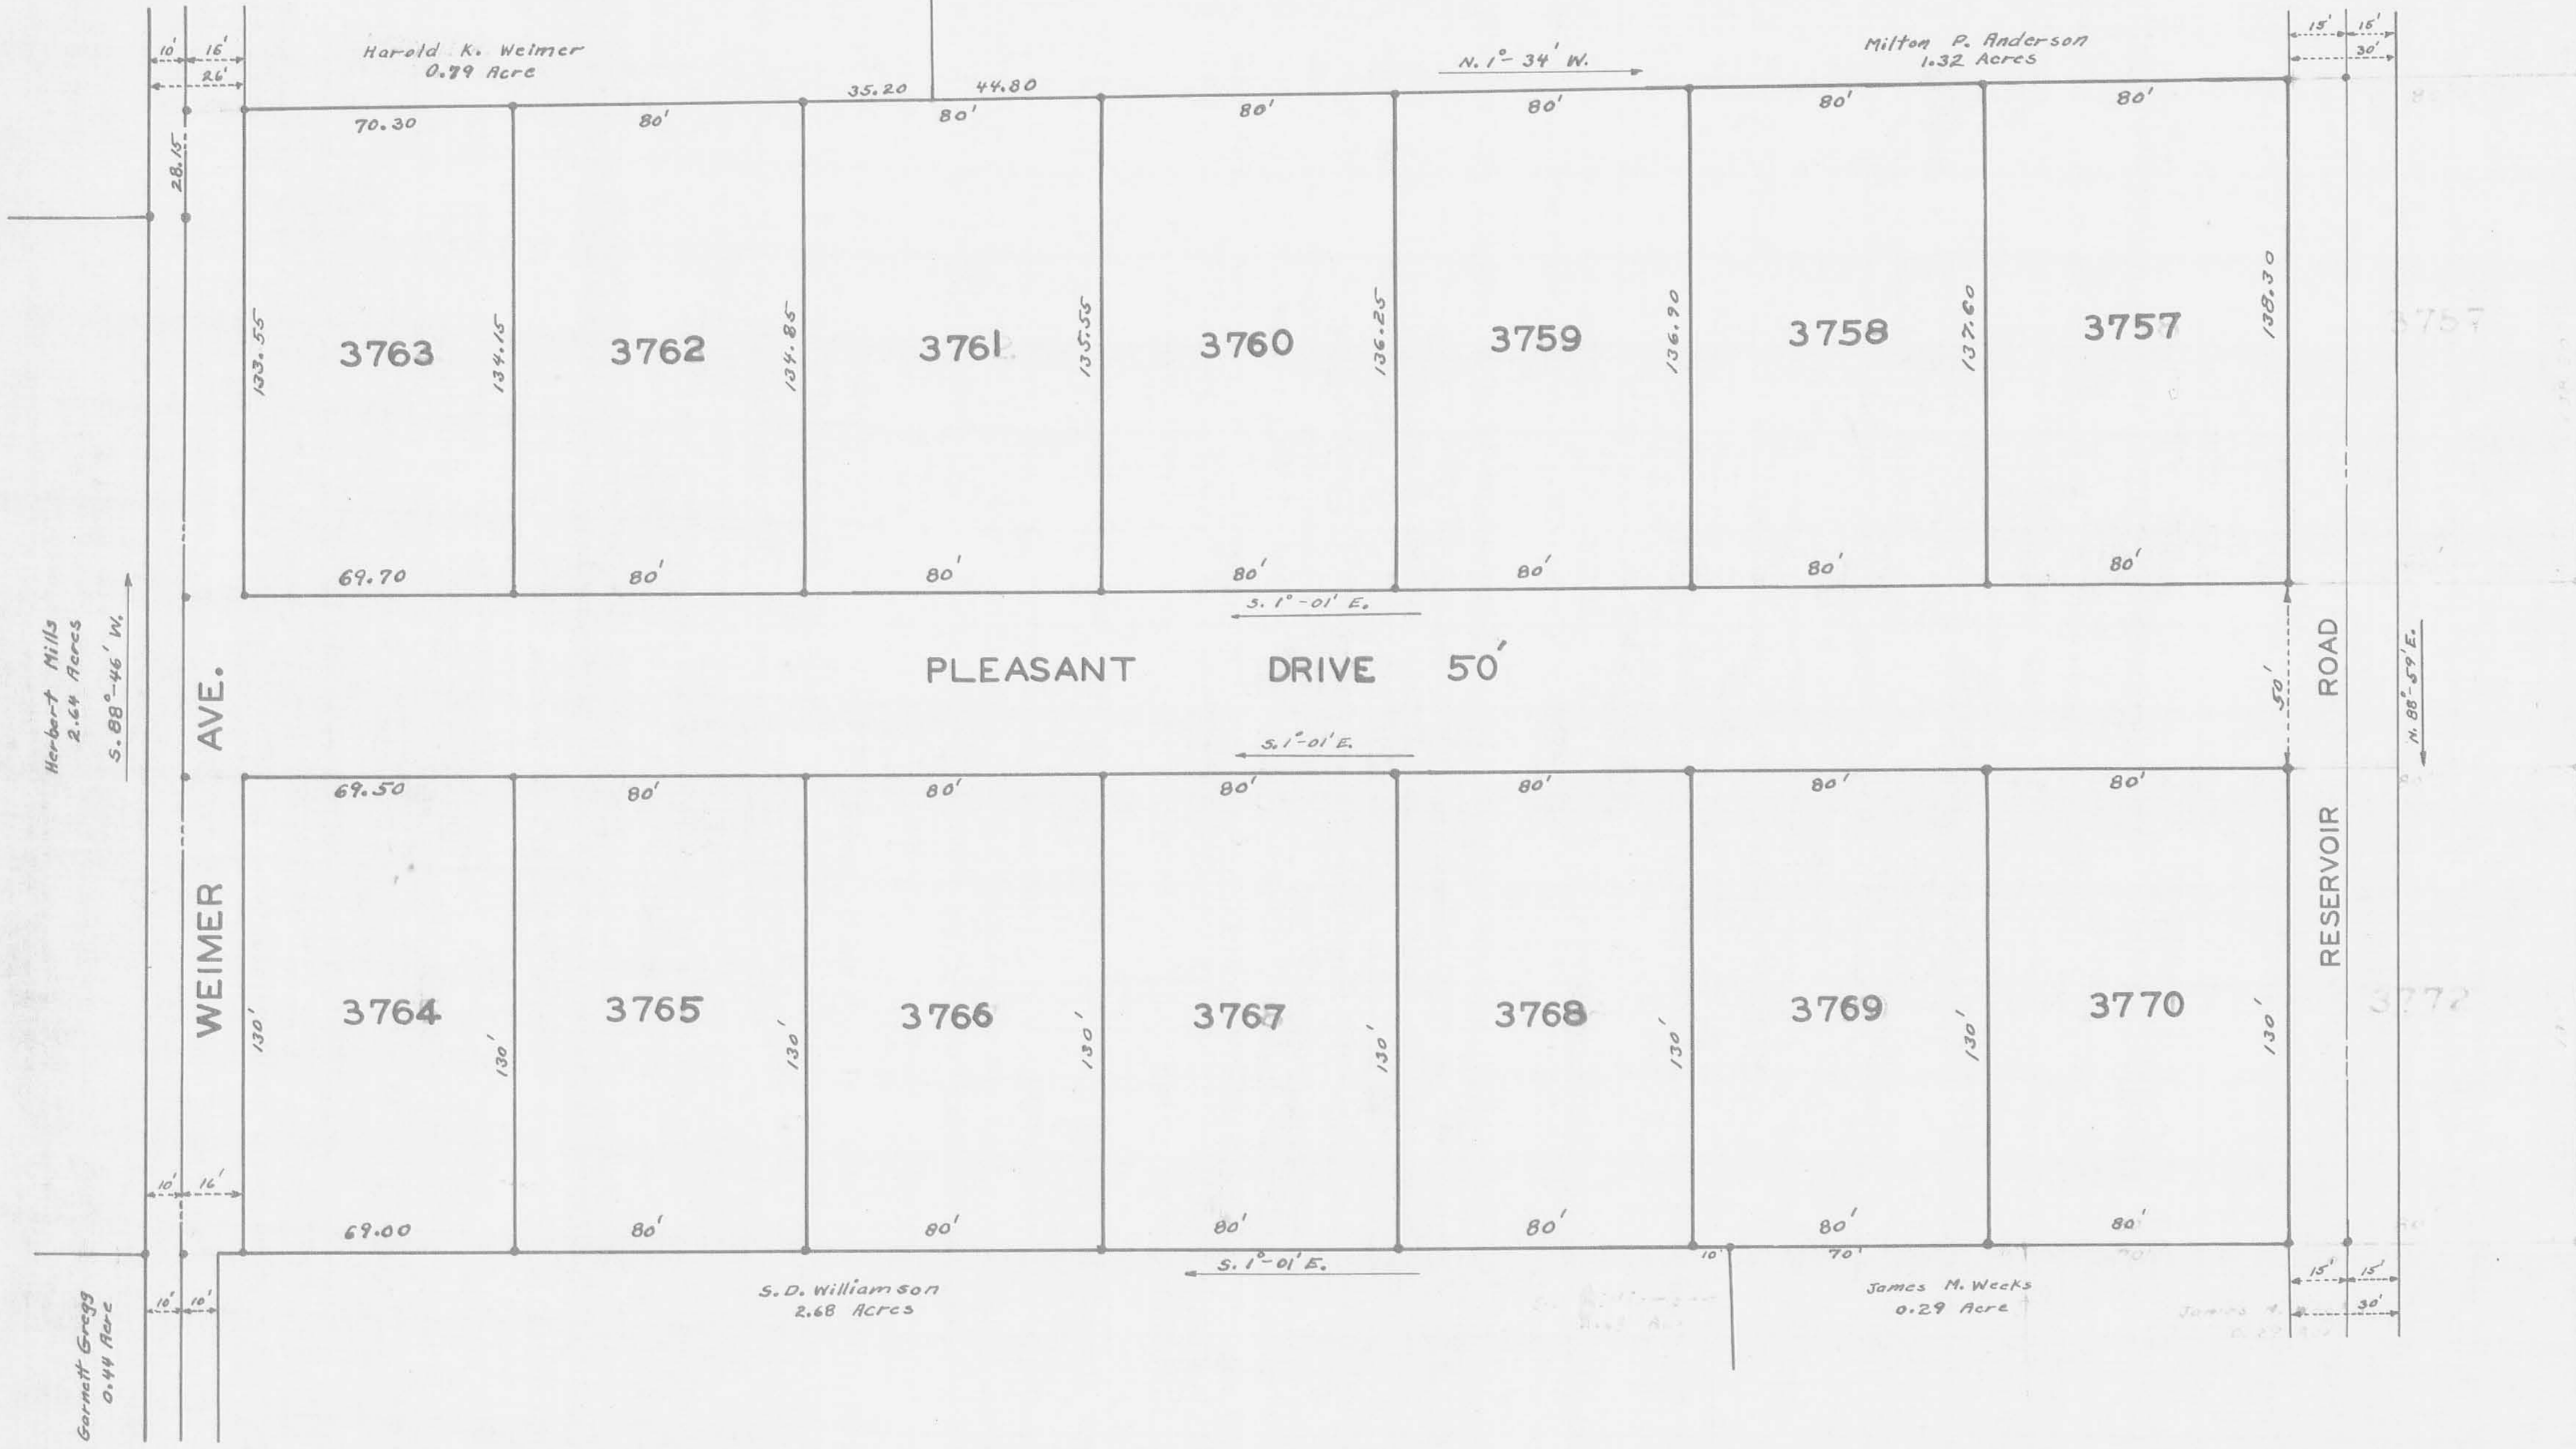

SPARKS ALLOTMENT NUMBER TWO

BELLEFONTAINE LAKE TOWNSHIP

LOGAN COUNTY OHIO

V.M.S. 4478

JUNE 1954

1" = 30'

• indicates Irons



JJ-78

JJ-78

A-110