

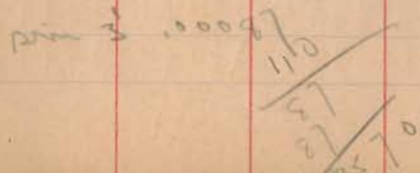


Survey for N. Q. Bureau
 Part of 134-4-14
 Corner of Main and Water Sts

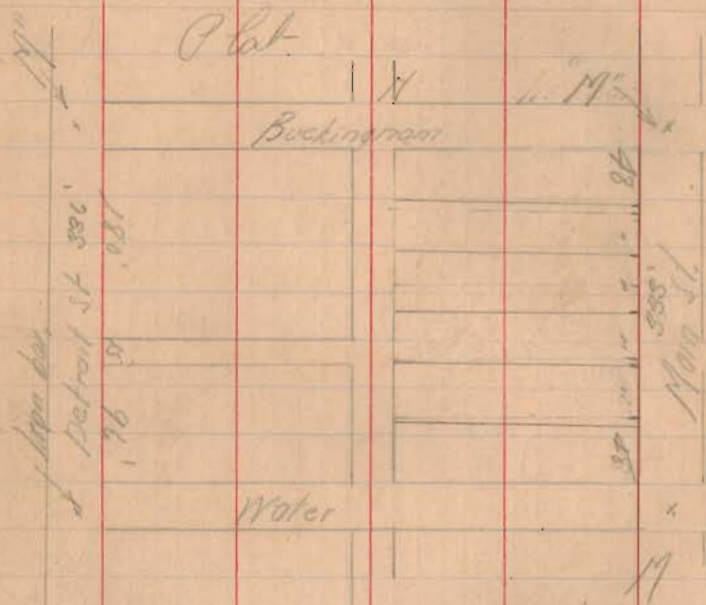

Survey

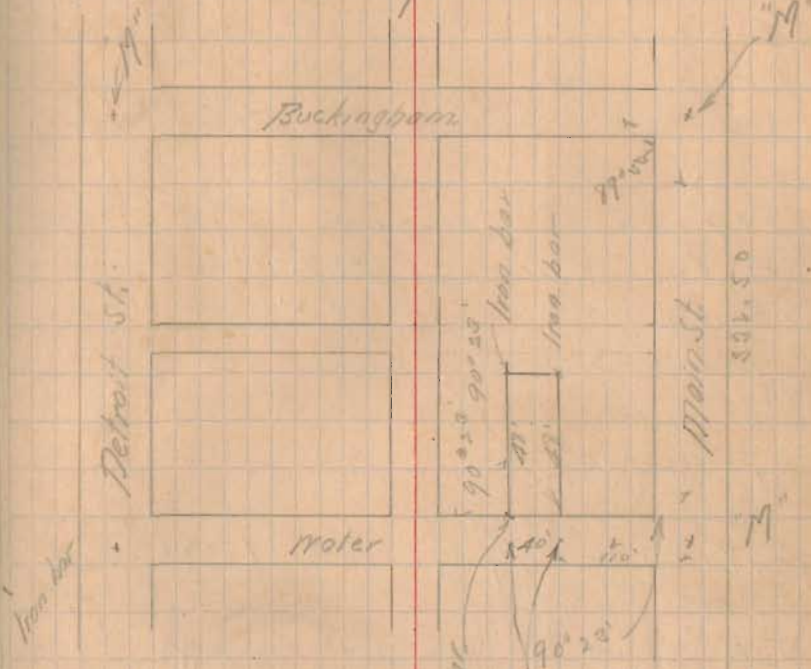

INDEXED ON MAP
2167

INDEXED ON MAP
 78

