


Survey for Frank Calland  
Surveyed as shown

Notes taken from survey by  
S. A. Buchanan. Book A-1  
page 146 - City Engineers Office  
1920

Also Field book 187 p. 106  
" " 184 p. 85  
City Engineers  
Office

C. A. Inskeep 4/10/43 73  
J. H. Inskeep

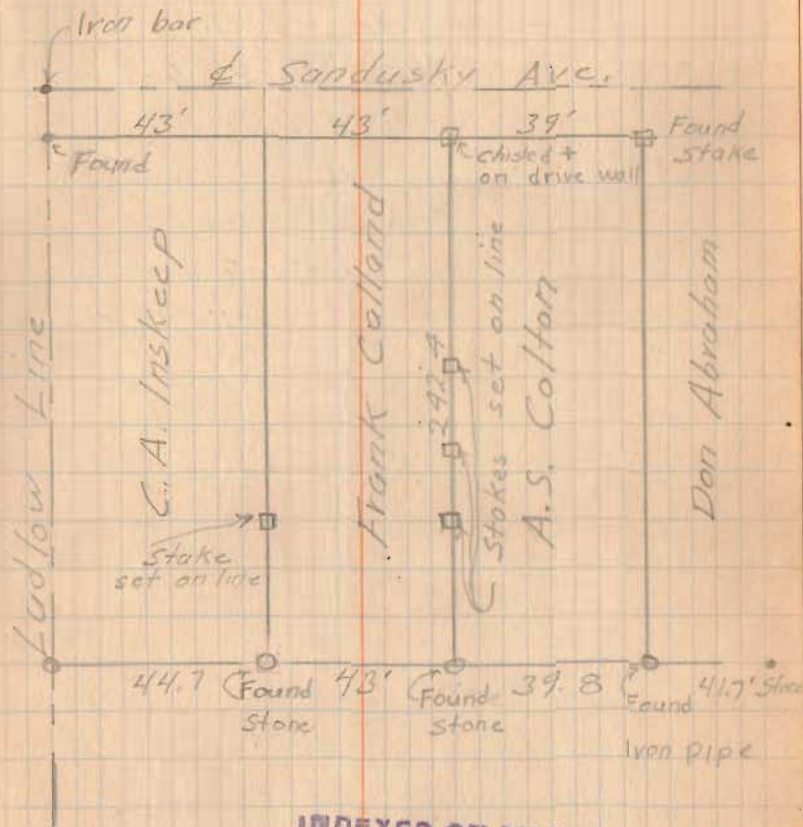

2252