


Survey for Joe Wolf
Part of X.M.S. 4990 of
the S. side of E. Sandusky
between the Ludlow Line
and Green St.

See City Engineer's Book 184
Page 85 and Book 187, Page 107

- A - Found 3" x 5' limestone + on top (SAR)
- B - Found old stake (set pipe)
- C - set pipe
- D - Set pipe
- E - Found old stake
- F - Found sq. stone Δ top.
- G

G. Inskip July 24, 1927

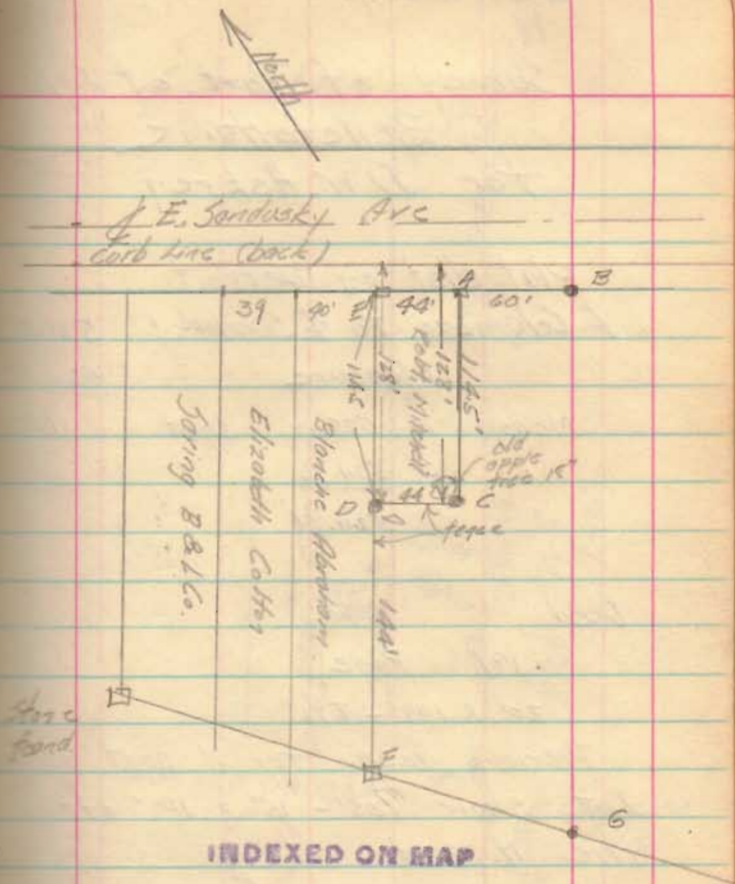

2271