

For. O.L. Jahnstger
Belleville Mo.
CAL. 11/27
G.C.I.

Survey of Part of

Lots 52 and 57

BM	2076	48.35	19.89
		5.31	77.04
		6.03	76.32
		9.15	72.90
		9.78	72.57

"A" set pipe 30' W & Detroit St
and 110' N. N.E. cor Askrey
(Gorges) Bldg. See page 38 this Book

"B" Tel conduit at corner

"C" Angle in Horn Bldg See
Page 47 this Book
Page Book to

D. N.E. cor brick bldg set as
surveyed Page 38 this book

Wells corner

11' } S of 14 line or S line of
59
88.5


4 1/2' or Detroit between Cols and Sand

Sidewalk N.E. cor Lot (prop line)

Curb

Sidewalk 110' S N.E. cor Lot (prop line)

Curb 110' " " " "

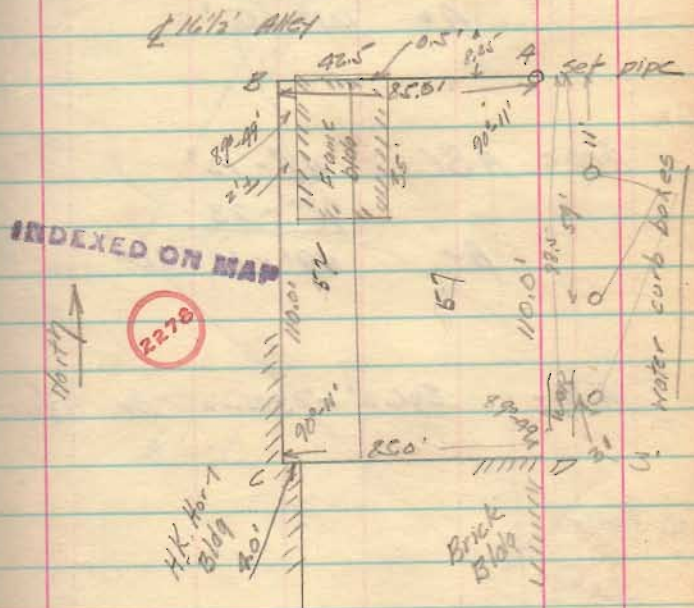

width between curbs 32' brick paving

at sidewalk 5' 1/2' ft. from prop line

3' Gas main ± 12' W & E

8" water in & of Cols 6.8' E of & of Sandstone