
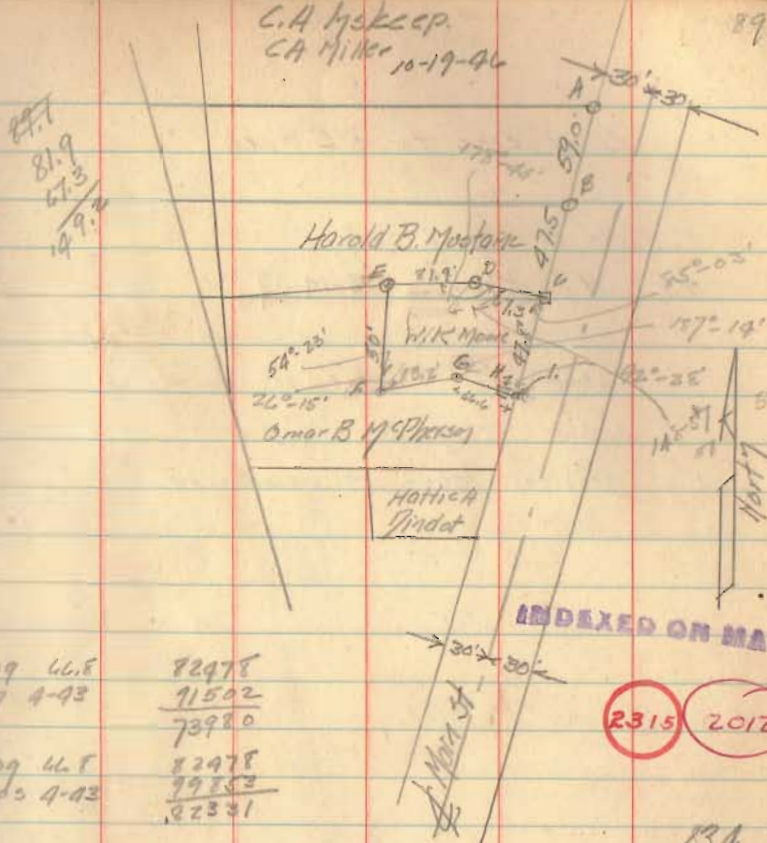


88  
 109.2  
 47.3  
 21.9

Survey VMS 5245  
 Bellefontaine, Ohio  
 Estate of W.K. Moore


- A 1/2" pipe (found)
- B 1/2" pipe (found)
- C Bolt with sq. head (found)
- D 3/4" pipe (found)
- E 3/8" iron bar (30") 11.9 from D so from F

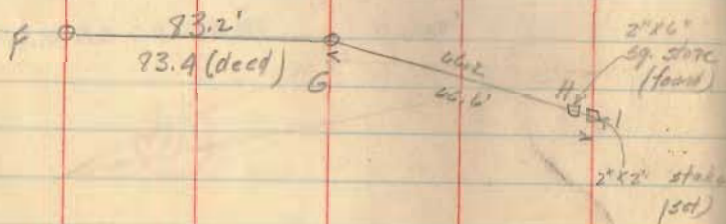

log 46.8      82978  
 sin 4-43      91502  
                   73980

log 46.8      82978  
 cos 4-43      99753  
                   82331

23.4  
 46.8  
 149.6  
 46.6  
 83.0

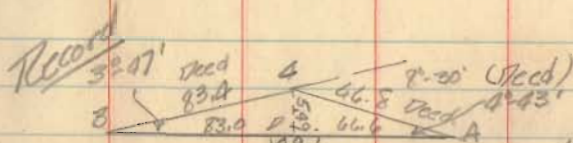

log 16.6      132011  
 tan 4-15'      2.77104  
                   0.09117

log 150      2.17609  
 1/2(A-B)      7.91408  
 1/2(A+B)      0-25'  
 4-15'      4-43'  
 A =      3-47'  
 B =

1-43  
 3-47  
 8-30 ✓

log 46.8      1.92478  
 sin 8-30'      9.16970  
                   0.99448  
 sin 3-47'      8.81904  
                   2.17504

149.6