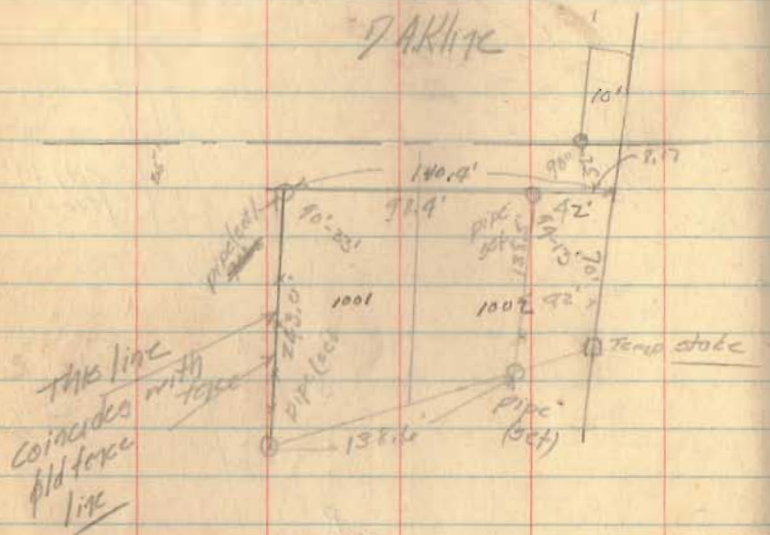


15A

91
-32
141Lots 1001-1007
for
DARKLINE

Staked as shown above

142

155

