

34


CA M'steep
G.H. Korman 10/2/48 Cloudy
Cool

Part of rms 1399
Lake Trip, Bellefontaine
for
Holmes Kress

6+82

Appex. Line 9990-9399

35

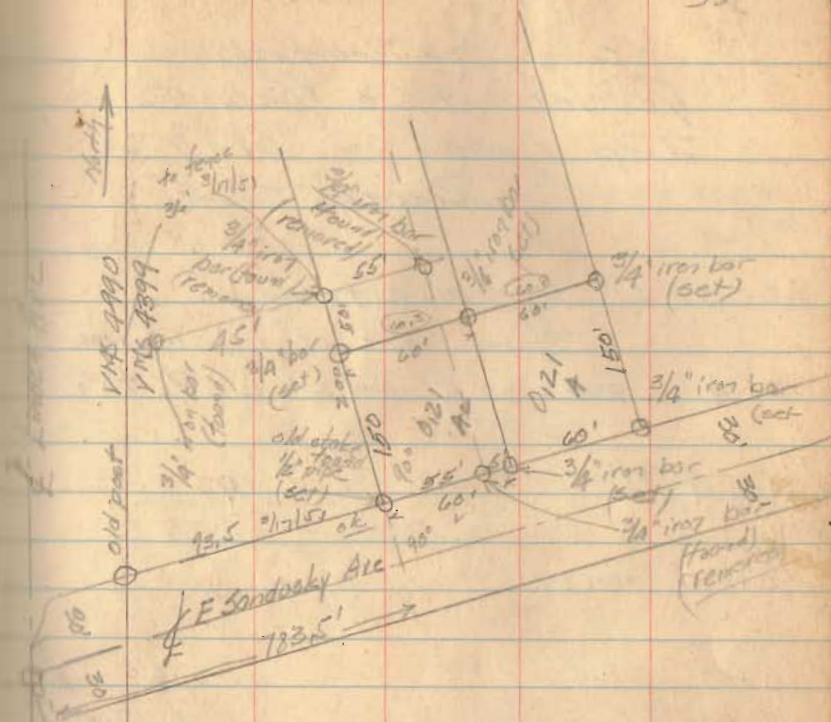

Iron bar & Linden and Sandusky (found)

INDEXED ON MAP

2360