



- A - C.I. Mon. Box - Chisel marks
- B - Nail
- C - 1/4" Pipe Found
- D - Nail
- E - 3/4" Pipe Found
- F - Nail
- G - 3/4" Pipe Found
- H - 3/4" Pipe Found
- I - Nail
- J - Nail
- K - 3/4" Pipe
- L - Nail
- City Book 330 Page 50
- City File 55-776
- File FW-264

**DULIN SURVEY**  
**BELLEFONTAINE OHIO**  
**LAKE TOWNSHIP**  
 SECTION 35 TOWN 4 RANGE 14  
 JUNE 1959

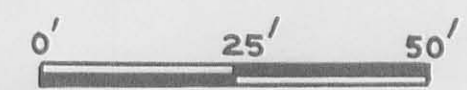

INDEXED ON MAP

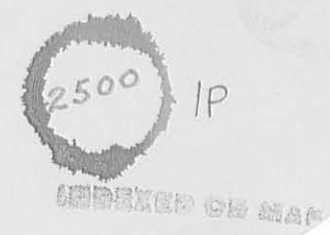

INDEXED ON MAP